

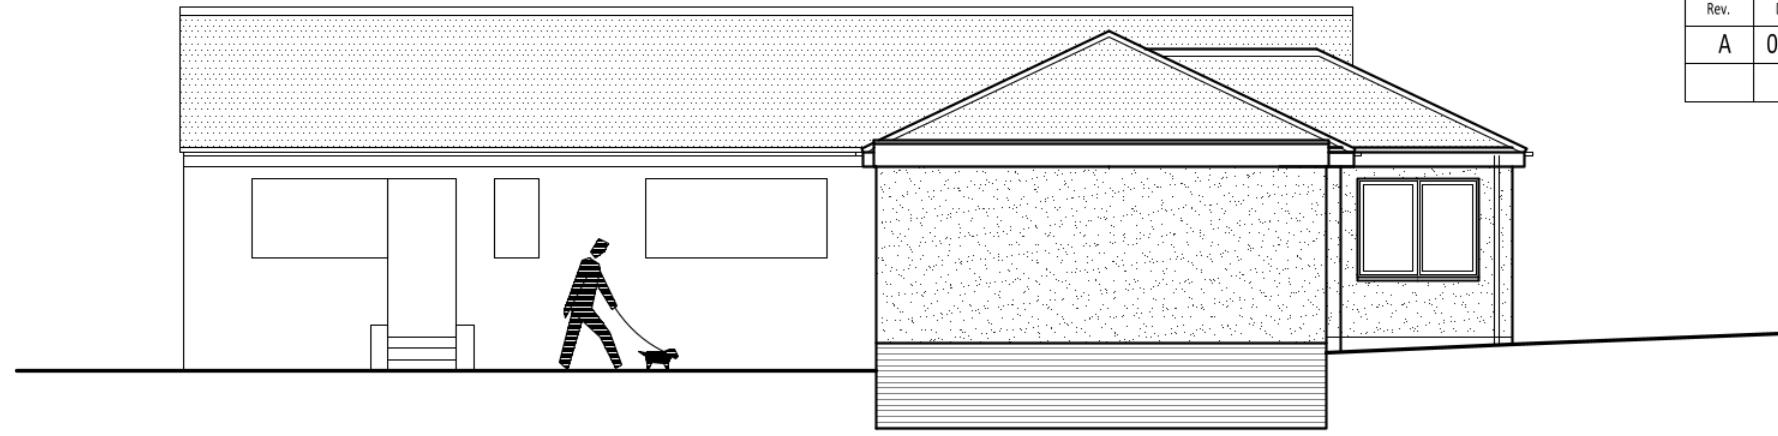



Rev.	Date	Details
A	04.01.26	External wall finish changed to render.
		Fenestration revised to as built.

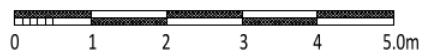

NORTH

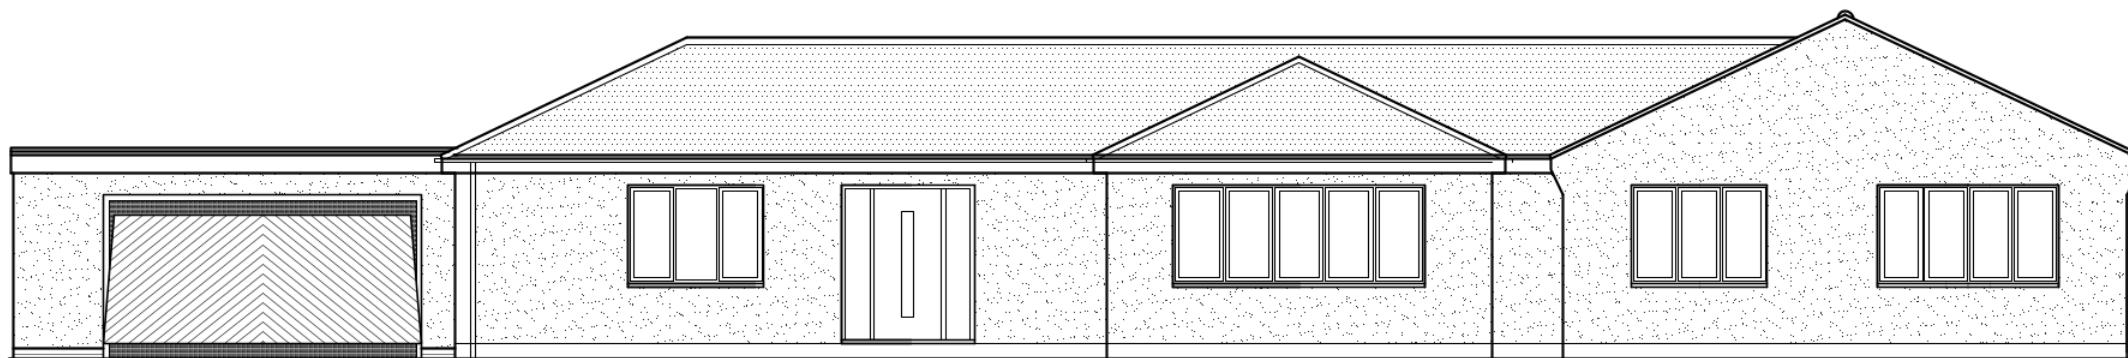

WEST

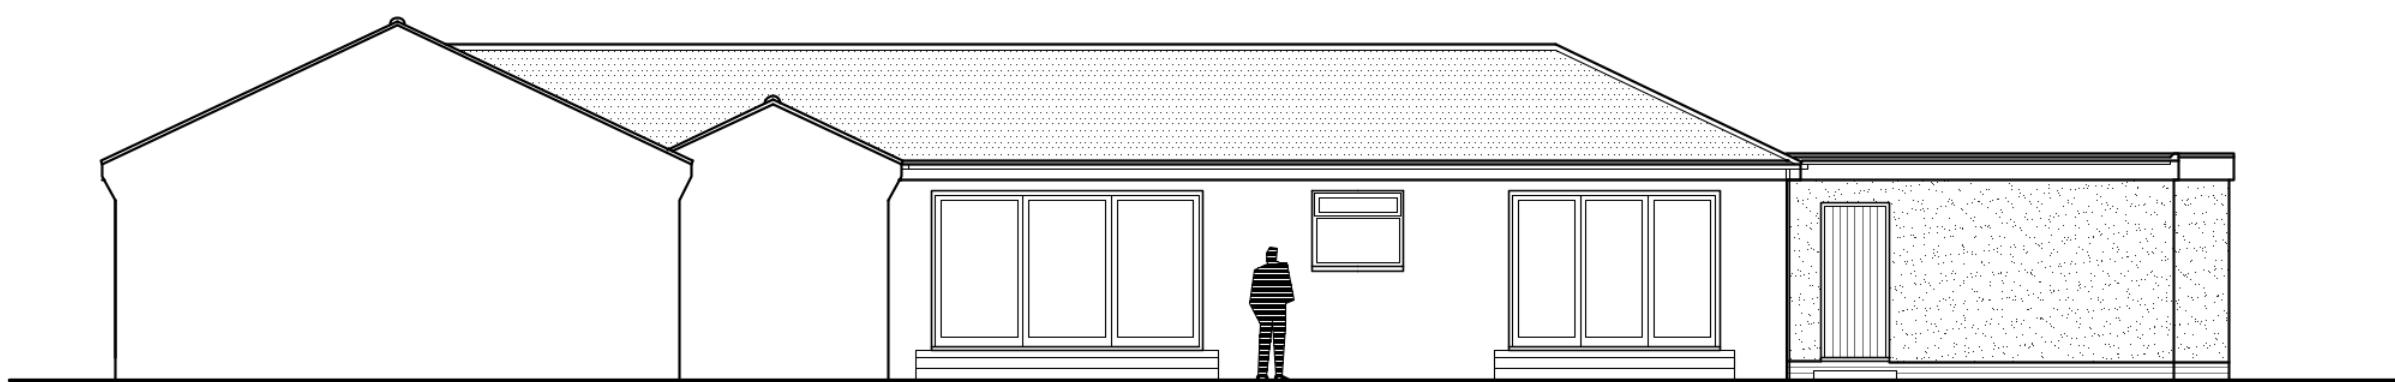

EAST



Client:

MR. PAUL FOX

Proposal:

EXTENSION TO FORM GARAGE AT
186 BARRIER BANK, COWBIT, SPALDING

JANICE KENDRICK DESIGN SERVICES

e-mail- jkds@talk21.com tel : 07711 007209

Scale @ A3

1:100

Dwg No.

25. 3654. 04

Title

PROPOSED ELEVATIONS