



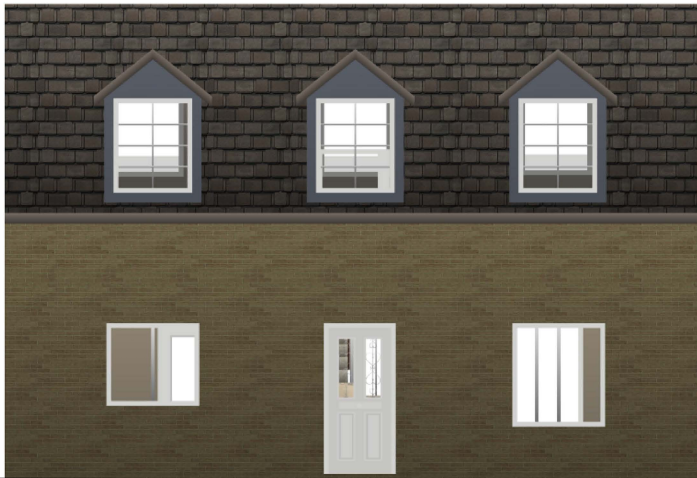

As Built North Elevation

6.6m

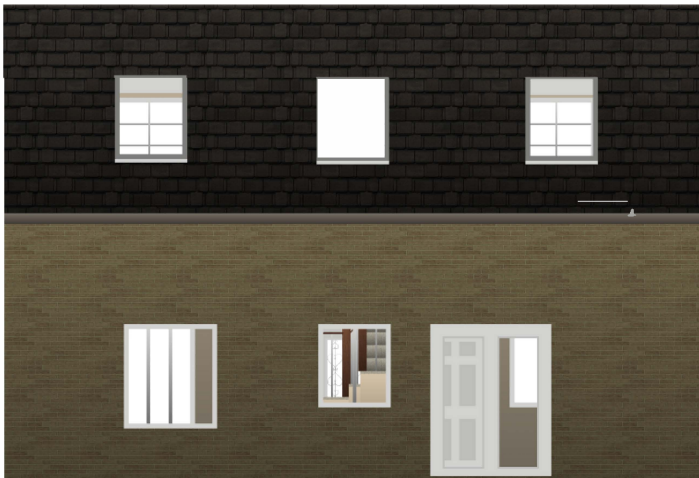

As Built South Elevation



As Built West Elevation

6.6m



As Built East Elevation

As Built Elevations

Scale 1:100 @ A4

Drawing 2069:10