



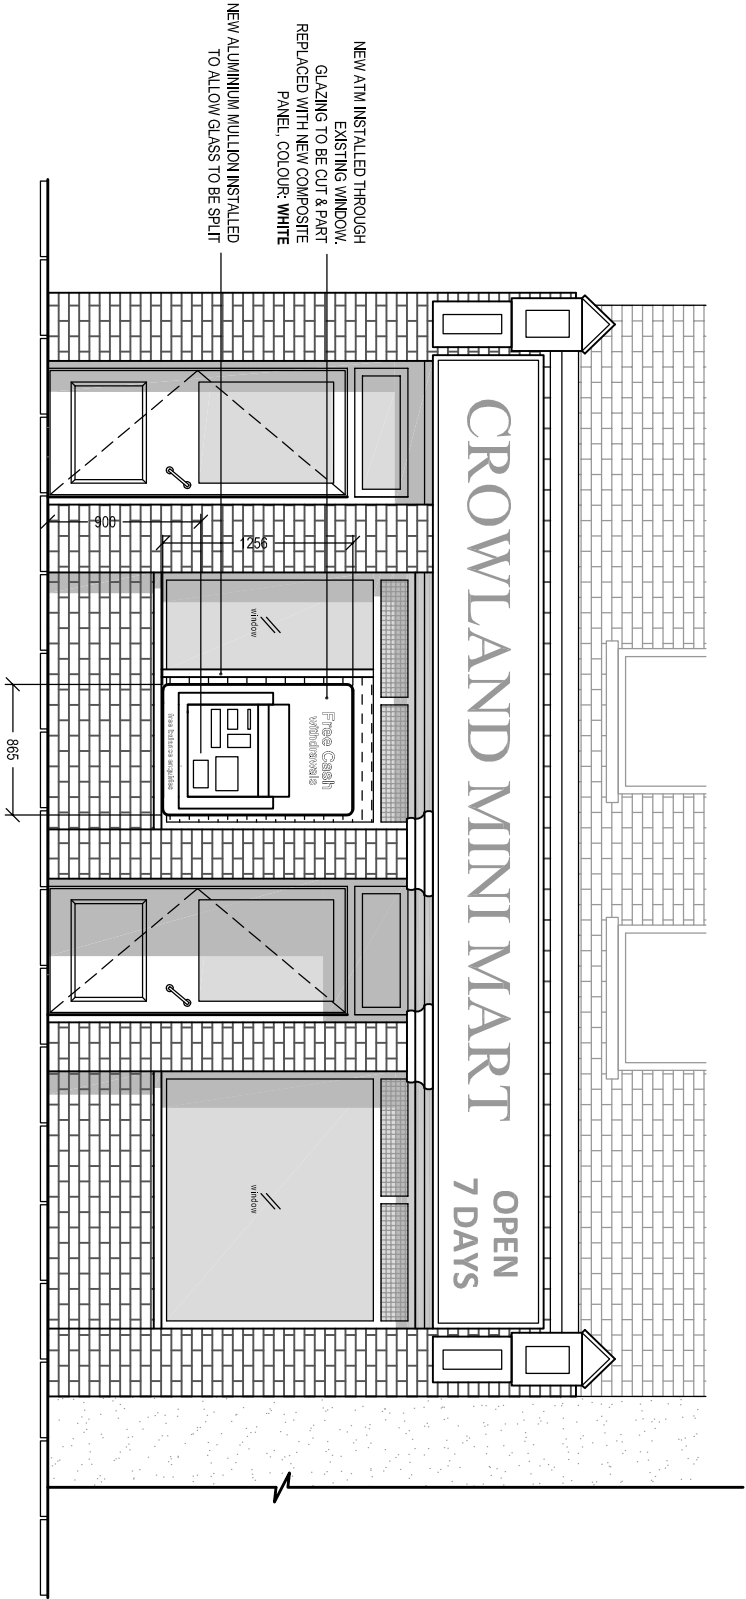

PROPOSED FRONT ELEVATION

Scale 1:50

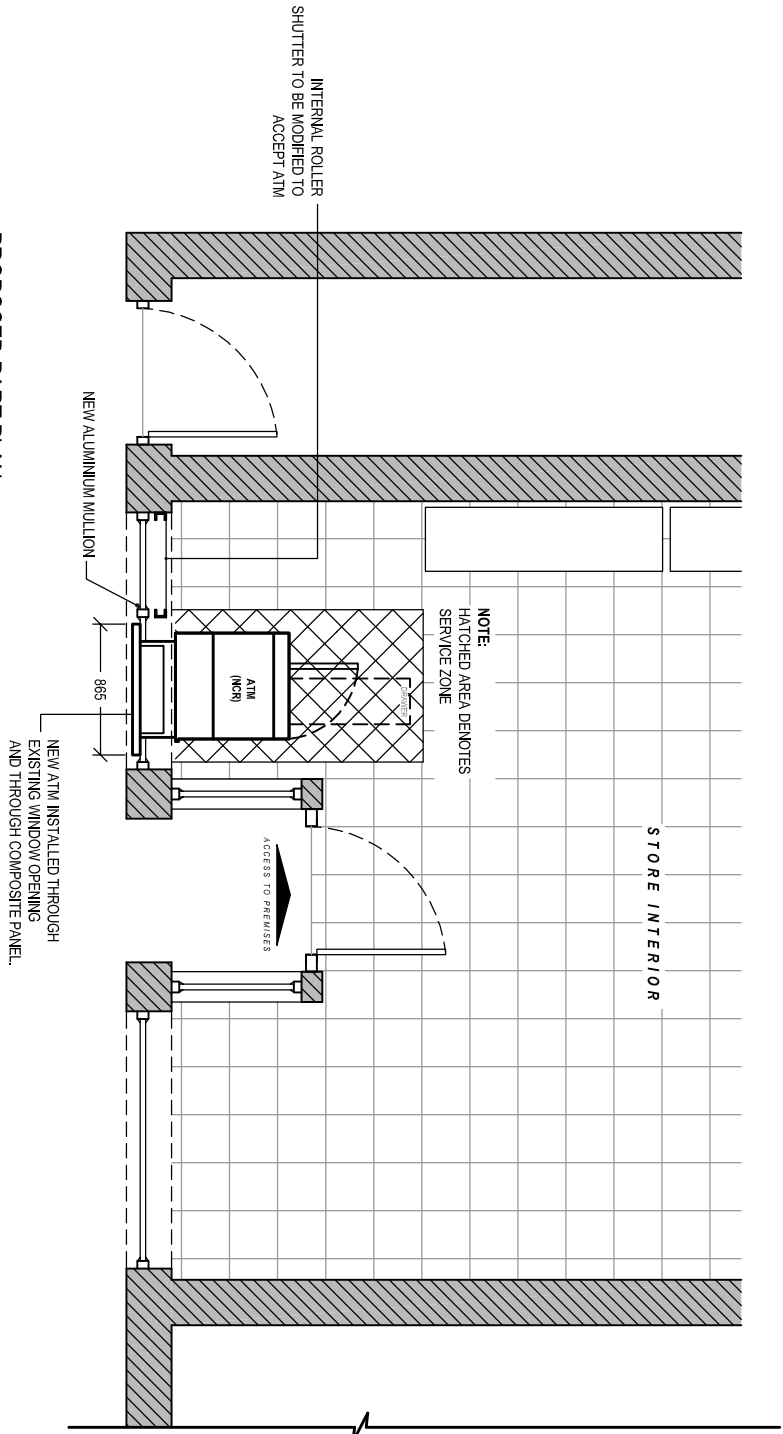

PROPOSED PART PLAN

Scale 1:30

Date: _____ By: _____

Comments: _____

GENERAL NOTES:
1) All dimensions in millimeters unless otherwise stated.

Site:
CROWLAND MINIMART
6 West Street
Crowland
Peterborough
PE6 0ED

Drawing Title:
As Installed Elevations and Plans

Ref: NM-05-2015-28-2	Date: 21-05-2015	Rev:
Scale: 1:50	Paper: A3	Date Rev: