


BLOCK/SITE PLAN

AREA 90m x 90m

SCALE: 1:500 on A4

CENTRE COORDINATES: 524013 , 310125

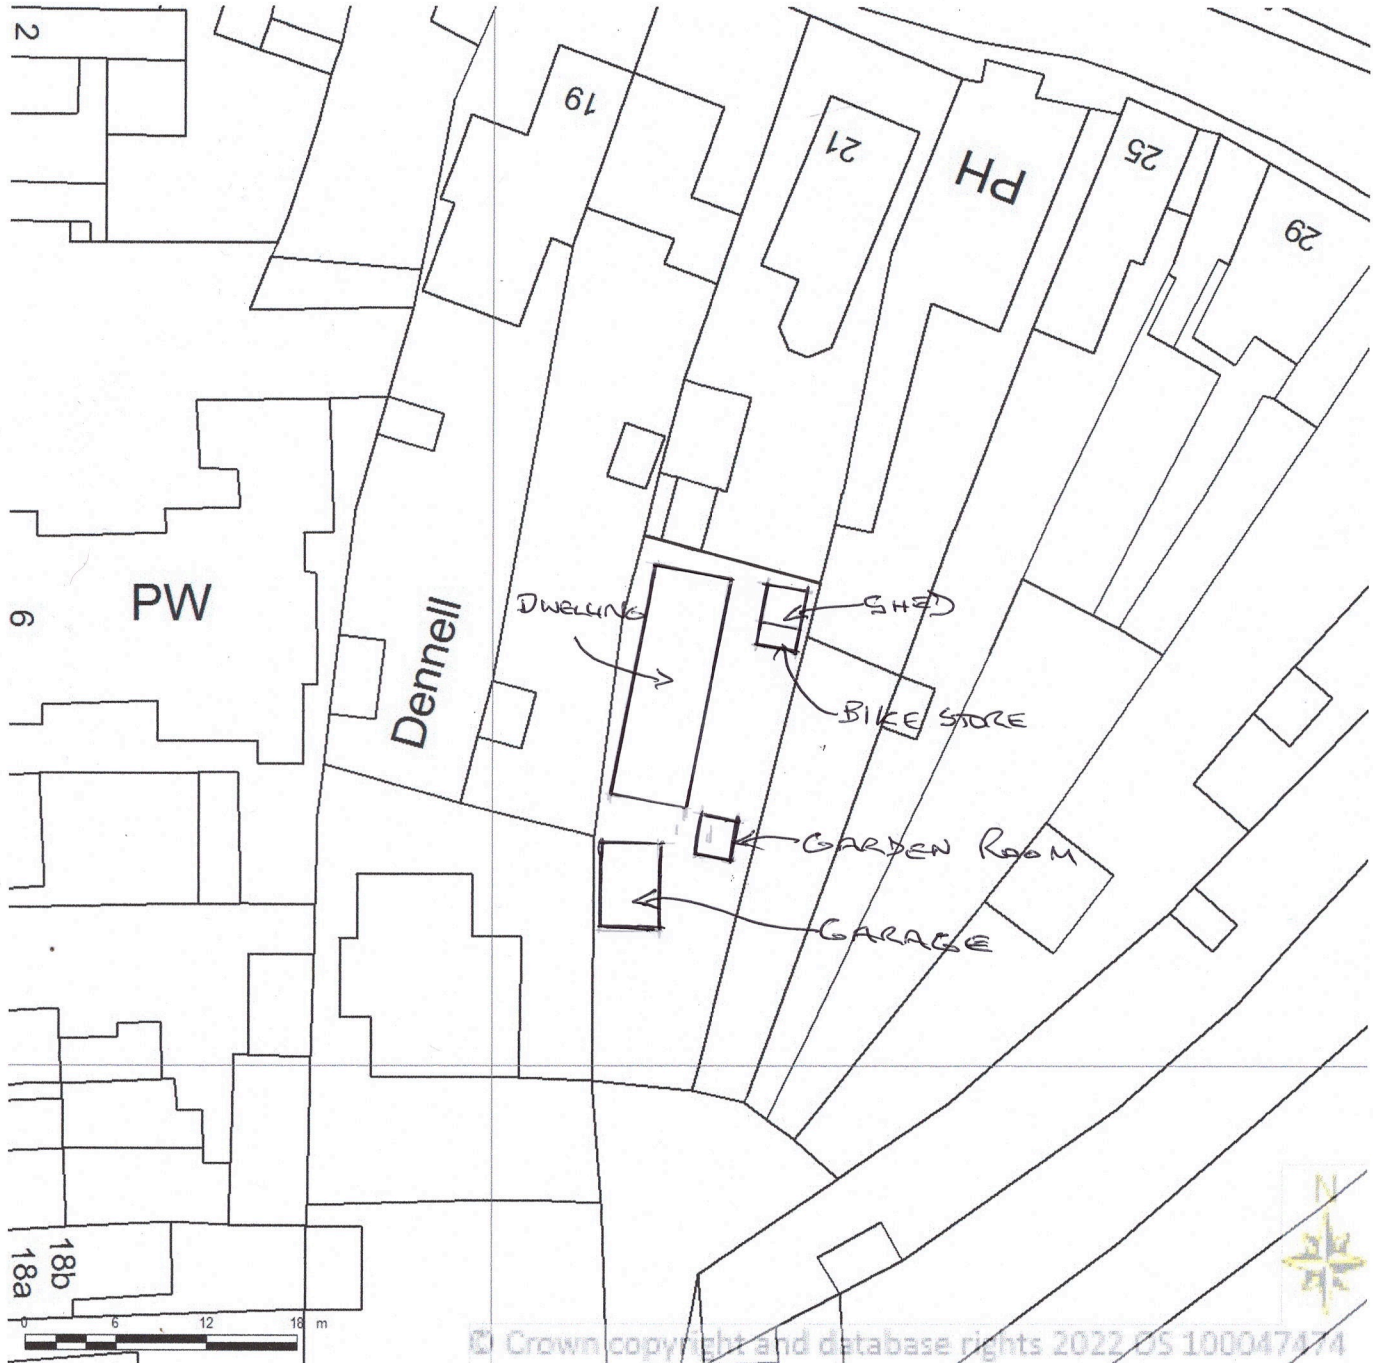

Supplied by Streetwise Maps Ltd

www.streetwise.net

Licence No: 100047474

09:31:18 05/07/2022