




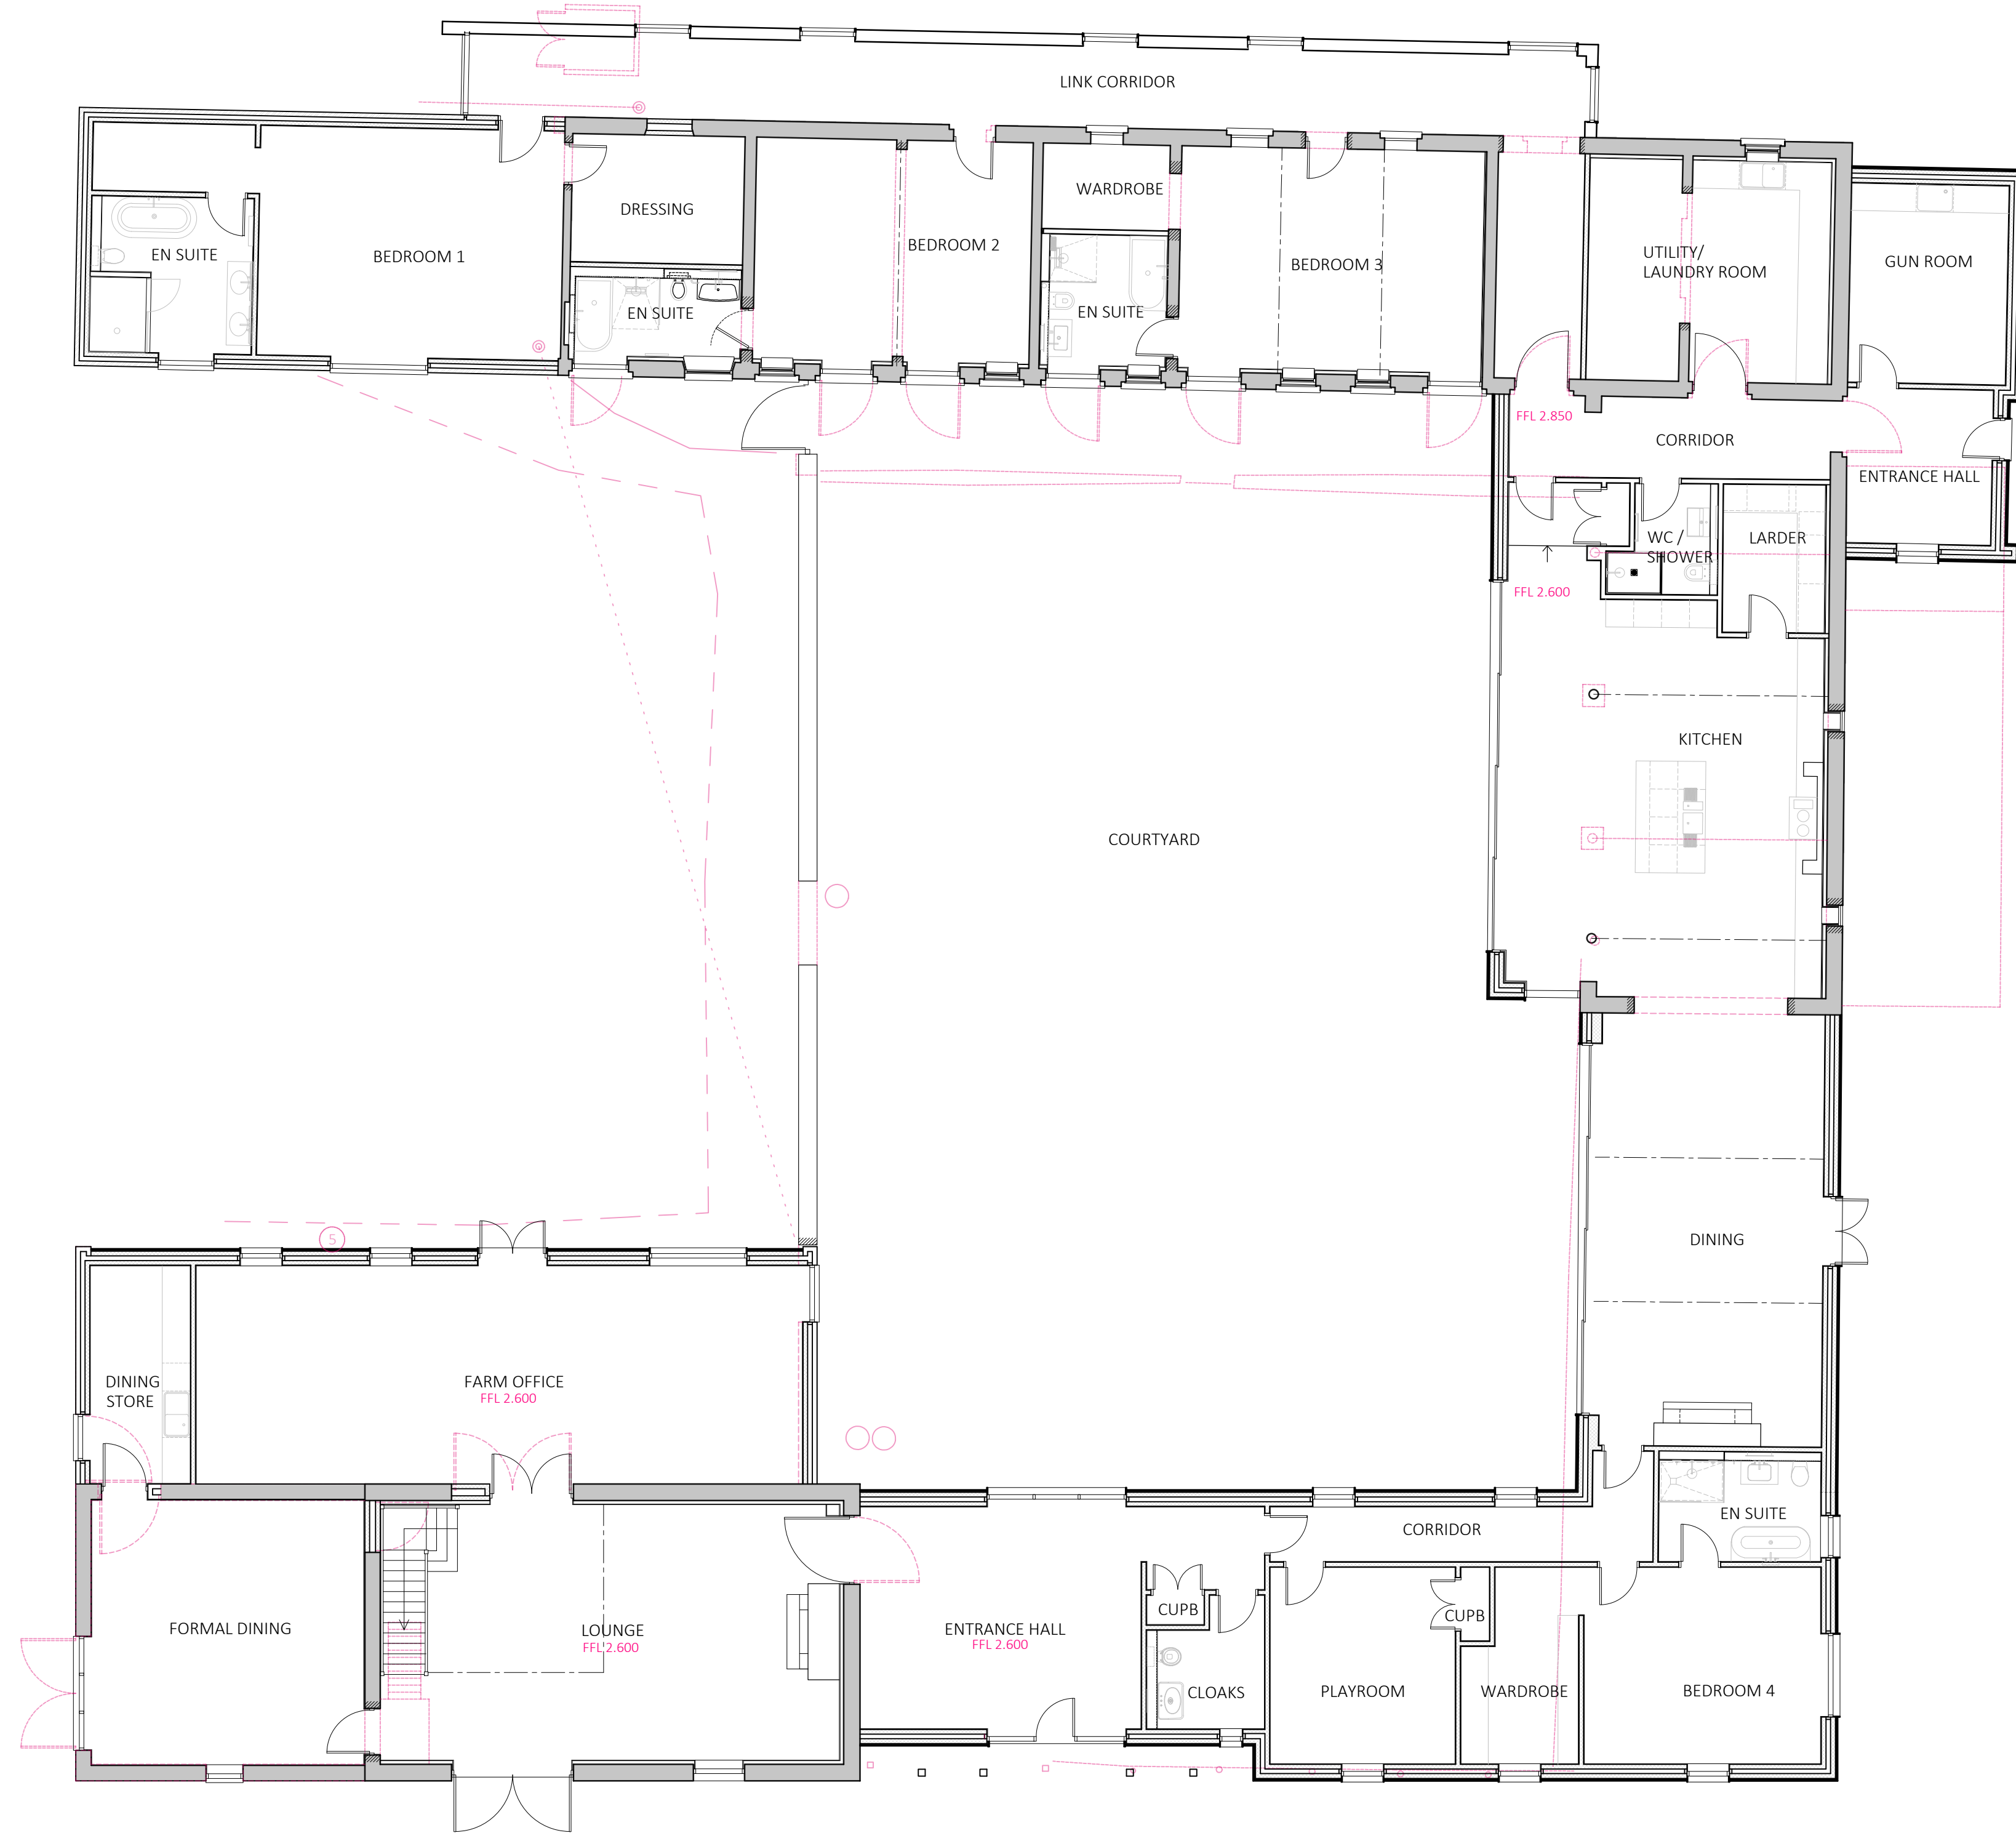


GROUND FLOOR PLAN

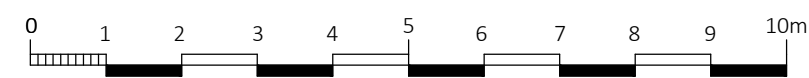

RED LINES SHOW EXTENTS OF DEMOLITIONS

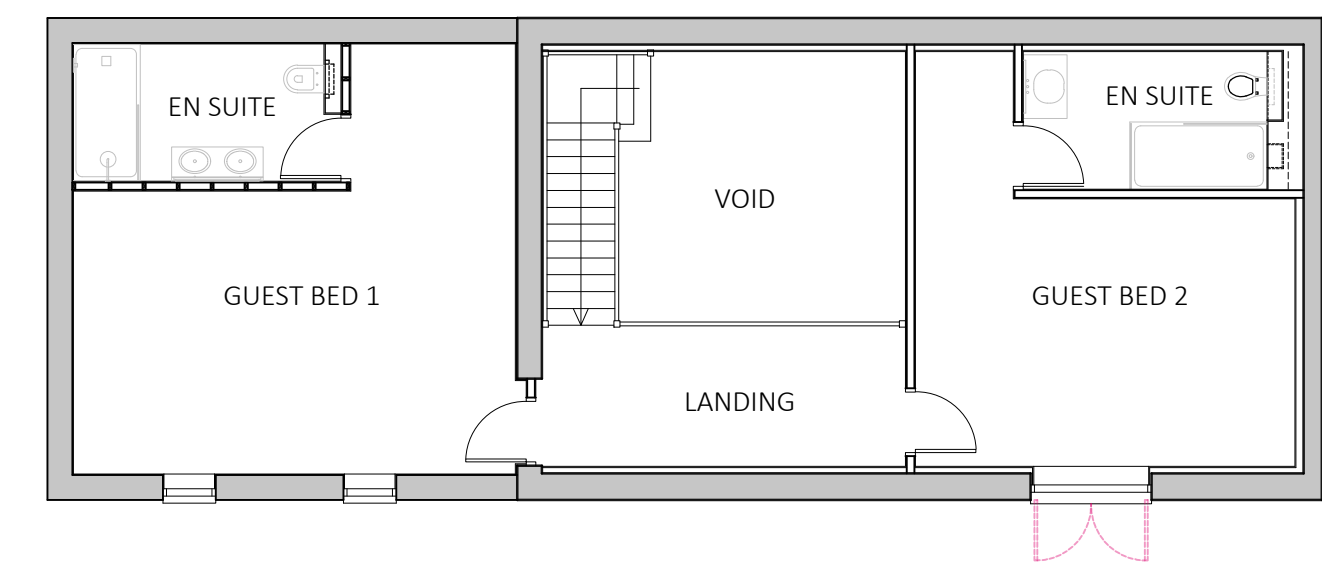

FIRST FLOOR PLAN

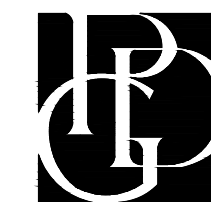

BARN CONVERSION
CLOOT DROVE, CROWLAND
PROPOSED PLANS

Scale: 1:100@A1
Drawn: CRB

Date: 06/2022
Dwg No: 21054/PL200

PDG ARCHITECTS LTD
1 Eaglethorpe Barns,
Eaglethorpe, Warrington,
Peterborough, PE8 6TJ
T: 01733 371000
E: design@pdgarchitects.co.uk
W: www.pdgarchitects.co.uk