



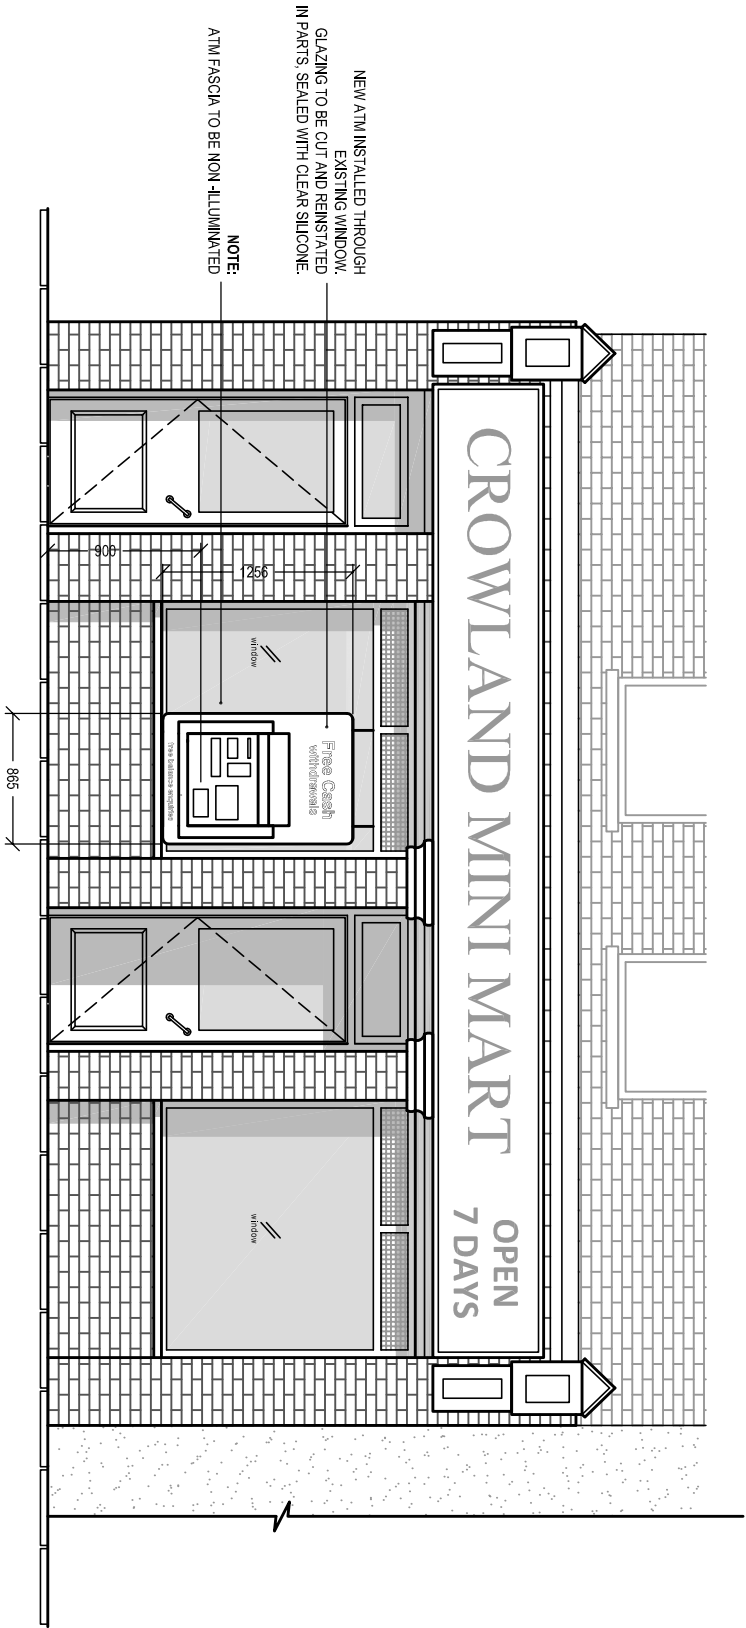

PROPOSED FRONT ELEVATION

Scale 1:50

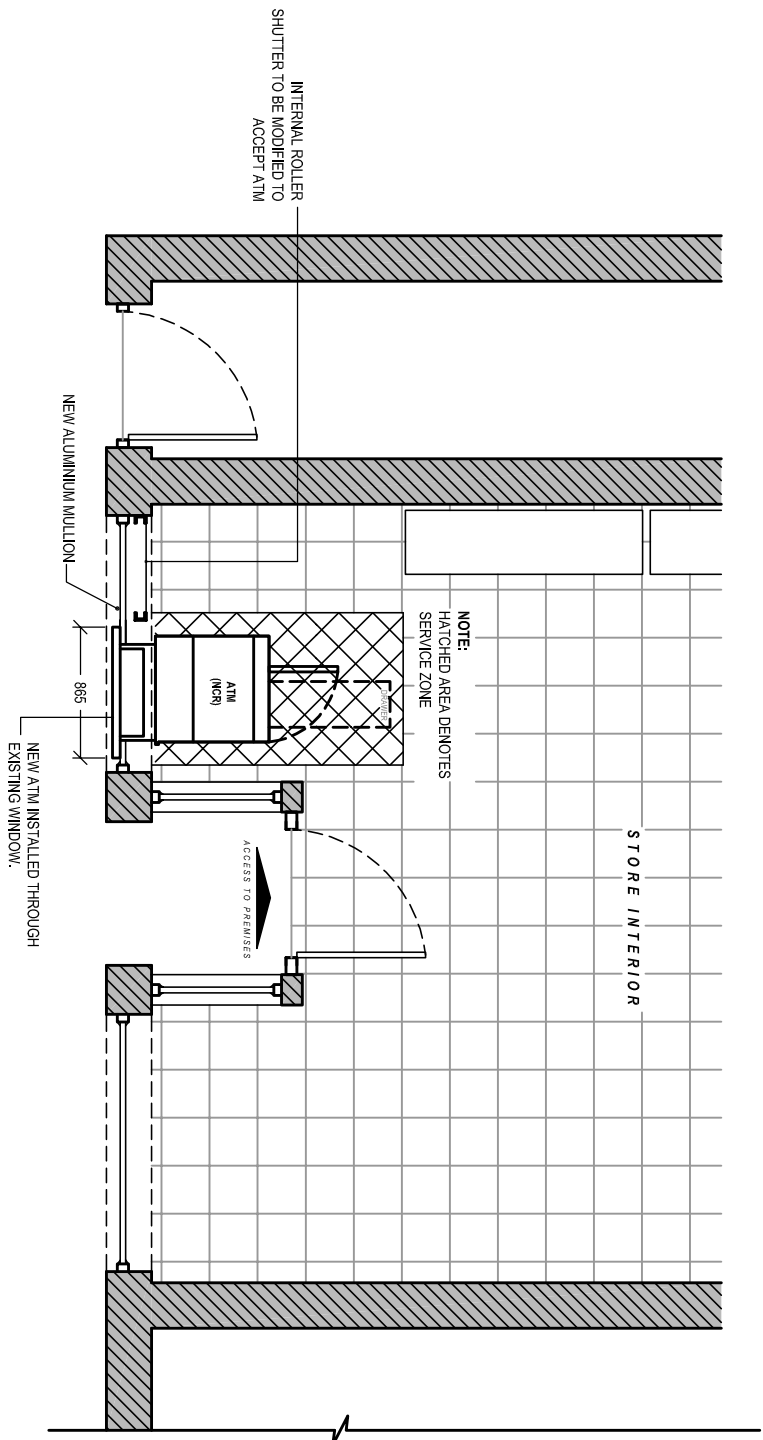

PROPOSED PART PLAN

Scale 1:30

Date:	Comments:	By:
02-10-15	ATM Installation revised to through glass.	CM

GENERAL NOTES:
1) All dimensions in millimeters unless otherwise stated.

Site:
CROWLAND MINIMART
6 West Street
Crowland
Peterborough
PE6 0ED

Drawing Title:
As Installed Elevations and Plans

Ref:	Date:	Rev:
NM-05-2015-28-2	21-05-2015	A
Scale:	Paper:	Date Rev:
1:50	A3	02-10-2015