

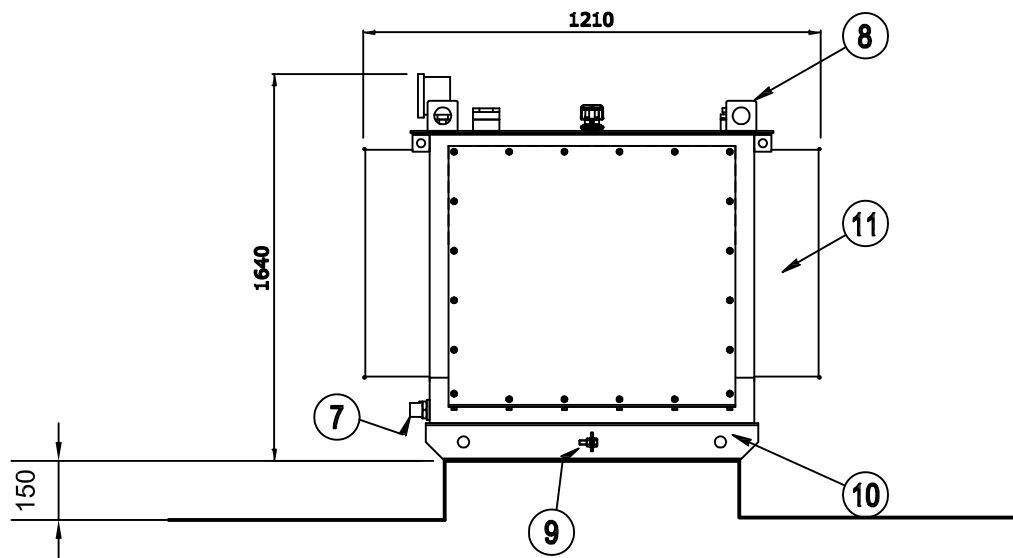


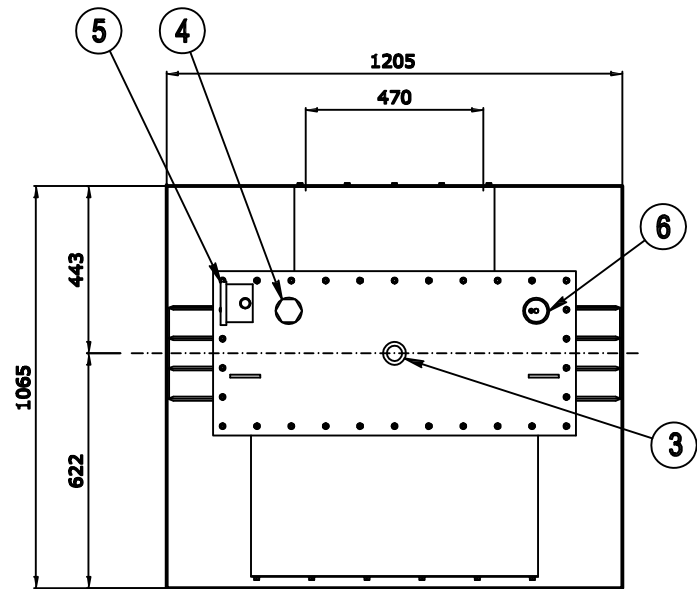


Pad Mount Elevations 1:20

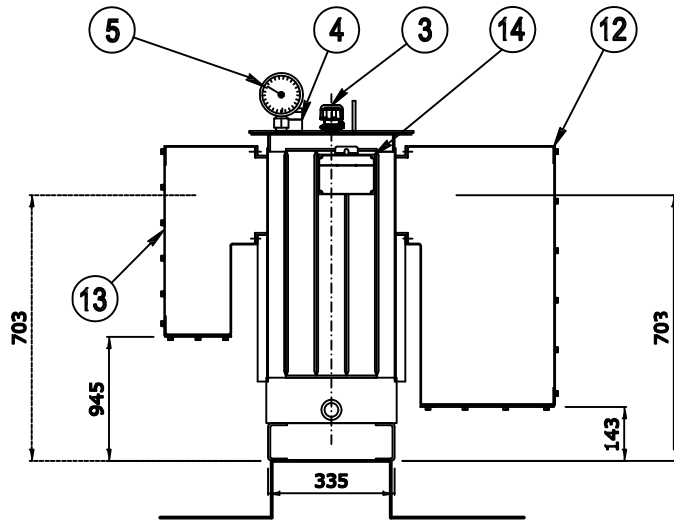

Pad Mount Plan 1:20

Detailing 1:20

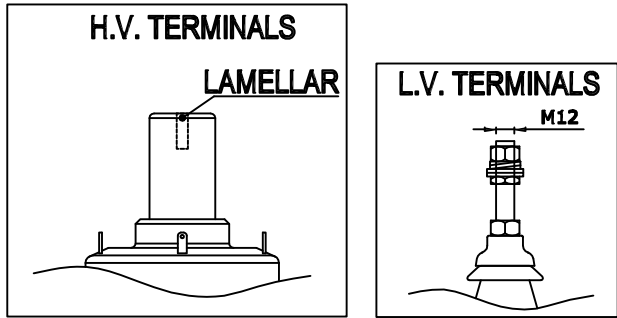

Type:	kVA: 50	Hz: 50
V. :	33000±2x2,5% / 0,433+n	
Coll. :	△ / ✕	Gr. : Dyn11
Wo:	290	Wcc at 75°C: 900
		Vcc%: 4,0
Total weight kg.	600	

ITEM	Q.ty	DESCRIPTION
14	1	RATING PLATE
13	1	LV CABLE BOX
12	1	HV CABLE BOX
11	2	COOLING FINS
10	2	SKID UNDER BASE
9	2	EARTHING CLAMPS
8	2	LIFTING LUGS
7	1	OIL DRAIN CAP
6	1	PRESSURE RELIEF DEVICE
5	1	DIAL TYPE THERMOMETER
4	1	OIL LEVEL INDICATOR
3	1	CIRCUIT TAP SELECTOR
2	4	L.V. BUSHING
1	3	H V TERMINALS

C: 10.10.2018 - As Built Aux trx (JL)
B: 05.10.2018 - As Built Aux trx (JL)
A: 12.05.2015 - Non Material Amendments (GS)
Revision:

Project:
Decoy Solar Farm
Decoy Farm
Crowland
Peterborough

Client:
Push Energy

Drawing Title:
33kv Pad Mount
Plans and Elevations

Project Ref: / Drawing No.
15/PA009C

Scale: 1:20 @ A3
Date: 28/11/2014
Drawn: JL
Checked: JK

push energy
PUSH ENERGY
1&2 Tollgate Business Park
Tollgate West
Stanway
Colchester
CO3 8AB
Tel: 01206 203253
Web: www.pushenergy.co.uk

Do not scale this drawing. Work to figured dimensions only. This drawing is copyright of Push Energy Ltd and should only be reproduced with their express permission.