

KEY



OBSCURE STIPPLYTE
GLAZING.



PANEL.

F = FIXED WINDOW GLAZING.

G= DOOR LEAF GLAZING.

LC = LOCKABLE COCKSPUR.

TF = TELEFLEX WINDERS.

CAM = DOUBLE FOLDING CAM OPENERS

RS6 = PERMANENT WINDOW RESTRICTORS.


SEC = EXTERNALLY WEDGE (JA414) & FIT.

'E' GASKET TO FRAME INTERNALLY.


RED = PROPOSED NEW WINDOWS

LIMITATIONS:-

DRAWING DEVIATIONS BETWEEN EXACT
AS-BUILT DIMENSIONS AND DIMENSIONS
STATED IN THIS DRAWING ARE GENERALLY
ACCEPTED UP TO 100MM.

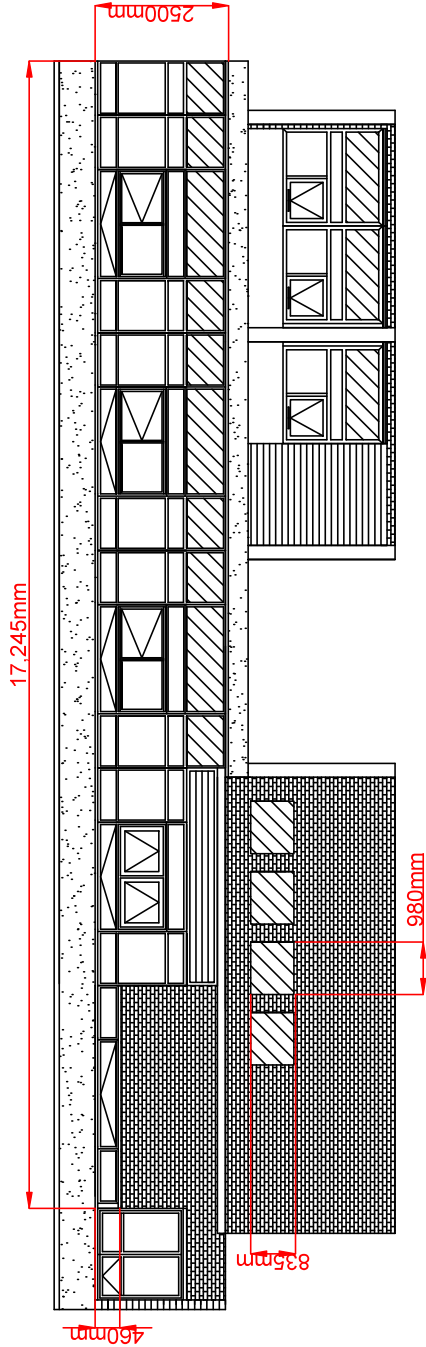

ELEVATION 3 EXISTING WINDOWS

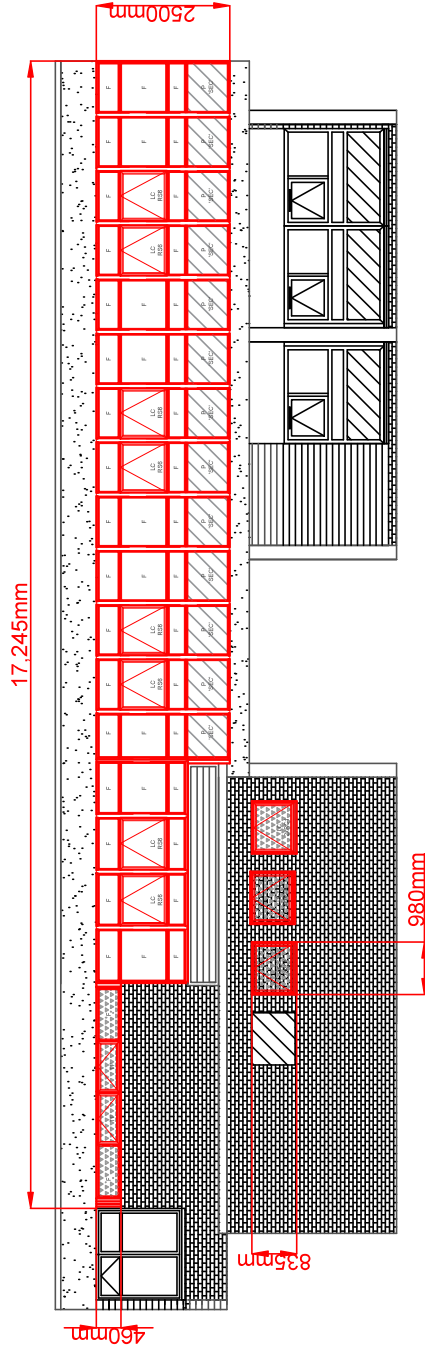

ELEVATION 3 PROPOSED NEW WINDOWS



CHARLES GARTH
INVEST | BUILD | MAINTAIN

CHARLES GARTH SURVEYORS & PROPERTY CONSULTANTS

2 CHURCH STREET
WETHERBY LS22 6LP
T: 0345 340 3919

ADDRESS:
THOMAS COWLEY HIGH
SCHOOL,
SCHOOL LANE,
SPALDING PE11 4TF

TITLE:
ELEVATION 3

SCALE:
1:100@A3

JOB No:
N/A

DWG No:
5

REV:

DATE:

STAGE:
PLANNING

DRAWN:
JP

CHECK:
LM

DATE:
3.2.2021