


KEY




- F = FIXED WINDOW GLAZING.
G= DOOR LEAF GLAZING.
LC = LOCKABLE COCKSPUR.
TF = TELEFLEX WINDERS.
CAM = DOUBLE FOLDING CAM OPENERS
RS6 = PERMANENT WINDOW RESTRICTORS.
SEC = EXTERNALLY WEDGE (JA414) & FIT.
'E' GASKET TO FRAME INTERNALLY.
RED = PROPOSED NEW WINDOWS & DOORS

LIMITATIONS:-

DRAWING DEVIATIONS BETWEEN EXACT
AS-BUILT DIMENSIONS AND DIMENSIONS
STATED IN THIS DRAWING ARE GENERALLY
ACCEPTED UP TO 100MM.

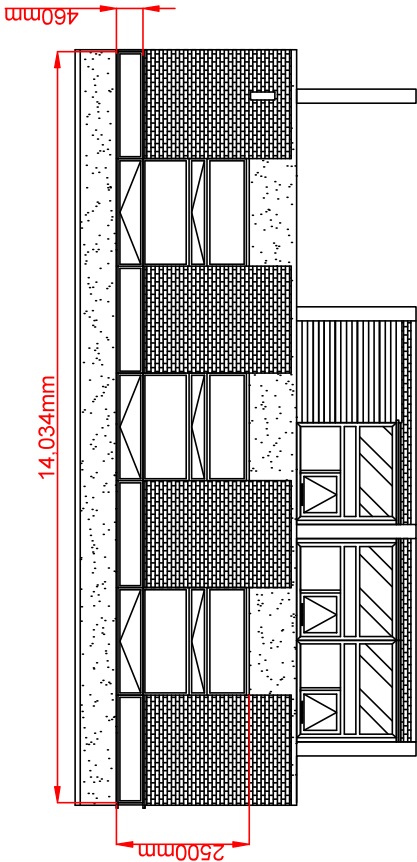

ELEVATION 5 EXISTING WINDOWS

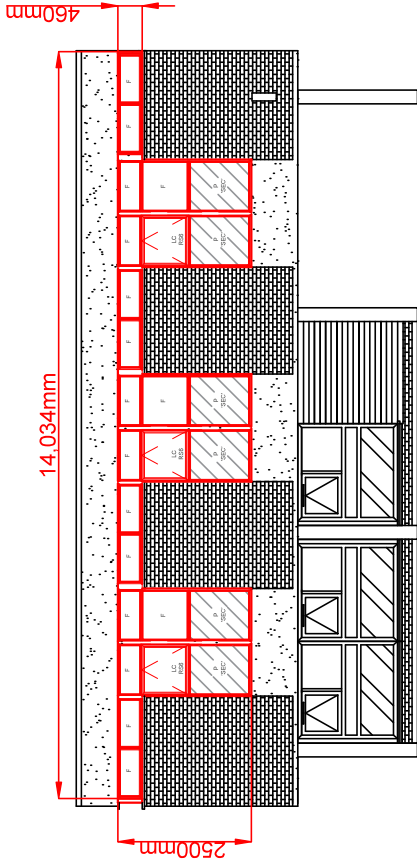

ELEVATION 5 PROPOSED NEW WINDOWS



CHARLES GARTH
INVEST | BUILD | MAINTAIN

CHARLES GARTH SURVEYORS & PROPERTY CONSULTANTS
2 CHURCH STREET
WETHERBY LS22 6LP
T: 0345 340 3919

ADDRESS:
THOMAS COWLEY HIGH
SCHOOL,
SCHOOL LANE,
SPALDING PE11 4TF

TITLE:
ELEVATION 5
STAGE:
PLANNING

SCALE:
1:100@A3
DRAWN:
JP
CHECK:
LM

JOB No:
N/A
DATE:
3.2.2021

DWG No:
7

REV:

DATE: