

PROPOSED NEW DOORS (OPEN IN)

700 APPROX
A/C100 / AFT / LOW THRESHOLD,
LOW THRESHOLD WITH 155X30MM CILL
RAL9910 HIPCA WHITE GLOSS
RAL9910 HIPCA WHITE GLOSS
MS2200 EURO HOOKLOCK
N/A
KEY / KEY CYLINDER, KEVED ALIKE JOB,
400MM SAA STRAIGHT 'D' HANDLES INT/EXT
AXIM CONCEALED NON HOLD OPEN (TBC).

DOOR SYSTEM & STILE:
CILL / ADDITIONAL PROFILES:
FRAME COLOUR & FINISH:
LEAF COLOUR & FINISH:
PRIMARY LOCK:
SECONDARY LOCK:
CYLINDER TYPE:
HANDLE TYPE & CONFIG:
CLOSER TYPE & CONFIG:

ADDITIONAL INFORMATION

KEY

OBSCURE STIPPOLYTE
GLAZING.

PANEL.

F = FIXED WINDOW GLAZING.

G= DOOR LEAF GLAZING.

LC = LOCKABLE COCKSPUR.

TF = TELEFLEX WINDERS.

CAM1 = DOUBLE FOLDING CAM OPENERS

RS6 = PERMANENT WINDOW RESTRICTORS.

SEC = EXTERNALLY WEDGE (JA414) & FIT.

E GASKET TO FRAME INTERNALLY.

RED = PROPOSED NEW WINDOWS & DOORS


LIMITATIONS:-

DRAWING DEVIATIONS BETWEEN EXACT


AS-BUILT DIMENSIONS AND DIMENSIONS

STATED IN THIS DRAWING ARE

GENERALLY ACCEPTED UP TO 100MM.

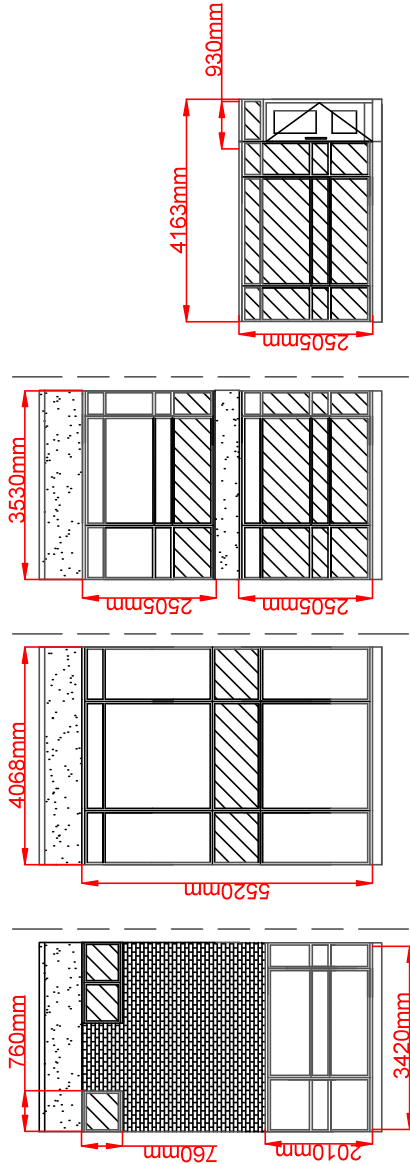

ELEVATION 8 (COURTYARD) EXISTING WINDOWS

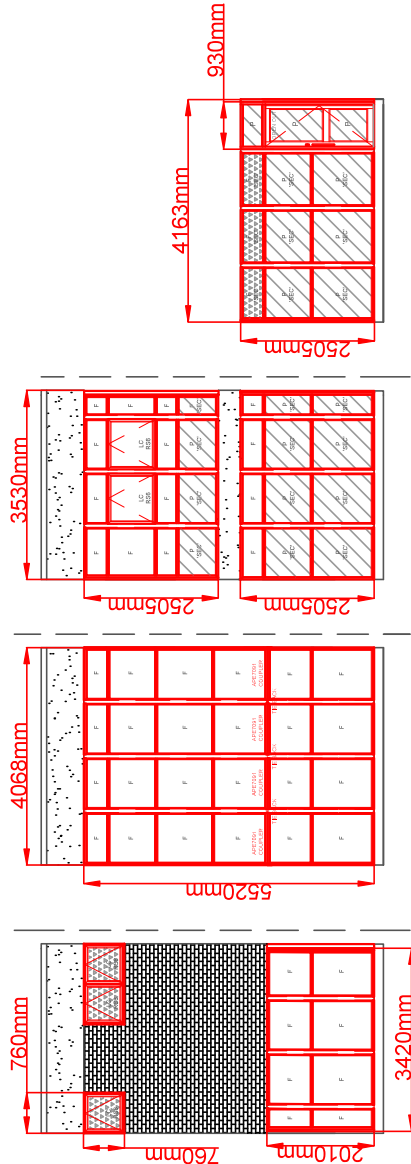

ELEVATION 8 (COURTYARD) PROPOSED NEW WINDOWS



CHARLES GARTH
INVEST | BUILD | MAINTAIN

CHARLES GARTH SURVEYORS & PROPERTY CONSULTANTS

2 CHURCH STREET
WETHERBY LS22 6LP
T: 0345 340 3919

ADDRESS:
THOMAS COWLEY HIGH
SCHOOL,
SCHOOL LANE,
SPALDING PE11 4TF

TITLE:
ELEVATION 8

SCALE:
1:100@A3

JOB No:
N/A

DWG No:
10

REV:

DATE:

DRAWN: JP
CHECK: LM
DATE: 3.2.2021