
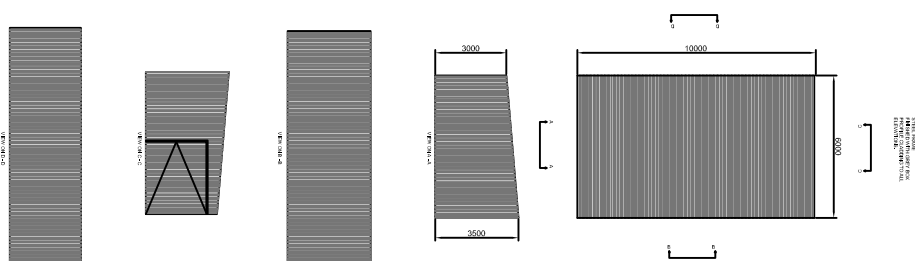


START

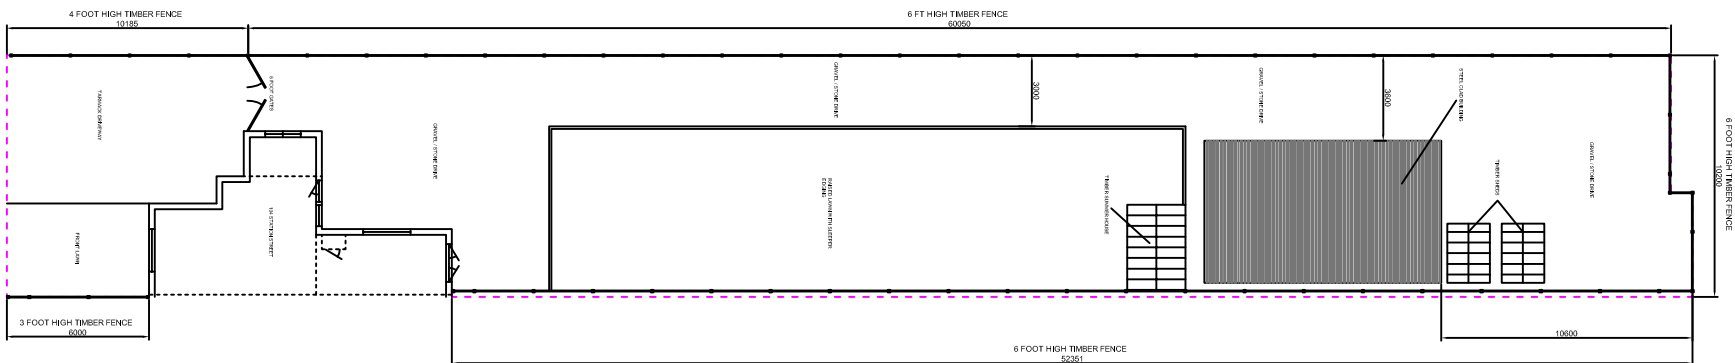

ALL WELDS TO BE 26 FILET U/M.O

No.	DESCRIPTION	CHK'D	APP'D	DATE	CLIENT:	JOB TITLE:	DRAWING TITLE:	NOTES:-	All Structural Steelwork to comply with BS EN 1090 Execution Class 2. All bolting to be BS EN 10901 - Grade 8.8 ALL WELDS TO BE 25Fillet UNDO	DRAWING No. PE114UJ
REVISIONS					104 STATION STREET DORINGTON PE11 4UJ	ERECTED STEEL BUILDING AS BUILT 2006/07	SITE PLAN	X		
DRAWING No. PE114UJ										