

0779
4.692ha
11.59

2972
2.662ha
6.58

6377
1.104ha
2.73

1268
.898ha
2.22

3465
1.245ha
3.08

5569
2.678ha
6.62

6463
1.86ha
.46

3961
1.310ha
3.24

5862
2.227ha
.56

2358
2.492ha
6.16

5257
.967ha
2.39

2251
1.371ha
3.39

5052
1.306ha
3.23

Dairy

0947
2.219ha
.54

Ref: 2145
1.634ha
4.04
04 JAN 2011
SHD Planning & Development

5048
1.415ha
3.50

4941
2.686ha

6034
1.50ha
.37

Long Acres

1433
3.171ha
7.84

6528

Homelands

Worth's Cottages

The Bungalow

6553
1.221ha
3.02

BM
3.35m

Drain

Drain


Drain

Drain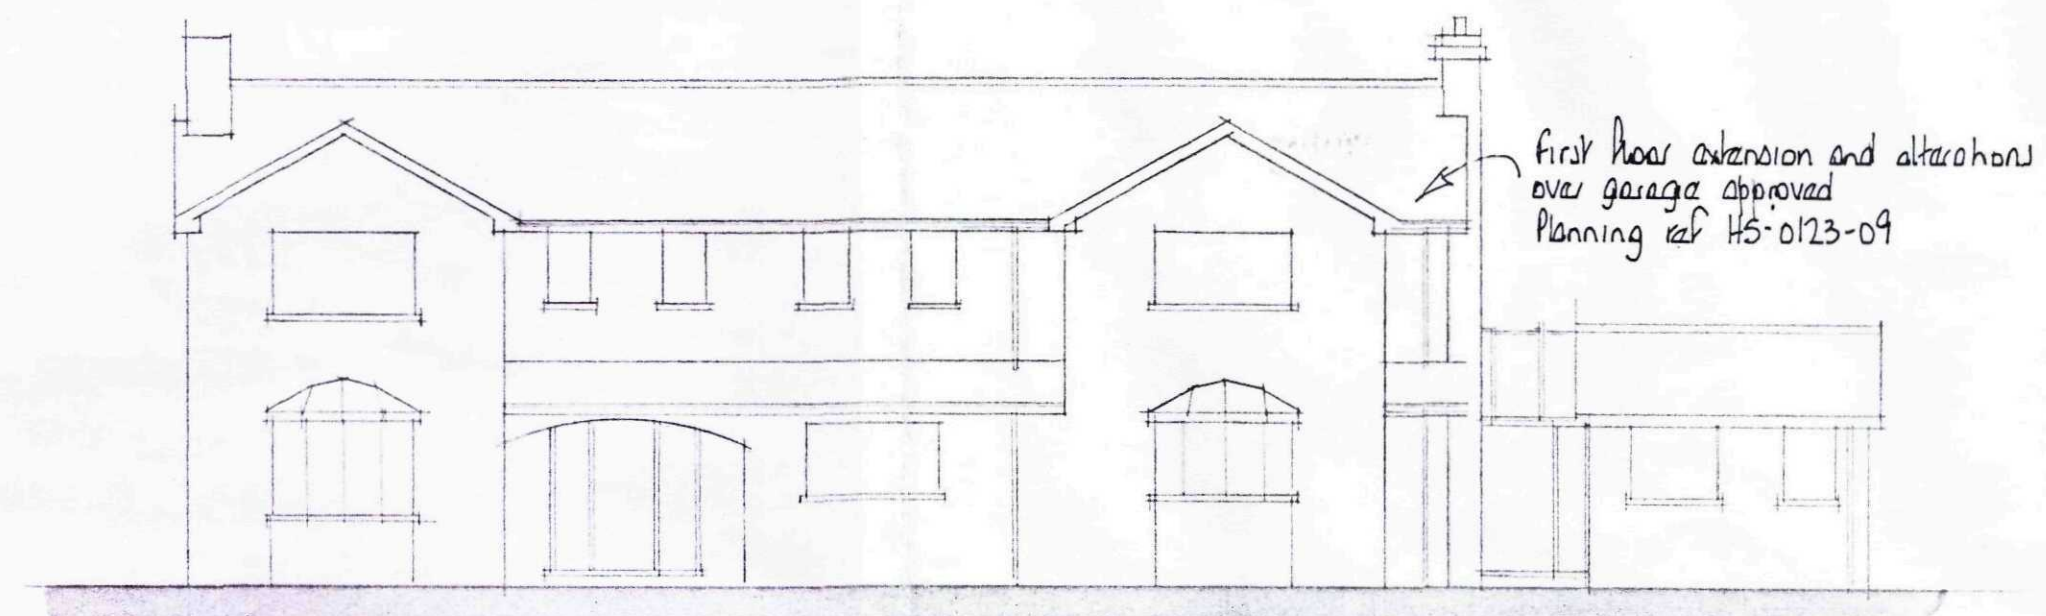


east

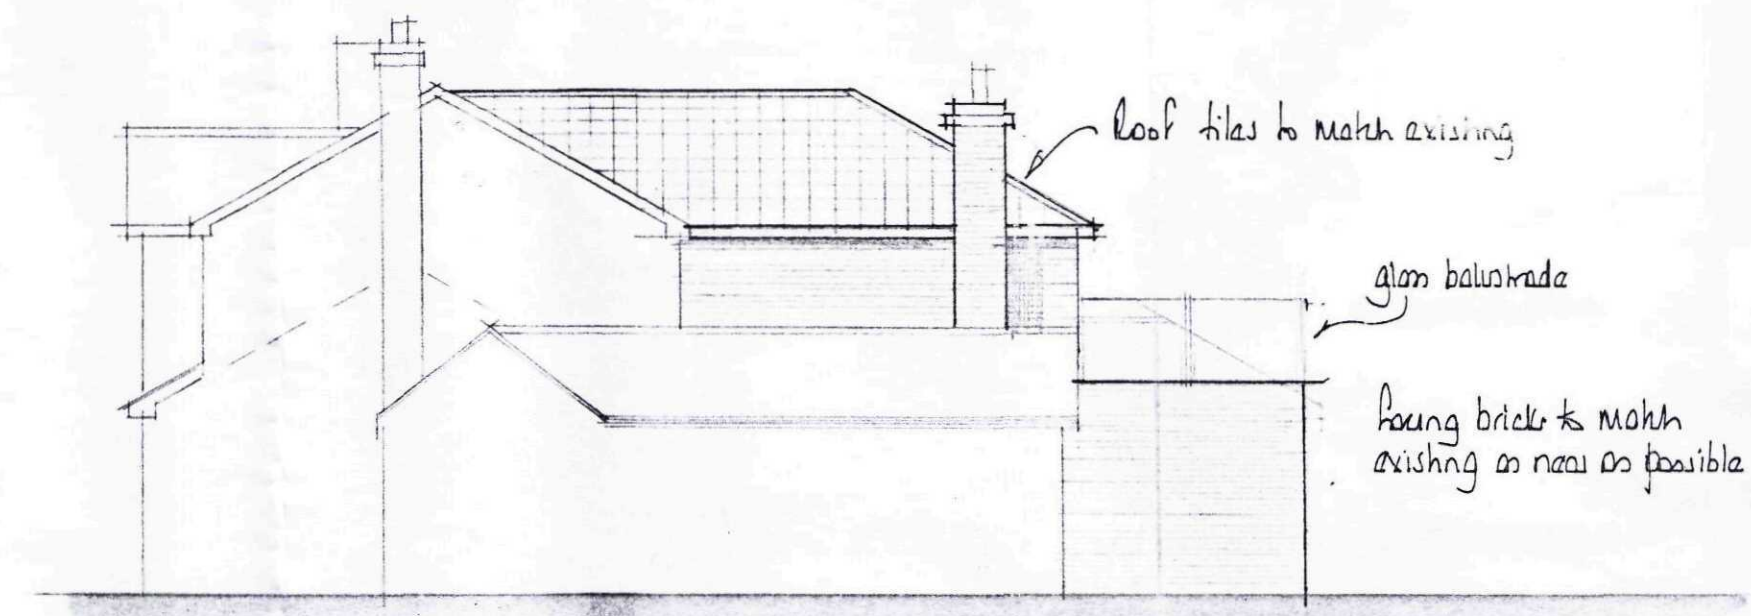


north




south

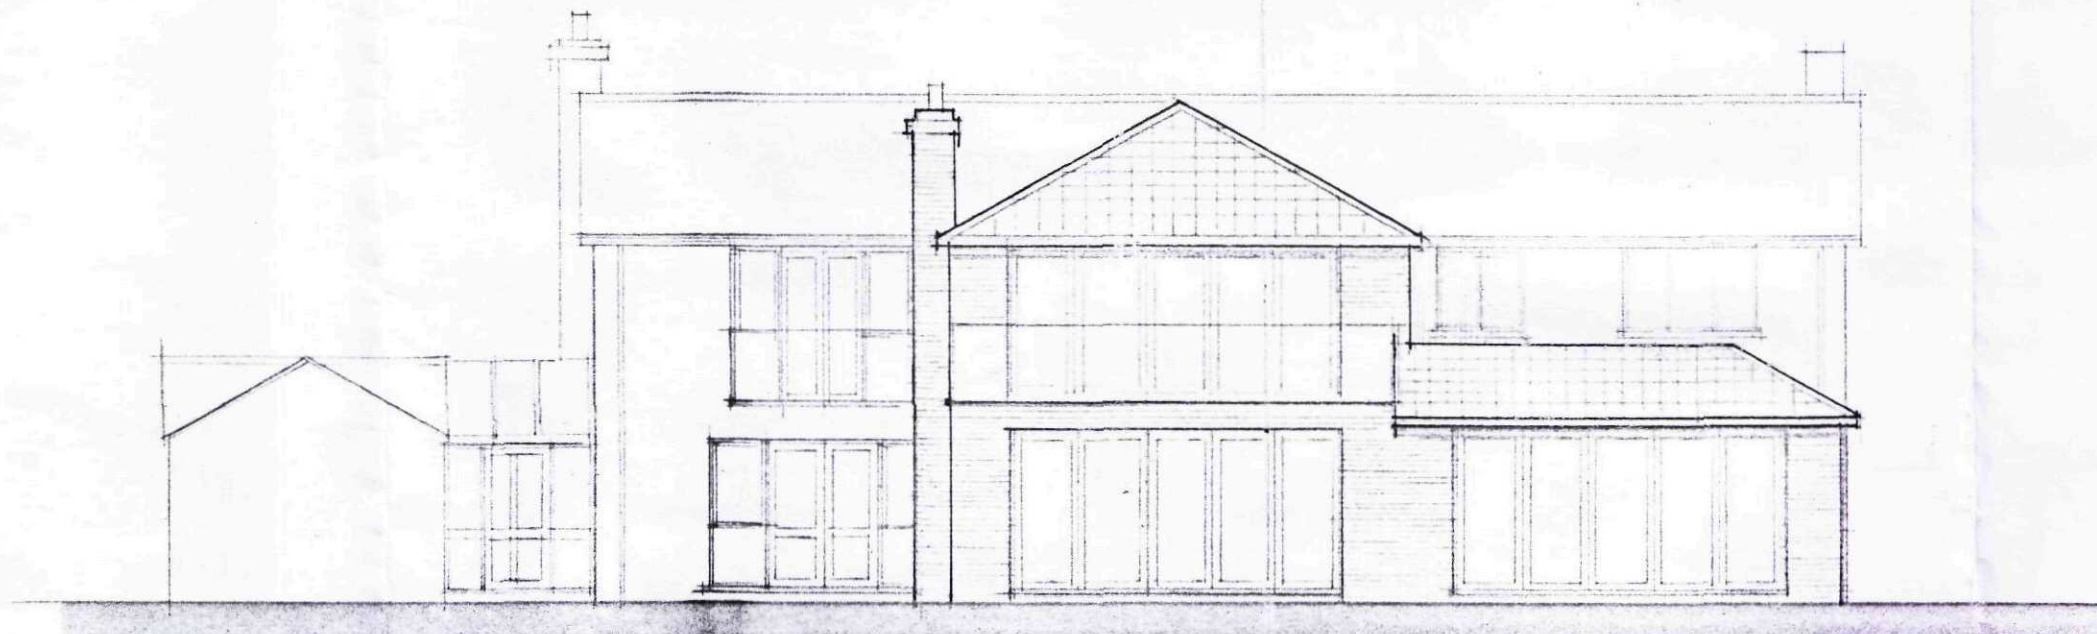


west

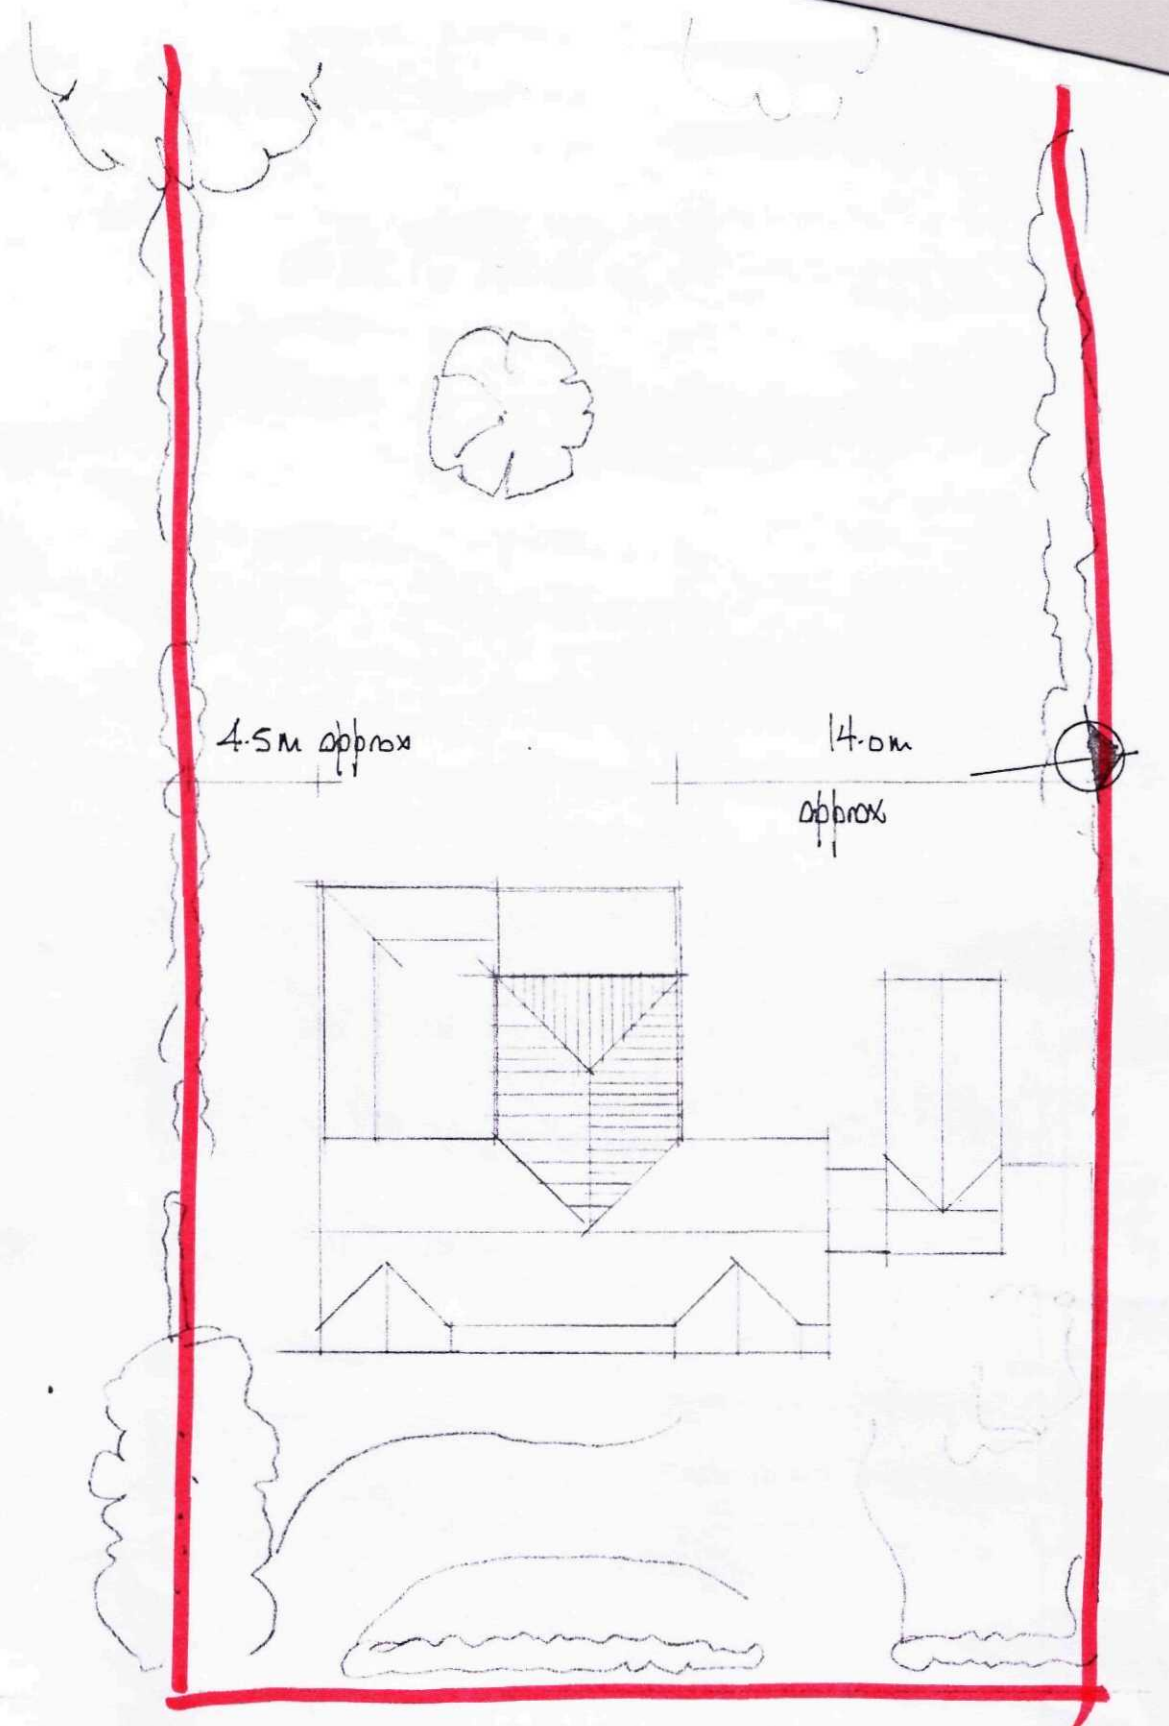

block plan

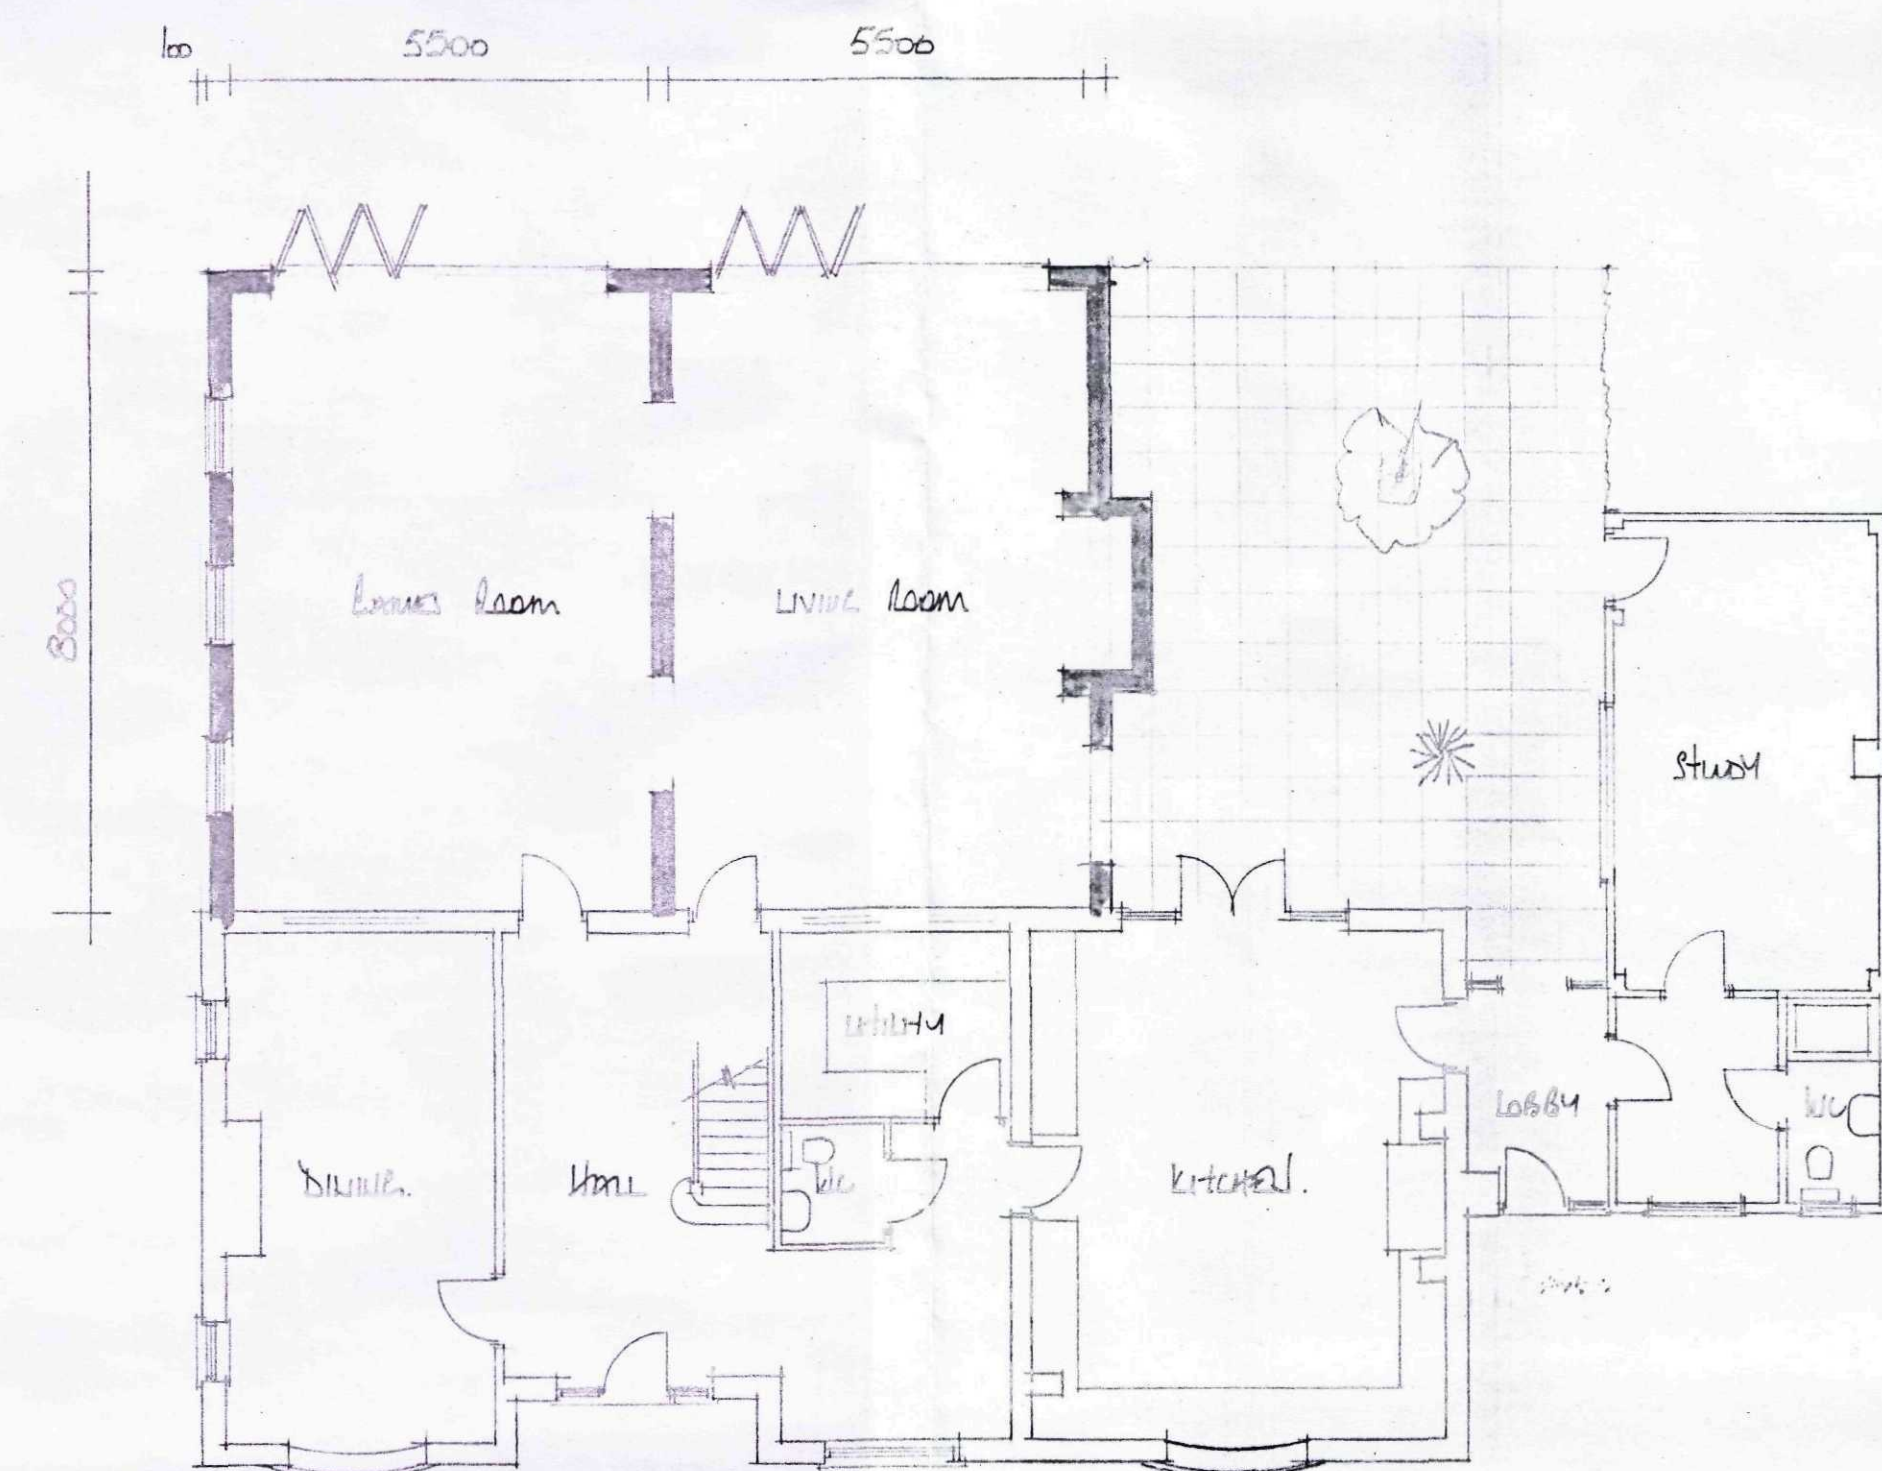

ground floor plan

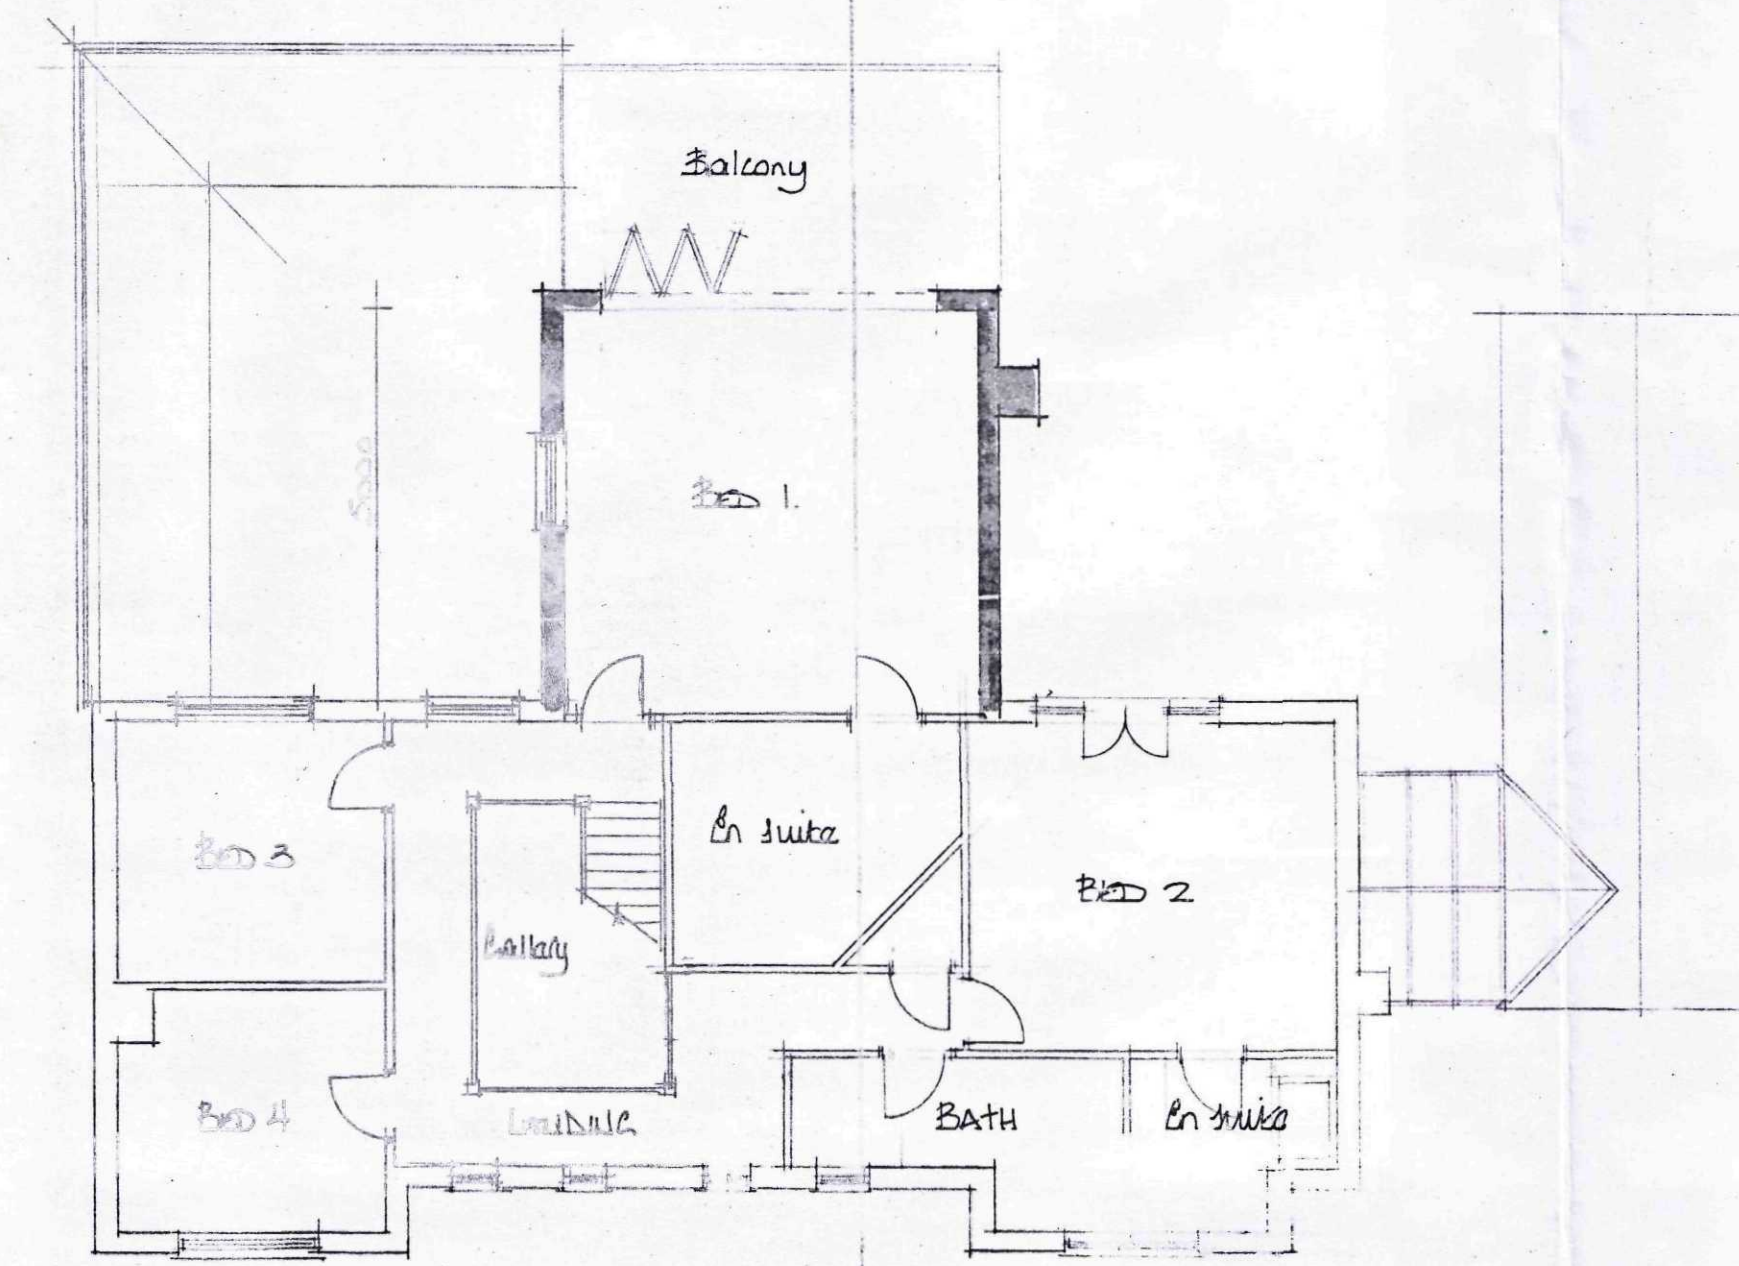

first floor plan

EAST MIDLANDS DESIGN ASSOC.

Architectural Consultants

Willow Lodge
Horseshoe Road
Spalding
Lincs
PE11 3JA

Tel/fax :- 01775 767968
Email :- willowlodge@talktalk.net
Mobile phone :- 07710825044

Client
MR N & MRS J PICKETT

Project
Extension & alterations to
Lodge at Gillingham
Lodge
Plot
Plot 2 BLJ
Drawing


Plans & elevations
as proposed

Scale
1:100 & 1:250


Date
Dec '10
Drawn
BL

DWG No.
REV


07104/20

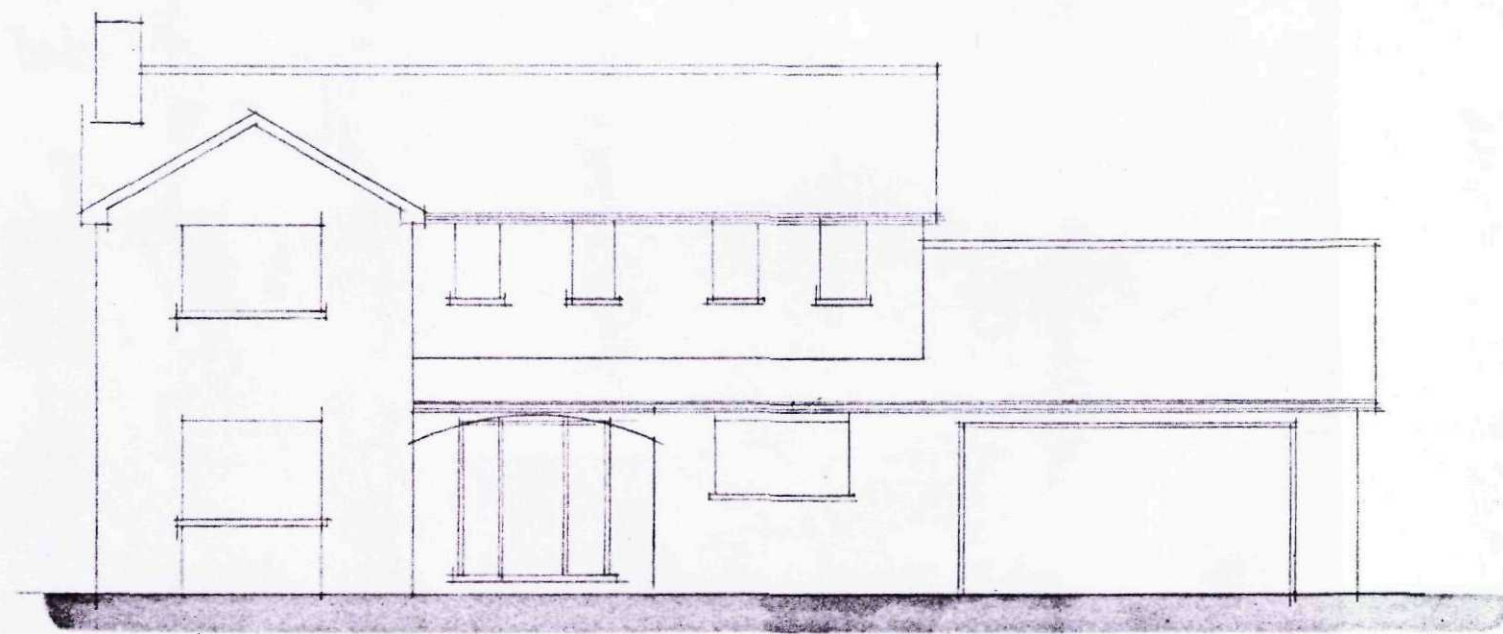


east

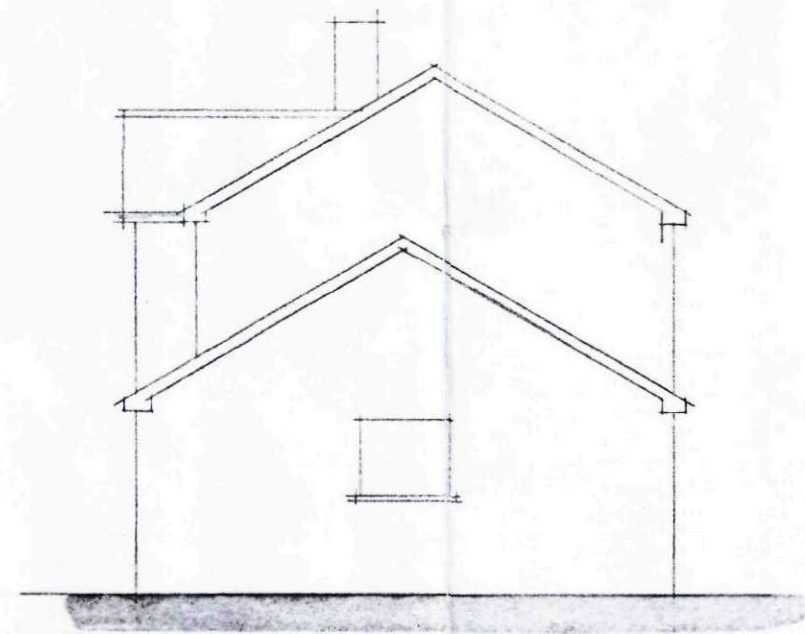


north

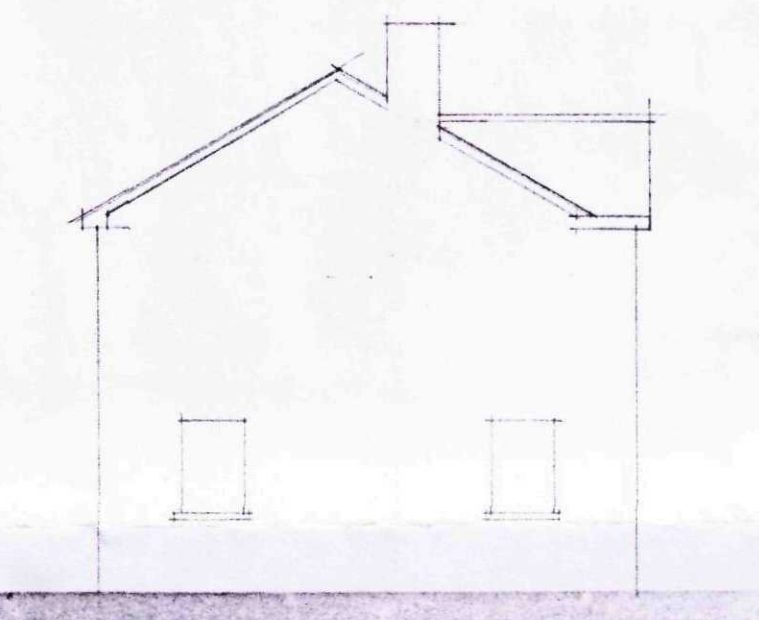


south

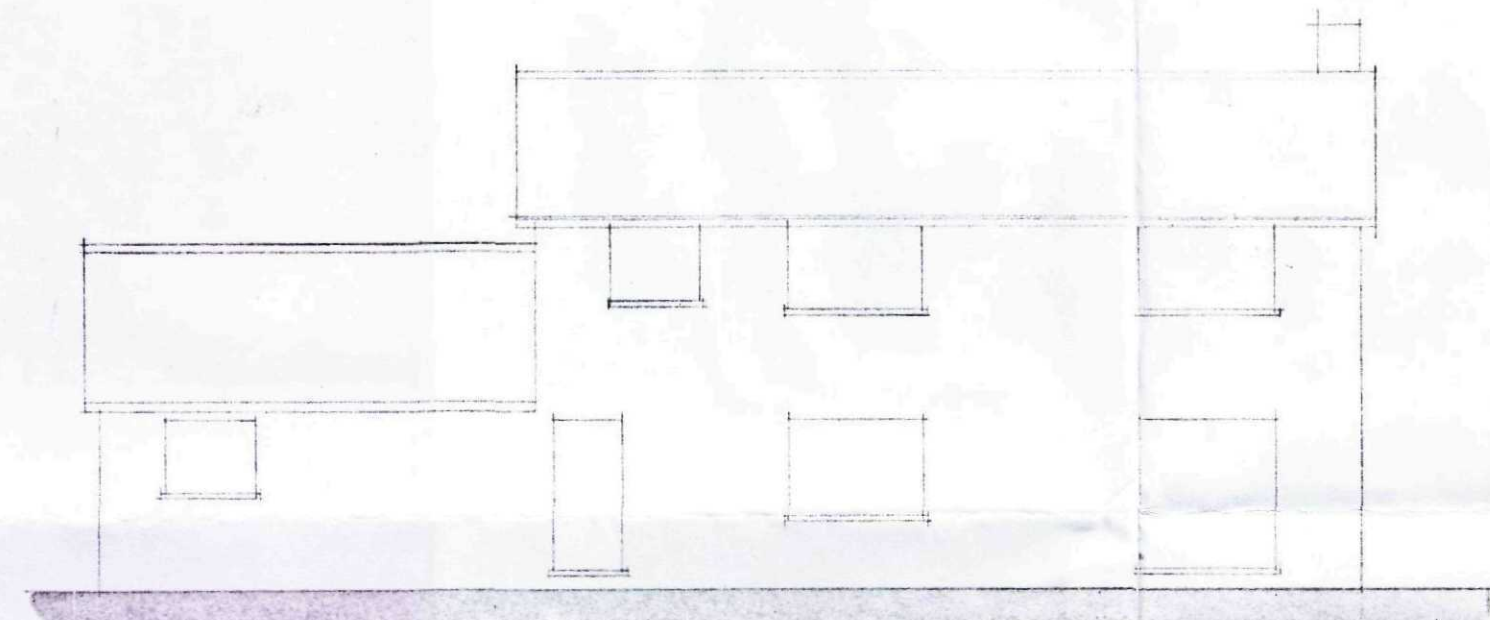

west

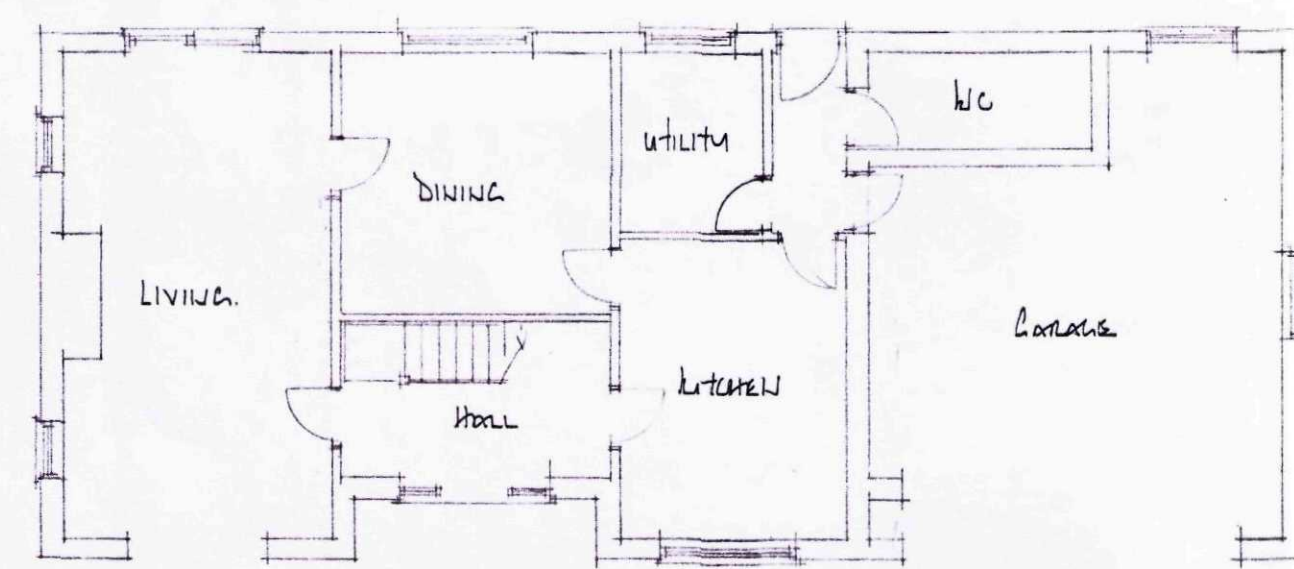

ground floor

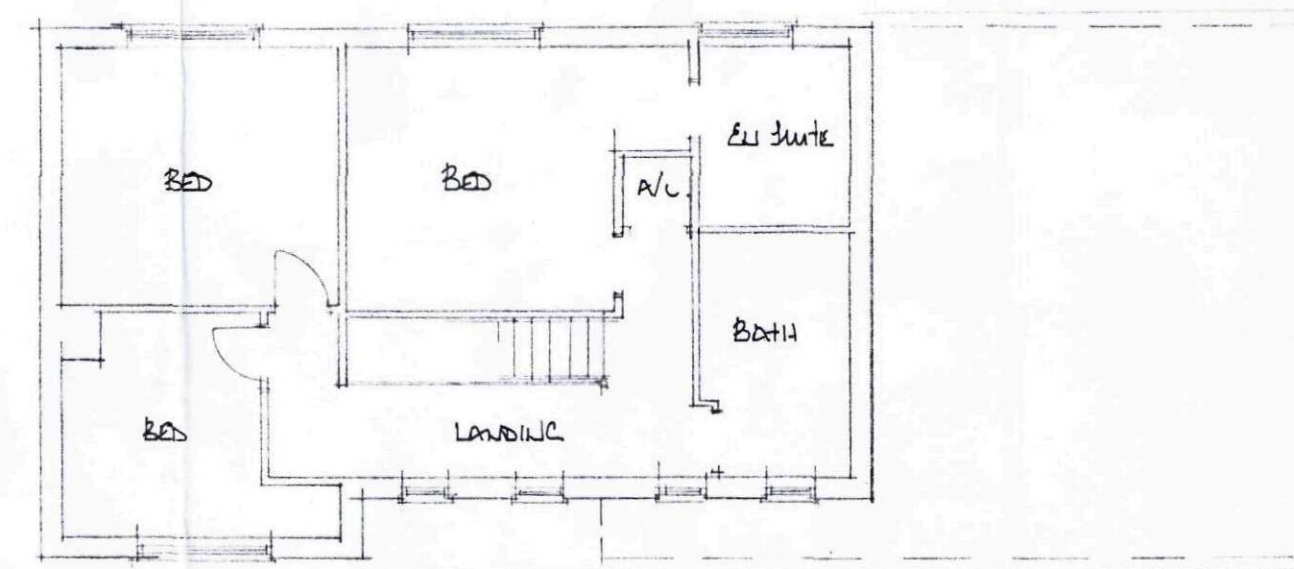

first floor

EAST MIDLANDS
DESIGN ASSOC.

Architectural Consultants

Willow Lodge
Horseshoe Road
Spalding
Lincs
PE11 3JA

Tel/fax :- 01775 767968
E-mail :- willowlodge@zoom.co.uk
Mobile phone :- 07710 815044

Client

MR N & MRS T PICKETT

Project

EXTENSIOUS & INTERACTIVE AT
LOCATE CHANGE
LOCATE
FLEET
PER BLW

Drawing

Plans, Elevations
As Built

Scale 1:100

Date 11.08 Drawn AL

Dwg No. Rev.

07/04/10

SHDC
Planning & Development
04 JAN 2011
Ref: 000/11