

COUNTY OFFICES
NEWLAND • LINCOLN

LINCOLNSHIRE COUNTY COUNCIL

City Hall, Lincoln LN1 1DN
Telephone (01522) 552222 Fax (01522) 553149
Minicom (01522) 552055

HIGHWAYS and PLANNING DIRECTORATE

Director: *Paul Kirby* *Acme Director*

Paul Jameson

FAC Steve Thom
Planning Officer

DG

*Maps attached with apology for error
emission from my letter dated 16/6/00.*

Karen Barker


WITH COMPLIMENTS

Lincolnshire - Part of the East Midlands Region





Printed on
Recycled Paper



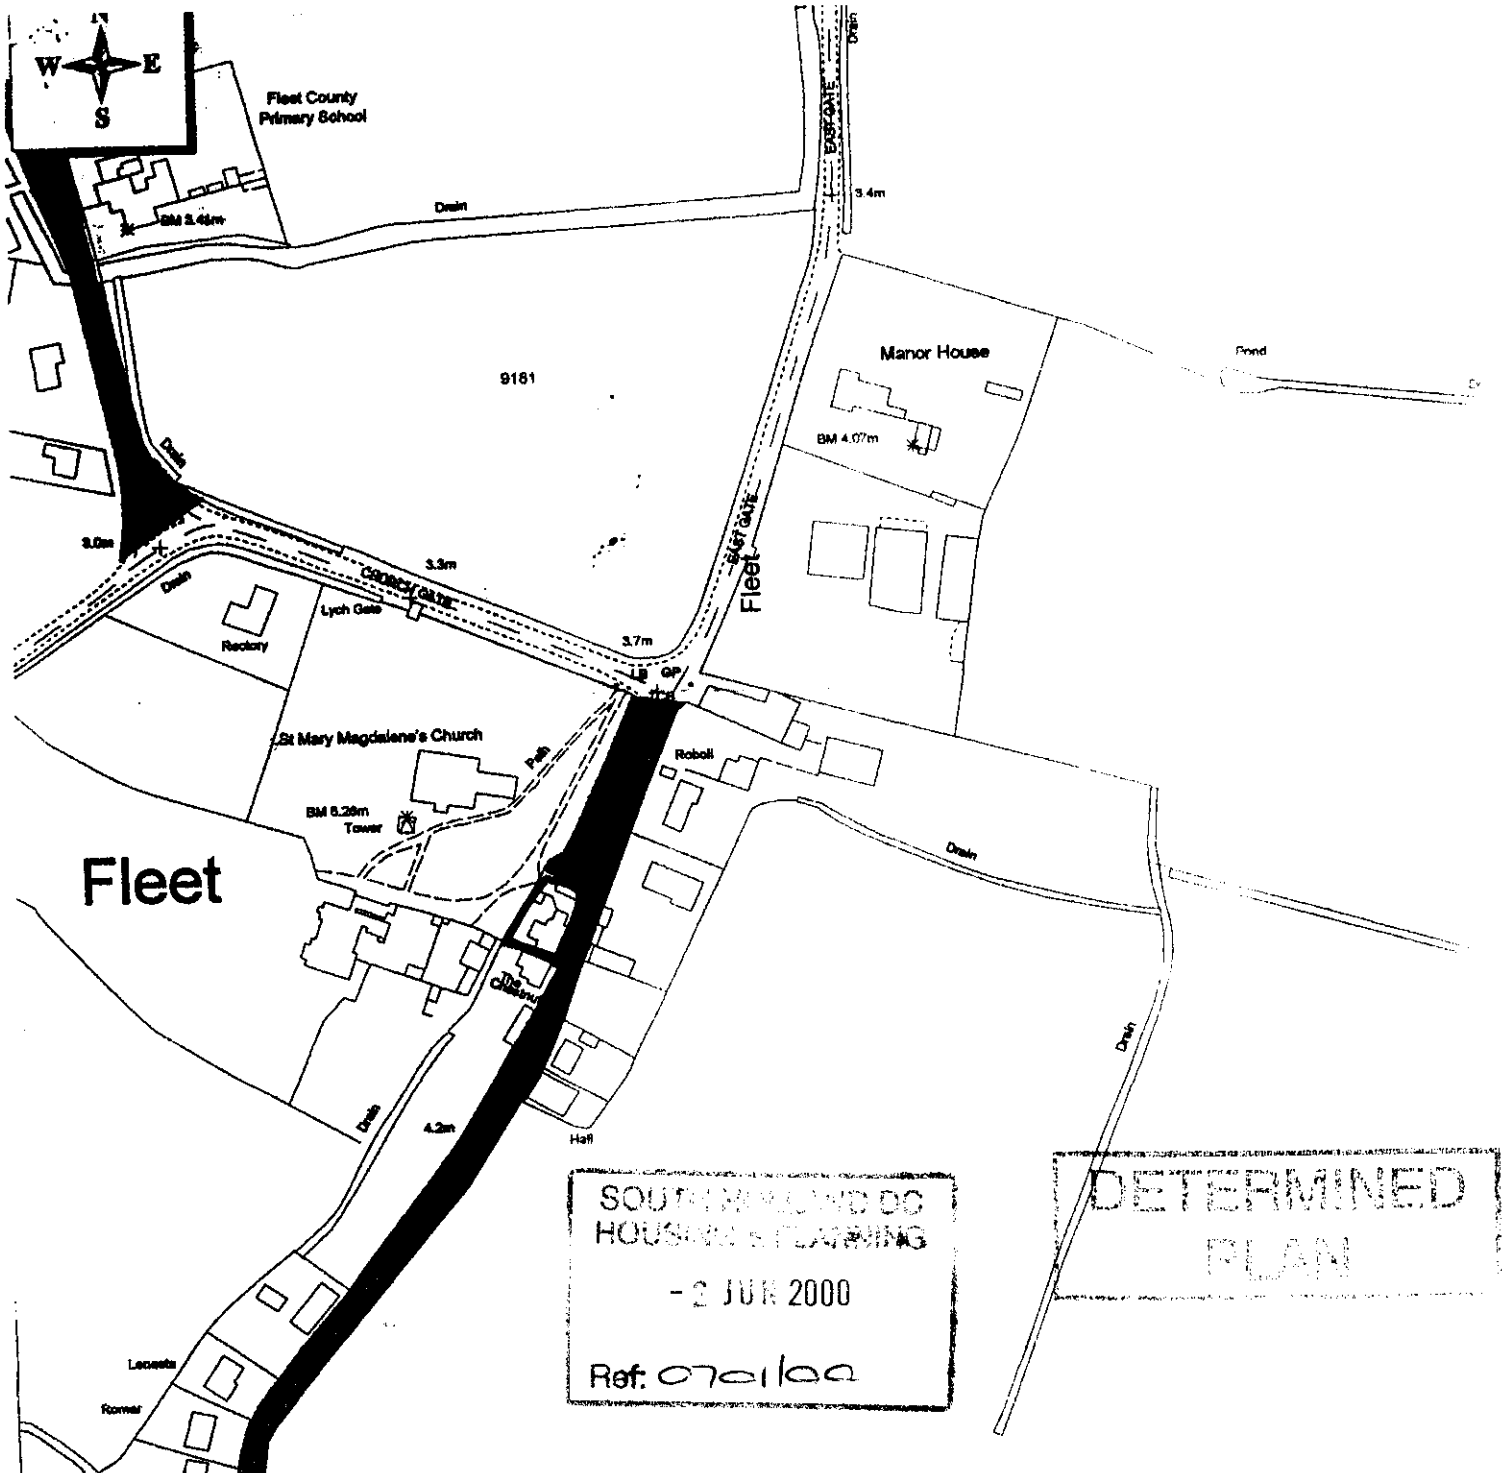

SOUTH NEWLAND DC
HOUSING & PLANNING
- 2 JUN 2000
Ref: 0701/00

DETERMINED
PLAN

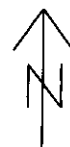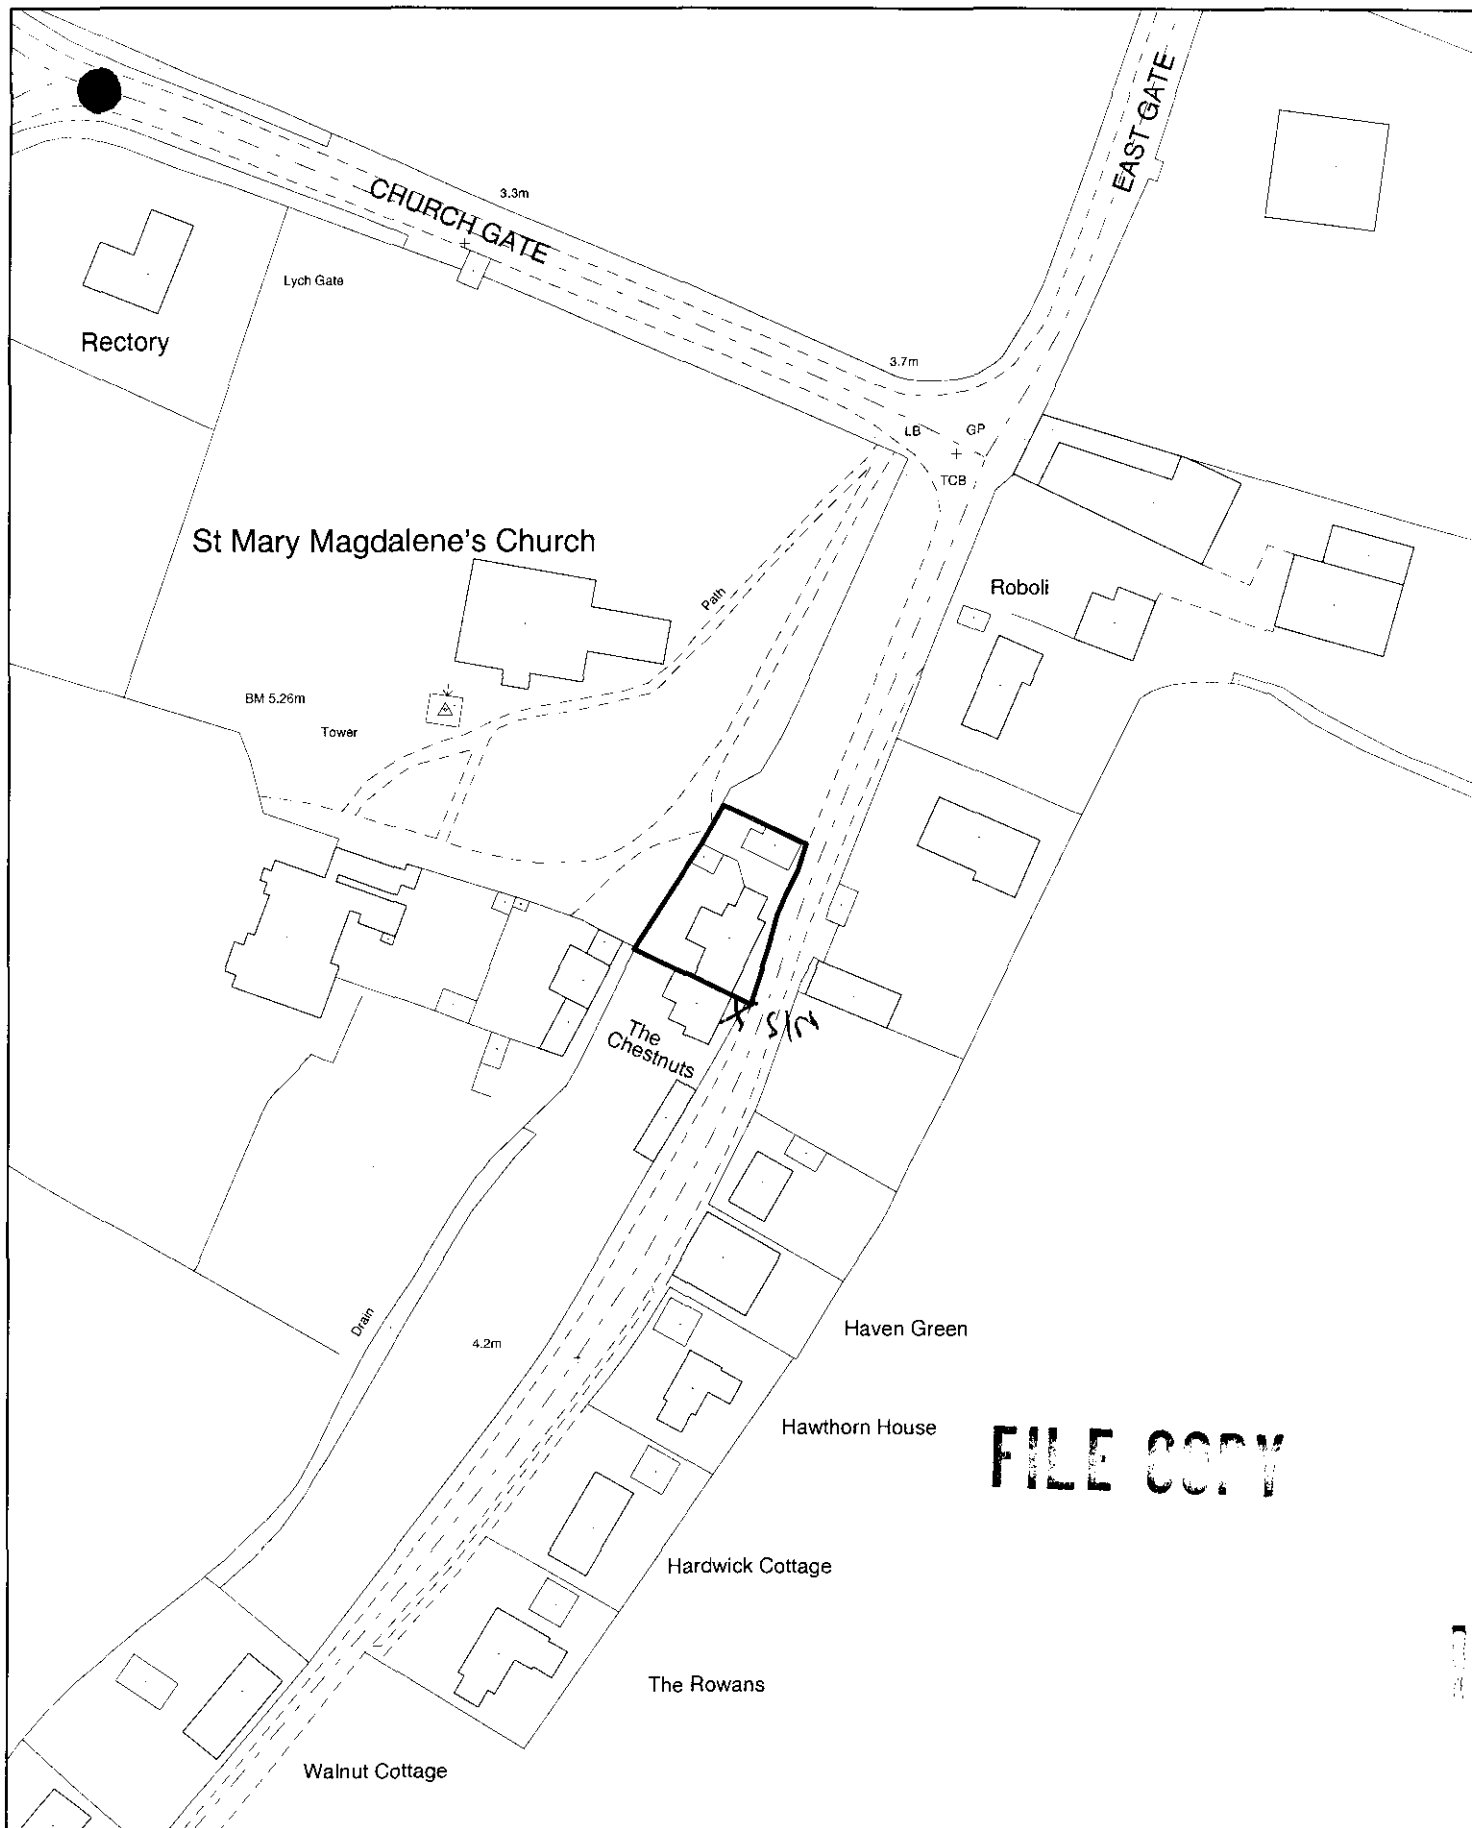

9181

Manor

BM 4.07m

EAST GATE
Fleet

3.3m

CHURCH GATE

Lych Gate

Rectory

3.7m

LB GP

TCB

St Mary Magdalene's Church

Path

Roboli

BM 5.26m
Tower

The Chestnuts

Drain

4.2m


Hall

SOUTH HOLLAND DC
HOUSING & PLANNING

23 JUN 2000

Ref:

~~proposed diversion~~ proposed diversion
of claimed public
footpath onto
highway verge
+ church property
(N.B. The Diversion may
not ~~be~~ proceed)

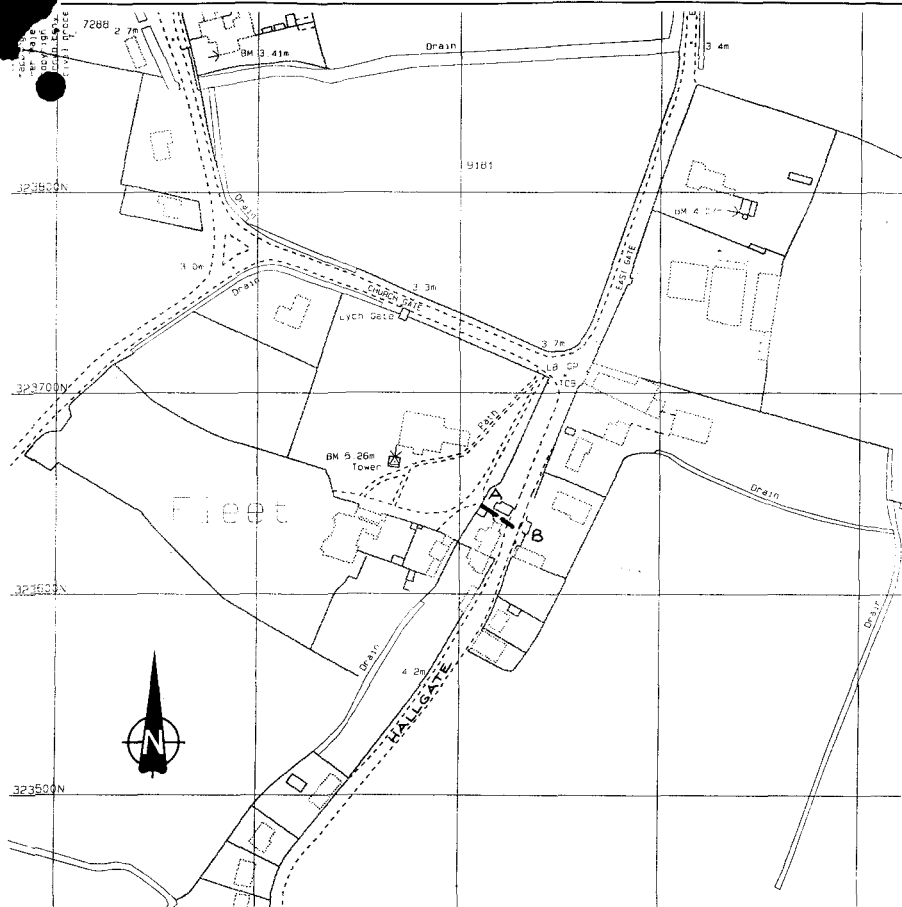

LEGEND

--- Claimed public footpath

SOUTH LINCOLNSHIRE
HOUSING & PLANNING

23 JUN 2000

Ref

PAUL KIRBY
DIRECTOR OF HIGHWAYS AND PLANNING

LINCOLNSHIRE COUNTY COUNCIL

Dr/Date
G.L.B. 5/98
Scale
1:2500
Checked
Approved

FLEET :-
(Definitive Map Modification Order)
addition of claimed public footpath
from Hallgate to Church property

Lincolnshire County Council
County Offices, Lincoln

Reproduced from/based upon the
O.S. Map with the sanction of the
Controller of H.M. Stationary Office.
CROWN COPYRIGHT RESERVED

O.S. sheet reference
TF 3823

File/Holding No.
PL/C/B/6

Drawing No.
A4/1153/4

20 MAY 1998

License No LA27134