



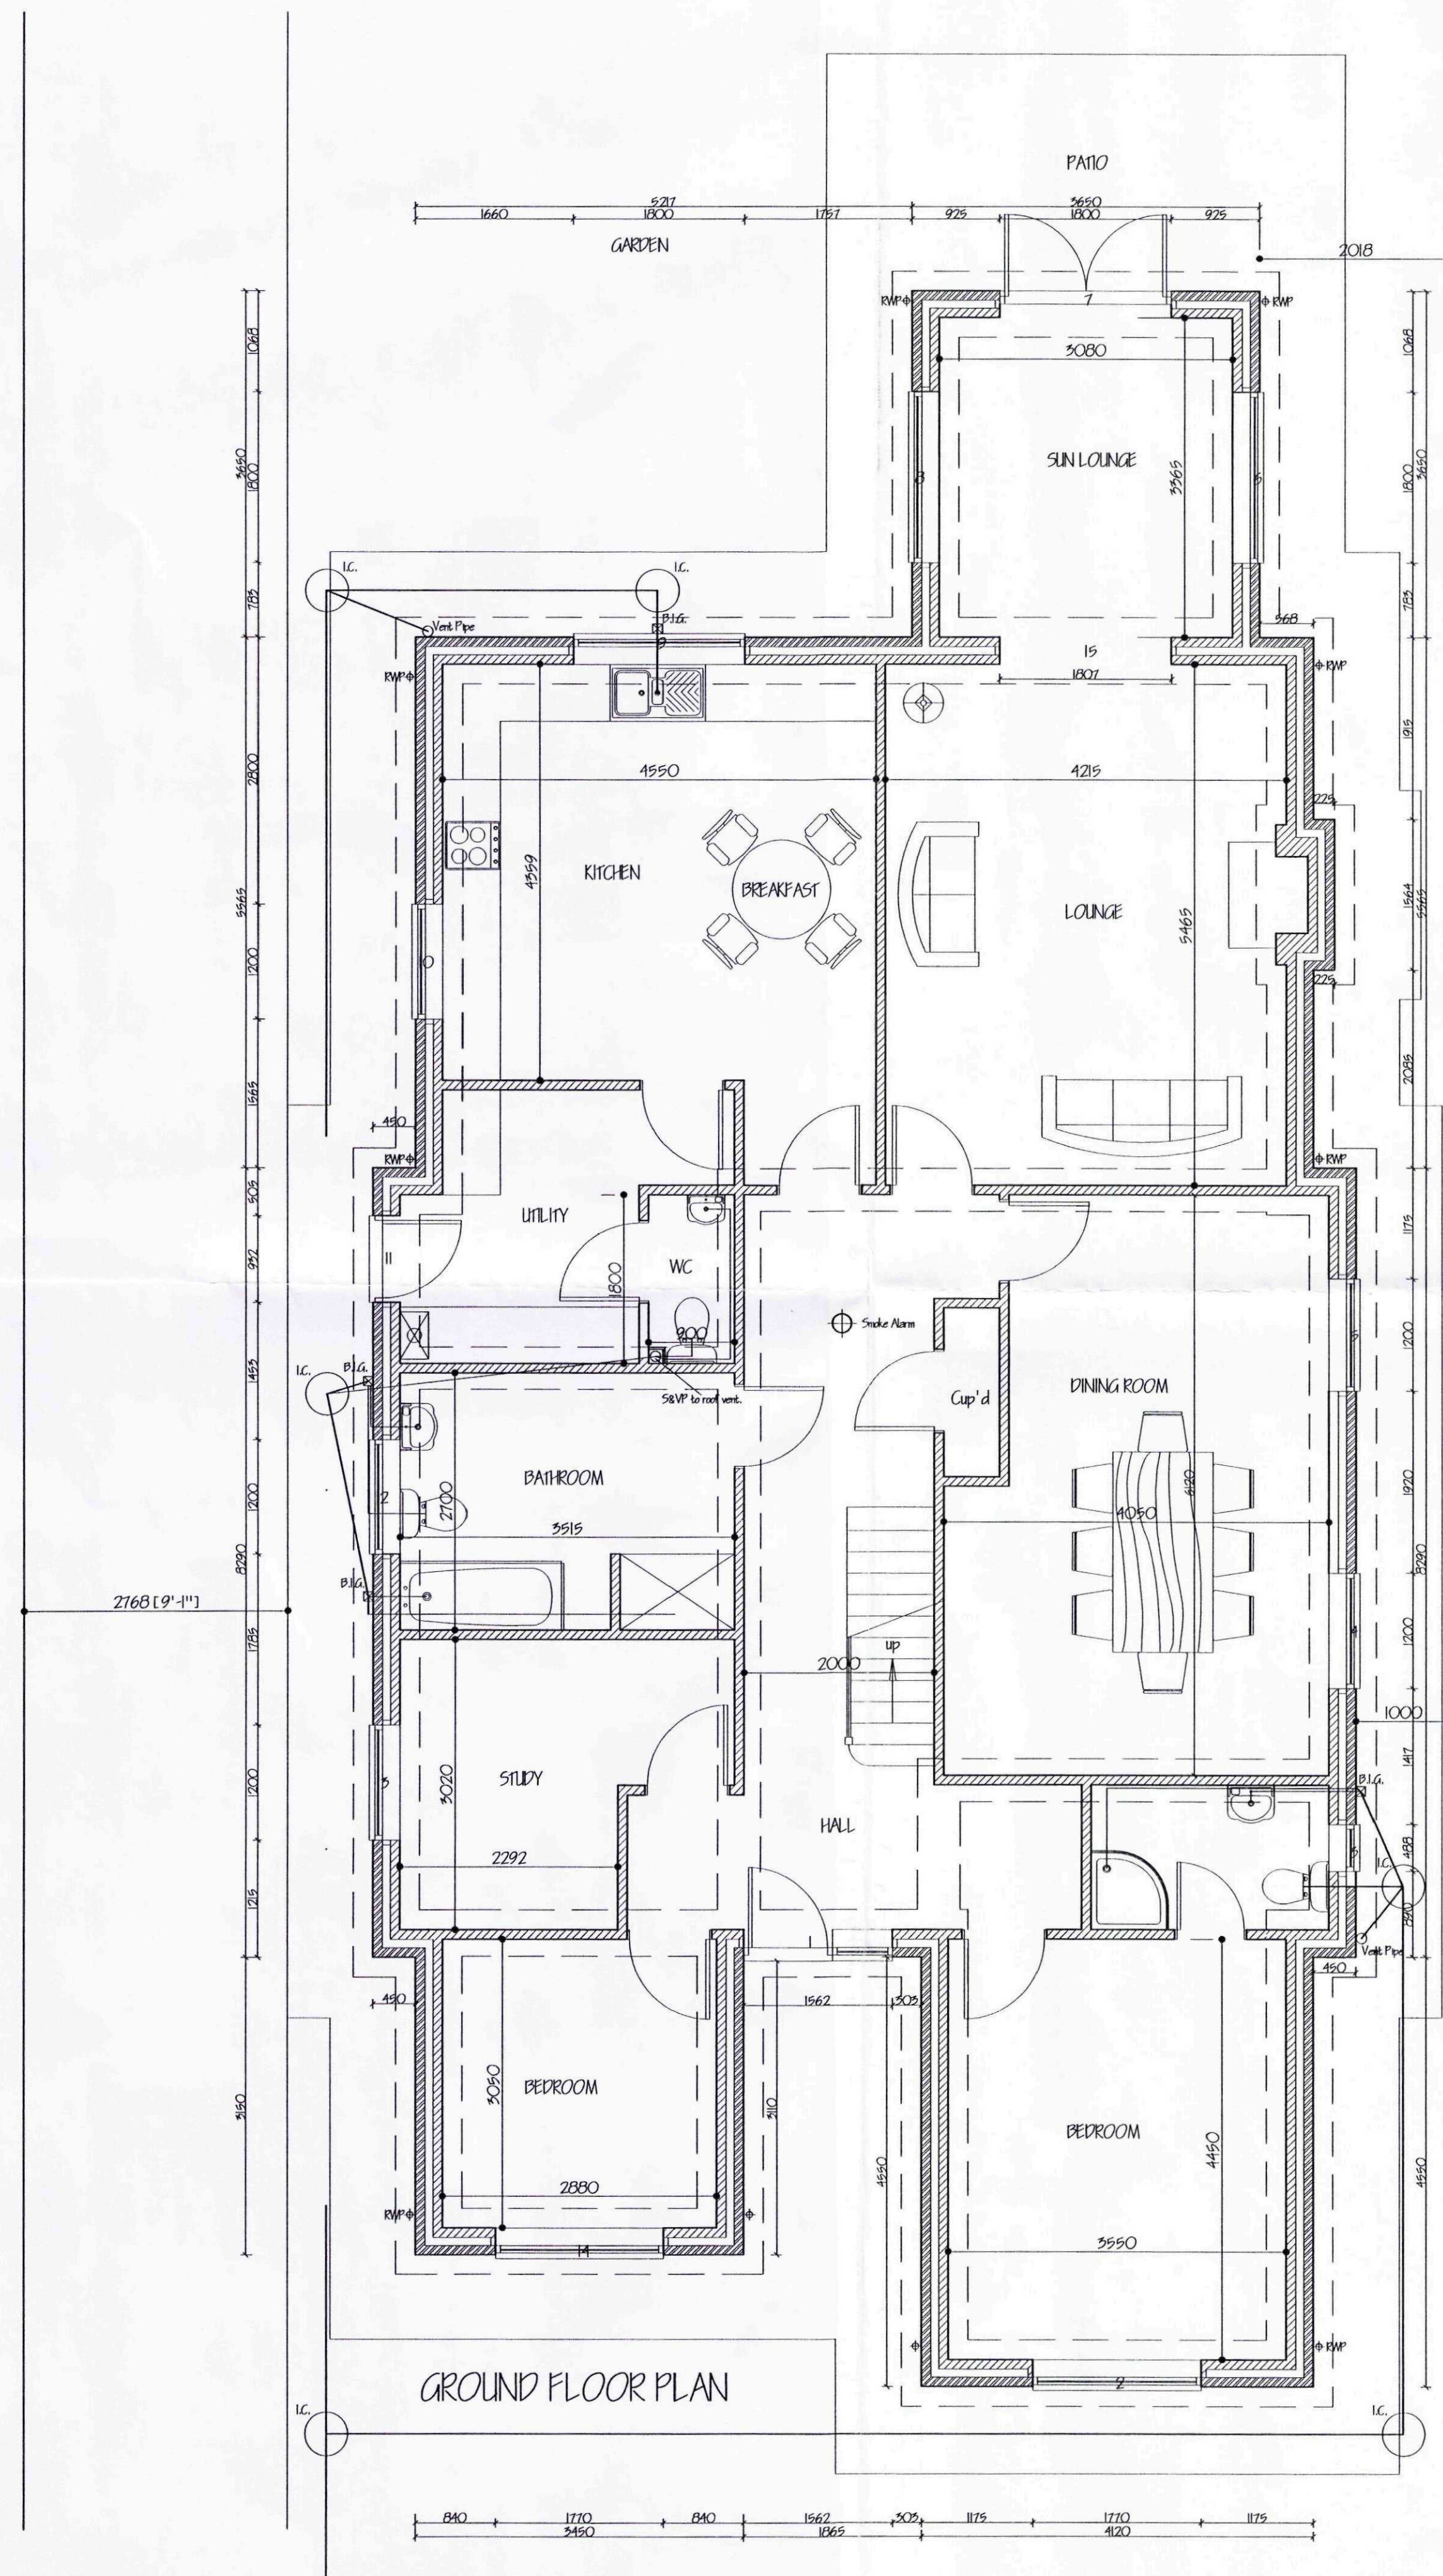


Opening schedule -


Ref	Opening Description	Opening Size	Lintel Type	Lintel Length
1	JFVC Entrance Door	1962w x 2000h	U/HP TS	1900mm
2	JFVC Window	1770w x 1200h	U/5 TS	1800mm
3	JFVC Window	480w x 1090h	U/5 TS	800mm
4	JFVC Window	1200w x 1200h	U/5 TS	1800mm
5	JFVC Window	1200w x 1200h	U/5 TS	1800mm
6	JFVC Window	1800w x 1560h	U/HP TS	2000mm
7	JFVC Window	1800w x 1560h	U/HP TS	2000mm
8	JFVC Window	1800w x 1560h	U/5 TS	2000mm
9	JFVC Window	1800w x 1560h	U/5 TS	2000mm
10	JFVC Window	1200w x 1090h	U/5 TS	1800mm
11	JFVC Window	1200w x 1090h	U/5 TS	1800mm
12	JFVC Window	1200w x 1090h	U/5 TS	1800mm
13	JFVC Window	1200w x 1090h	U/5 TS	1800mm
14	JFVC Window	1770w x 1200h	U/5 TS	1800mm
15	JFVC Window	1770w x 1200h	U/5 TS	1800mm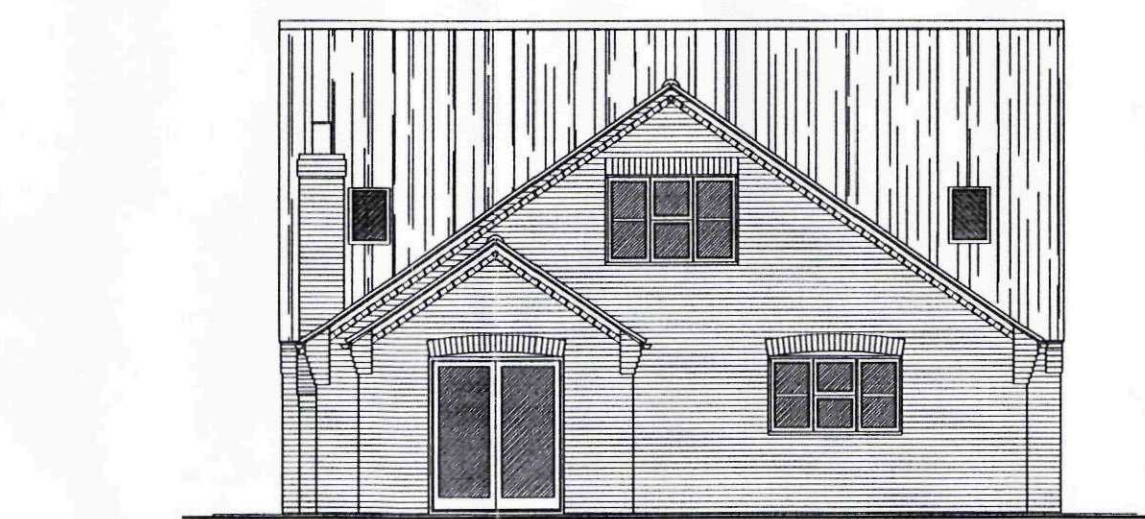

WEST ELEVATION 1:100

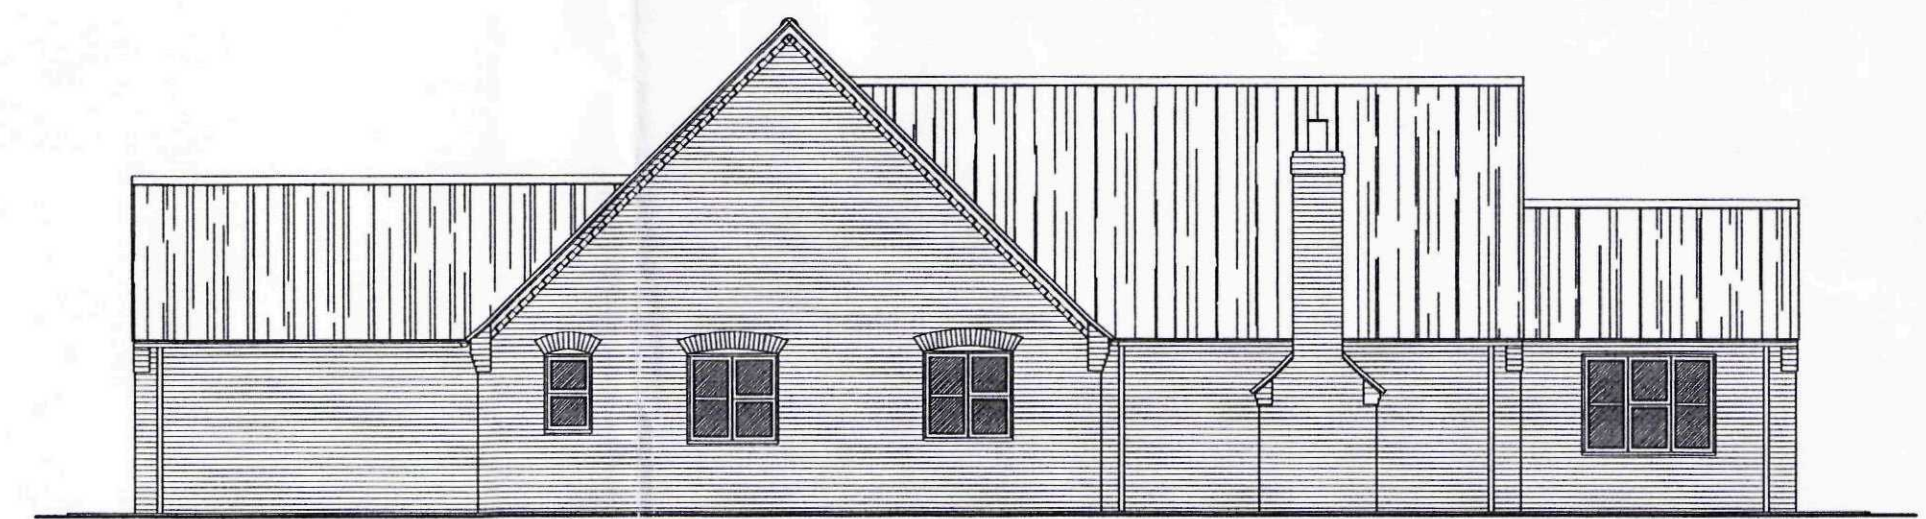


NORTH ELEVATION 1:100

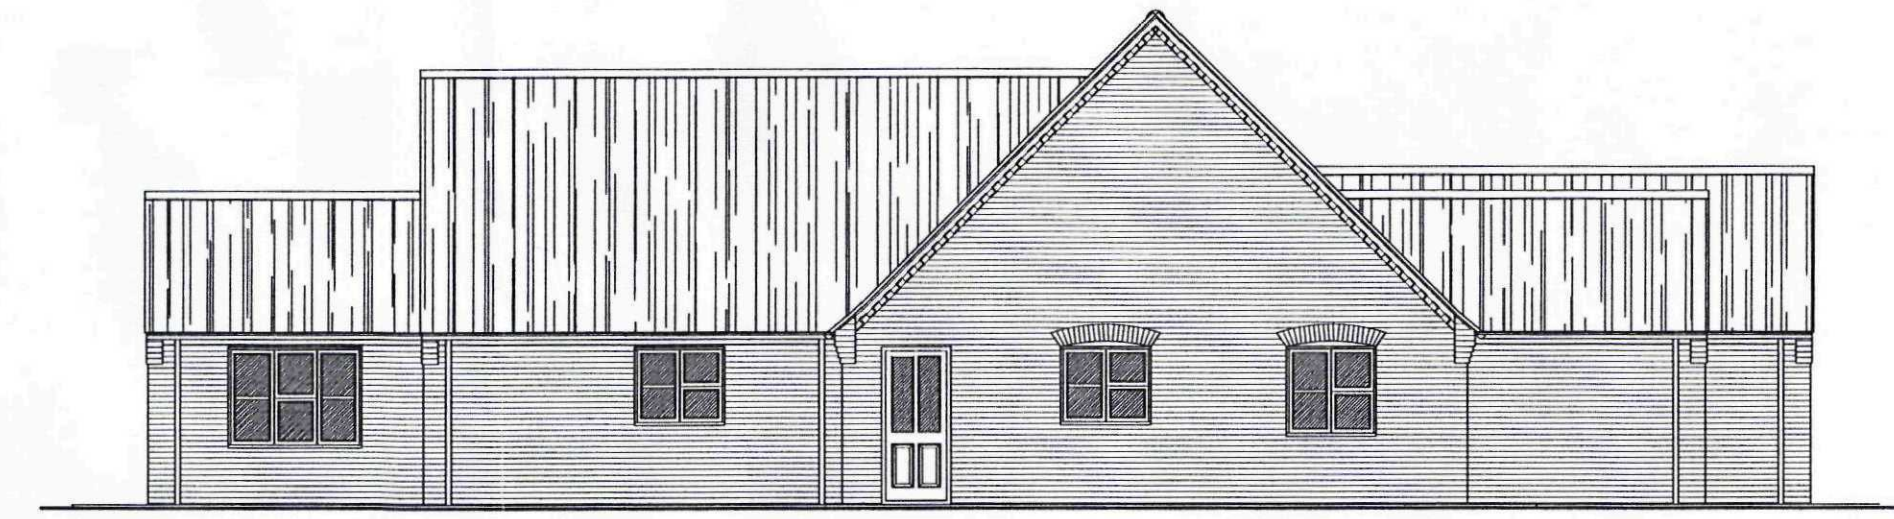

SOUTH ELEVATION 1:100

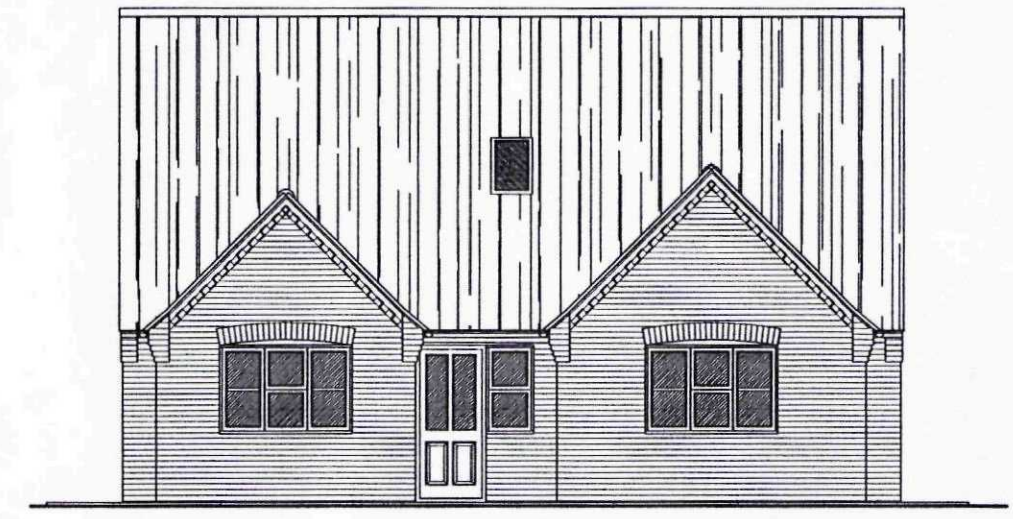

EAST ELEVATION 1:100

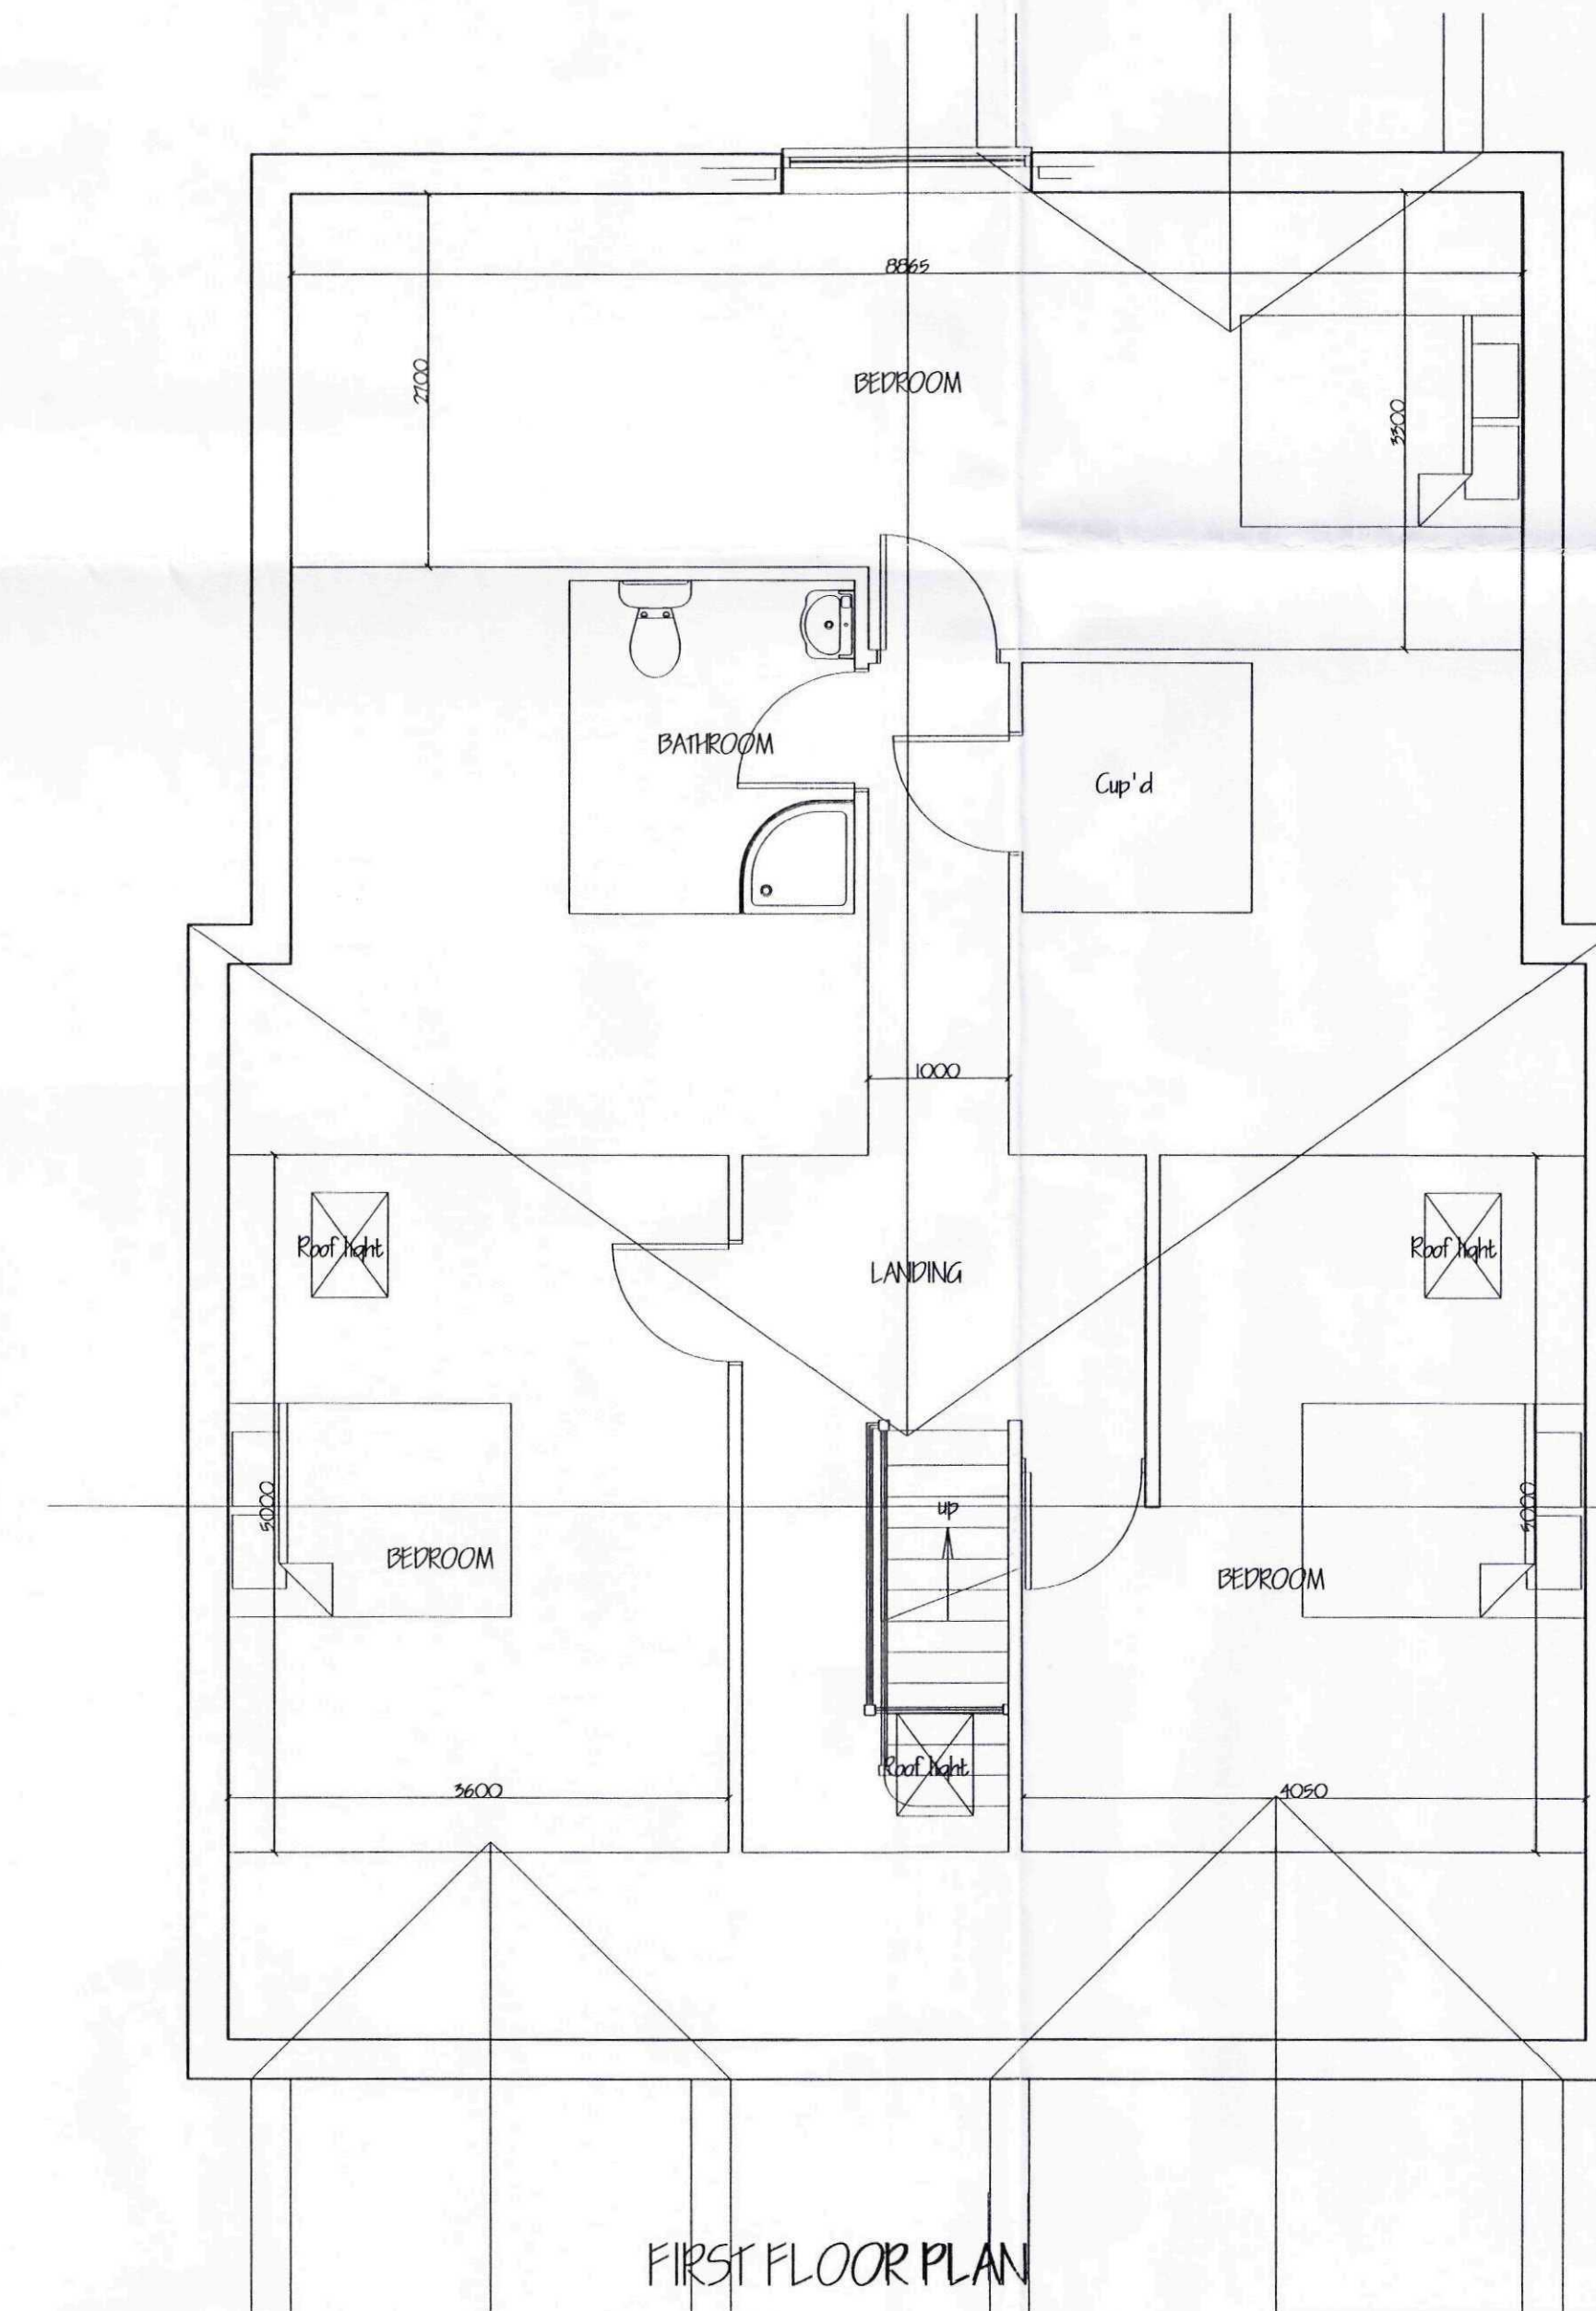

FIRST FLOOR PLAN

F	WINDOW & ROOF LIGHTS ADDED TO ELEVATIONS	MAY '10
E	AS-BUILT & FIRST FLOOR ADDED	APRIL 2010
D	BUILDING REGULATIONS AMENDMENTS	AUG '07
C	BUILDING REGULATIONS AMENDMENTS	JULY '07
B	BUILDING REGULATIONS APPLICATION	JULY '07
A	CLIENT'S AMENDMENTS	MAR '07
ref.	revision	date

G. R. MERCHANT LTD.
I. ENG AMICE FIWO
ARCHITECTURAL, STRUCTURAL
AND LAND DRAINAGE
CONSULTANTS
 4 Wrights Mews
 12A Park Road, Holbeach,
 Spalding, Lincs. PE12 7EE
 Tel: 01406 480800
 Fax: 01406 485744
 E-Mail: gr.merchant@btconnect.com

Project
 PROPOSED CHALET BUNGALOW
 ADJ. CHARTWELL
 83 GEDNEY ROAD
 LONG SUTTON

Client
 MR D WINTERTON

Drawing
 FLOOR PLAN & ELEVATIONS - PROPOSED

Job Ref.
 1504-06

Drawing No.
 02F

Date
 FEB '07

Drawn
 SLH


Scales
 AS NOTED

DO NOT SCALE FROM THIS DRAWING
 This drawing is copyright and may not be altered, traced, photographed or used for any other purpose other than that for which it is issued. The General Contractor is to check all dimensions on site and report any discrepancies to the Architect. All details shown on the drawing including accessories are based upon typical site conditions related to the work. No responsibility can be accepted for abnormal conditions which may be discovered during construction or those reported to the Architect as they design amendments may be considered. Site surveys are recommended in respect of foundations available specific site conditions before building begins its construction. This drawing is limited to the amount of information contained and does not purport to contain a full specification of the work. It is solely for the purpose of obtaining Planning & Building Regulations approval. This drawing must not be used as a contract document alone. The works will not be supervised or inspected on site by G.R. Merchant or any representative thereof. It is the client's or their appointed agent's responsibility to control workmanship, substitution of materials, adherence to specification, verification to contract etc. All materials to be used must be certified and all components and materials etc. to be used must be certified and installed etc. in strict accordance with manufacturer's instruction and relevant code of practice. Materials shall conform to appropriate British standard specification or BSIA certificate or European code equivalent. The Employer / Client shall ensure that the selected contractor is conversant with and abides all measures necessary to achieve compliance with Health and Safety legislation for Building sites and Work places. The Employer / Client is advised that should the works need to comply with the Construction Design and Management Regulations an independent Planning Supervisor will be required. The works shall comprise of all that is shown on the drawing and details. Work that may not specifically be shown but may be reasonably inferred as necessary to carry out the works shall be deemed to be included. It is the client's responsibility to be aware of the Party Wall etc. Act 1996 when building is close proximity to adjoining neighbour boundaries.

SHC
 Planning & Development
 19 MAY 2010
 Ref: 0415-10
FILE COPY



SITE LAYOUT
1/500

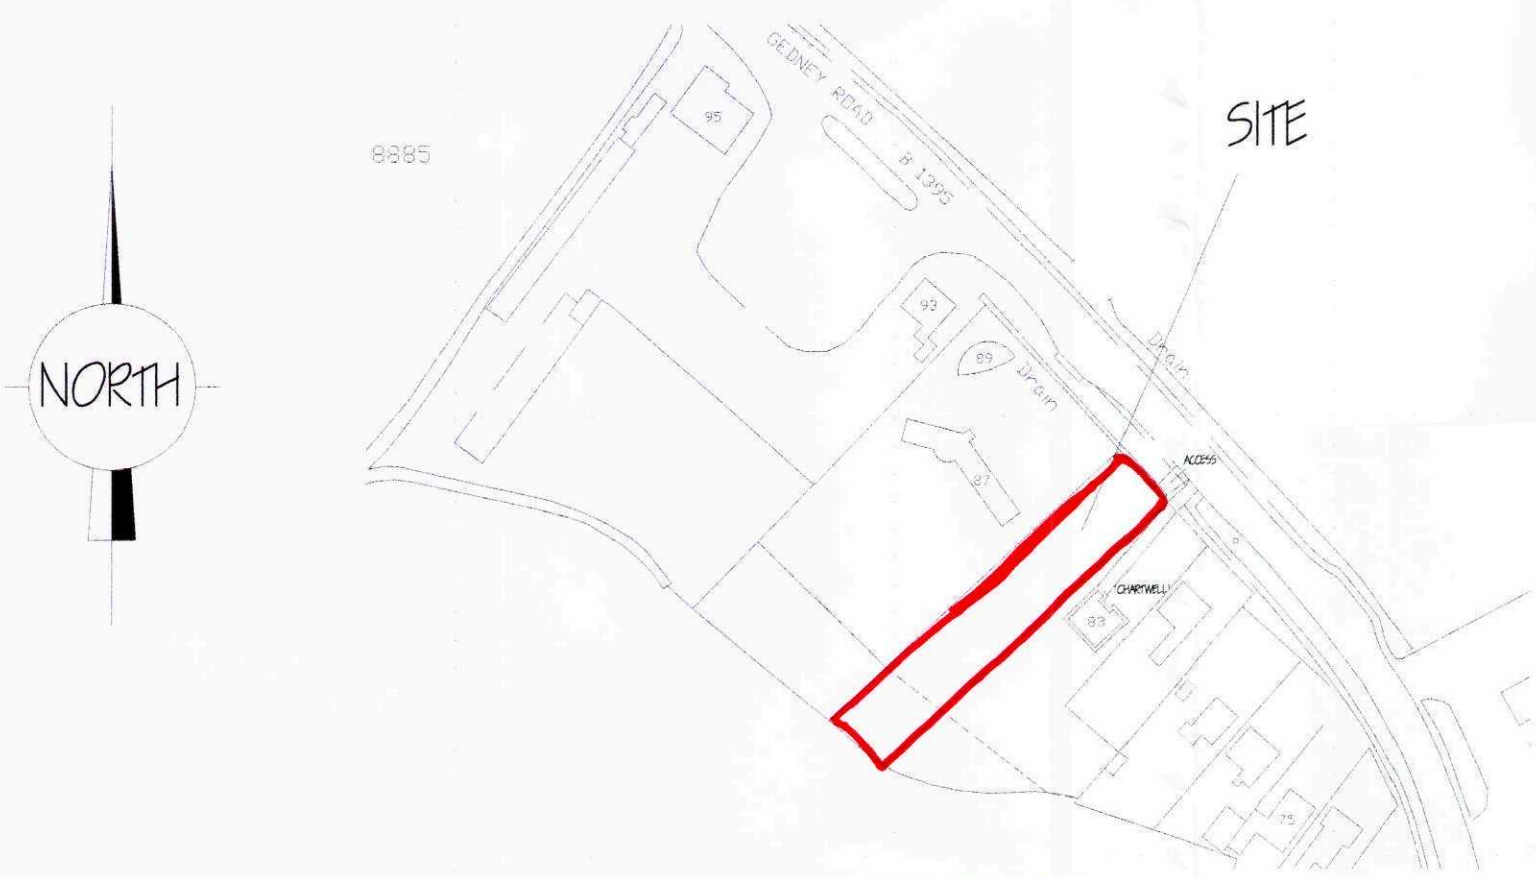

LOCATION PLAN
1/2500

LANDSCAPING & BOUNDARY TREATMENT SCHEME

- A - EXISTING MIXED HEDGE, TREES & BUSHES.
- B - HAWTHORN - Feathered.
- C - SILVER BIRCH - Feathered.
- D - WHITEBEAM - Feathered.
- E - PROPOSED ACCESS TO GEDNEY ROAD.
- F - PROPOSED DRIVE.
- G - PATIO AREA.
- H - PROPOSED 1.8 Metre HIGH CLOSE BOARDED FENCE
- J - PROPOSED 1.0 Metre HIGH CLOSE BOARDED FENCE.
- K - EXISTING ACCESS TO GEDNEY ROAD.
- L - PROPOSED MIXED HEDGE.
 - (a) Hawthorn (*Crataegus Monoquina*)
 - (b) Blackthorn (*Prunus Spinosa*)
 - (c) Buckthorn (*Rhamnus Cathartica*)

Mixed hedging to be planted in double rows using 600mm high plants at 200mm spacings in a mix comprising 25% of each species.

All planting to be in accordance with BS 4428: 1989 and ammendment no. 1 (1991)

All trees to be planted with minimum 600mm plastic mulch mat and to be staked, tied and tubed

1/3 to 1/2 bag of peat free and shrub planting compost to be incorporated into backfill for each tree hole

