



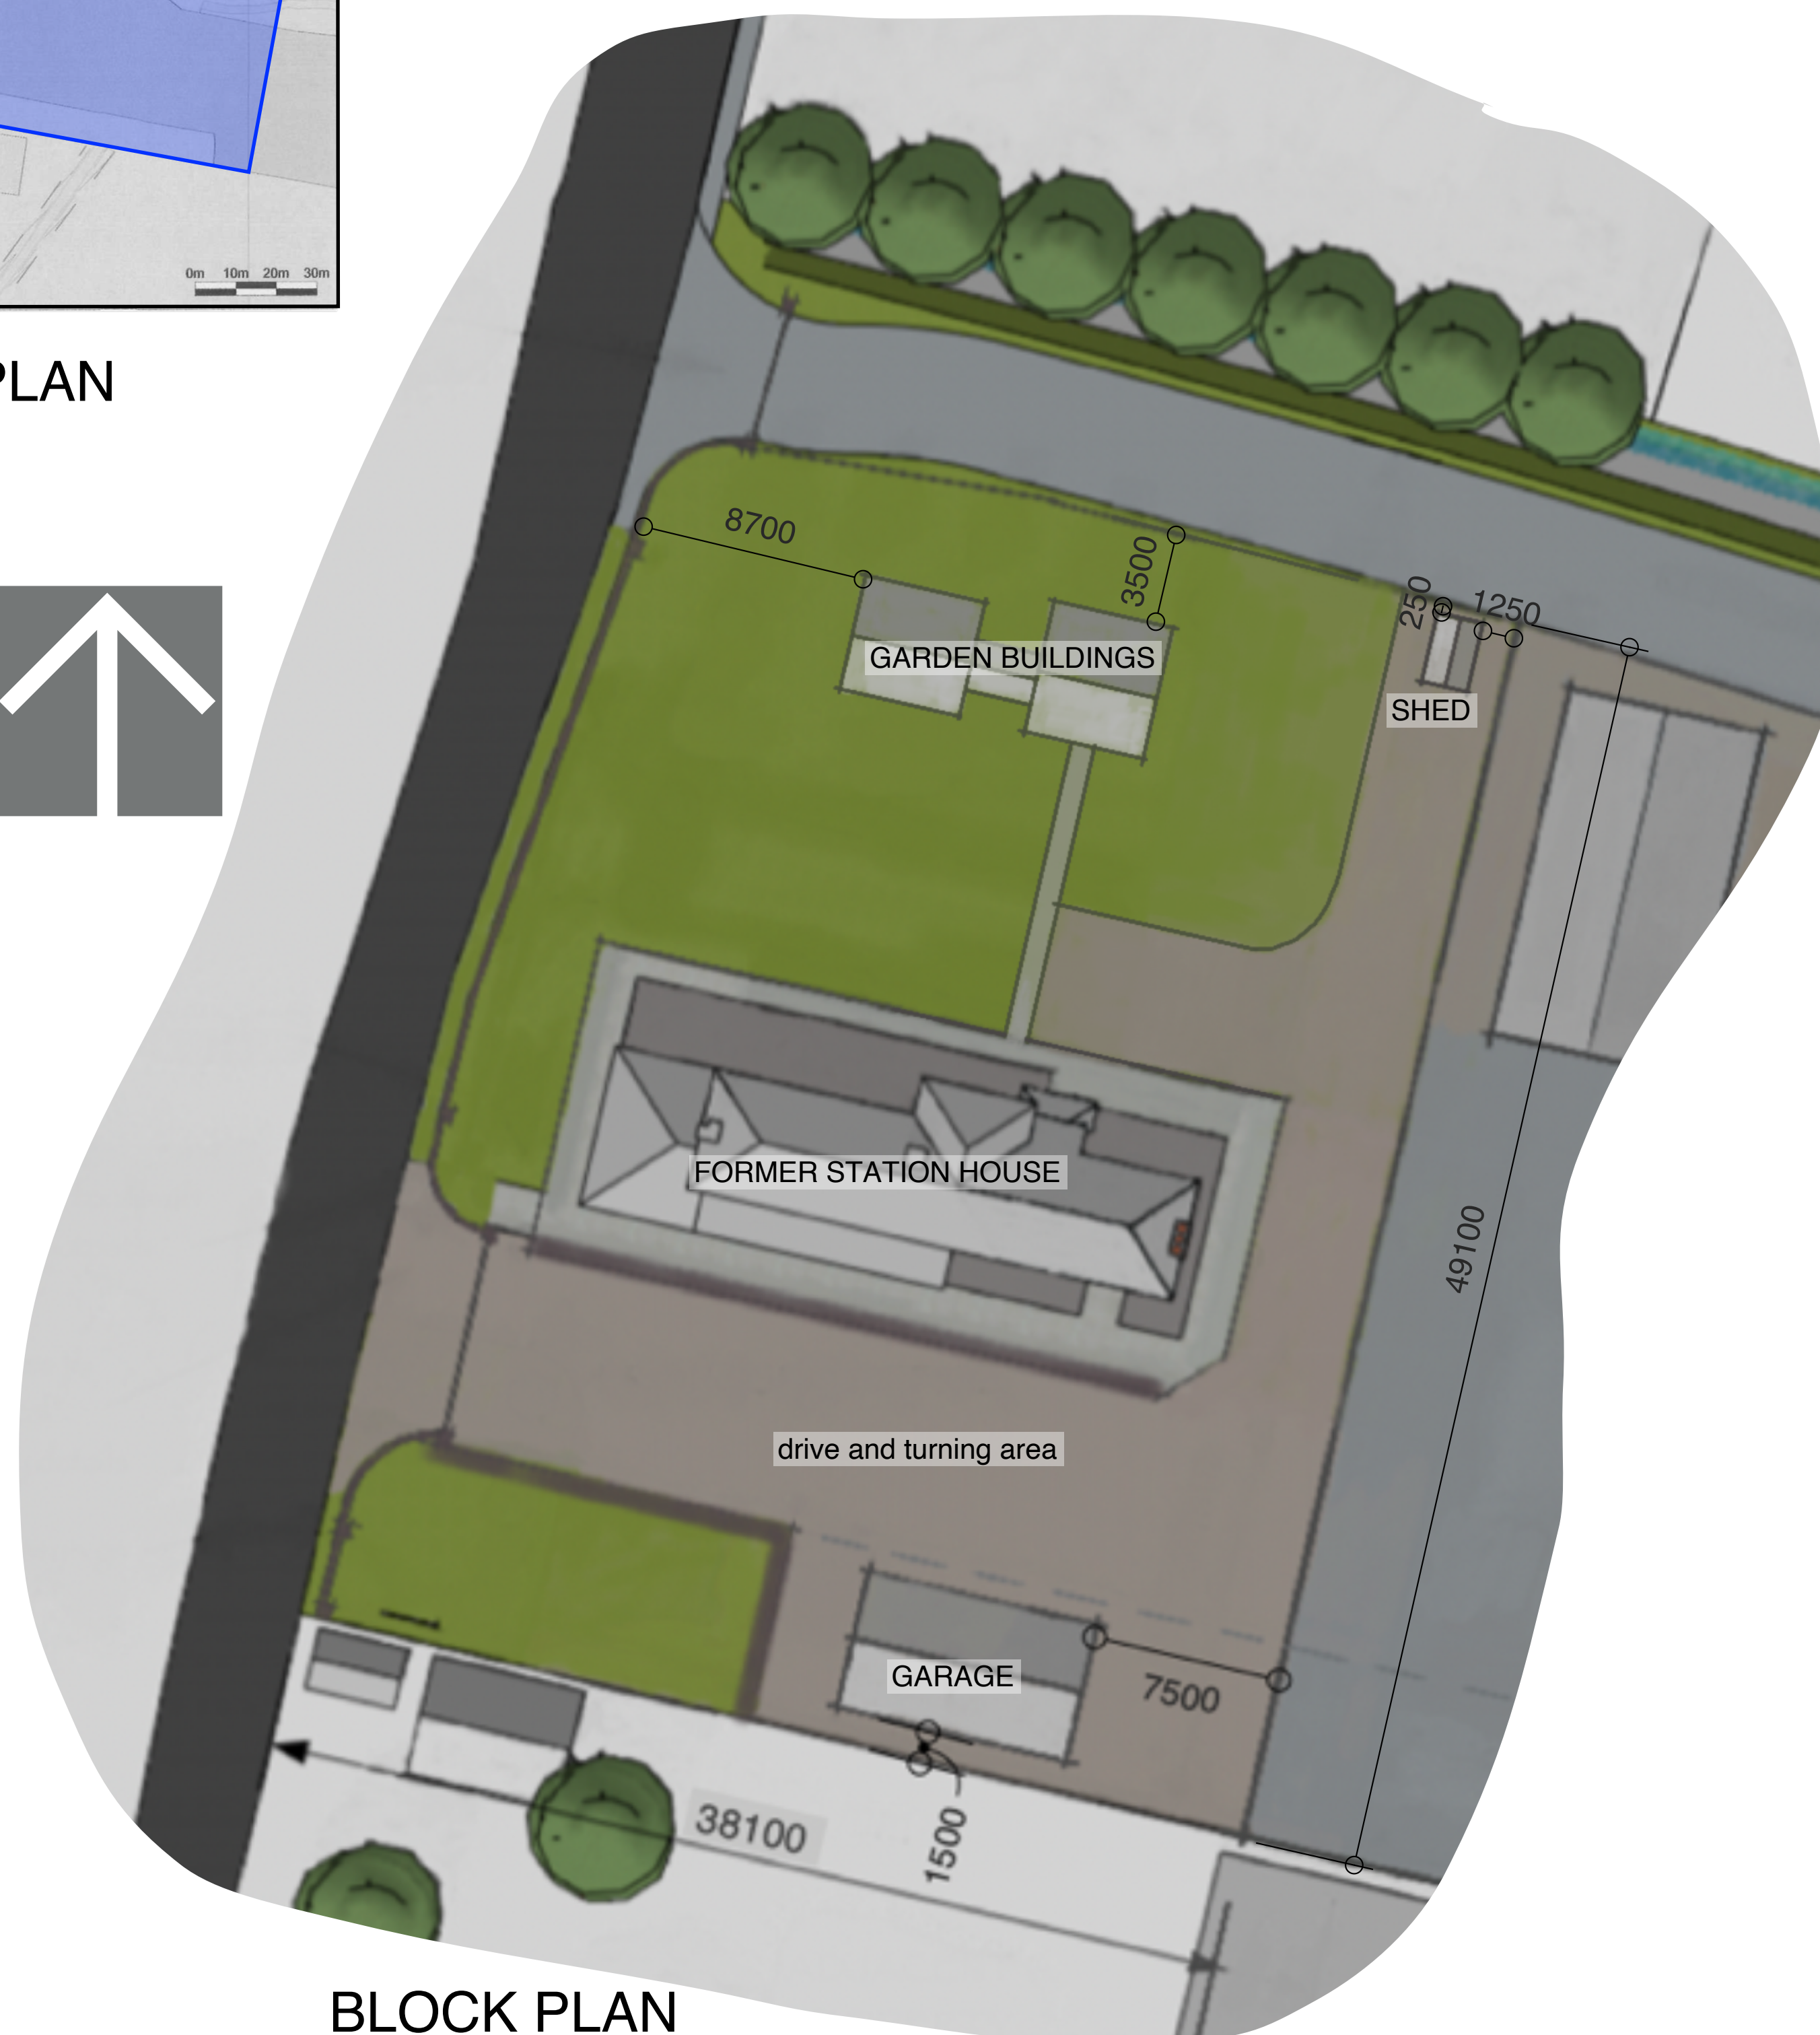

BLOCK PLAN

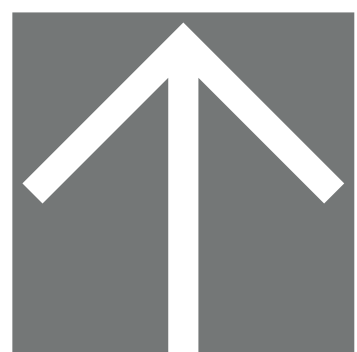

FORMER RAILWAY STATION HOUSE AT
STATION ROAD GEDNEY Lincs

A	BLUE LINE ADDED TO LOCATION PLAN	AUG 24

MR M GODFREY

AS BUILT DETAILS

AUG 24 1/1250 1/200

J079-AB 2A

Julian Warrick

Architectural Design Consultant

SEE your design. Imagine no longer how it looks. SEE how it looks

Email: julian@jwarrick-design-cons.com

Tel: 01775 820123

Mob: 07849 652067

www.JulianWarrick.co.uk

Google +

8 Beech Grove

Donington

Spalding

PE11 4XQ