


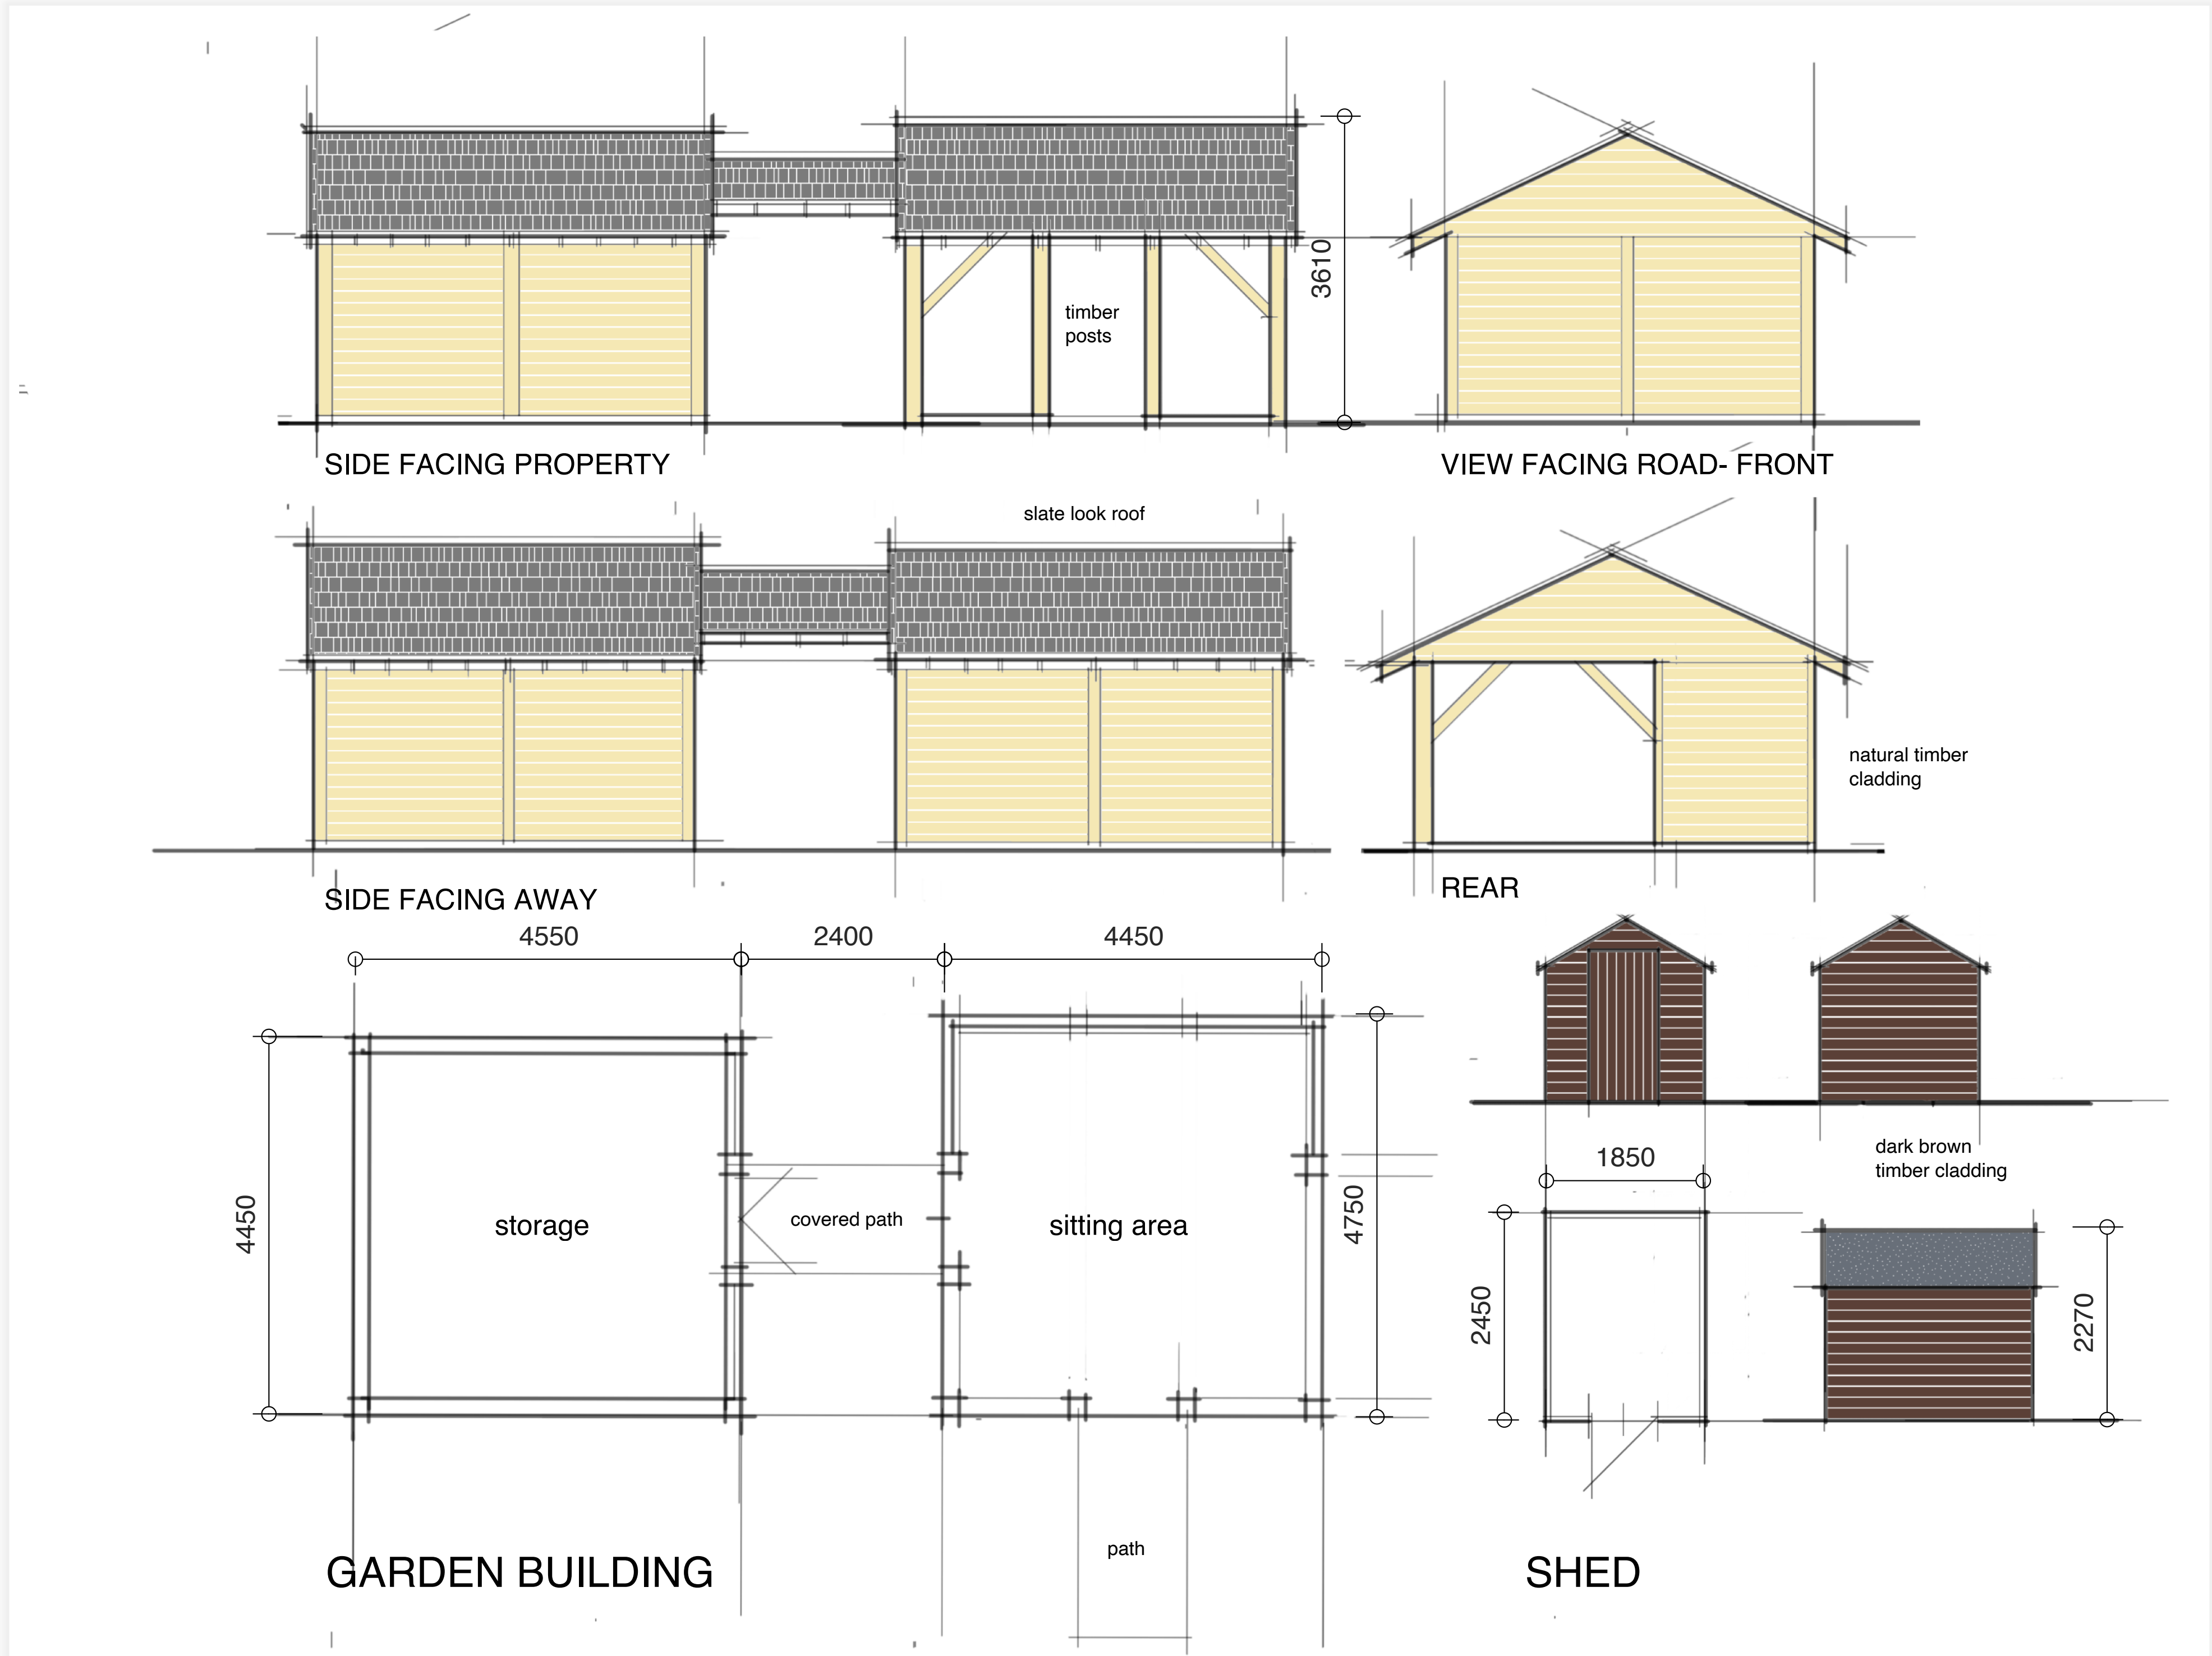

FORMER RAILWAY STATION HOUSE AT
STATION ROAD GEDNEY Lincs

MR M GODFREY

AS BUILT DETAILS

AUG 24

1/50

J079-AB 3

Julian Warrick

Architectural Design Consultant

SEE your design. Imagine no longer how it looks. SEE how it looks

Email: julian@jwarrick-design-cons.com

Tel: 01775 820123

Mob: 07849 652067

www.JulianWarrick.co.uk

Google +

8 Beech Grove
Donington
Spalding
Lincs
PE11 4XQ