




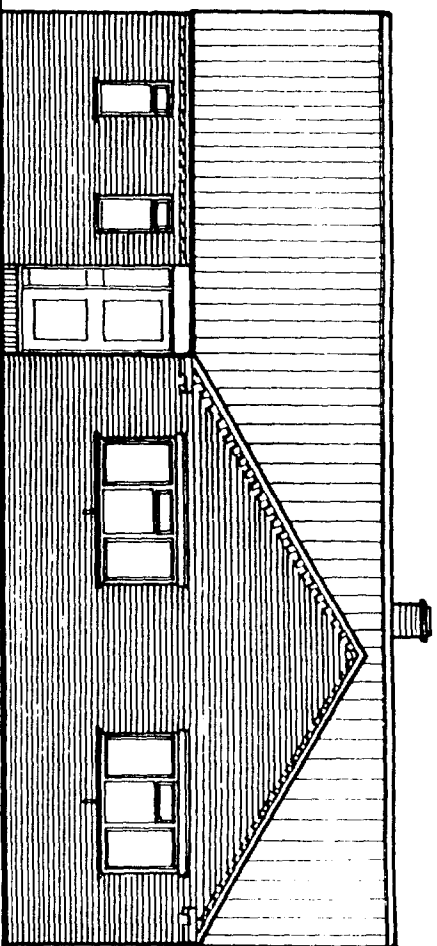


Front elevation

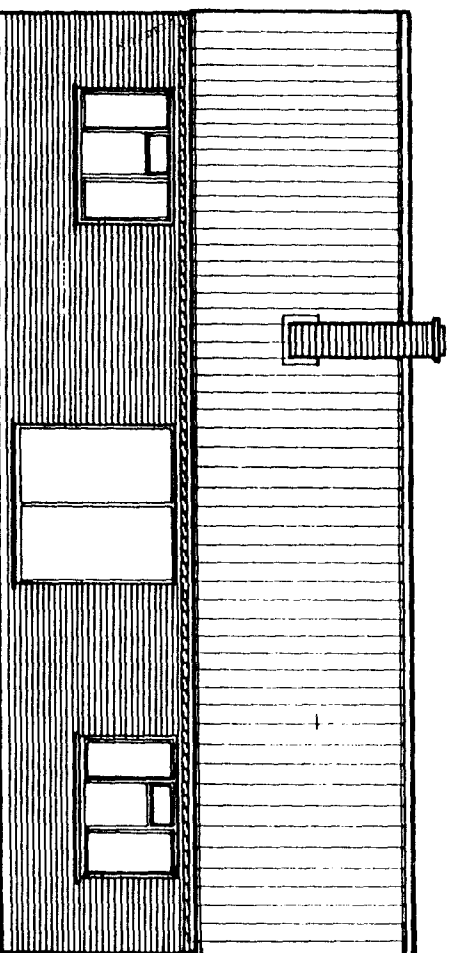


Rear elevation

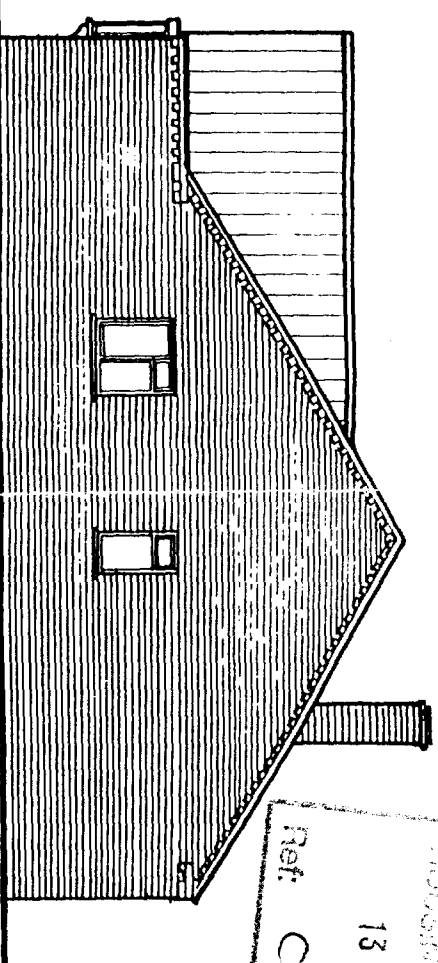

Side elevation

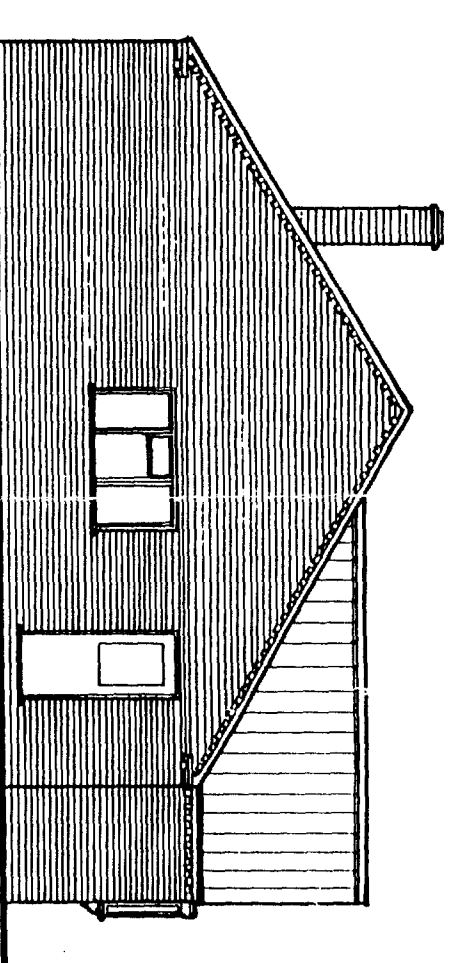

Side elevation

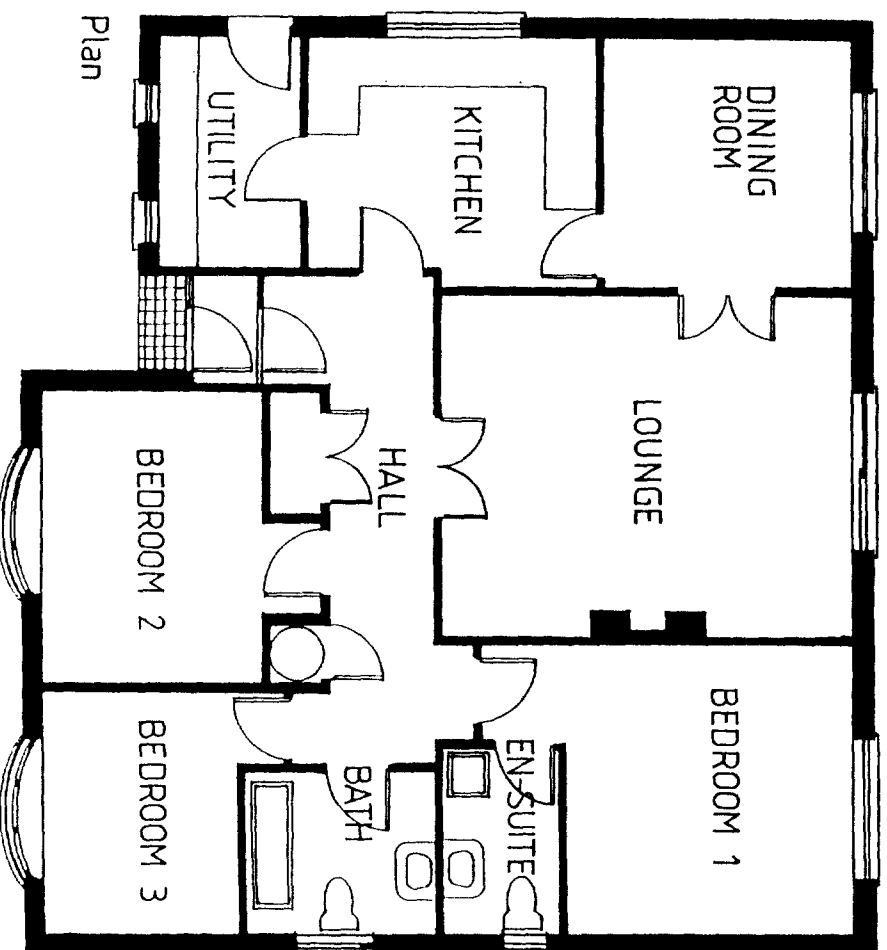

13 OCT 1997

Ref: 0782/97

DRAWING

10 OCT 1997


ISSUED

APPROVED PLAN


Ref.

Plots 1,2,3,4,6 and 7 Phase 2
St. Mary's Meadows. Gedney.


160/3/12. 1:100. June 97

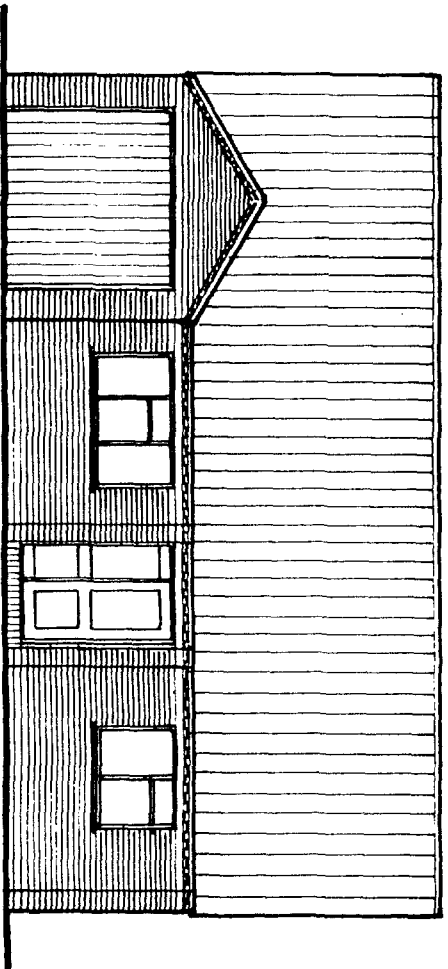


Front elevation

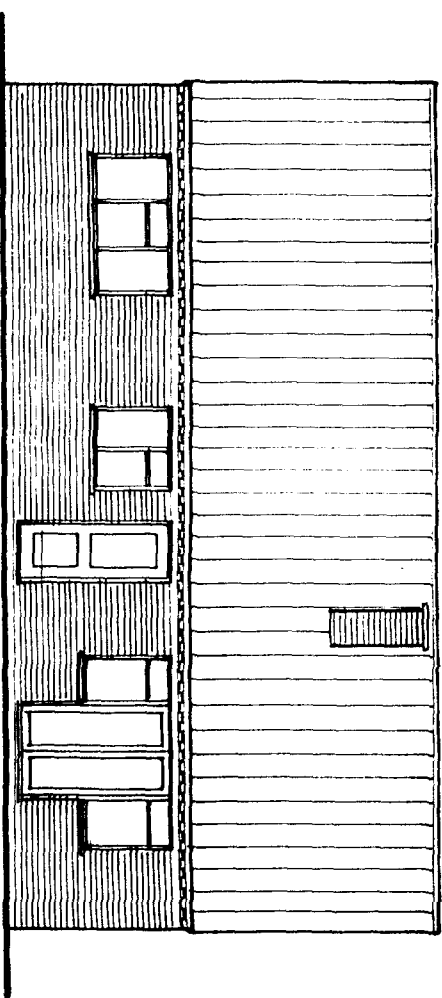


Rear elevation

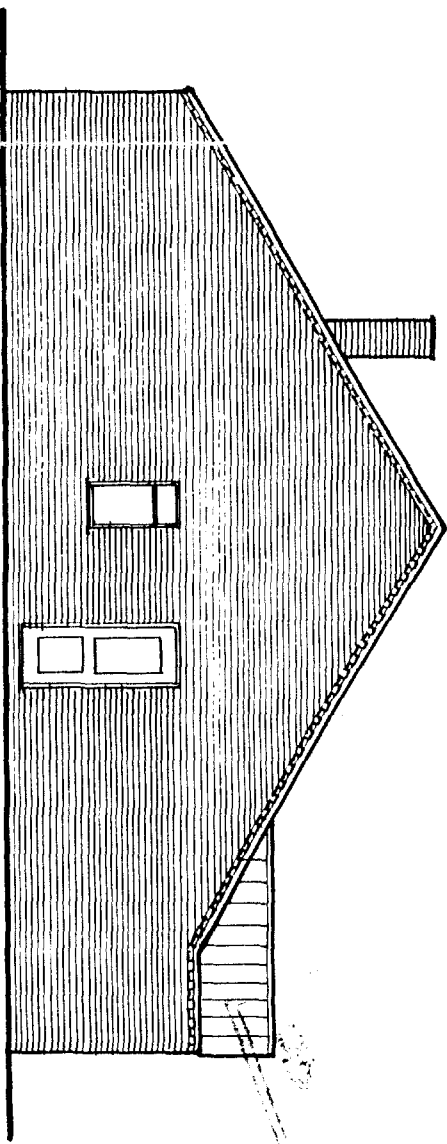

Side elevation

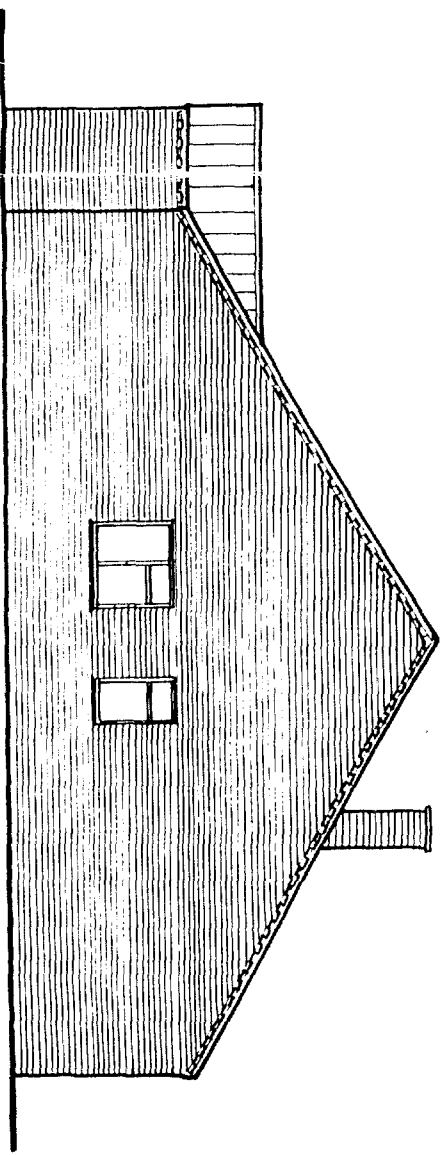

Side elevation

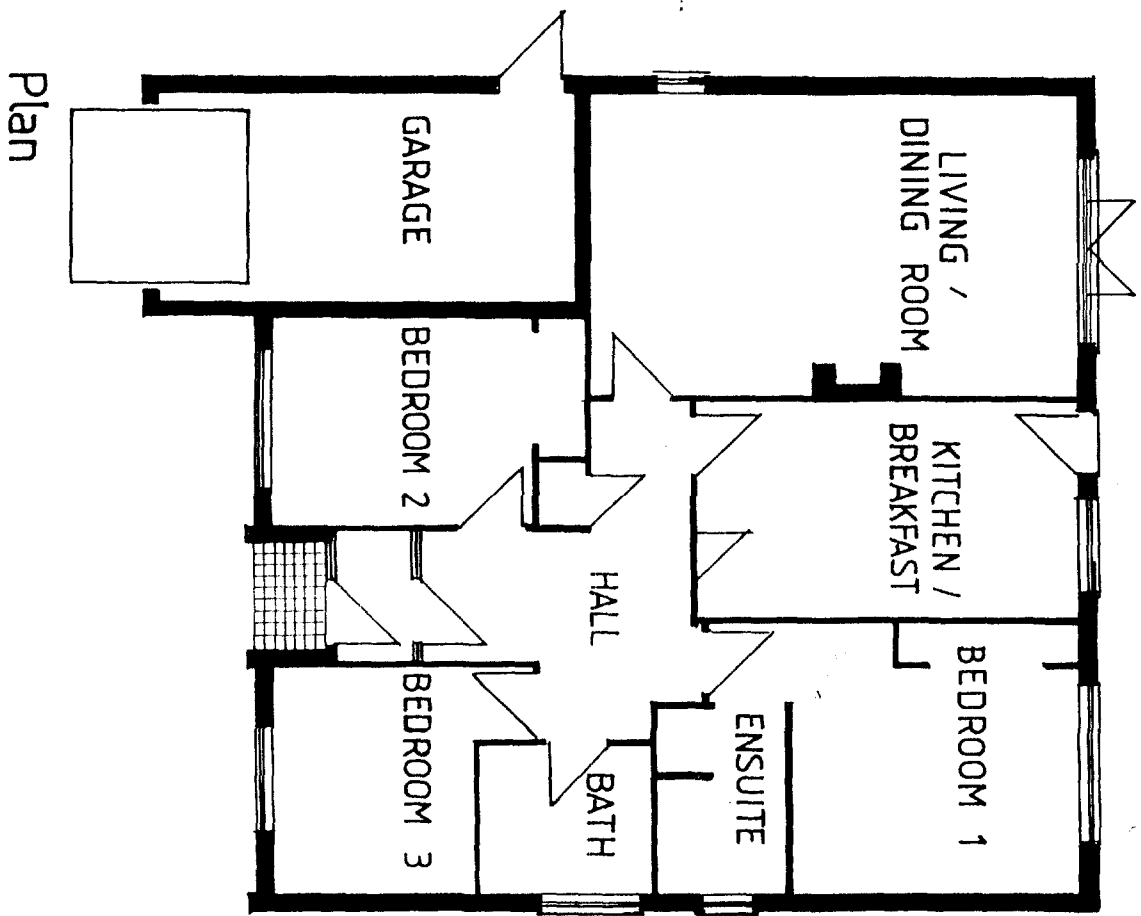


Plan


DRAWING
3 JUL 1997
ISSUED

0182197


Plots 6.9. Phase 2
St. Mary's Meadows. Gedney.
160/3/13. 1:100. June 97

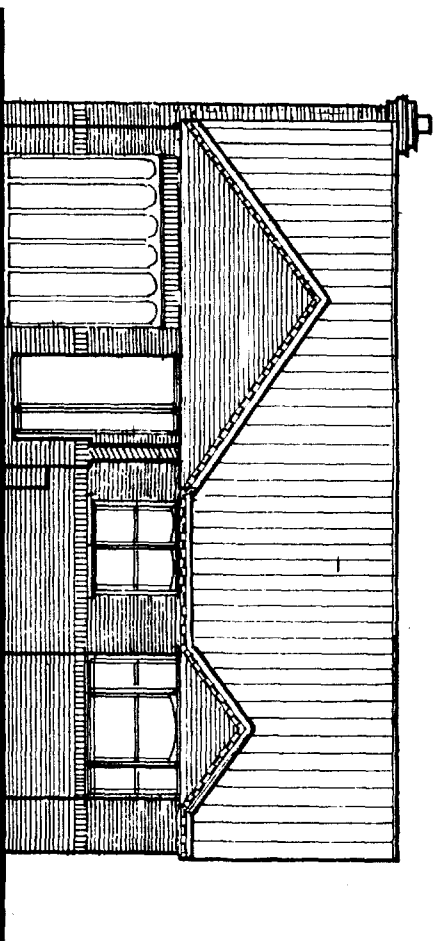


Front Elevation

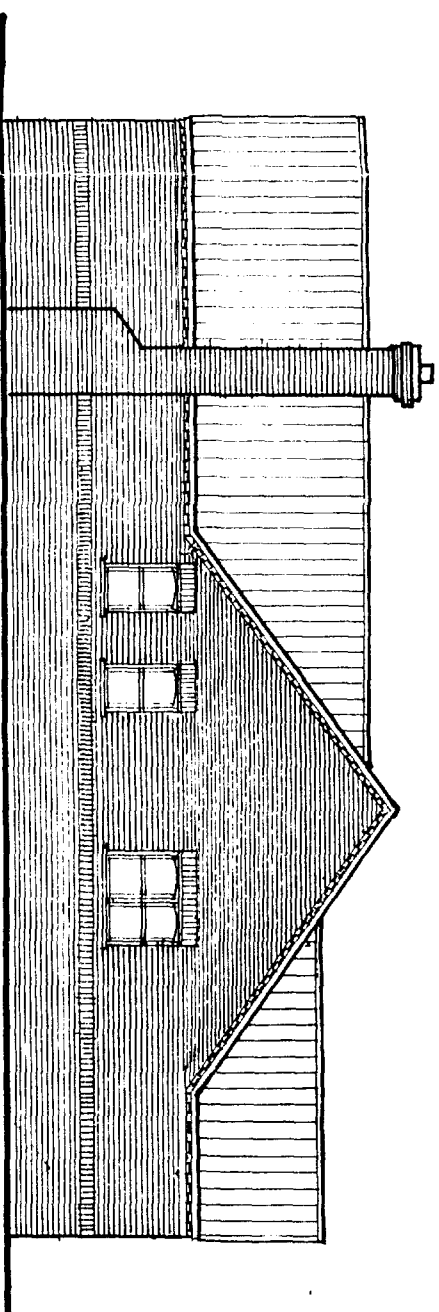


Side Elevation

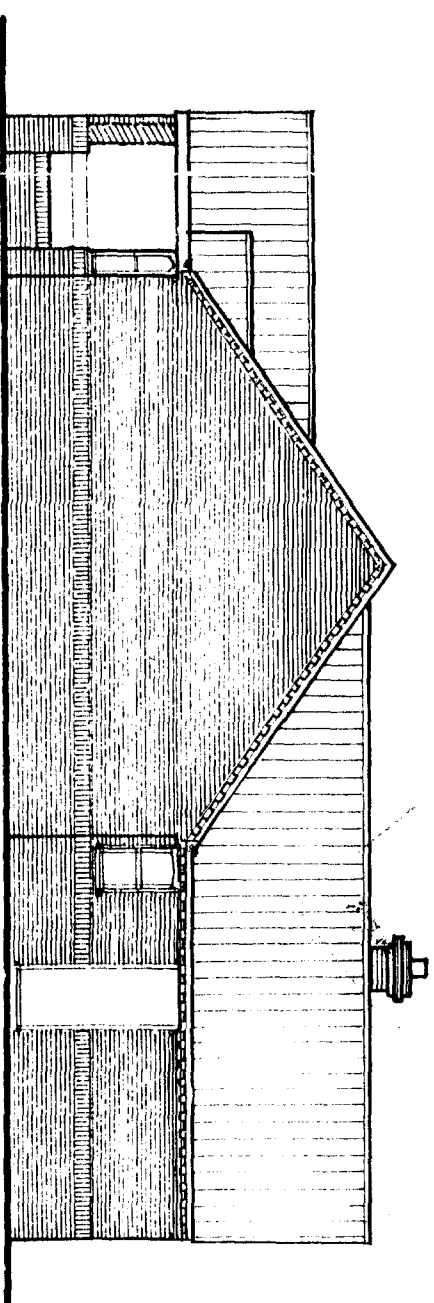

Side Elevation

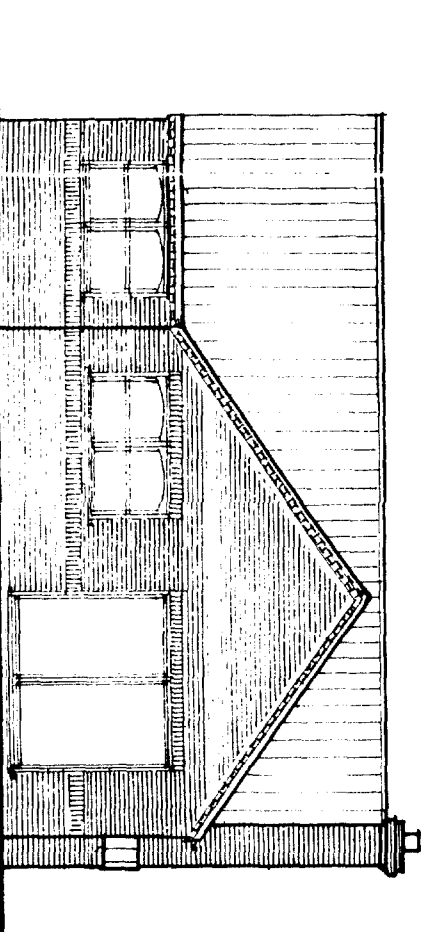

Rear Elevation

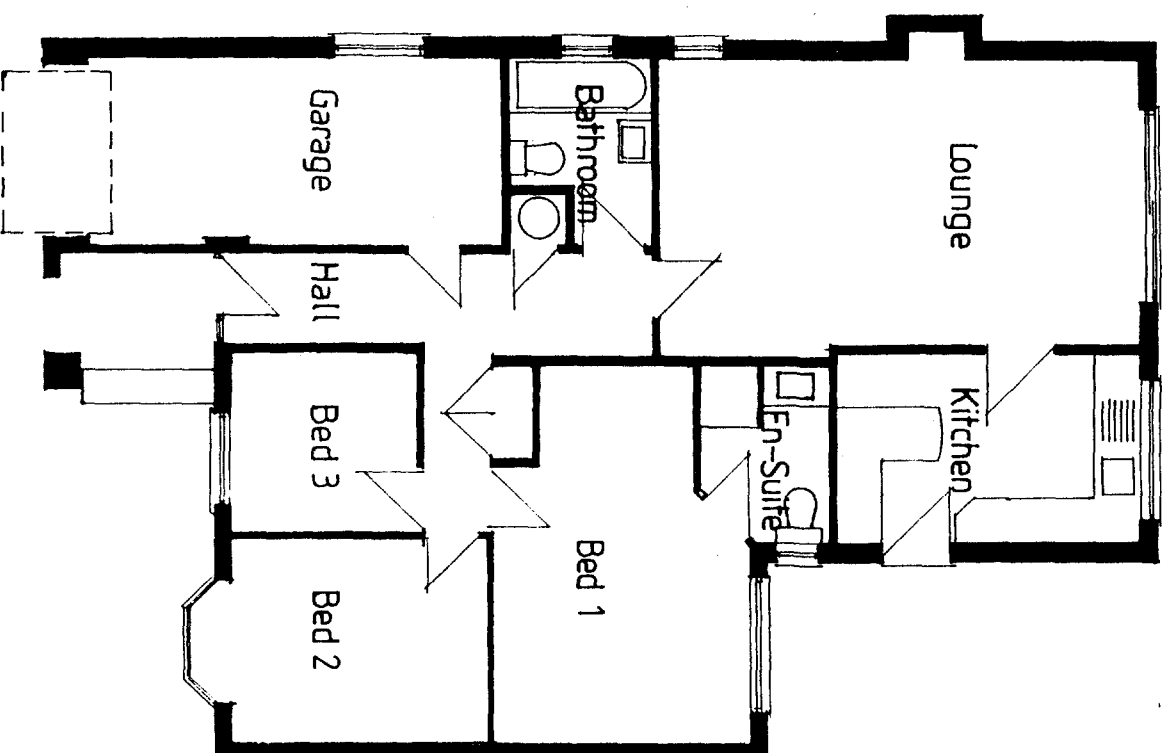


DRAWING
3 JUL 1997
ISSUED

0182197


Plots 2.3.4. Phase 2
St Mary's Meadows. Gedney
160/3/10. 1:100. June 97

Town & Country
Planning
Landscape Architecture

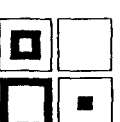


Robert
Doughty
Consultancy


22 High Street, Hellingham, Shefford NG34 0RA Tel: (01529) 421646 Fax: (01529) 421358

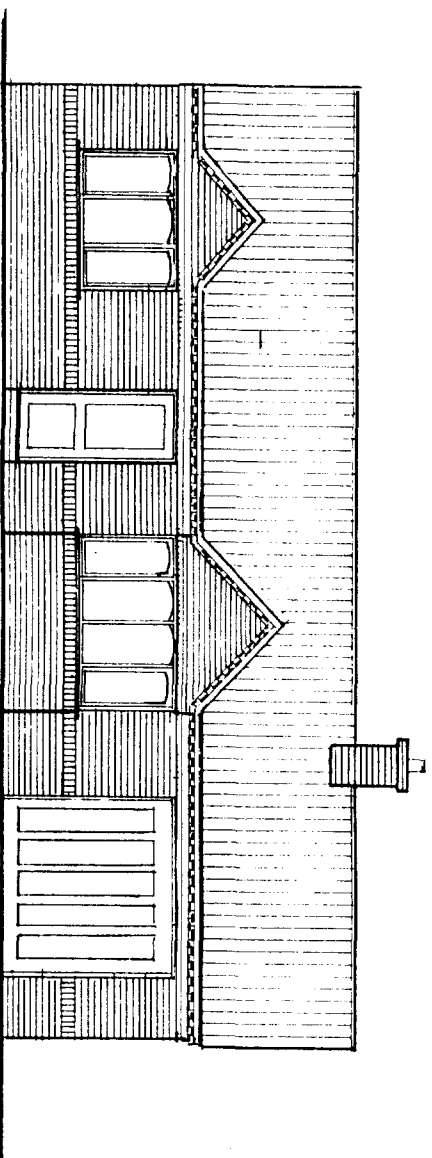


Front Elevation

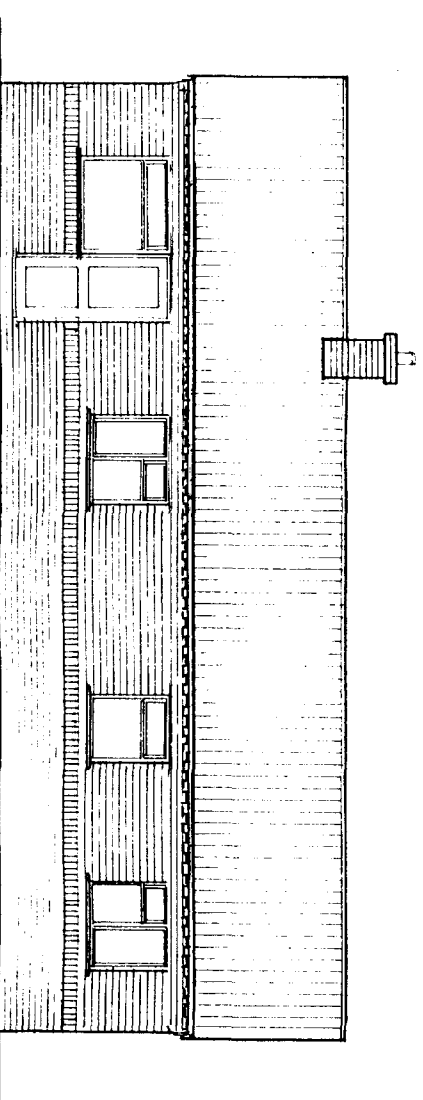


Rear Elevation

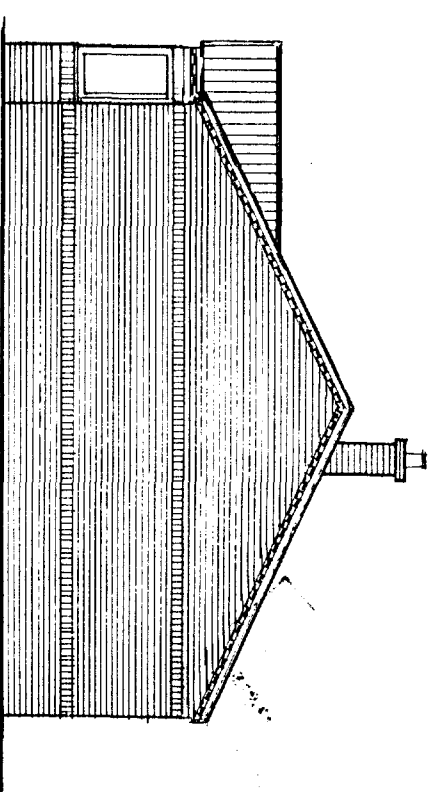

Side Elevation

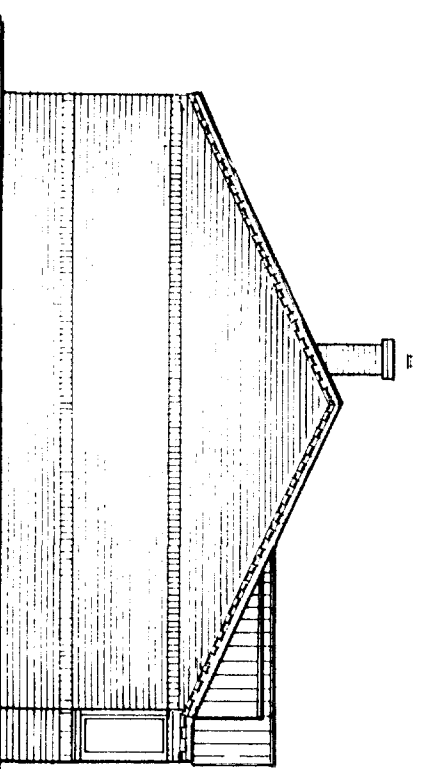

Side Elevation

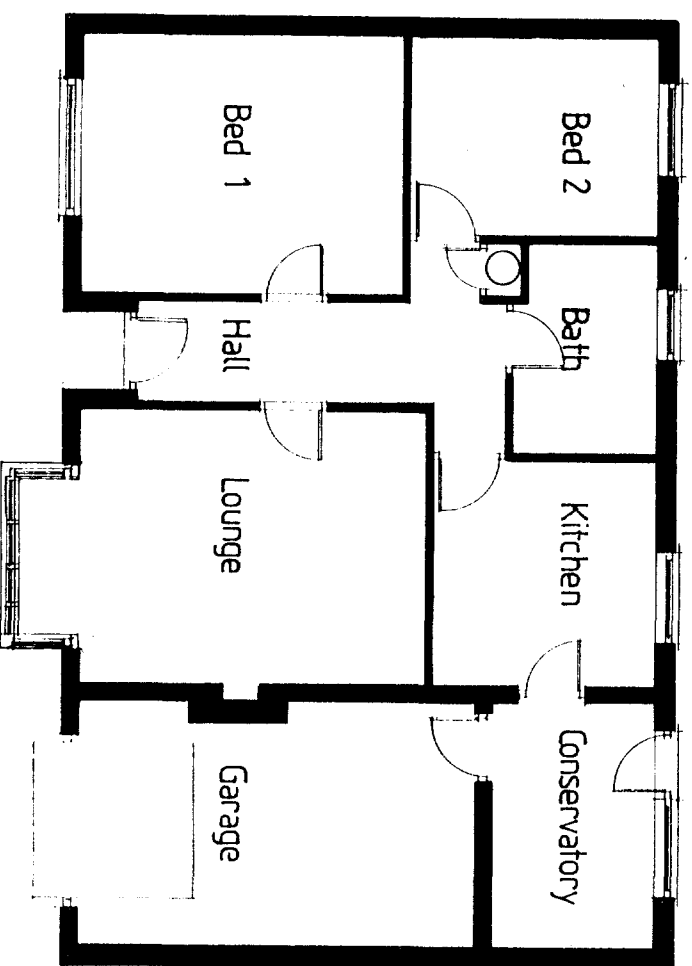


Plan

082107


DRAWING
3 JUL 1997
ISSUED

Plot 1 Phase 2
St. Mary's Meadows Gedney


160/3/11. 1:100. June 97

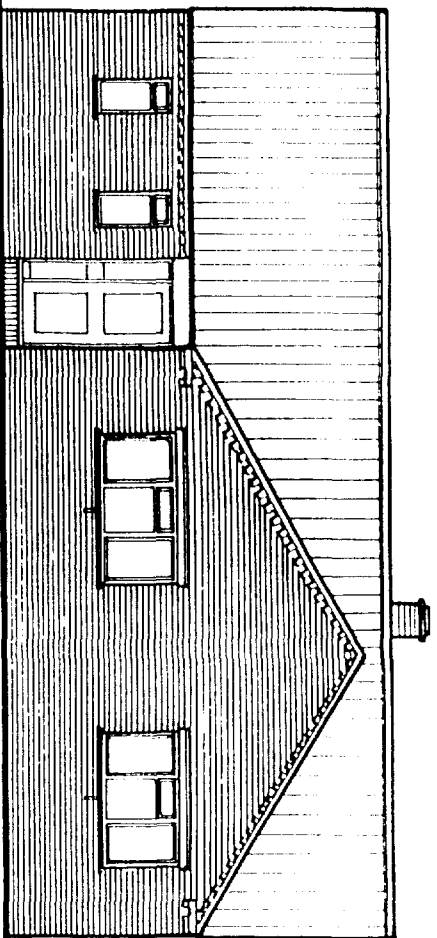


Front elevation

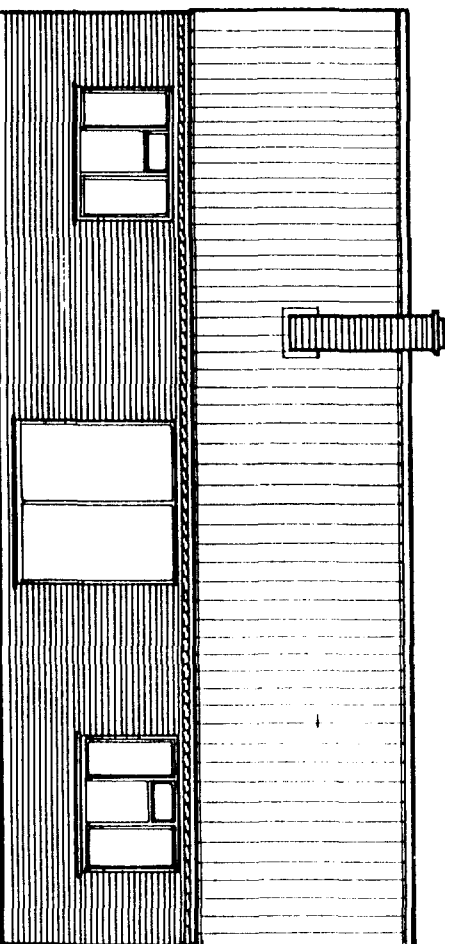


Rear elevation

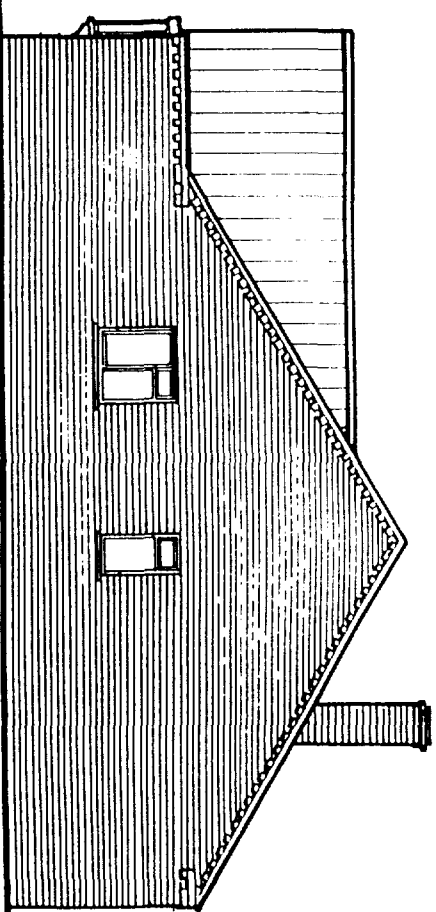

Side elevation

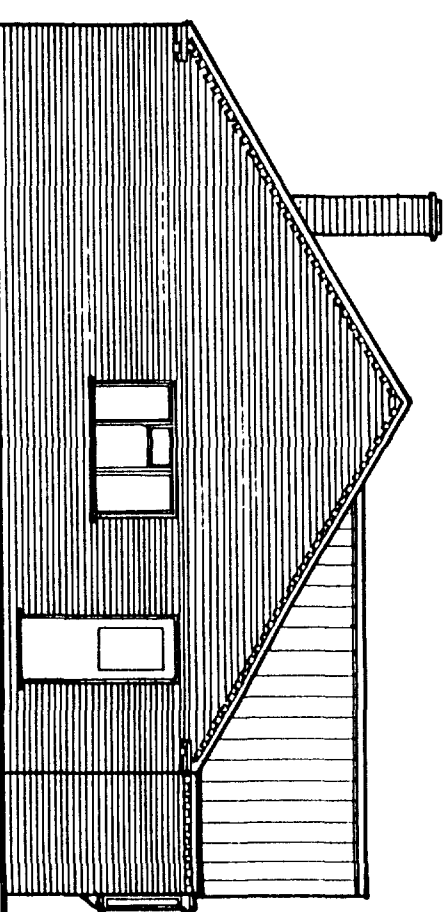

Side elevation

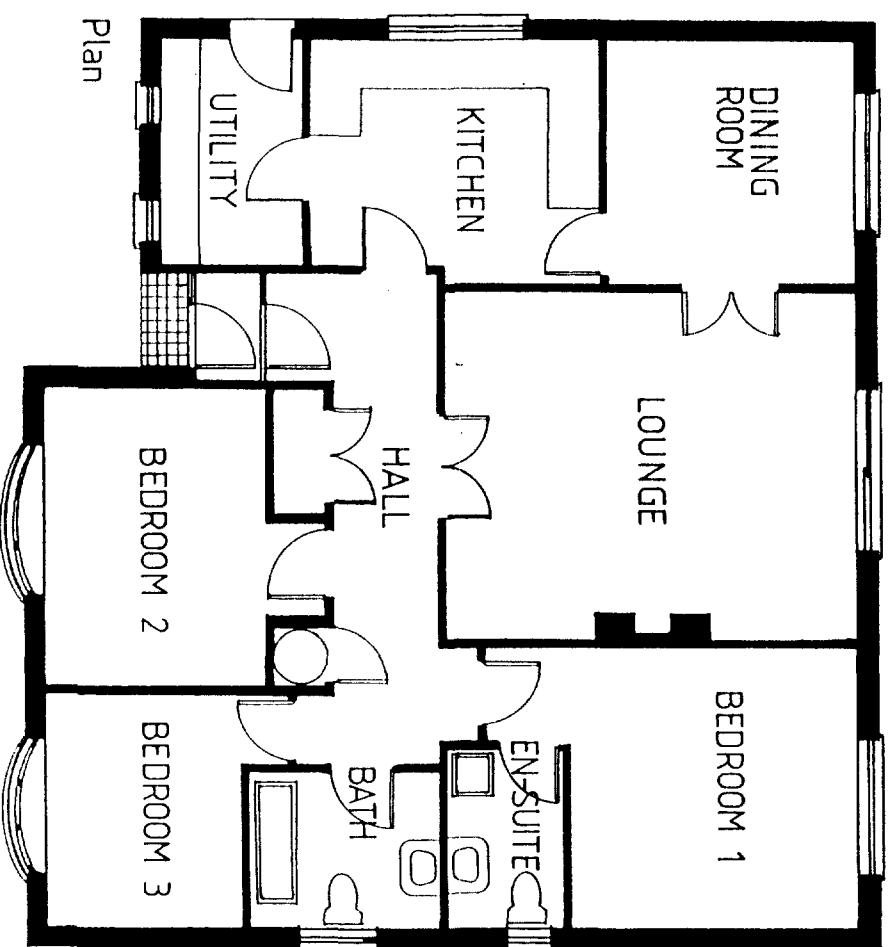

01821 67

DRAWING
3 JUL 1997
ISSUED


Plots 5.7.8. Phase 2
St. Mary's Meadows. Gedney.

160/3/12. 1:100. June 97

Town & Country Planning

Ecology

 
Landmarks Architecture



Robert Doughty Consultancy



Reproduced from the ~~1928~~ *Colours Book* ~~1928~~ with the permission of the Controller of HM Stationery Office. Crown copyright reserved.

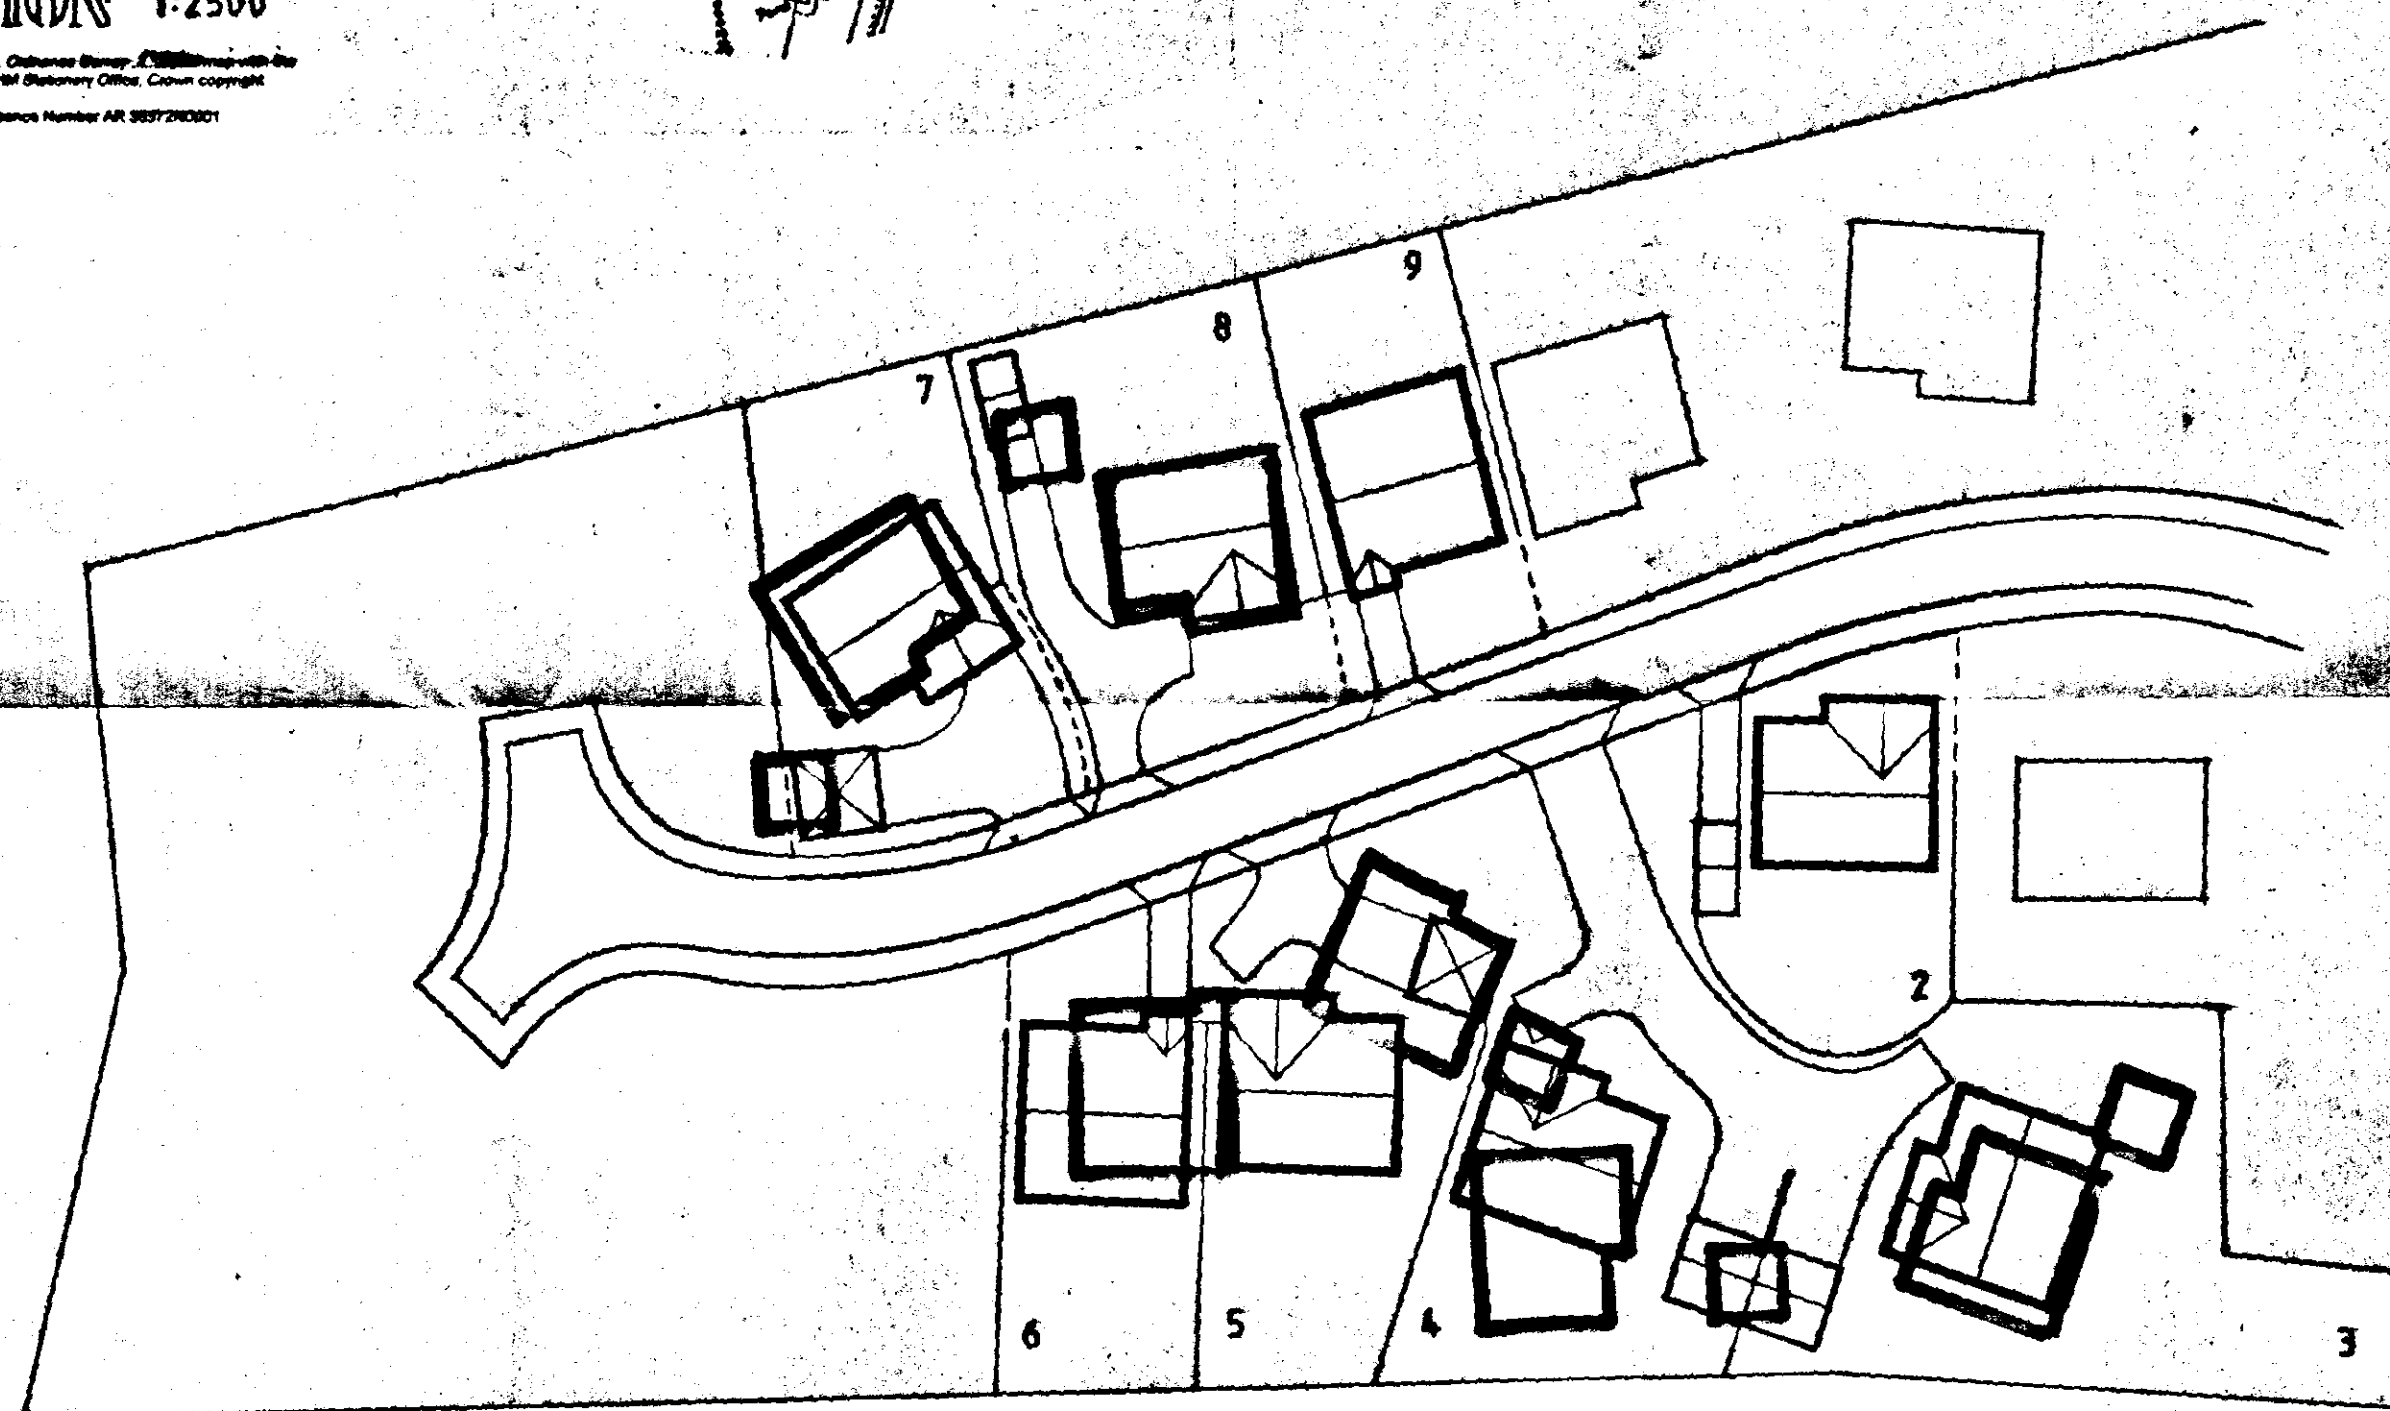

DRAWING
1 JUN 1998
ISSUED

Layout based upon 160731A as approved under H06/0782/97
amendments made to some units siting /orientation.


LAYOUT. Phase 2 (PLOTS 2-9)

ST. MARY'S MEADOW, GEDNEY

Dwg 384/2/1A Scale 1:500


May 1998

Town & Country
Planning
Ecology
Landscape Architecture

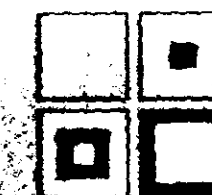


**Robert
Doughty
Consultancy**

MCKENNA DEVELOPMENTS LIMITED

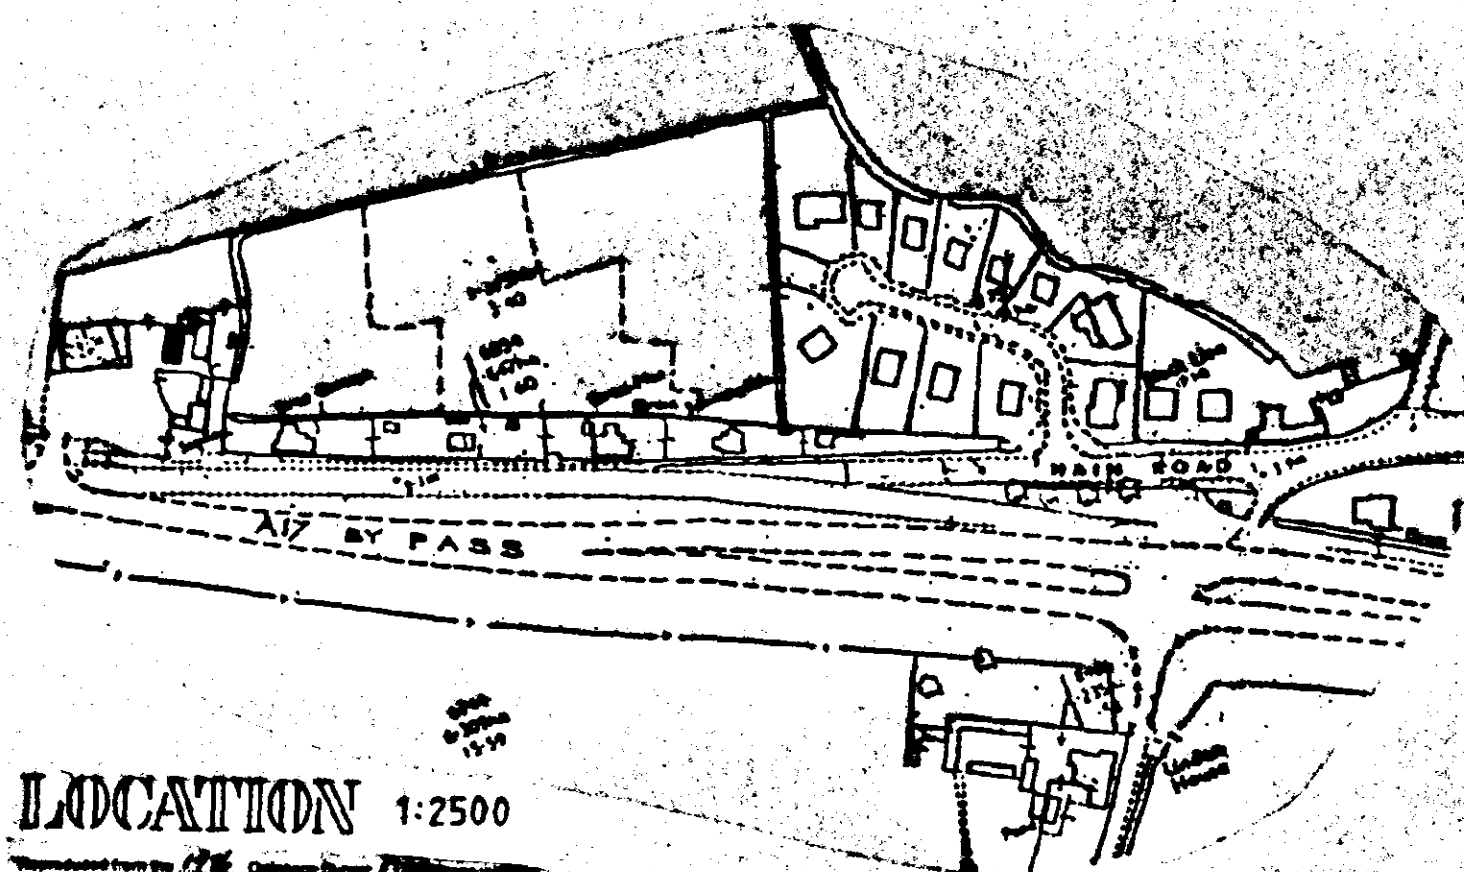

LOCATION 1:2500

Extracted from the 1:2500 Ordnance Survey map, copyright 1997, permission of the Controller of Her Majesty's Stationery Office, Crown copyright reserved.
Robert Doughty Consultancy Licence Number AN 3837/280001

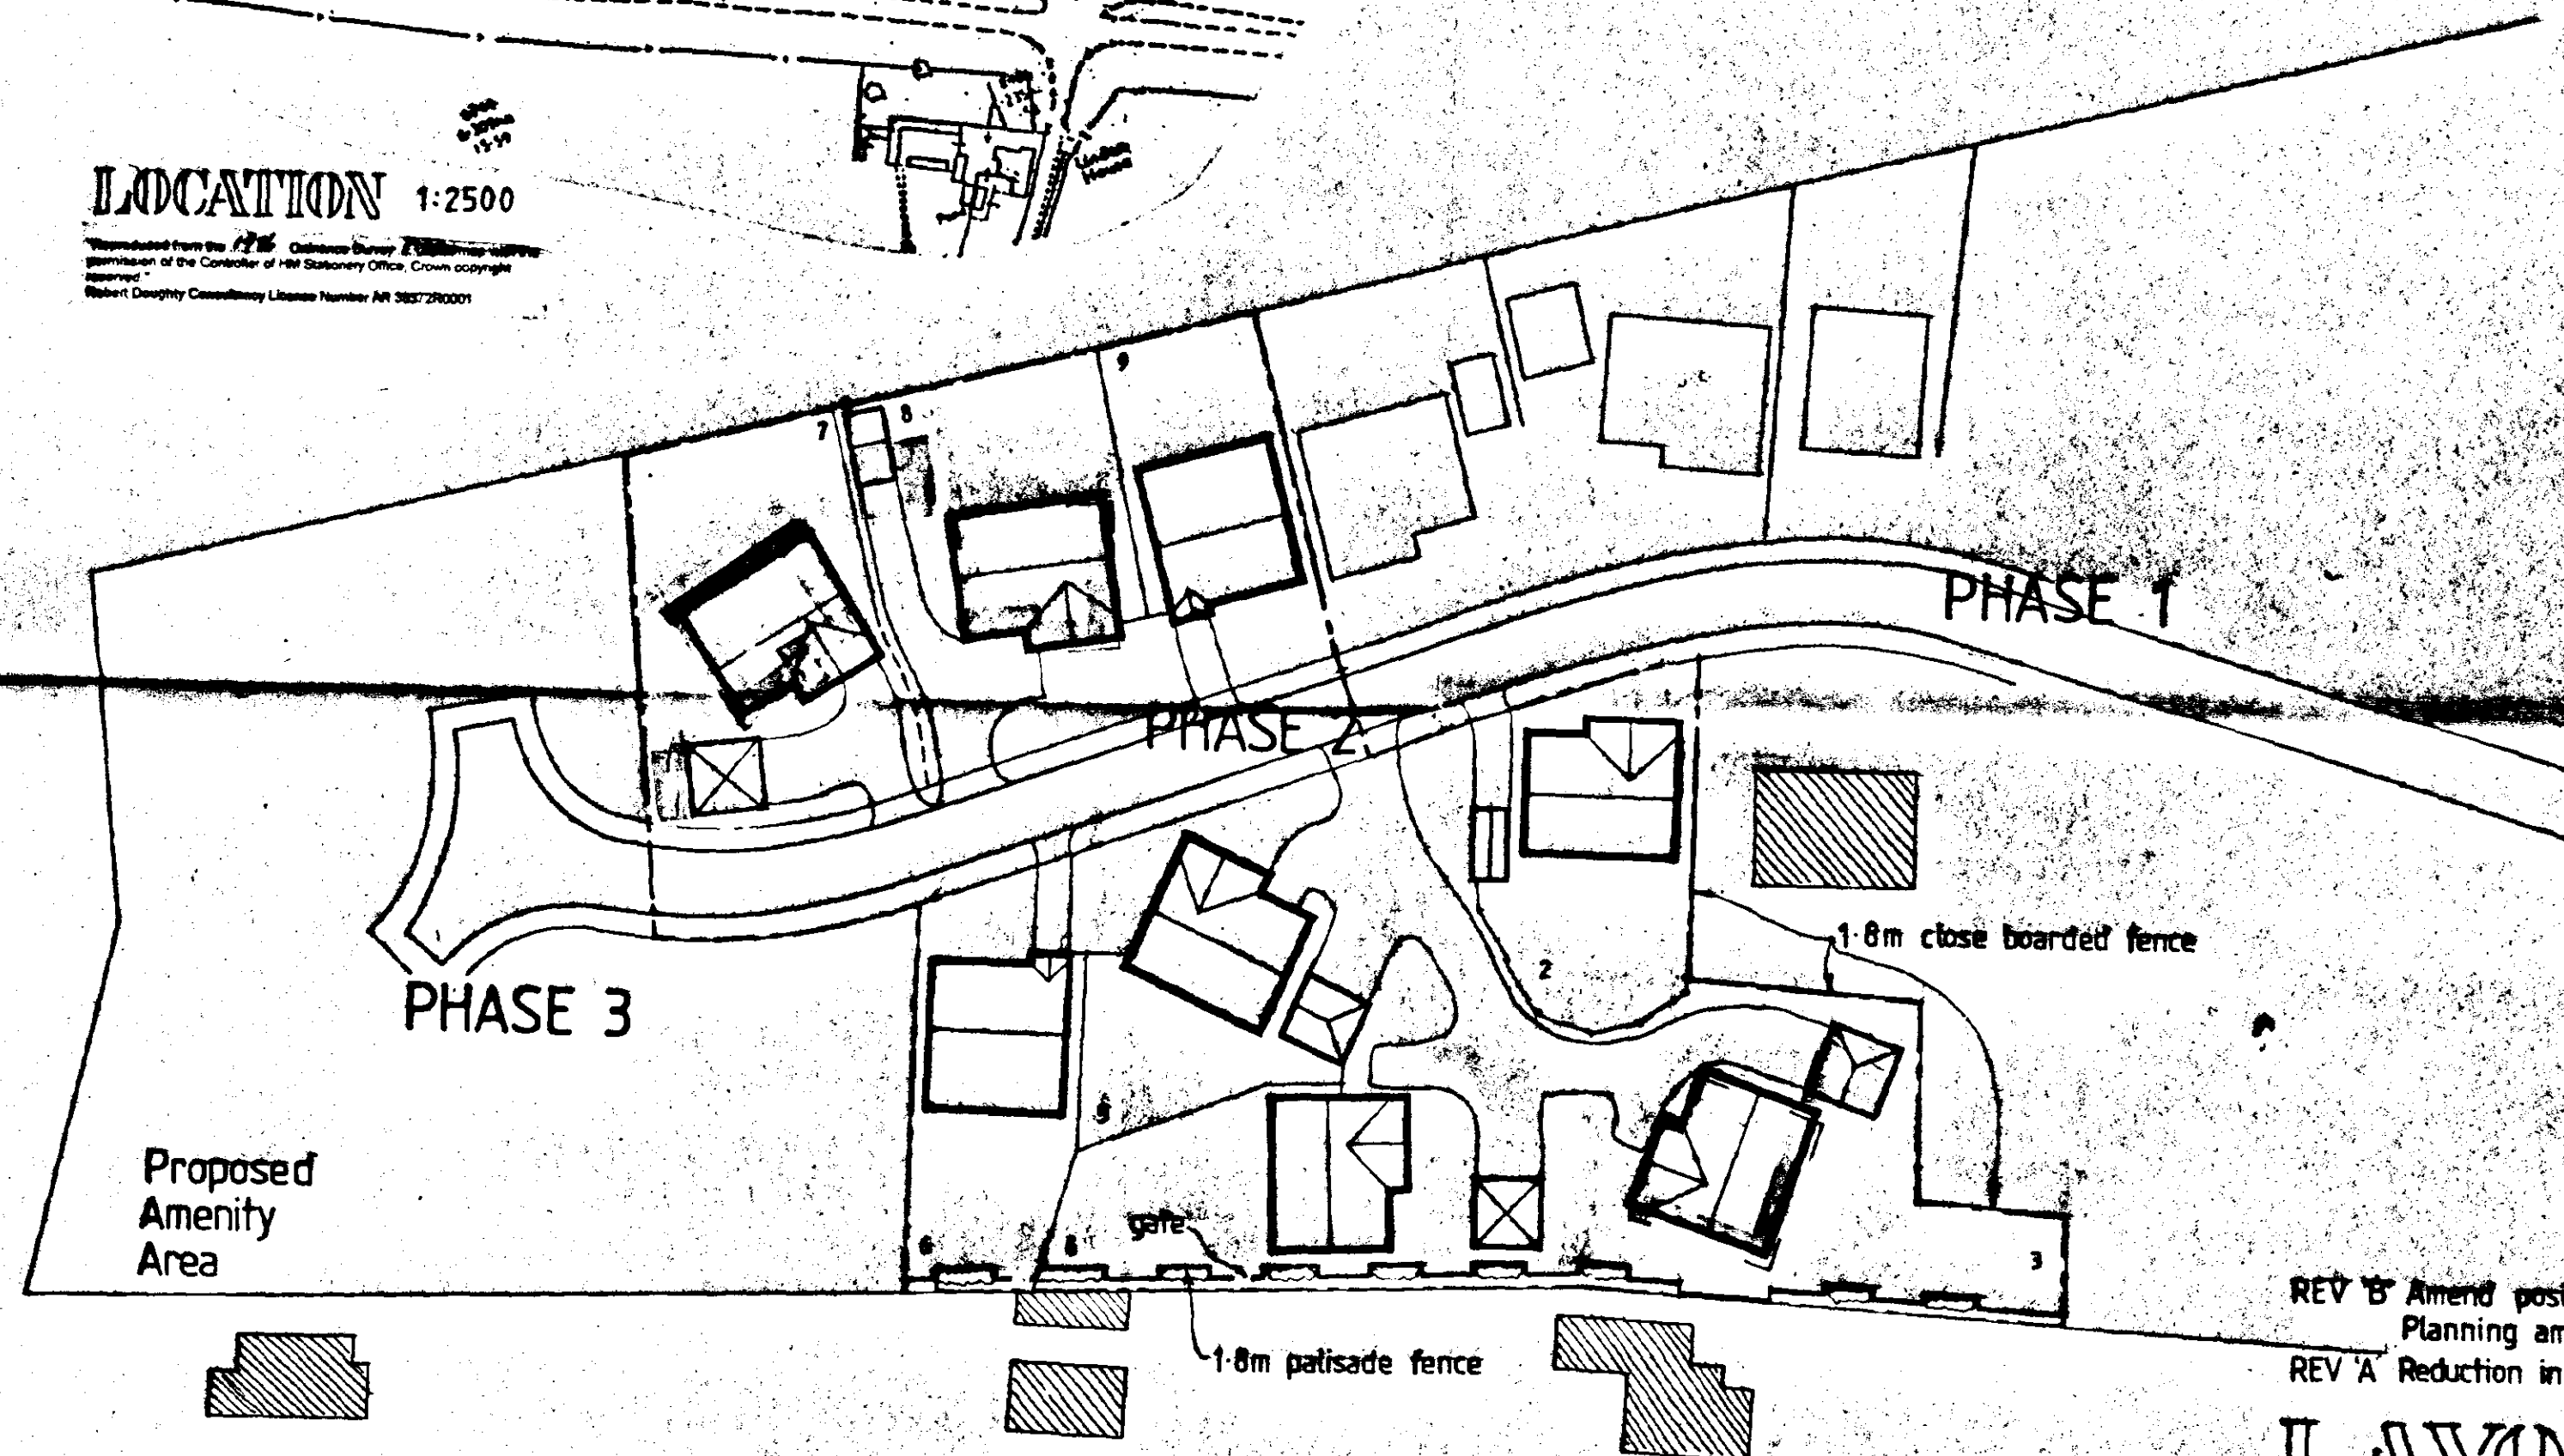

AMENDED PLAN
Ref. A1

SOUTH HOLLAND DC
HOUSING & PLANNING
27 JUL 1998
Ref. 0182/97

REV 'B' Amend positions of plots 3, 7 & 9 and renumbering 26/7/98
Planning amendment application.
REV 'A' Reduction in plots from 9 to 8.


LAYOUT
PHASE 2

DRAWING
24 JUL 1998
ISSUED

ST. MARY'S MEADOWS, GEDDNEY.
Dwg 160/3/18 Scale 1:500 June 97

Town & Country
Planning


Landscape Architecture

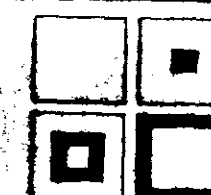

Robert
Doughty
Consultancy


32 High Street, Helpringham, Stamford NG34 0RA Tel: (01529) 421546 Fax: (01529) 421358

MCKENNA DEVELOPMENTS LIMITED

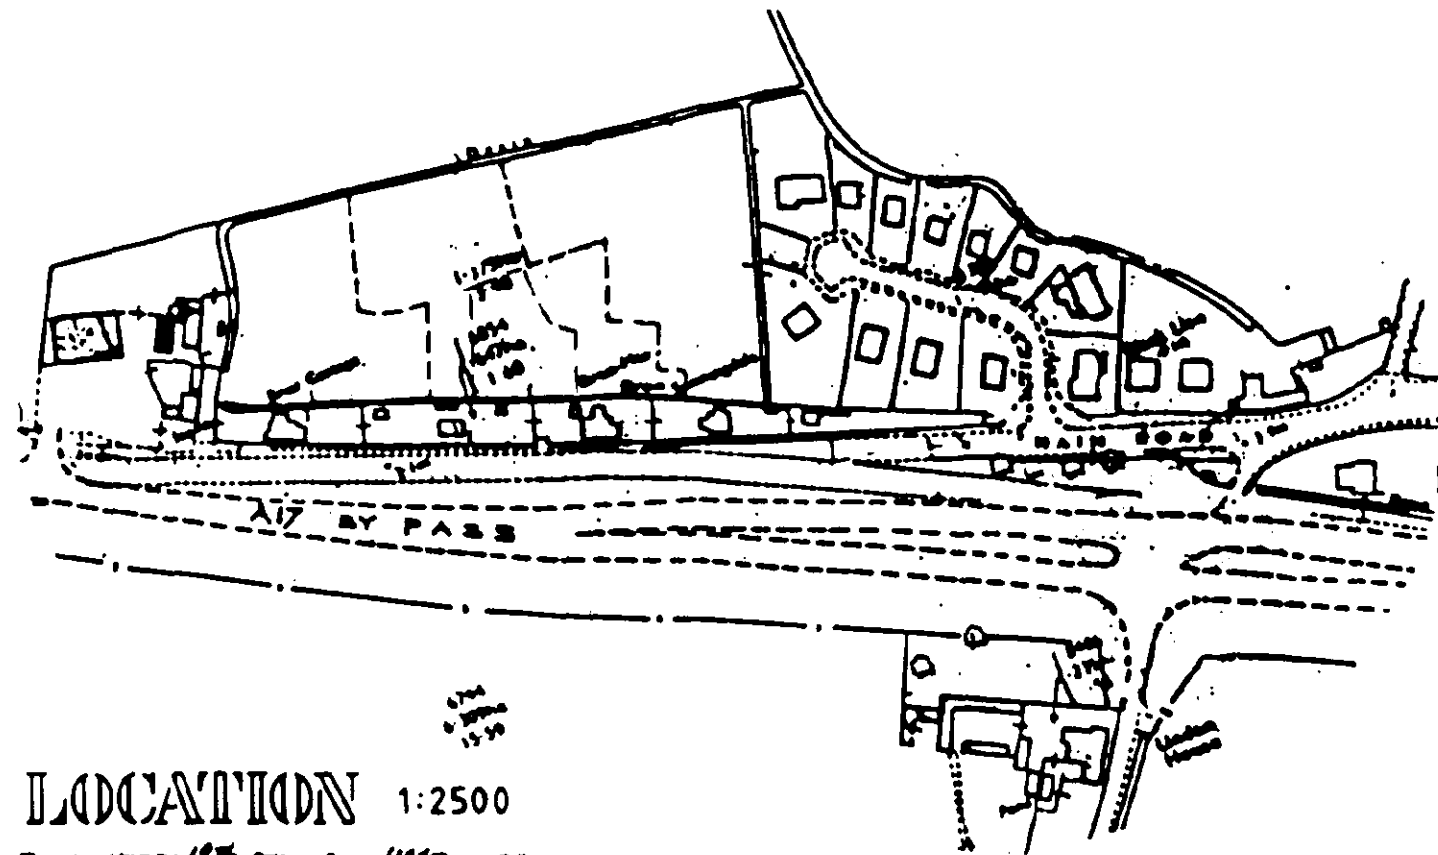

LOCATION 1:2500

"Reproduced from the 1976 Ordnance Survey 1:62500 map with the permission of the Controller of Her Majesty's Stationery Office. Crown copyright reserved."
Robert Doughty Consultancy Licence Number AR 363720001

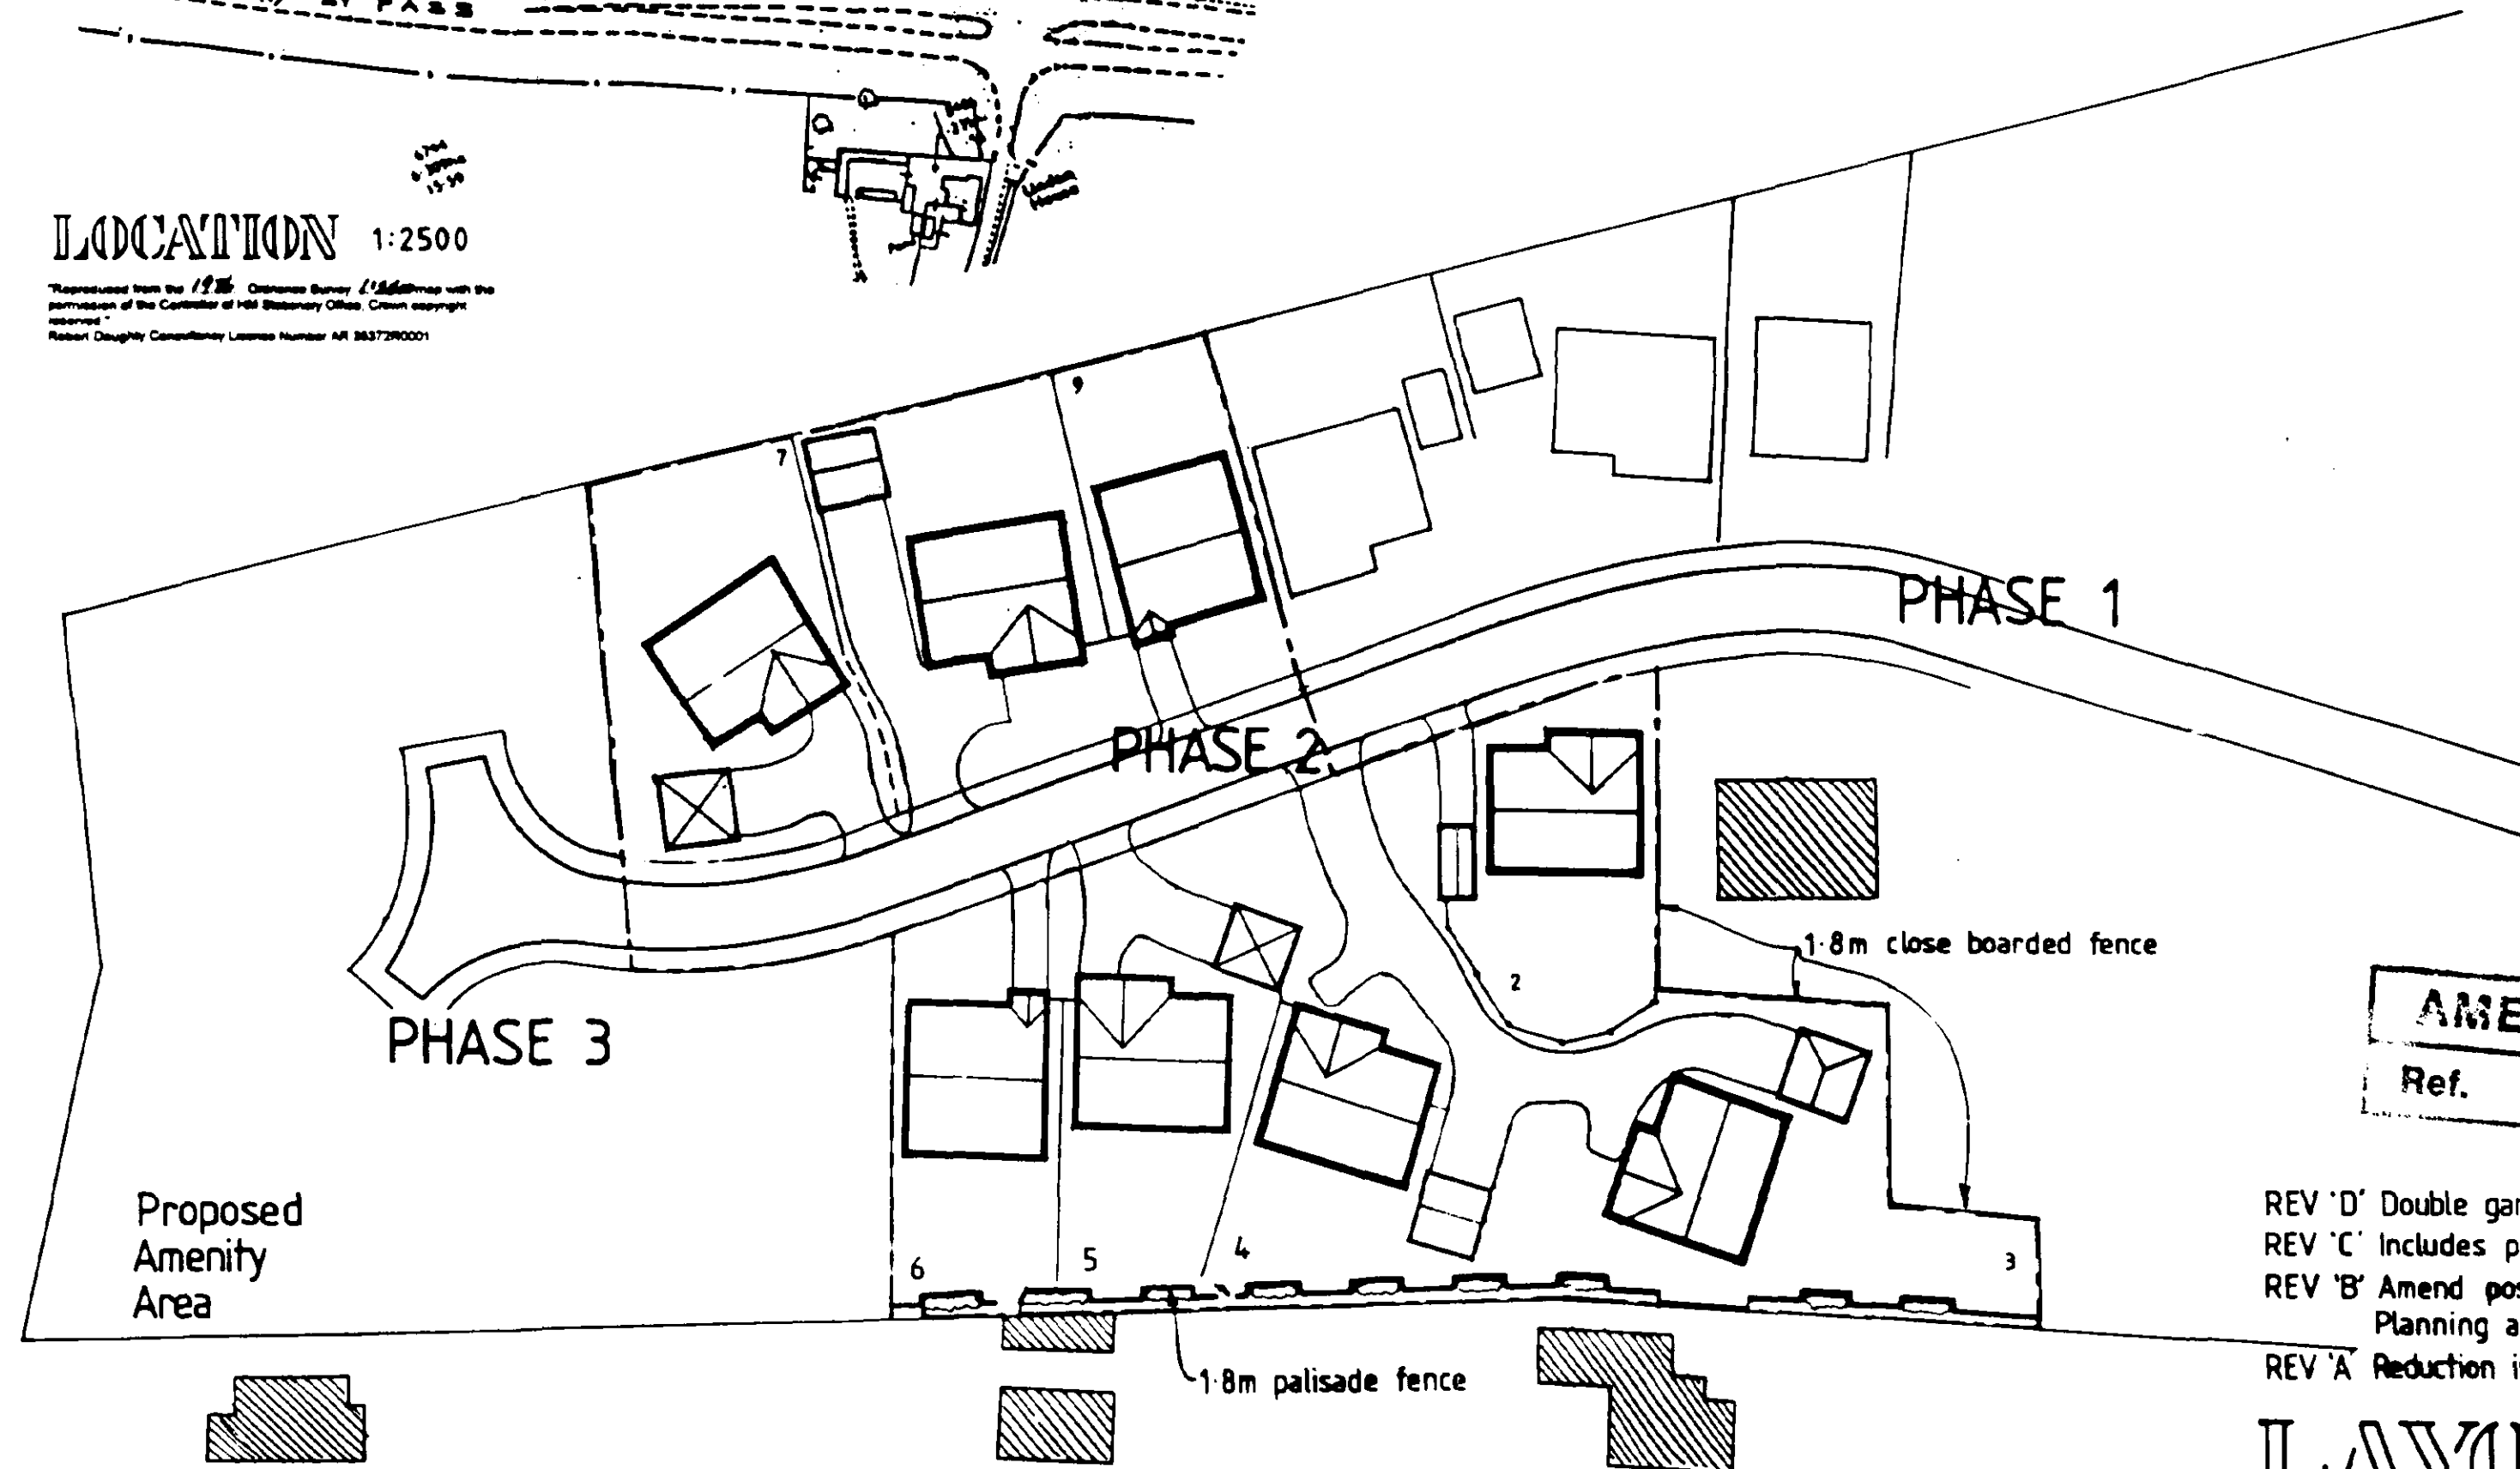

AMENDED PLAN	
Ref. A3	SOUTH HOLLAND DC HOUSING & PLANNING -8 DEC 1998 Ref: 0782/97

REV 'D' Double garage plot 8. 12/98
REV 'C' Includes proposed revised siting plots 4,5,6. 10/98
REV 'B' Amend positions of plots 3,7 & 9 and renumbering 24/7/98
Planning amendment application.
REV 'A' Reduction in plots from 9 to 8.


LAYOUT
PHASE 2

DRAWING
7 DEC 1998
ISSUED

ST. MARY'S MEADOWS. GEDDNEY.
Dwg 160/3/10 Scale 1:5000 June 97

Town & Country
Planning

Landscape Architecture

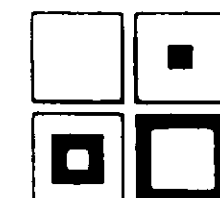

Robert
Doughty
Consultancy

32 High Street Helpingsham Sleaford NG34 0RA Tel: (01529) 421846 Fax: (01529) 421358

Schedule of trees


Key	No	Description	Planting height
SB	2	Betula pendula	150 - 180cm feathered
W	2	Sorbus aria 'Mitchellii'	std.
S	3	Rhus typhina 'Laciniata'	120 - 150c.g.
Y	2	Taxus baccata 'Fastigiata Aurea'	60 - 75 c.g.

 Beech hedging - 5 plants per metre in double staggered row

 1.8m Close boarded fence

 1.8m Palisade fence (see detail sheet 160/1/2/1)

 Rosa rugosa at 1.0m intervals

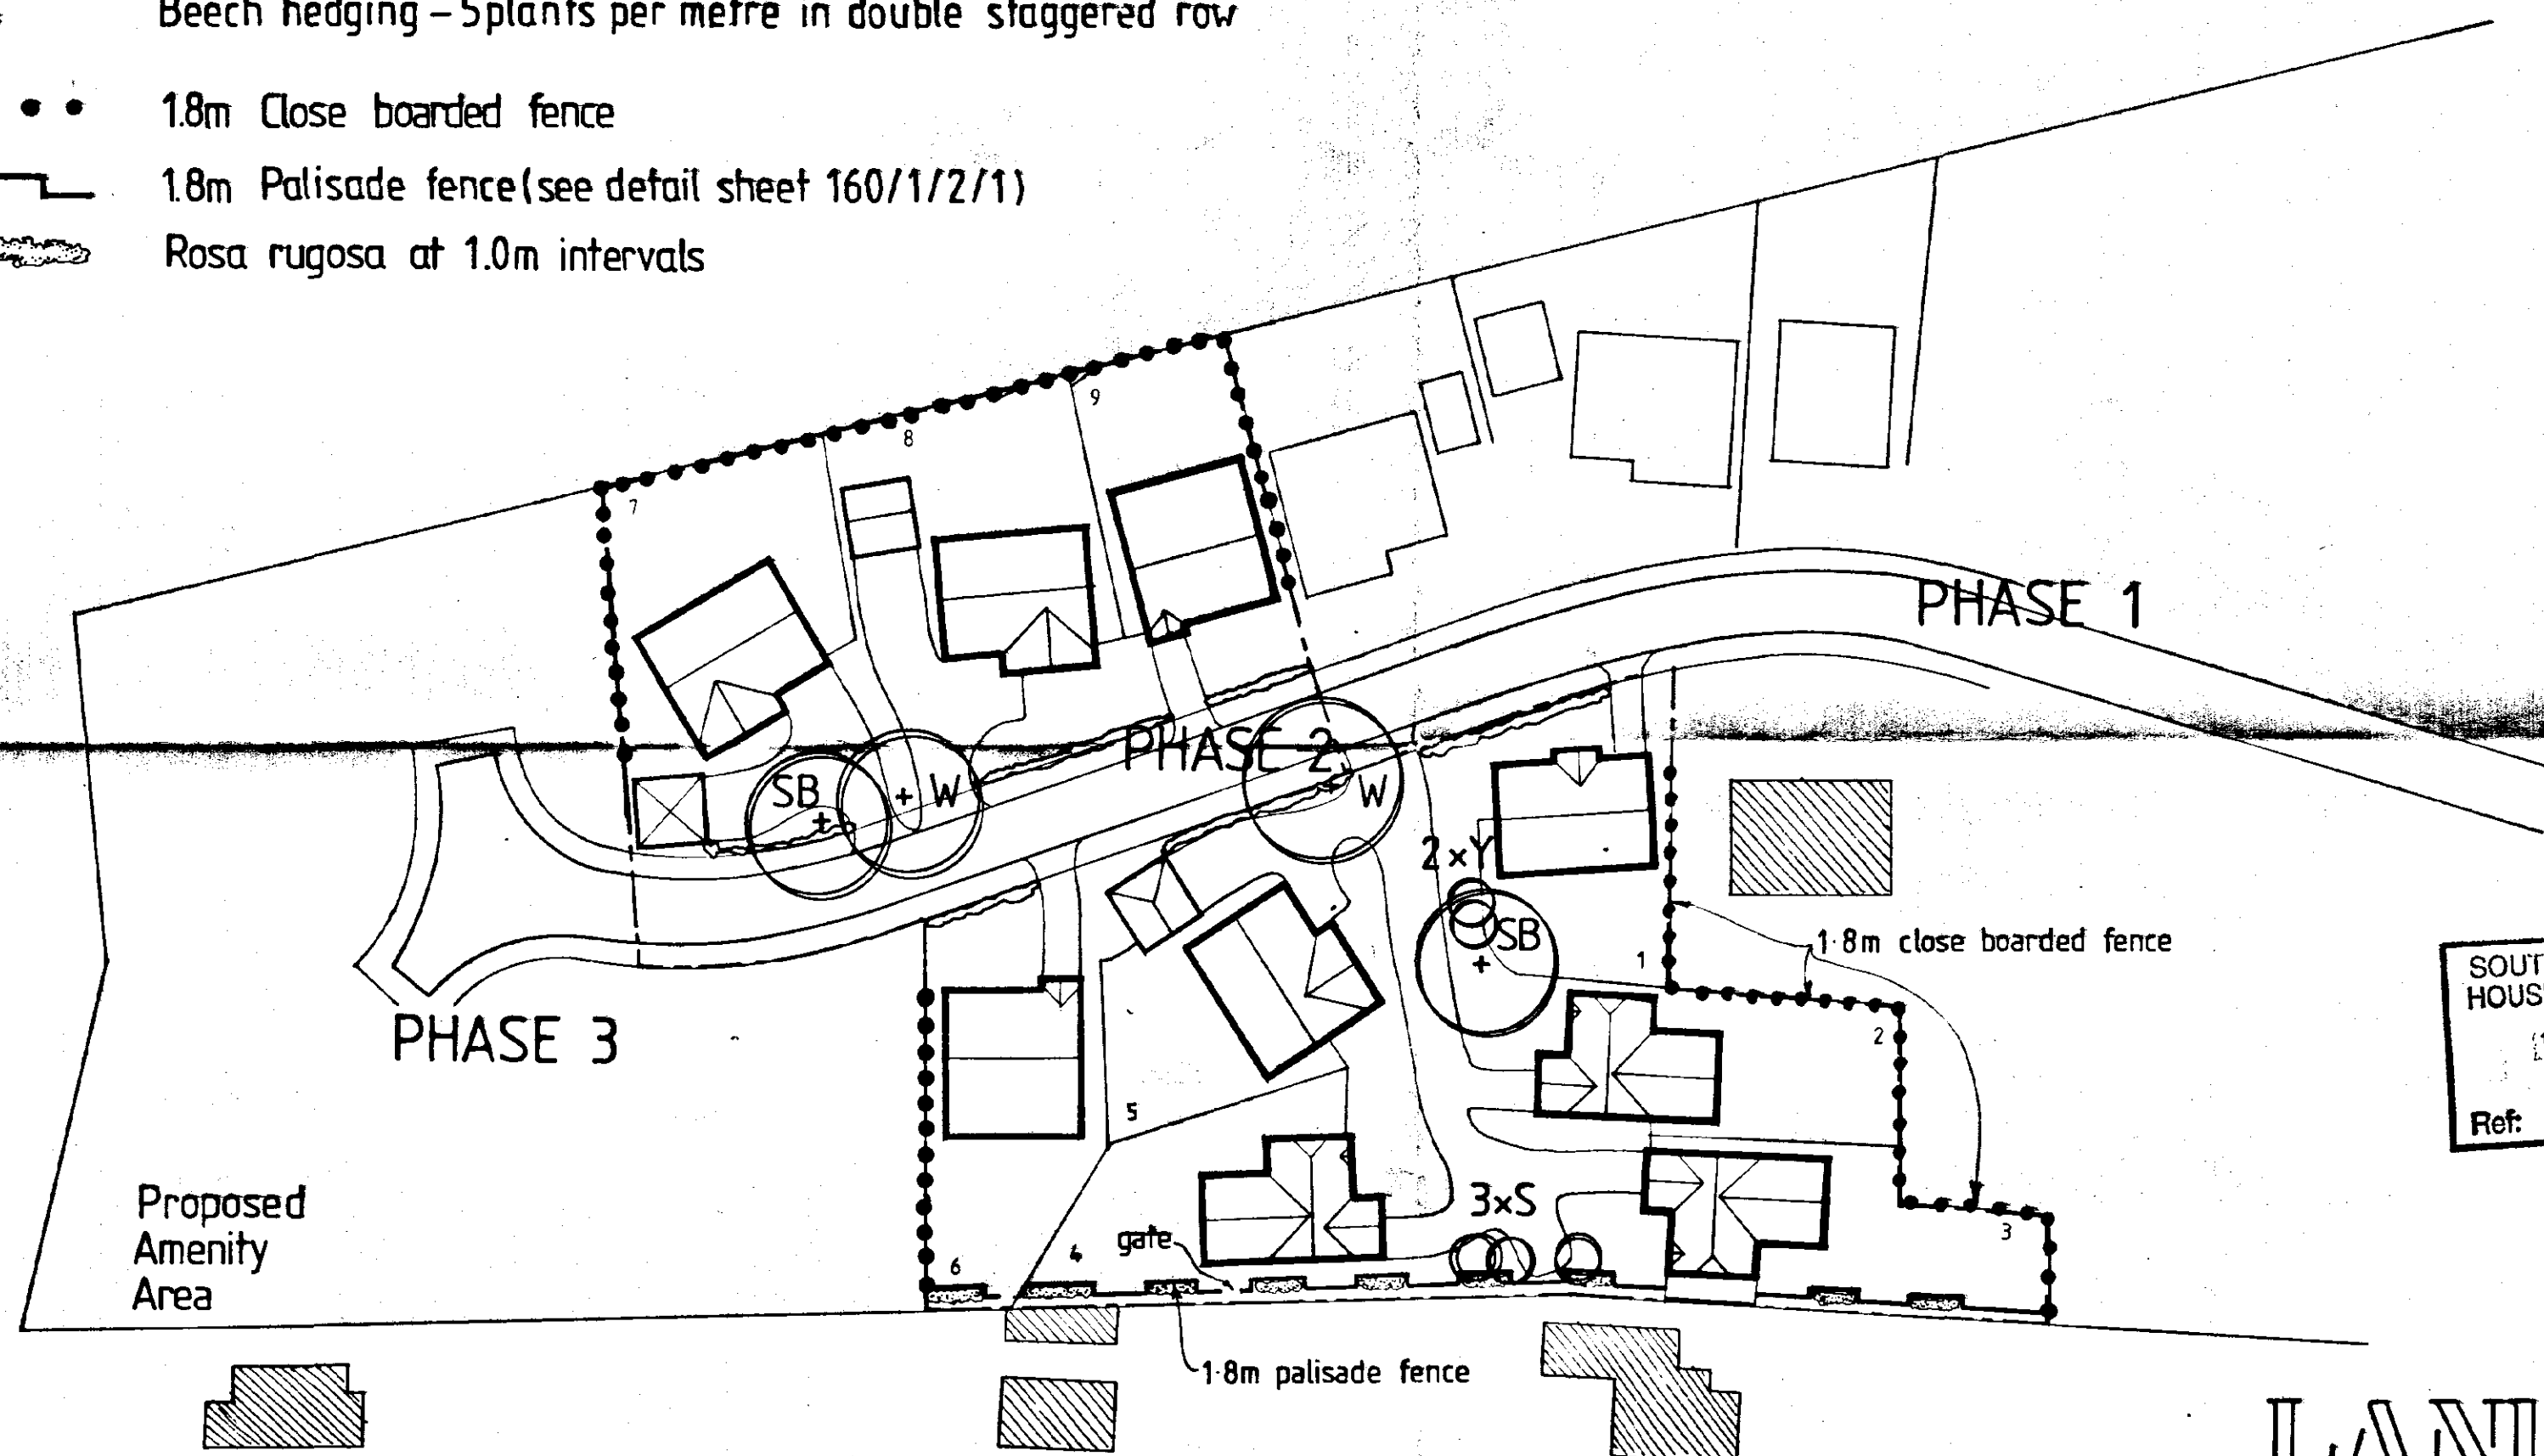


LANDSCAPE PHASE 2

ST. MARY'S MEADOWS. GEDNEY.
Dwg 160/3/2 Scale 1:500 June 97

Town & Country
Planning

Landscape Architecture

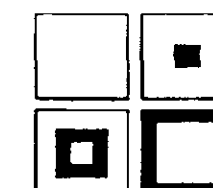

Robert
Doughty
Consultancy

32 High Street, Helpringham, Stamford NG34 0RA Tel: (01529) 421646 Fax: (01529) 421358

McKENNA DEVELOPMENTS LIMITED


Schedule of trees


Key	No	Description	Planting height
SB	2	Betula pendula	150 - 180cm feathered
W	2	Sorbus aria 'Mitchellii'	std.
S	3	Rhus typhina 'Laciniata'	120 - 150c.g.
Y	2	Taxus baccata 'Fastigiata Aurea'	60 - 75 c.g.

 Beech hedging - 5 plants per metre in double staggered row

 1.8m Close boarded fence

 1.8m Palisade fence (see detail sheet 160/1/2/1)

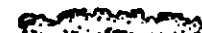 Rosa rugosa at 1.0m intervals

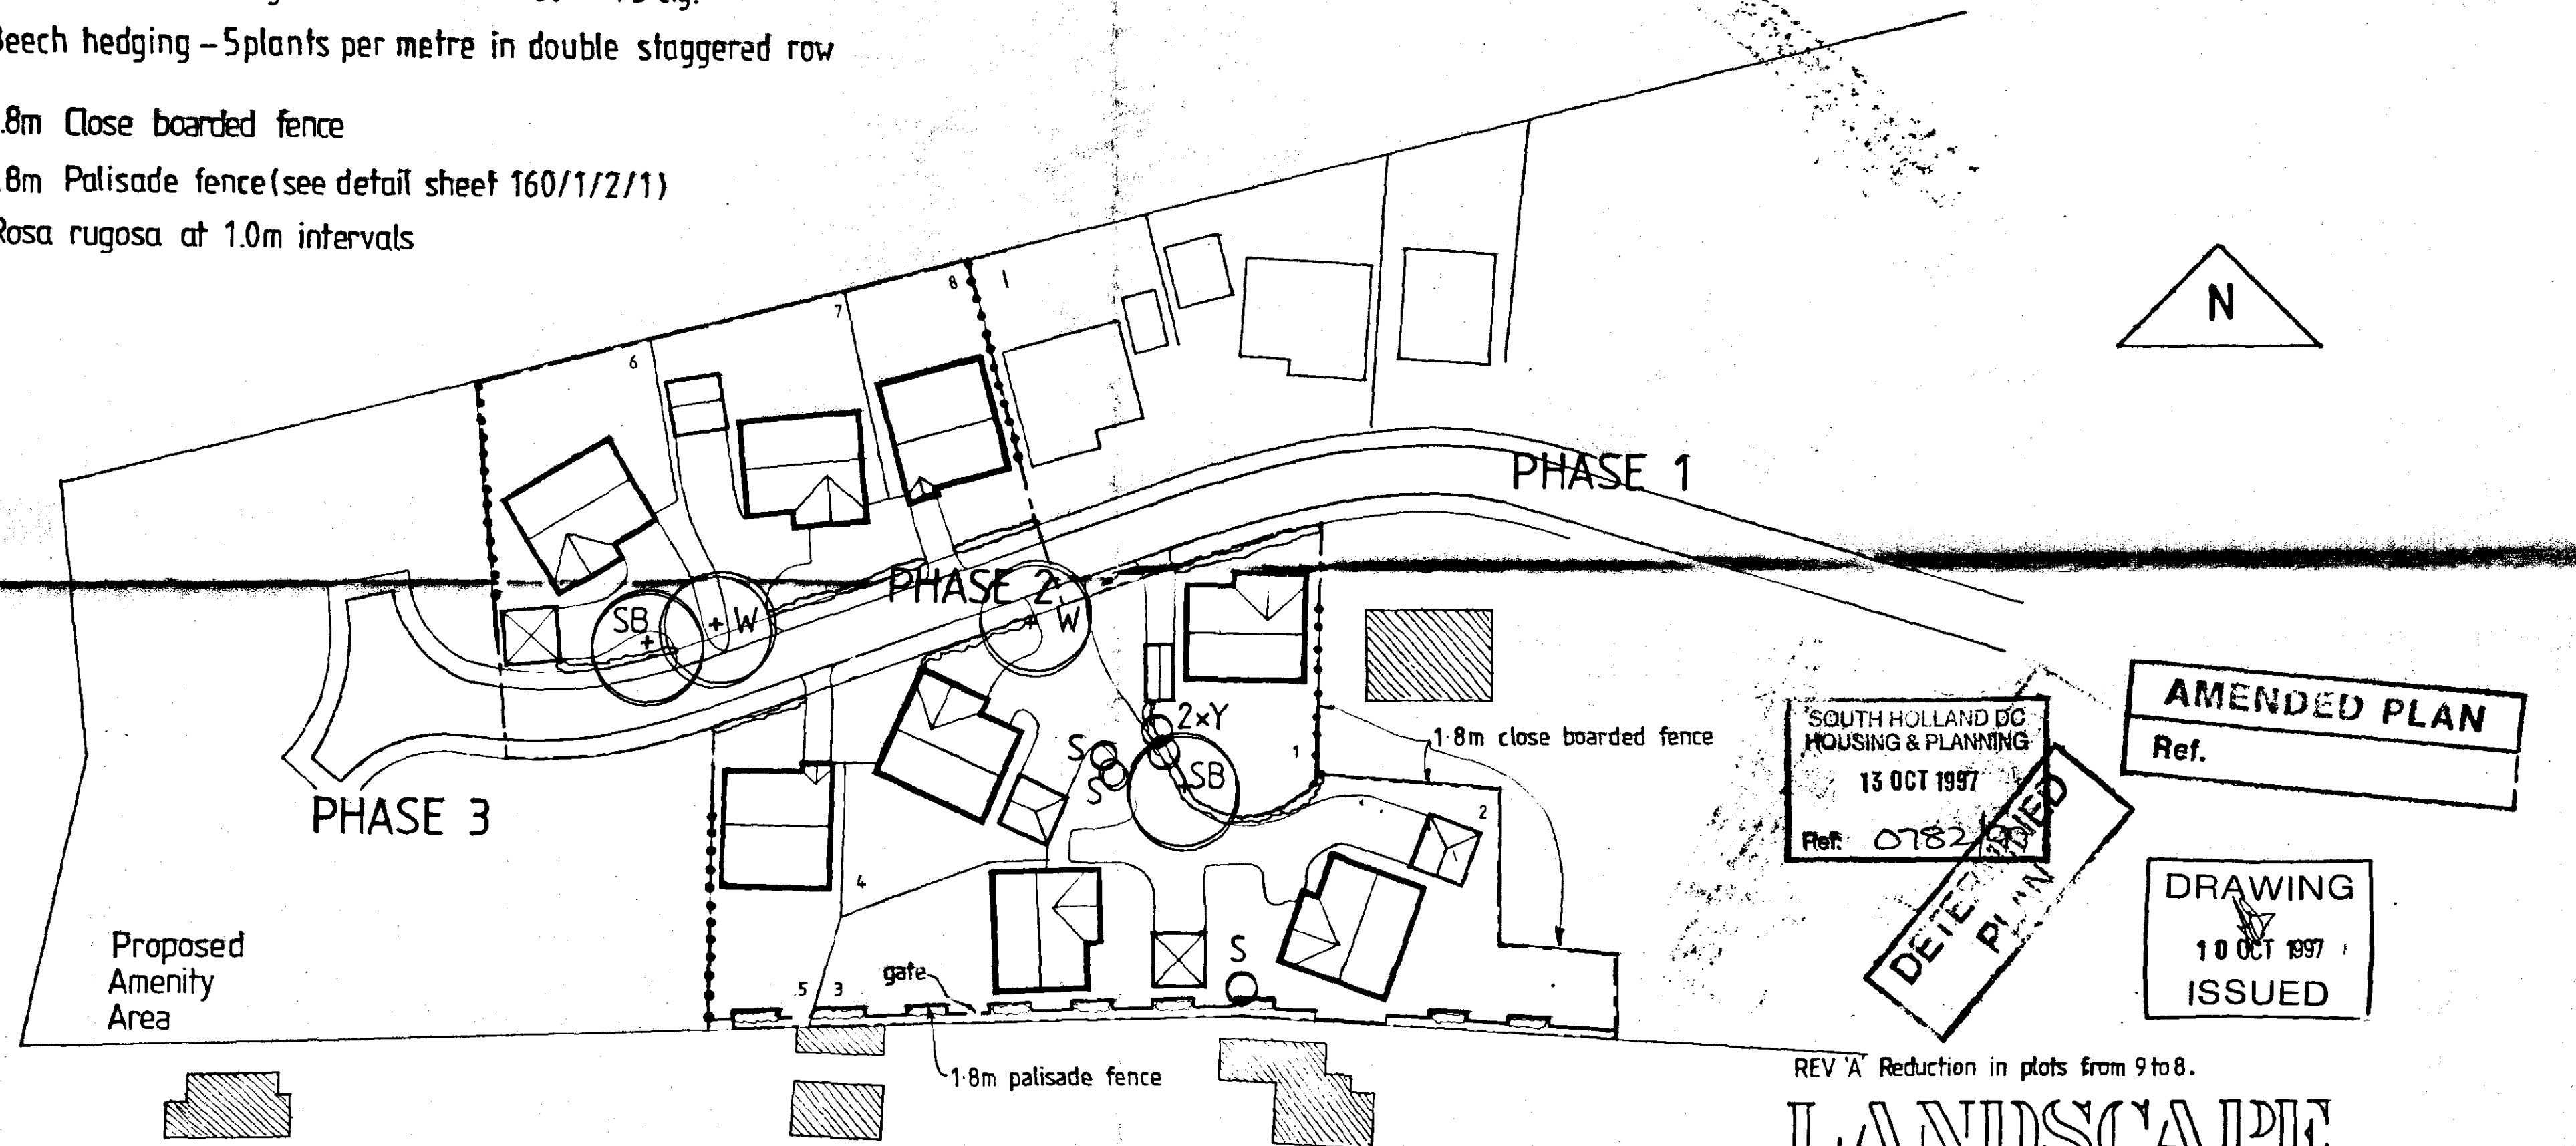


REV 'A' Reduction in plots from 9 to 8.

LANDSCAPE PHASE 2

ST. MARY'S MEADOWS, GEDNEY.
Dwg 160/3/2 Scale 1:500 June 97


Town & Country
Planning

Landscape Architecture

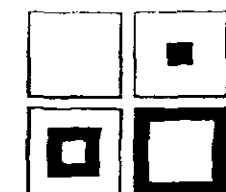


Robert
Doughty
Consultancy

32 High Street, Helpringham, Sleaford NG34 0RA Tel: (01529) 421646 Fax: (01529) 421358

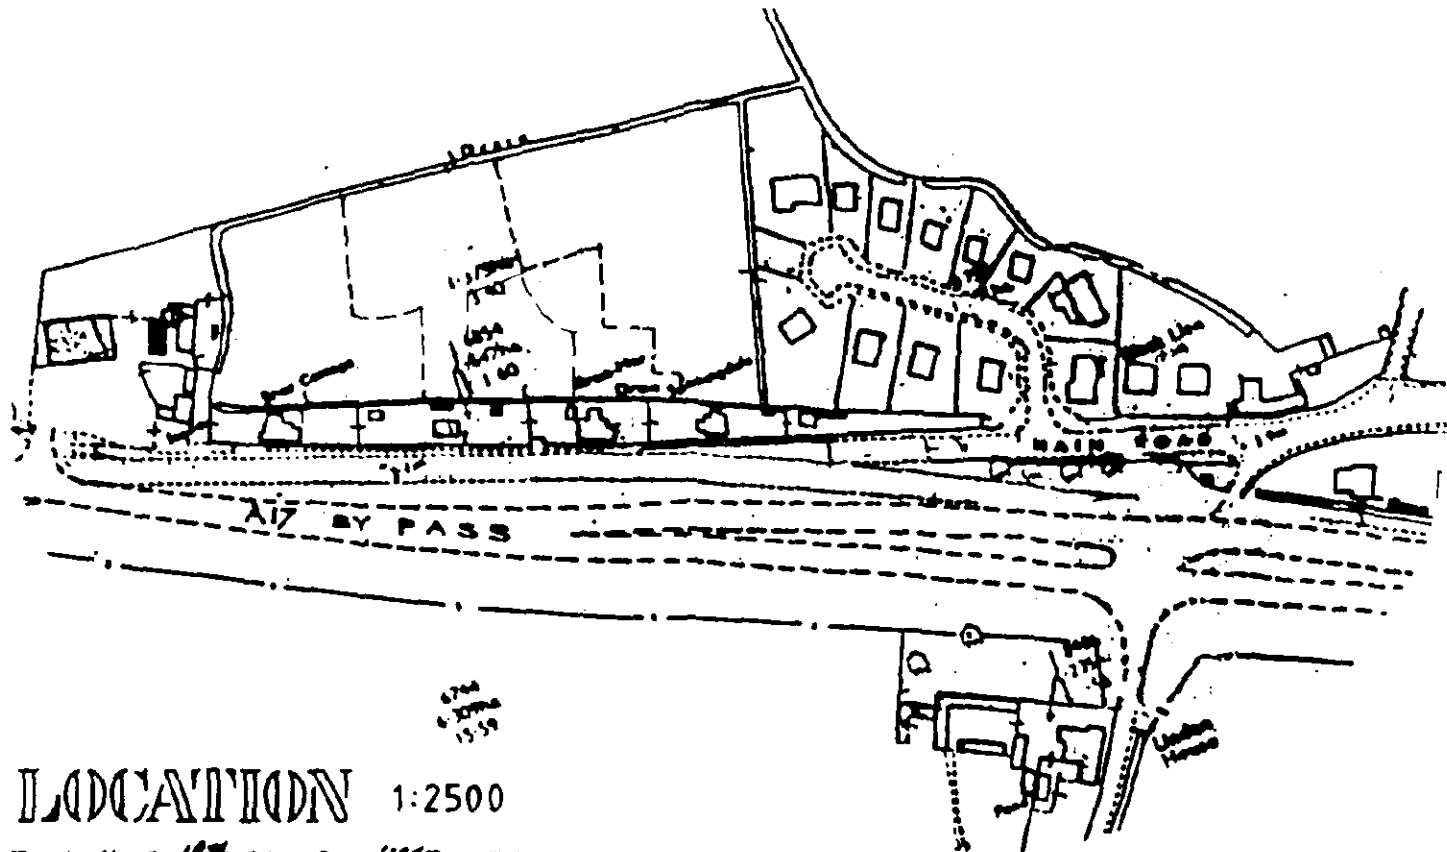

LOCATION 1:2500

"Reproduced from the 1974 Ordnance Survey 1:50,000 map with the permission of the Controller of Her Majesty's Stationery Office. Crown copyright reserved."
Robert Doughty Consultancy Licence Number AR 35372R0001

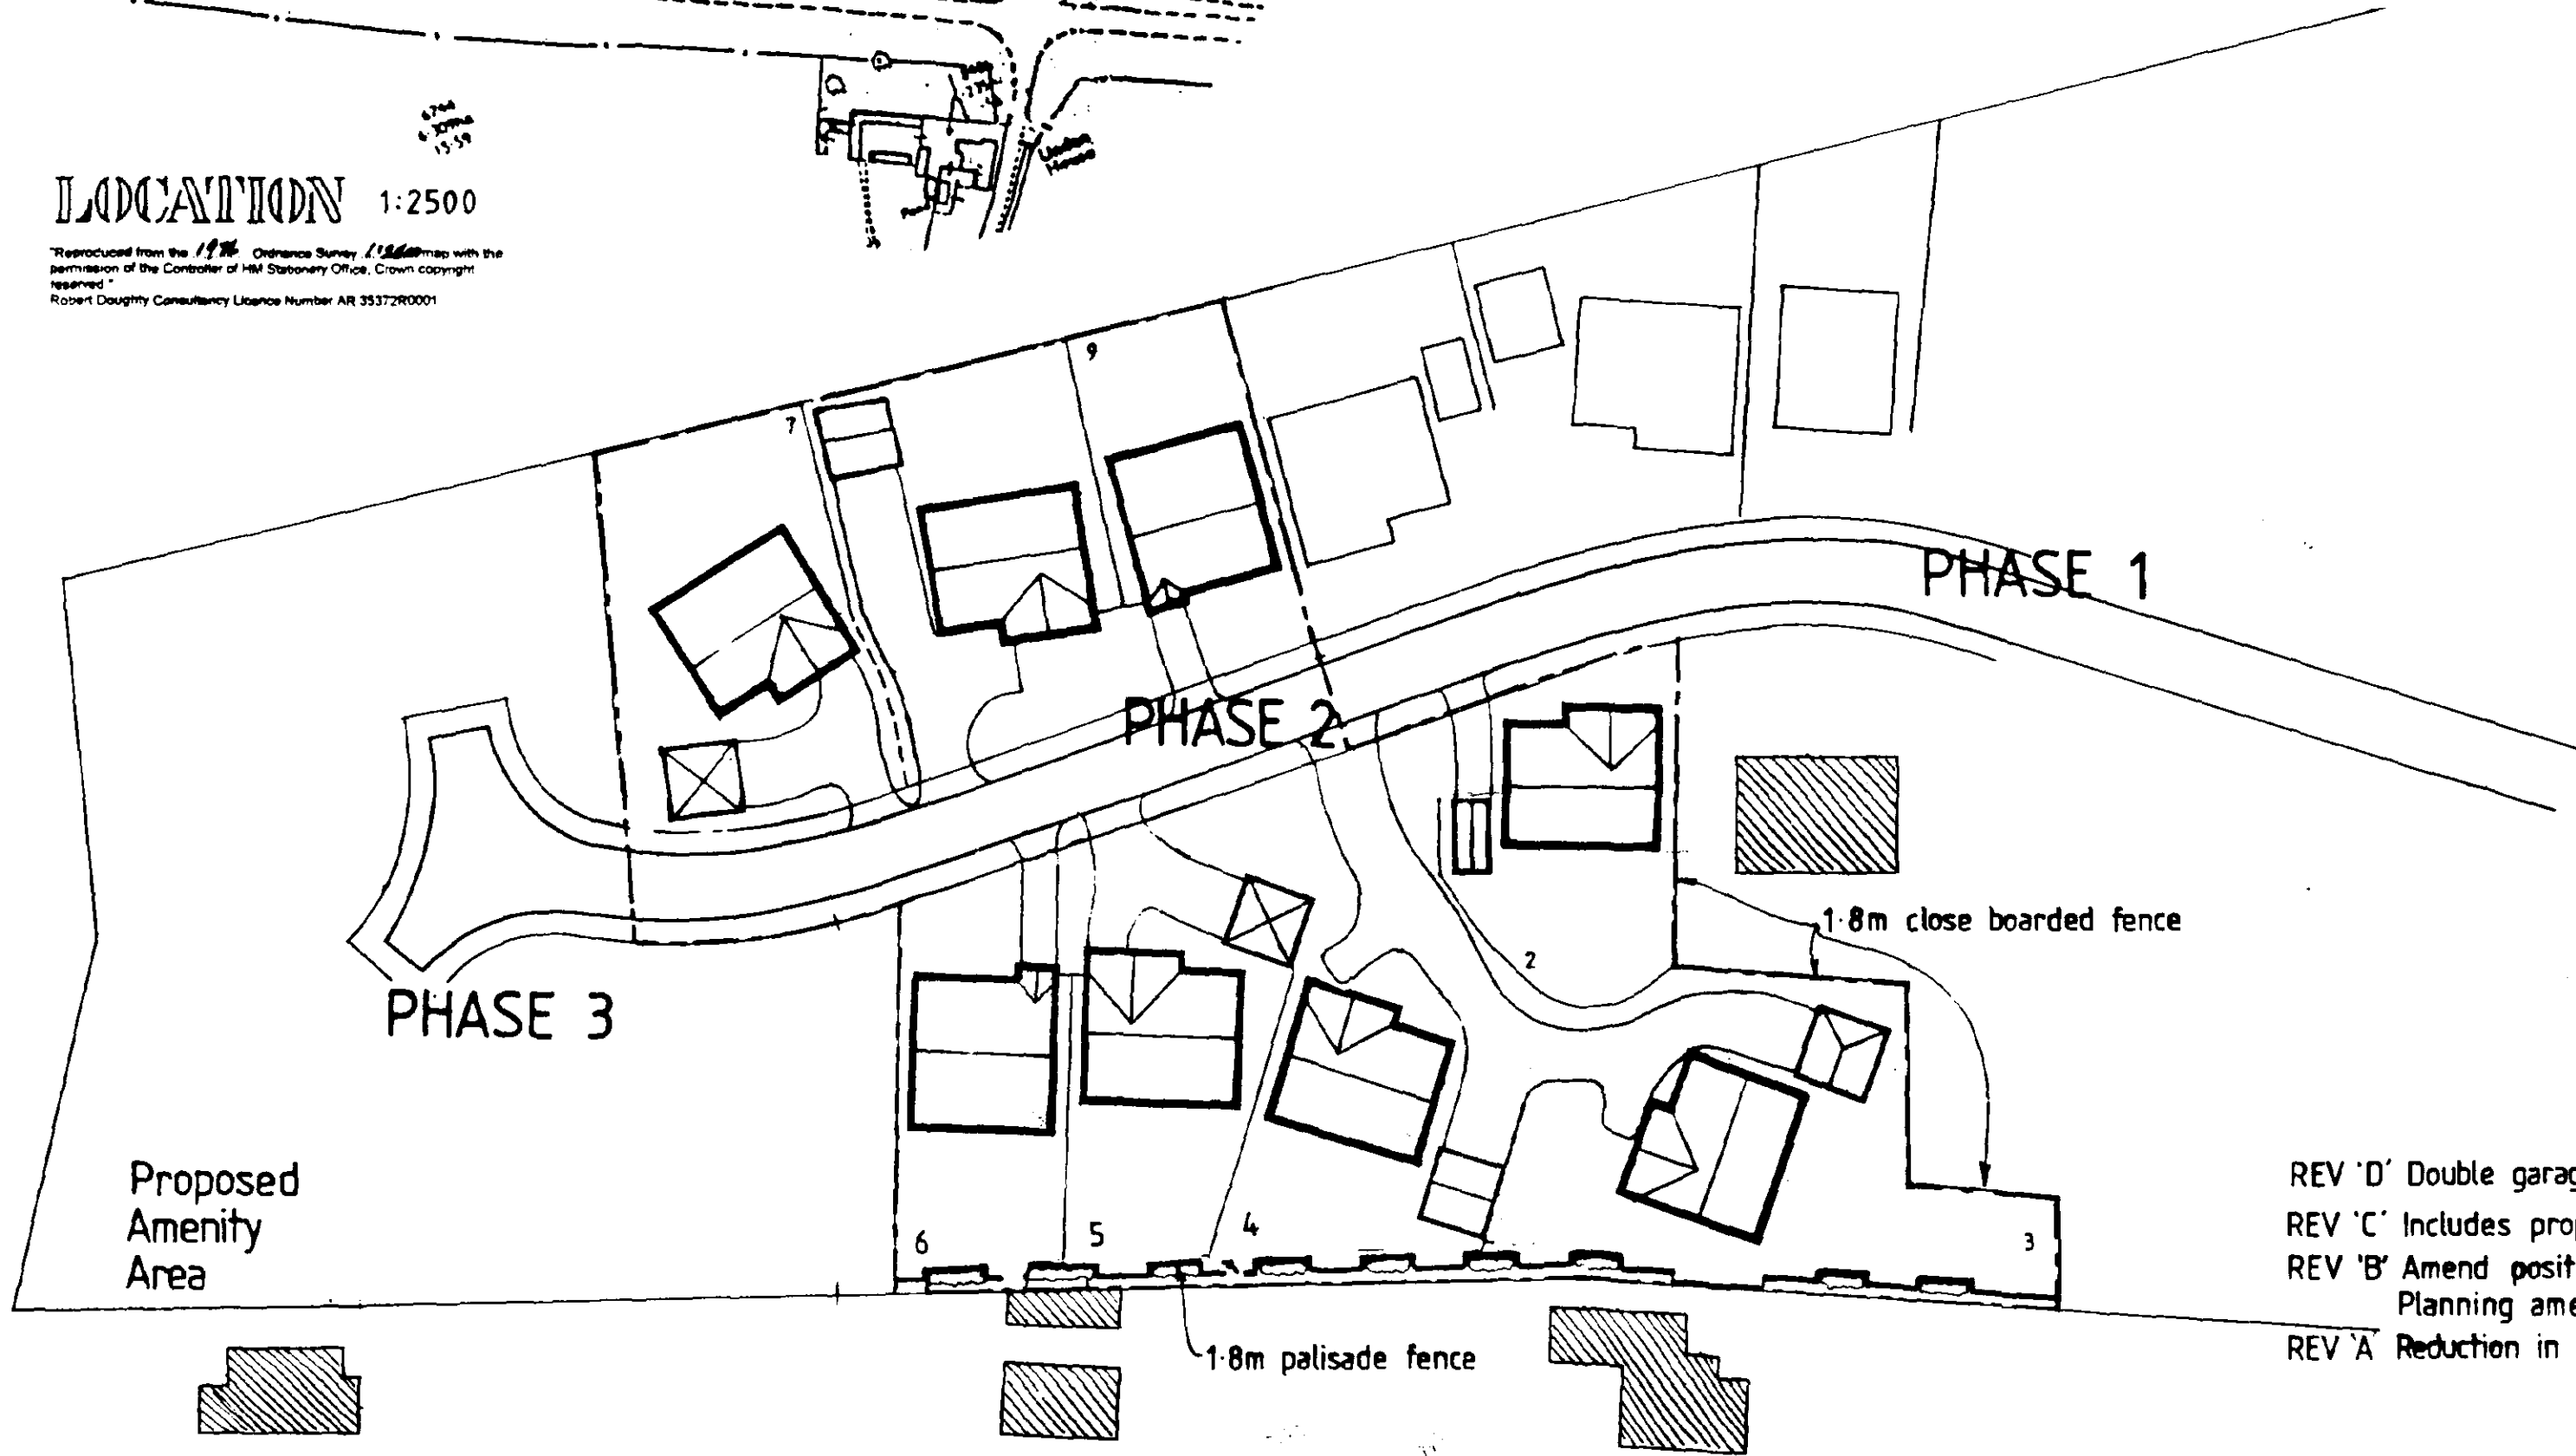

REV 'D' Double garage plot 8. 12/98
REV 'C' Includes proposed revised siting plots 4,5,6. 10/98
REV 'B' Amend positions of plots 3,7 & 9 and renumbering 24/7/98
Planning amendment application.
REV 'A' Reduction in plots from 9 to 8.

AMENDED PLAN
Ref. A/5

SOUTH HOLLAND DC
HOUSING & PLANNING
20 AUG 1999
Ref: 0782/97


LAYOUT. Phase 2 (PLOTS 2-9)
ST. MARY'S MEADOW. GEDNEY
Dwg 384/2/1A Scale 1:500 May 1998

Town & Country
Planning

Landscape Architecture

32 High Street, Helpringham, Sleaford NG34 0RA Tel: (01529) 421646 Fax: (01529) 421358

Robert
Doughty
Consultancy

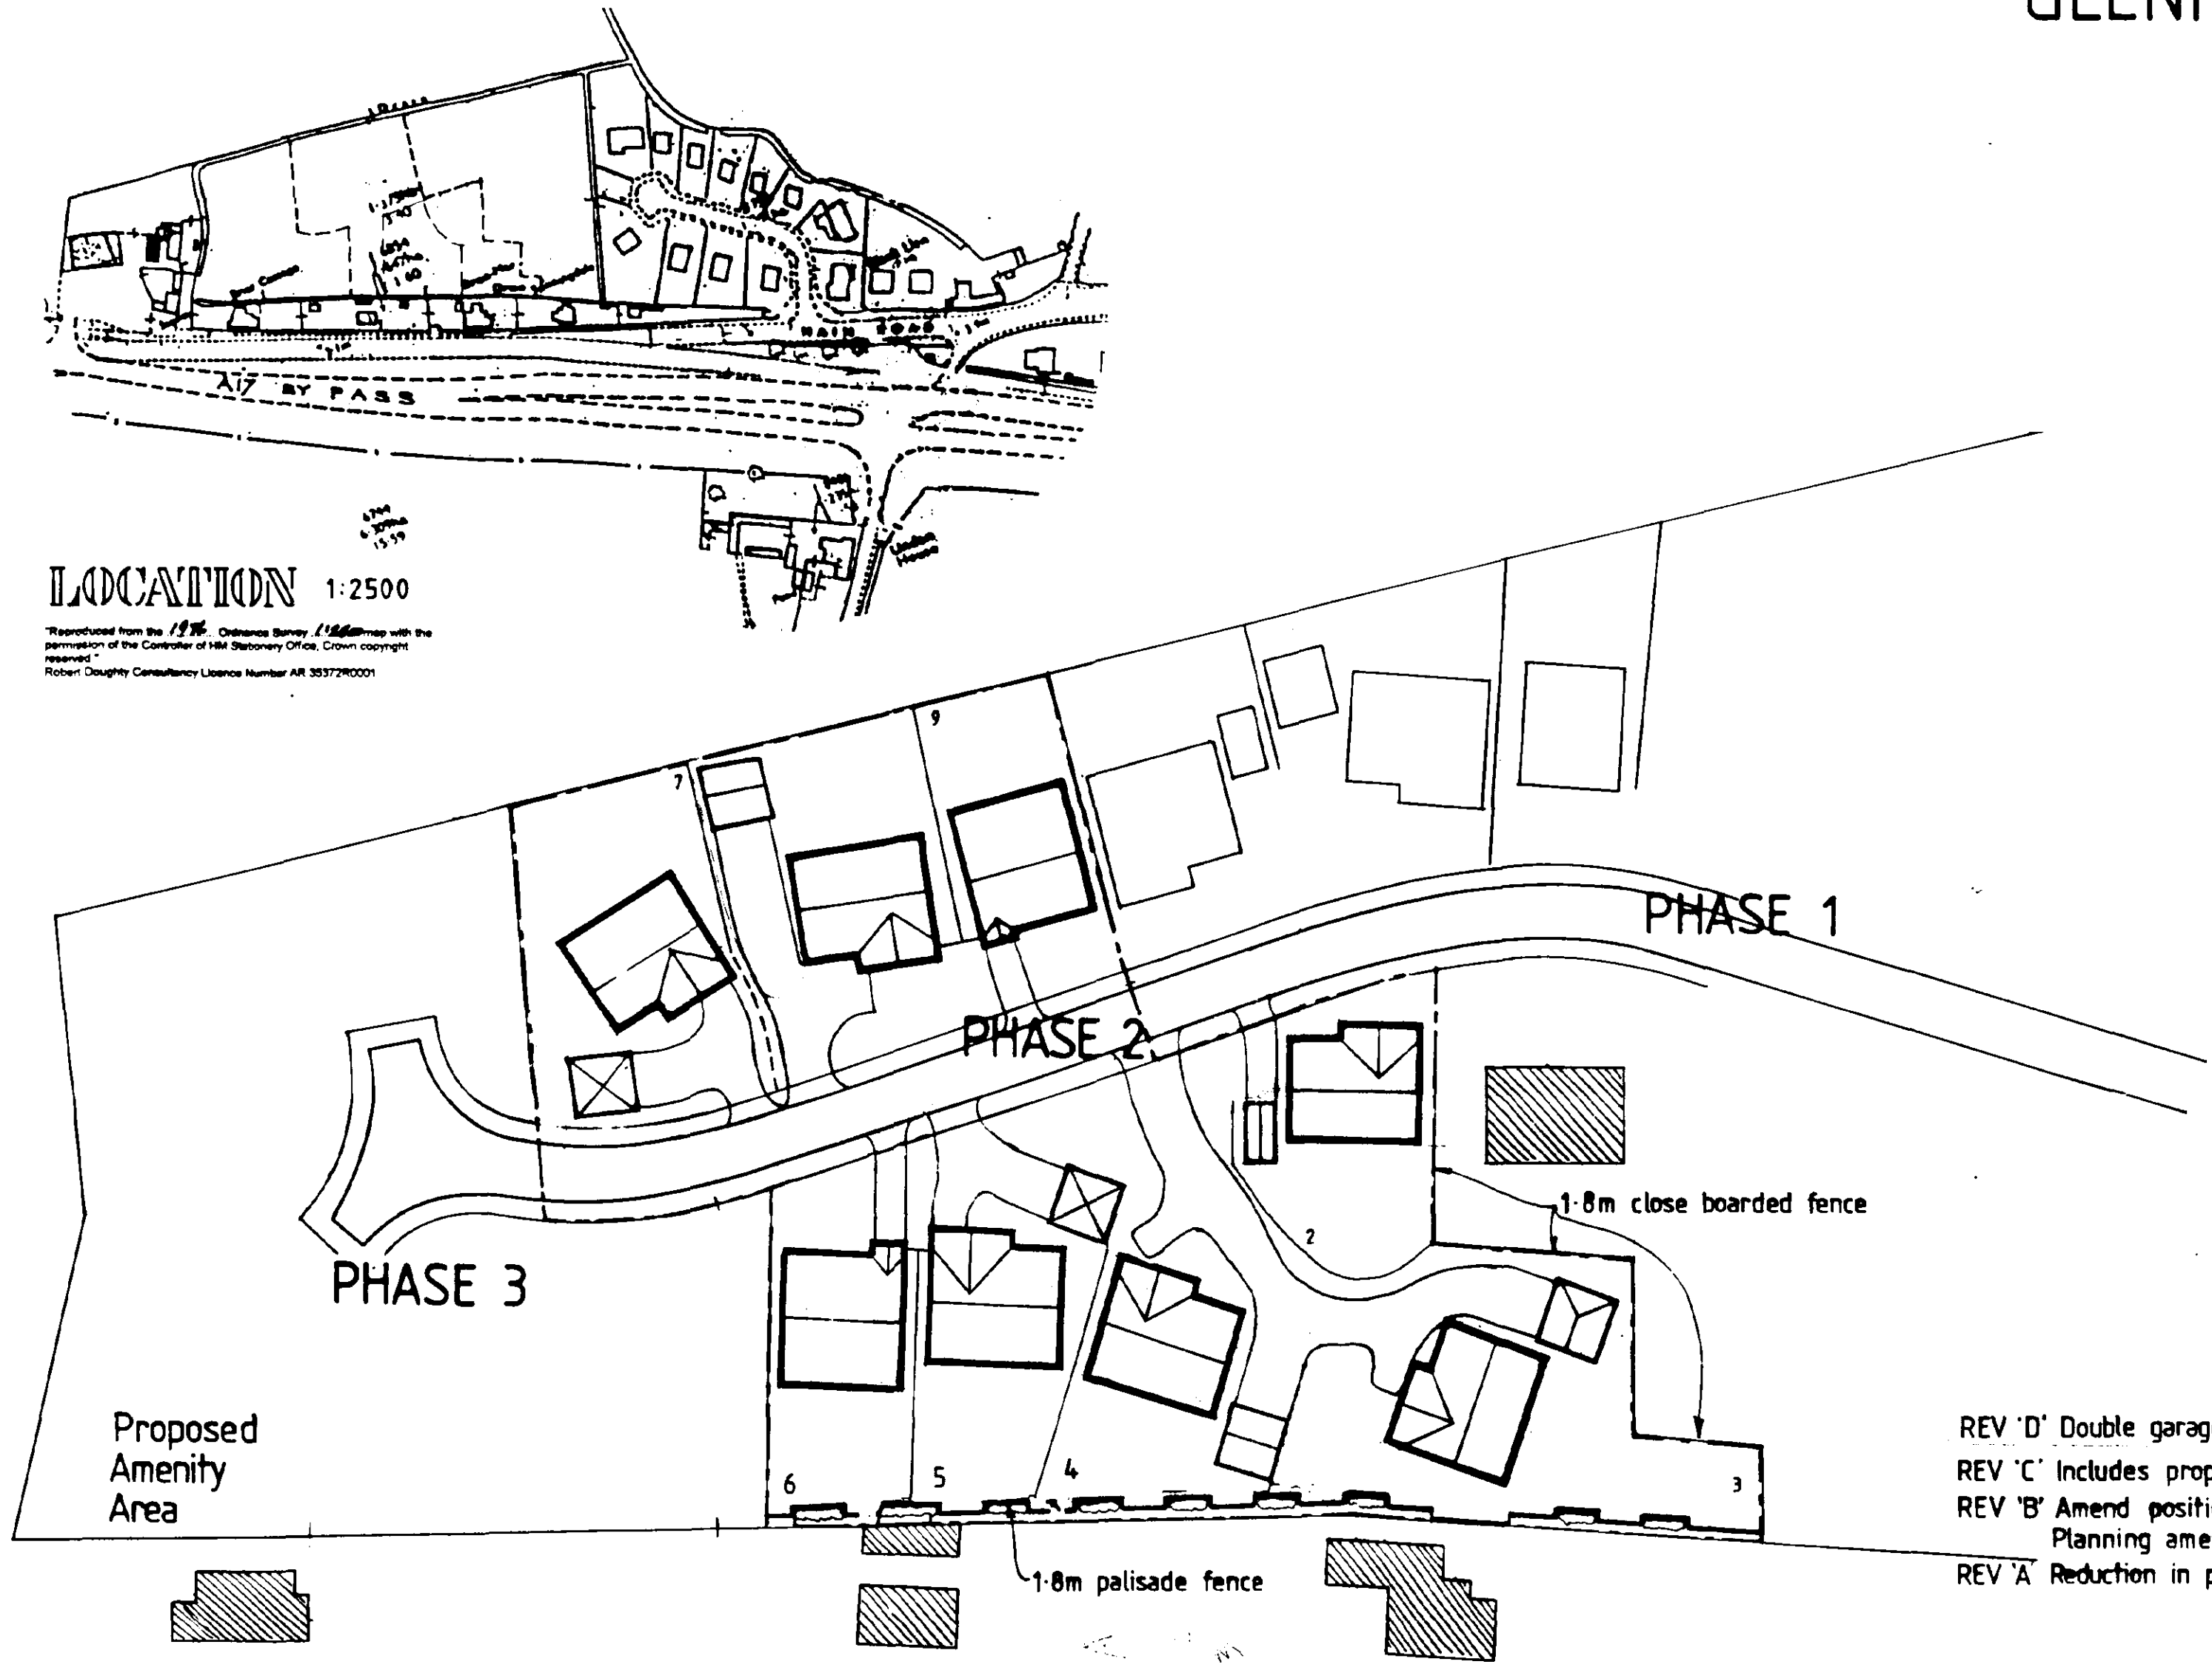

LOCATION 1:2500

"Reproduced from the 1995 Ordnance Survey 1:2500 map with the permission of the Controller of HM Stationery Office, Crown copyright reserved".
Robert Doughty Consultancy Licence Number AR 35372R0001

REV 'D' Double garage plot 8. 12/98
REV 'C' Includes proposed revised siting plots 4,5,6. 10/98
REV 'B' Amend positions of plots 3,7 & 9 and renumbering 24/7/98
Planning amendment application.
REV 'A' Reduction in plots from 9 to 8.


AMENDED PLAN
Ref. N/S

SOUTH HOLLAND DC
HOUSING & PLANNING
20 AUG 1999
Ref: 0782/97

LAYOUT. Phase 2 (PLOTS 2-9)
ST. MARY'S MEADOW. GEDNEY
Dwg 384/2/1A Scale 1:500 May 1998


Town & Country Planning		Robert Doughty Consultancy
Landscape Architecture		
32 High Street, Helpingham, Sleaford NG34 0RA Tel: (01529) 421046 Fax: (01529) 421358		

ROBERT DOUGHTY CONSULTANCY DEVELOPMENTS LIMITED

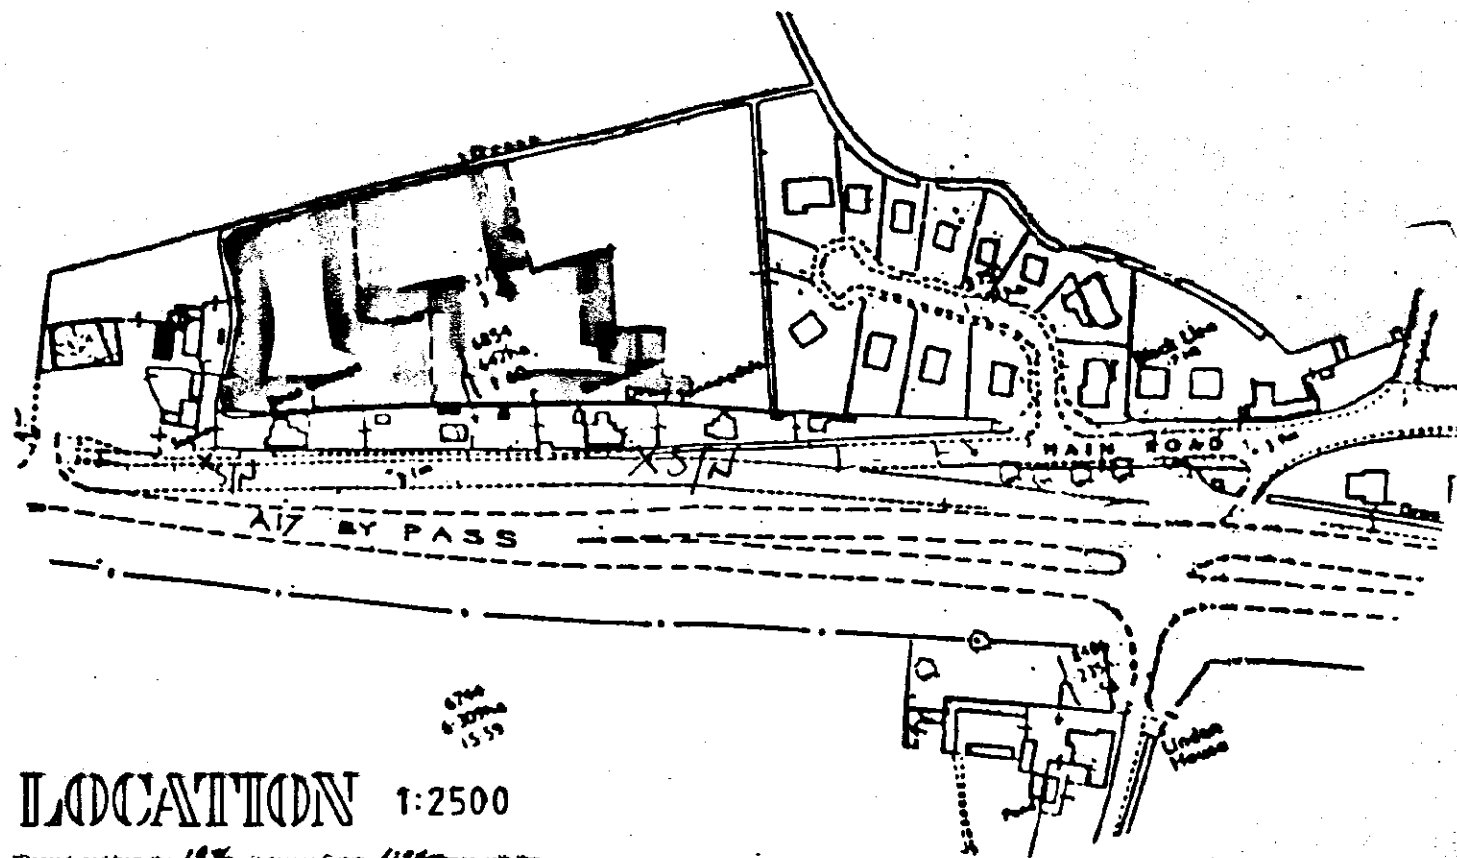

LOCATION 1:2500

"Reproduced from the 1976 Ordnance Survey 1:2500 map with the permission of the Controller of HM Stationery Office. Crown Copyright reserved."
 Robert Doughty Consultancy Licence Number AR 35372R0001

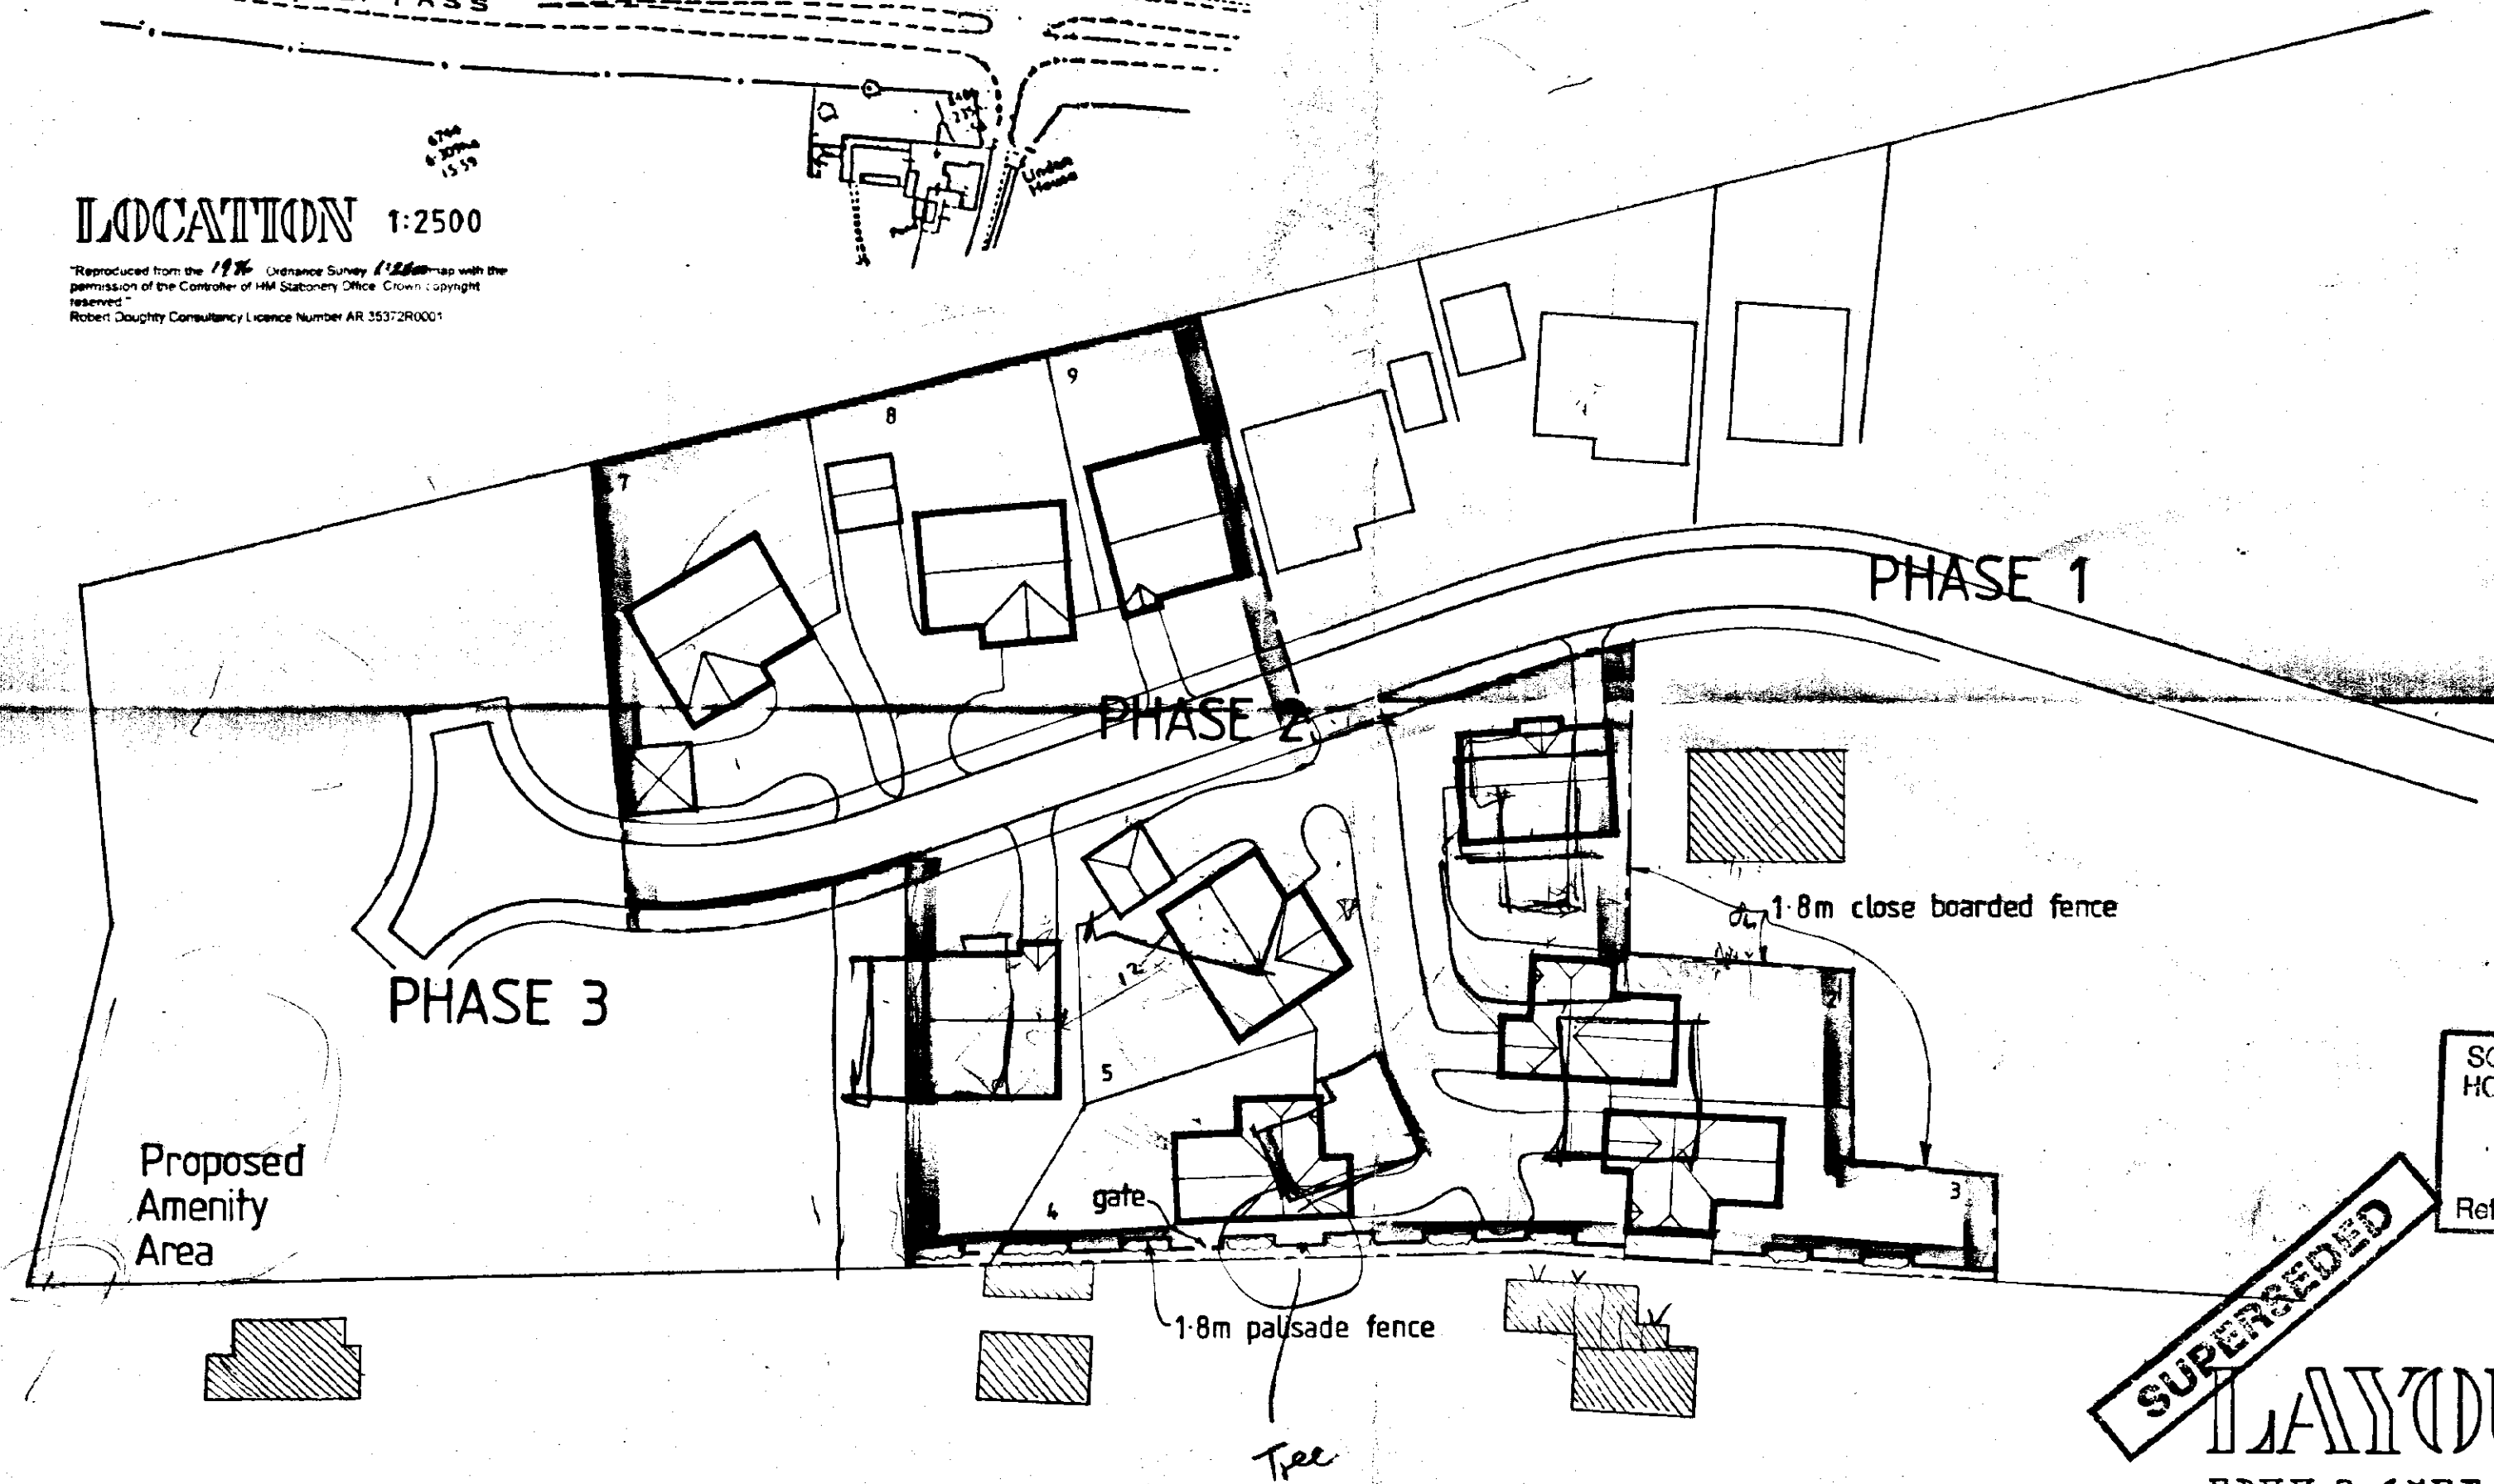

SOUTH HOLLAND DC
 HOUSING & PLANNING
 10 JUL 1997
 Ref: 0782/97

SUPERSEDED


LAYOUT
 PHASE 2

DRAWING
 3 JUL 1997
 ISSUED

ST. MARY'S MEADOWS. GEDDNEY.
 DWG 160/3/1 Scale 1:500 June 97


Town & Country Planning	☐	☒	Robert Doughty Consultancy
Landscape Architecture	☒	☐	
32 High Street, Helpingsham, Steaford NG34 0RA Tel: (01529) 421646 Fax: (01529) 421358			

MCKENNA DEVELOPMENTS LIMITED

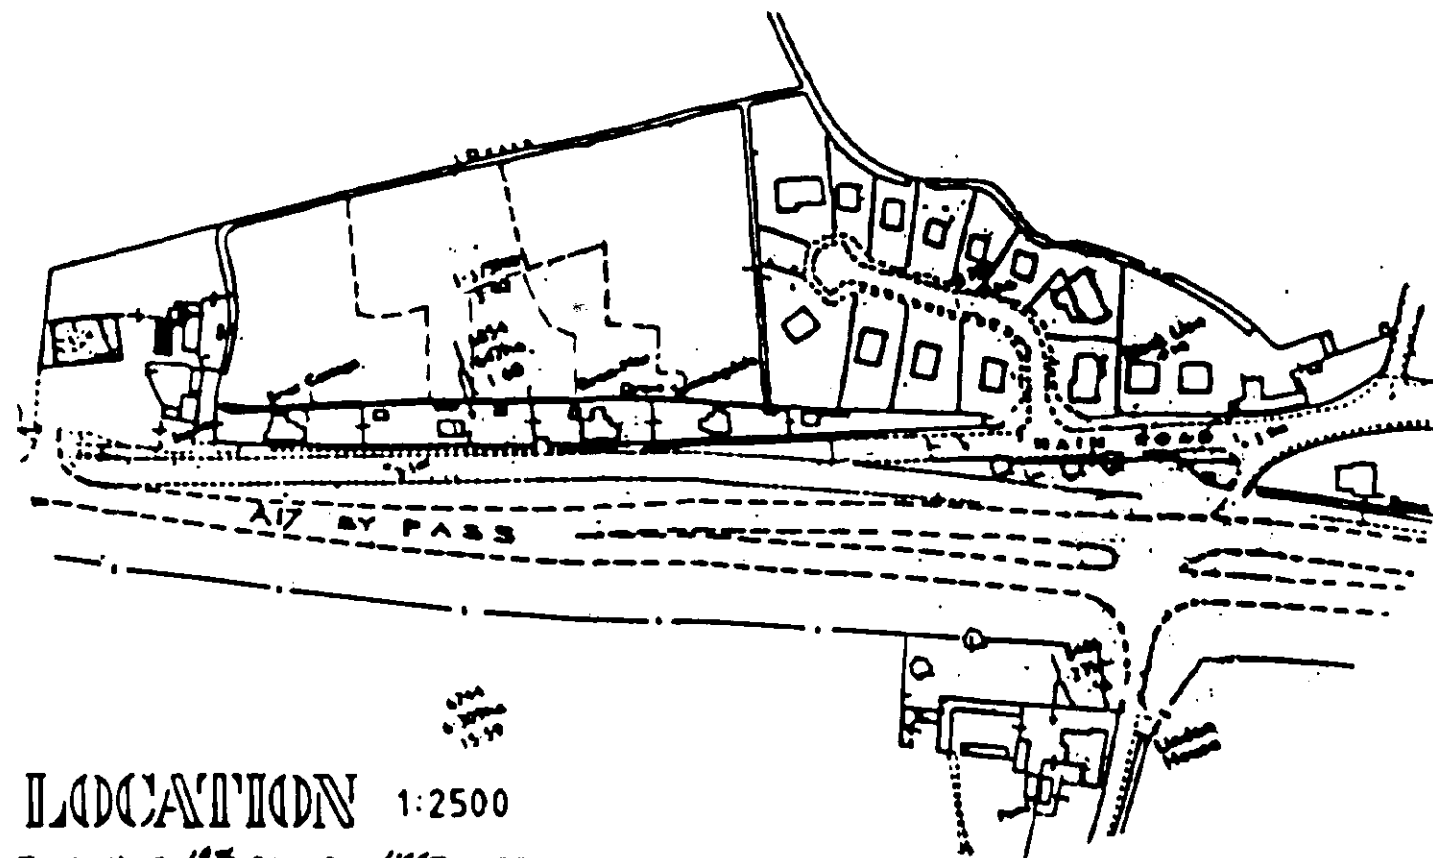


LOCATION 1:2500

*Reproduced from the 1:2500 Ordnance Survey 1:25000 map with the permission of the Controller of Her Majesty's Stationery Office. Crown copyright reserved.
Robert Doughty Consultancy Licence Number AR 363720001

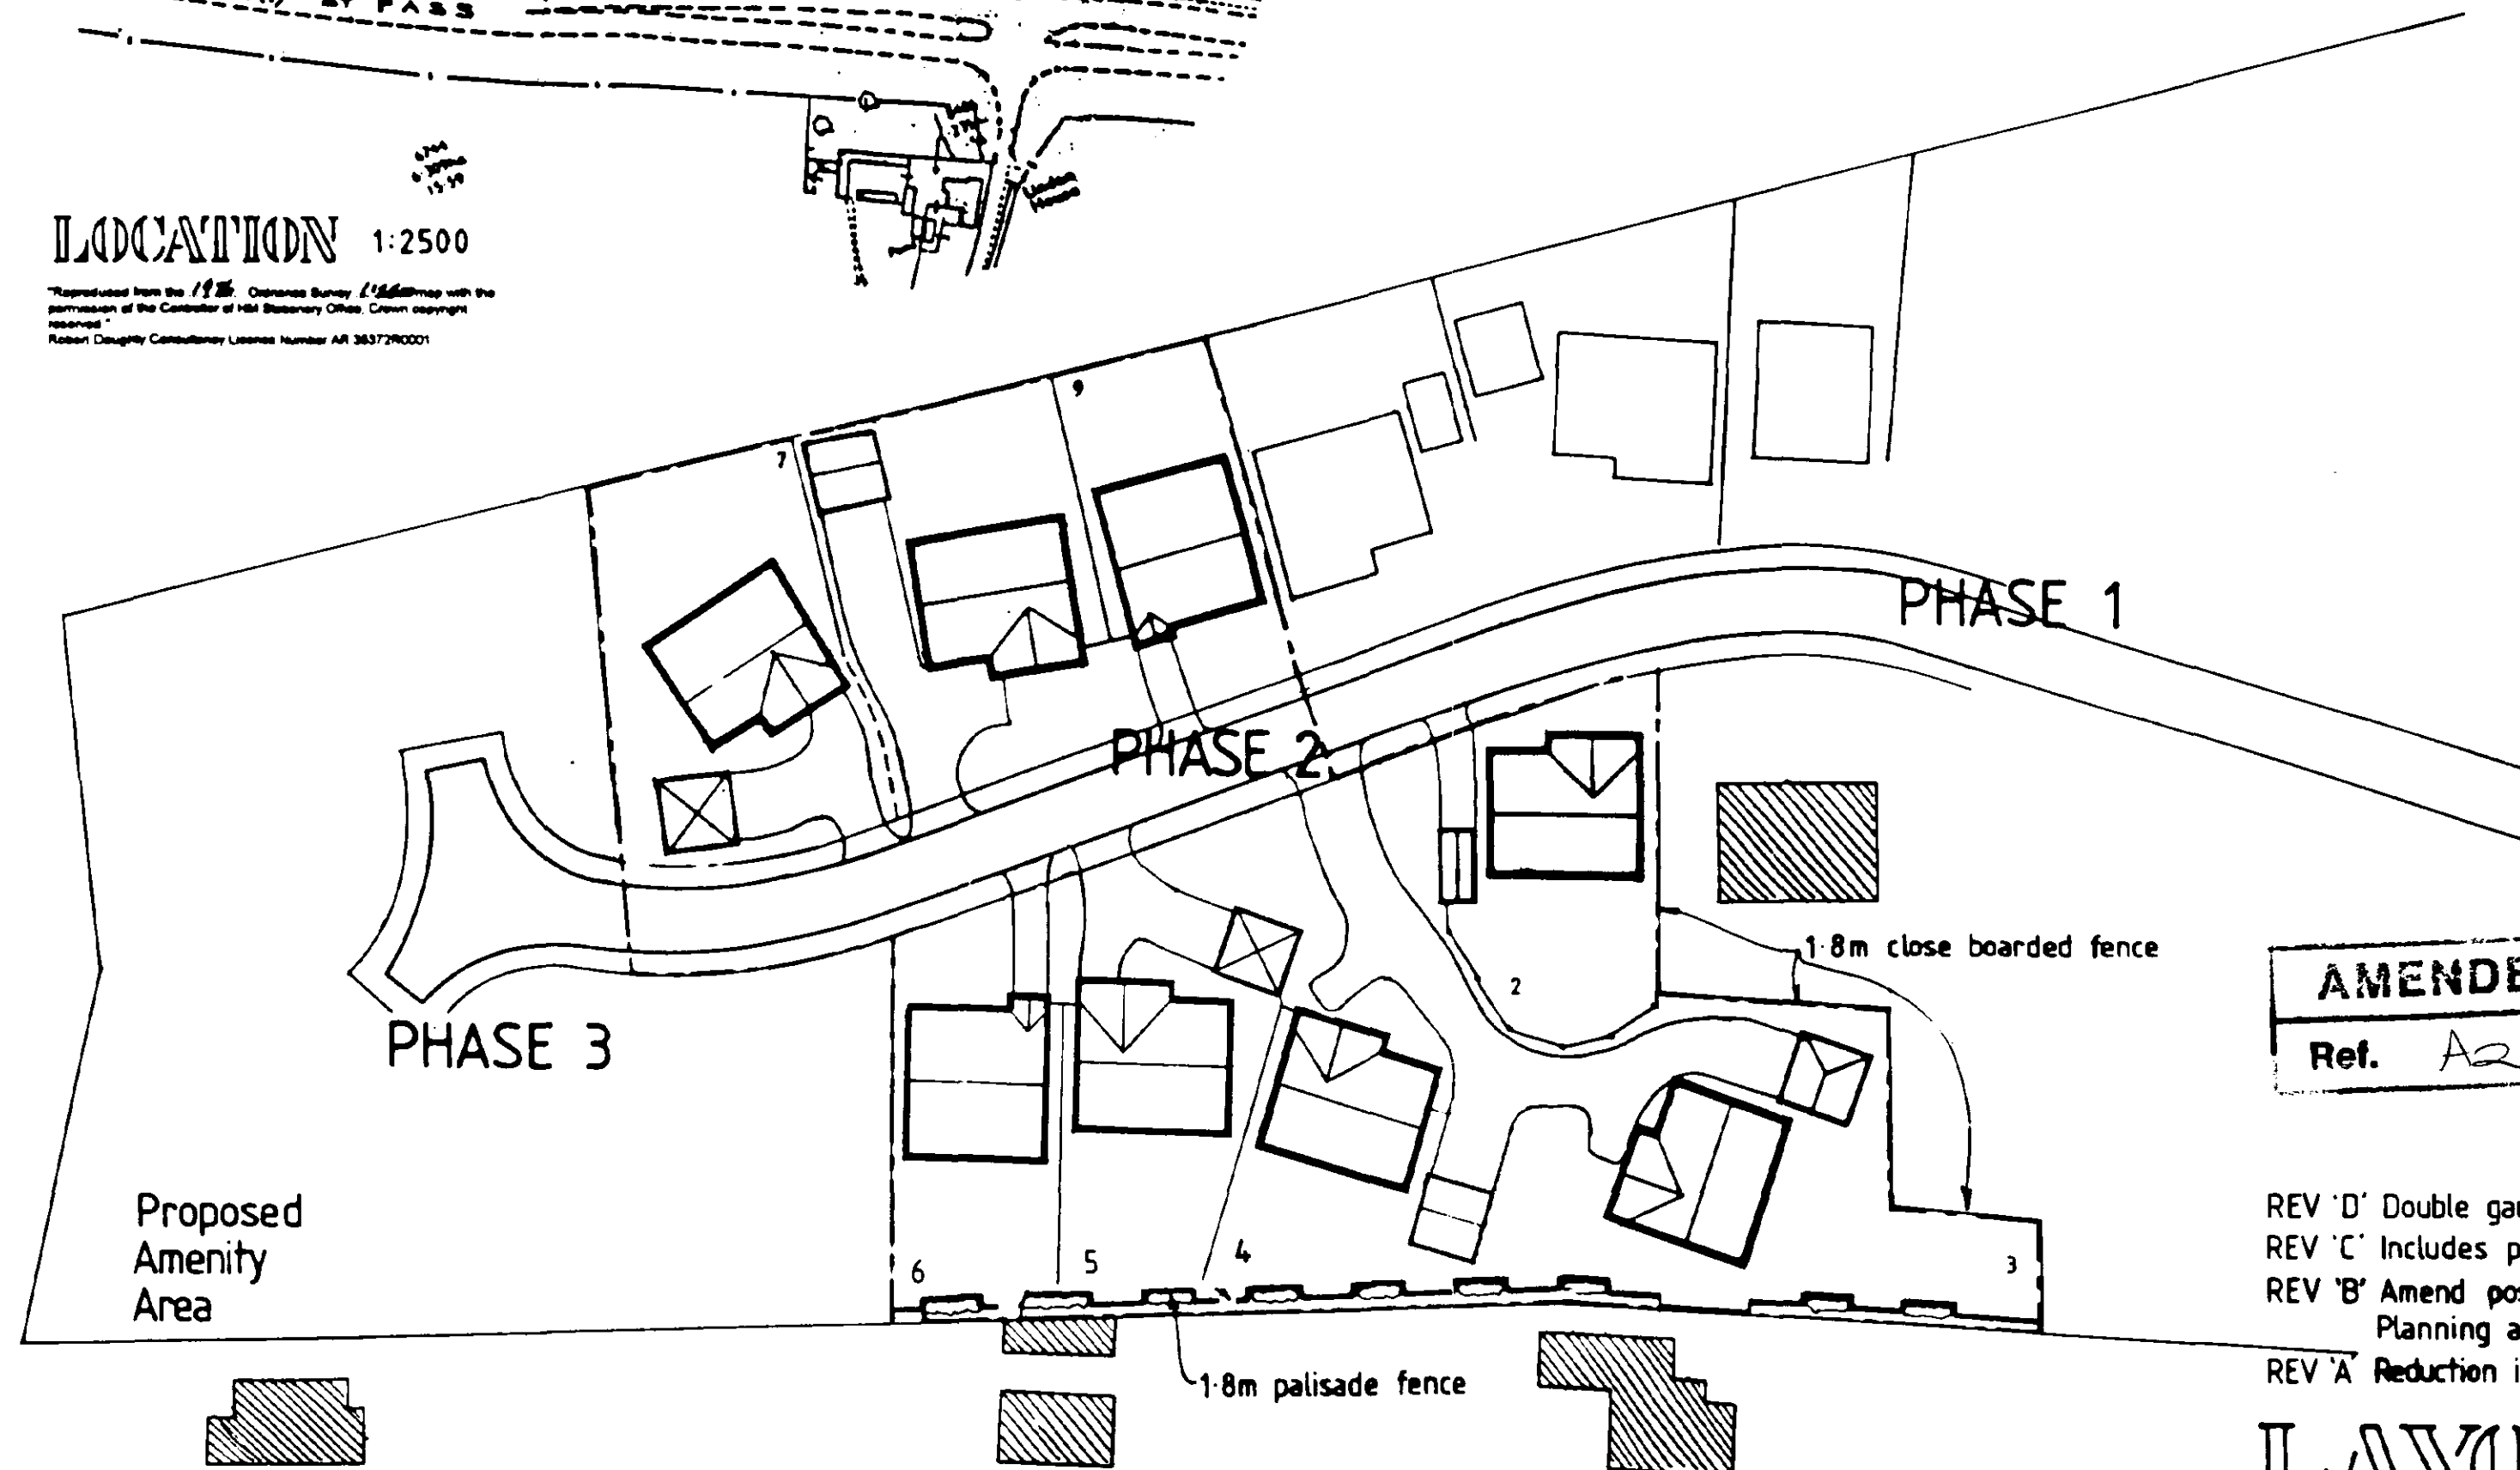

AMENDED PLAN

Ref. A2

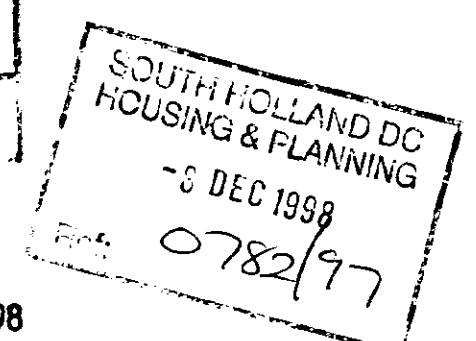

REV 'D' Double garage plot 8. 12/98

REV 'C' Includes proposed revised siting plots 4,5,6. 10/98

REV 'B' Amend positions of plots 3,7 & 9 and renumbering 26/7/98
Planning amendment application.

REV 'A' Reduction in plots from 9 to 8.

DRAWING

7 DEC 1998

ISSUED


**LAYOUT
PHASE 2**

ST. MARY'S MEADOWS. GEDNEY.

Dwg 160/3/10 Scale 1:5000 June 97

Town & Country
Planning


Landscape Architecture

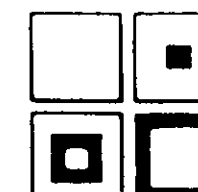

**Robert
Doughty
Consultancy**


32 High Street Helpingsham Sleaford NG34 0RA Tel: (01529) 421646 Fax: (01529) 421358

WILKINSON ARCHITECTS DEVELOPMENTS LIMITED

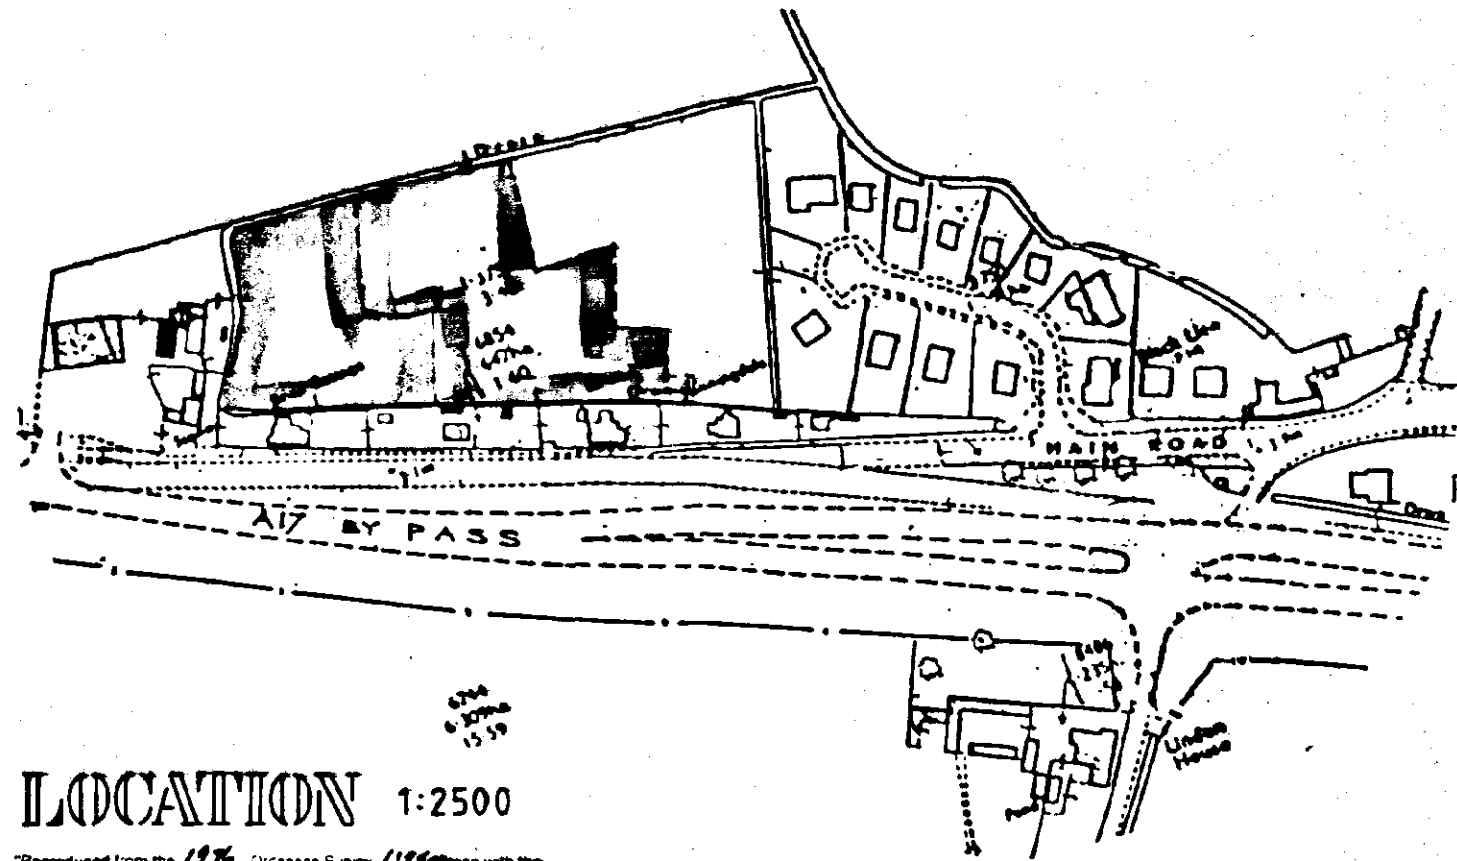

LOCATION 1:2500

"Reproduced from the 1976 Ordnance Survey 1:2500 map with the permission of the Controller of HM Stationery Office. Crown copyright reserved."
Robert Doughty Consultancy Licence Number AR 35372R0001

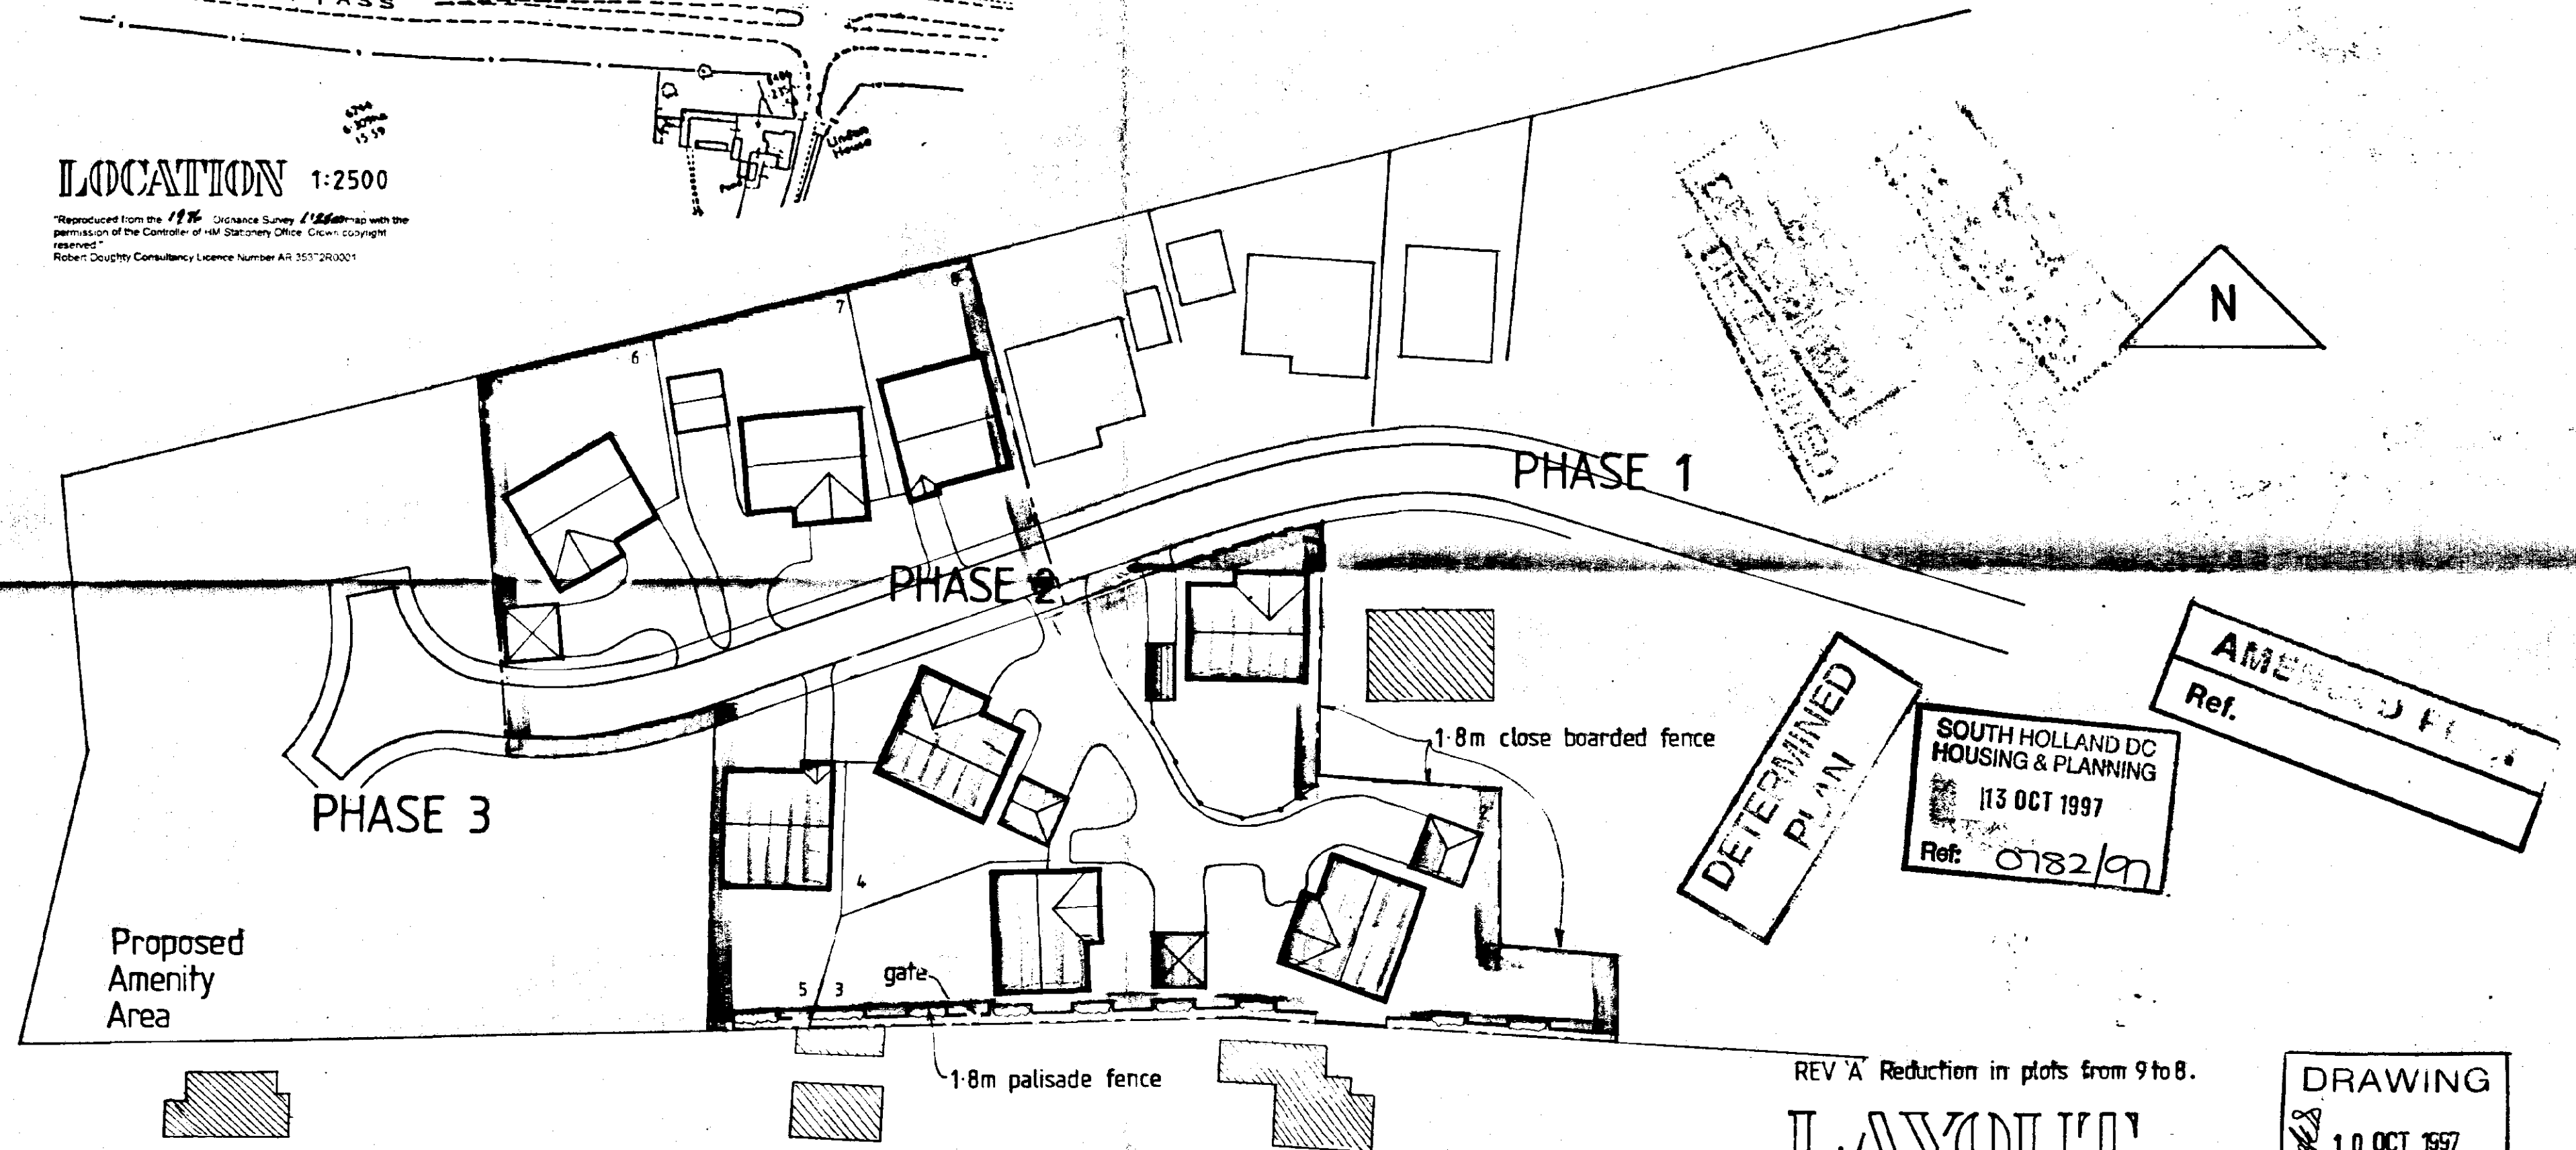

REV 'A' Reduction in plots from 9 to 8.


LAYOUT
PHASE 2

ST. MARY'S MEADOWS. GEDNEY.
Dwg 160/3/1A Scale 1:500 June 97

DRAWING
10 OCT 1997
ISSUED

Town & Country
Planning

Landscape Architecture

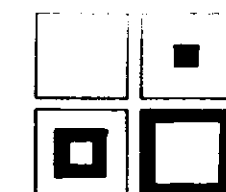

Robert
Doughty
Consultancy

32 High Street, Helpringham, Stamford NG34 0RA Tel: (01529) 421646 Fax: (01529) 421358