




- LANDSCAPING & TREE LANDSCAPING**
- G - MIXED HEDGING**
- (a) Hawthorn (Crataegus Monogyna)
  - (b) Beech (Fagus Sylvatica)
  - (c) Blackthorn (Prunus Spinos)
  - (d) Buckthorn (Rhamnus Cathartica)
- TREE PLANTING TO CONSIST OF NATURE SPECIES:-**
- A - SLIVER BIRCH (BETULA PENDULA) FEATHERED
  - B - HAWTHORN (CRATAEGUS MONOGYNA) FEATHERED
  - C - WHITE BEAM (SORBUS ARIA) FEATHERED
  - D - BEECH (FAGUS SYLVATICA) FEATHERED
  - E - BLACKTHORN (PRUNUS SPINOSA) FEATHERED
  - F - TURKISH HAZEL (CORYLUS COLURNA) FEATHERED
- All planting to be in accordance with BS 4428:1989 and amendment No. 1 (1991)
- All trees to be planted with minimum 0.6m plastic mulch mat and to be staked, tied and tubed.
- 1/3 to 1/2 bag of peat free tree and shrub planting compost to be incorporated into backfill for each tree hole.

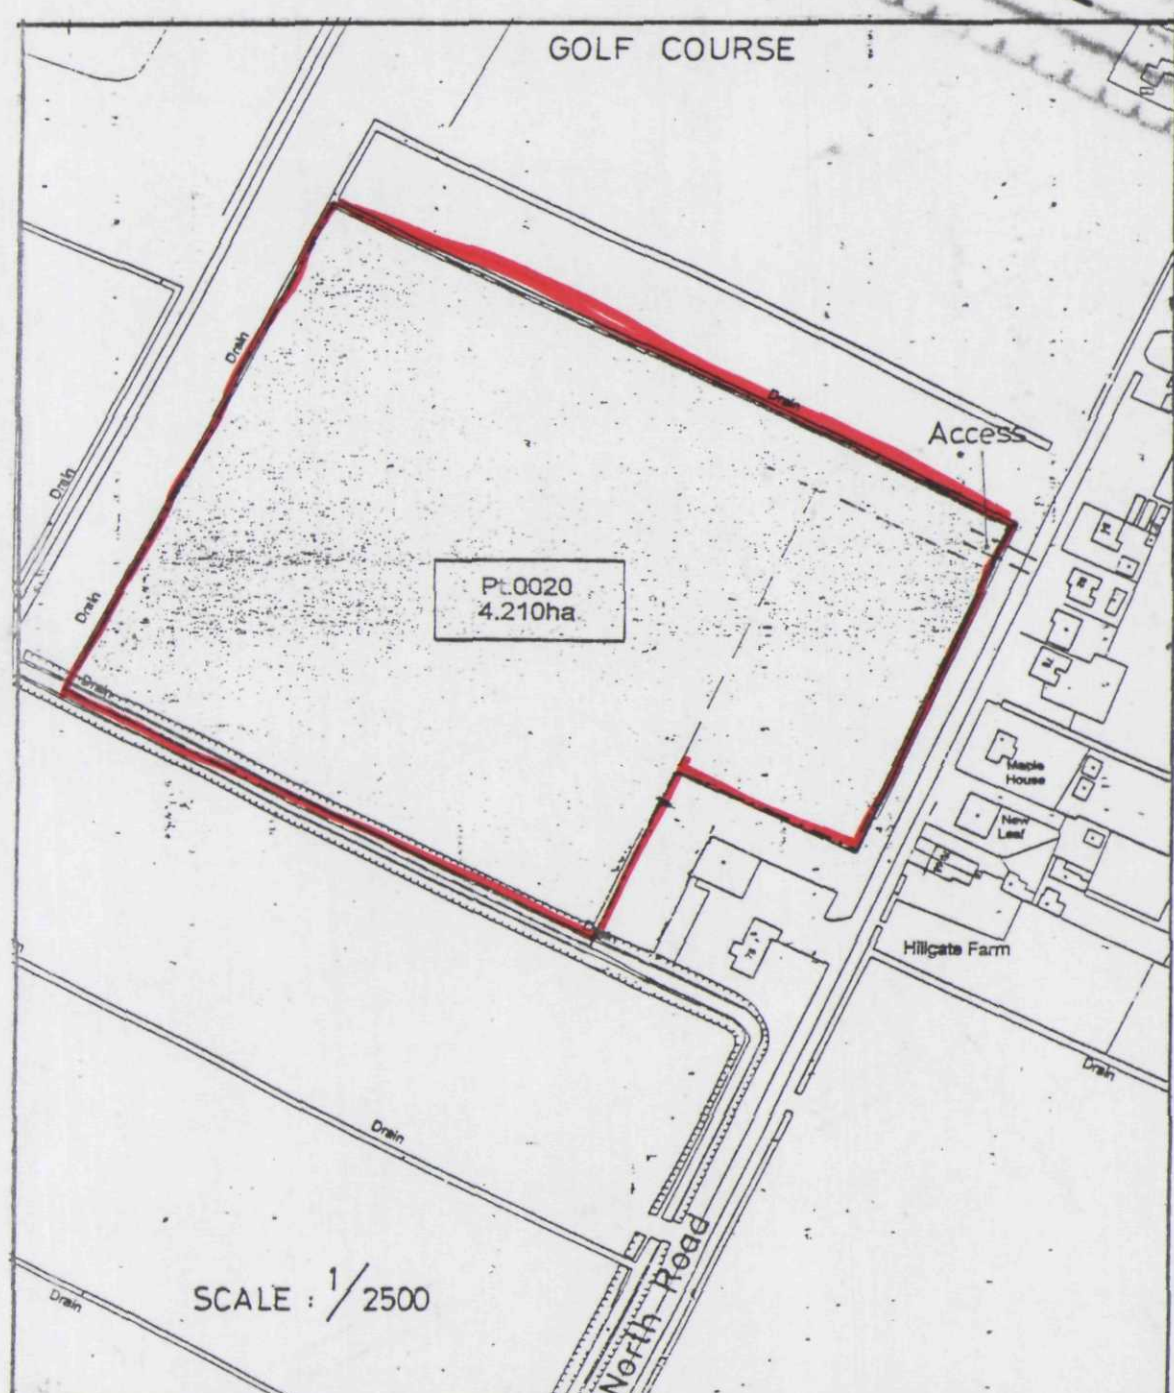

|   |                                  |           |
|---|----------------------------------|-----------|
| F | AS-BUILT RECEPTION               | DEC '05   |
| E | SITE MANAGERS OFFICE - AMENDMENT | OCT '04   |
| D | ANNOTATE TREE PLANTING           | OCT '04   |
| C | CARAVANS, TOILETS & RECEPTION    | JUL '04   |
| B | CONDITION COMPLIANCE             | APRIL '04 |
| A | FRONTAGE HEDGE NOTE              | APRIL '04 |

**G. R. MERCHANT**  
**I.ENG AMICE FWO**

**ARCHITECTURAL, STRUCTURAL AND LAND DRAINAGE CONSULTANTS**

Unit 4, Wrights Mews  
 12A Park Road, Holbeach,  
 Spalding, Lincs. PE12 7EE  
 Tel: 01406 490800  
 Fax: 01406 425744  
 E-Mail: G. R. Merchant @ Merchant. FD.  
 Co. UK

Project  
 CHANGE OF USE  
 NORTH ROAD  
 GEDNEY HILL  
 SPALDING, Lincs

Client  
 S. KENNELLY

Drawing  
 SITE & LOCATION PLANS  
 [ FISHING LAKES & AMENITIES ]

|          |             |
|----------|-------------|
| Job Ref. | Drawing No. |
| 546/02   | 01F         |

|          |       |
|----------|-------|
| Date     | Drawn |
| DEC 2002 | CRM   |

Scales  
 1/500 1/2500

**DO NOT SCALE FROM THIS DRAWING**

This drawing is copyright and may not be altered, traced, photographed or used for any other purpose other than that for which it is issued. The General Contractor is to check all dimensions on site and report any discrepancies to the Architect. All details shown on this drawing including foundations are based upon typical site conditions related to the area. No responsibility can be accepted for abnormal conditions which may be discovered during construction unless reported to the Architect so that design amendments may be considered. Site soil surveys are recommended in respect of foundations to establish specific site conditions before foundation work is undertaken. This drawing is limited in the amount of information contained and does not purport to contain a full specification of the works. It is solely for the purpose of obtaining Planning / Building Regulation approval. This drawing must not be used as a contract document. The works will not be supervised or inspected on site by G. R. Merchant or any representative thereof. It is the client or their appointed agents responsibility to control workmanship, substitution of materials, adherence to specification, variations to contract etc.

All materials to be new unless otherwise stated and all components and materials etc. to be used fitted and installed etc. in strict accordance with manufacturers instruction and relevant code of practice. Materials shall conform to appropriate British standard specification or BSIA certificate or European code equivalent. The Employer / Client shall ensure that the selected contractor is conversant with and adopts all measures necessary to achieve compliance with Health and Safety legislation for Building sites and Work places. The Employer / Client is advised that should the works need to comply with the Construction Design and Management Regulations an independent Planning Supervisor will be required. This works shall comprise of all that is shown on the drawing and details. Work that may not specifically shown but may be reasonably inferred as necessary to carry out the works shall be deemed to be included.

SHDC  
 Planning & Development  
 14 FEB 2005  
 Ref: 1034/04