
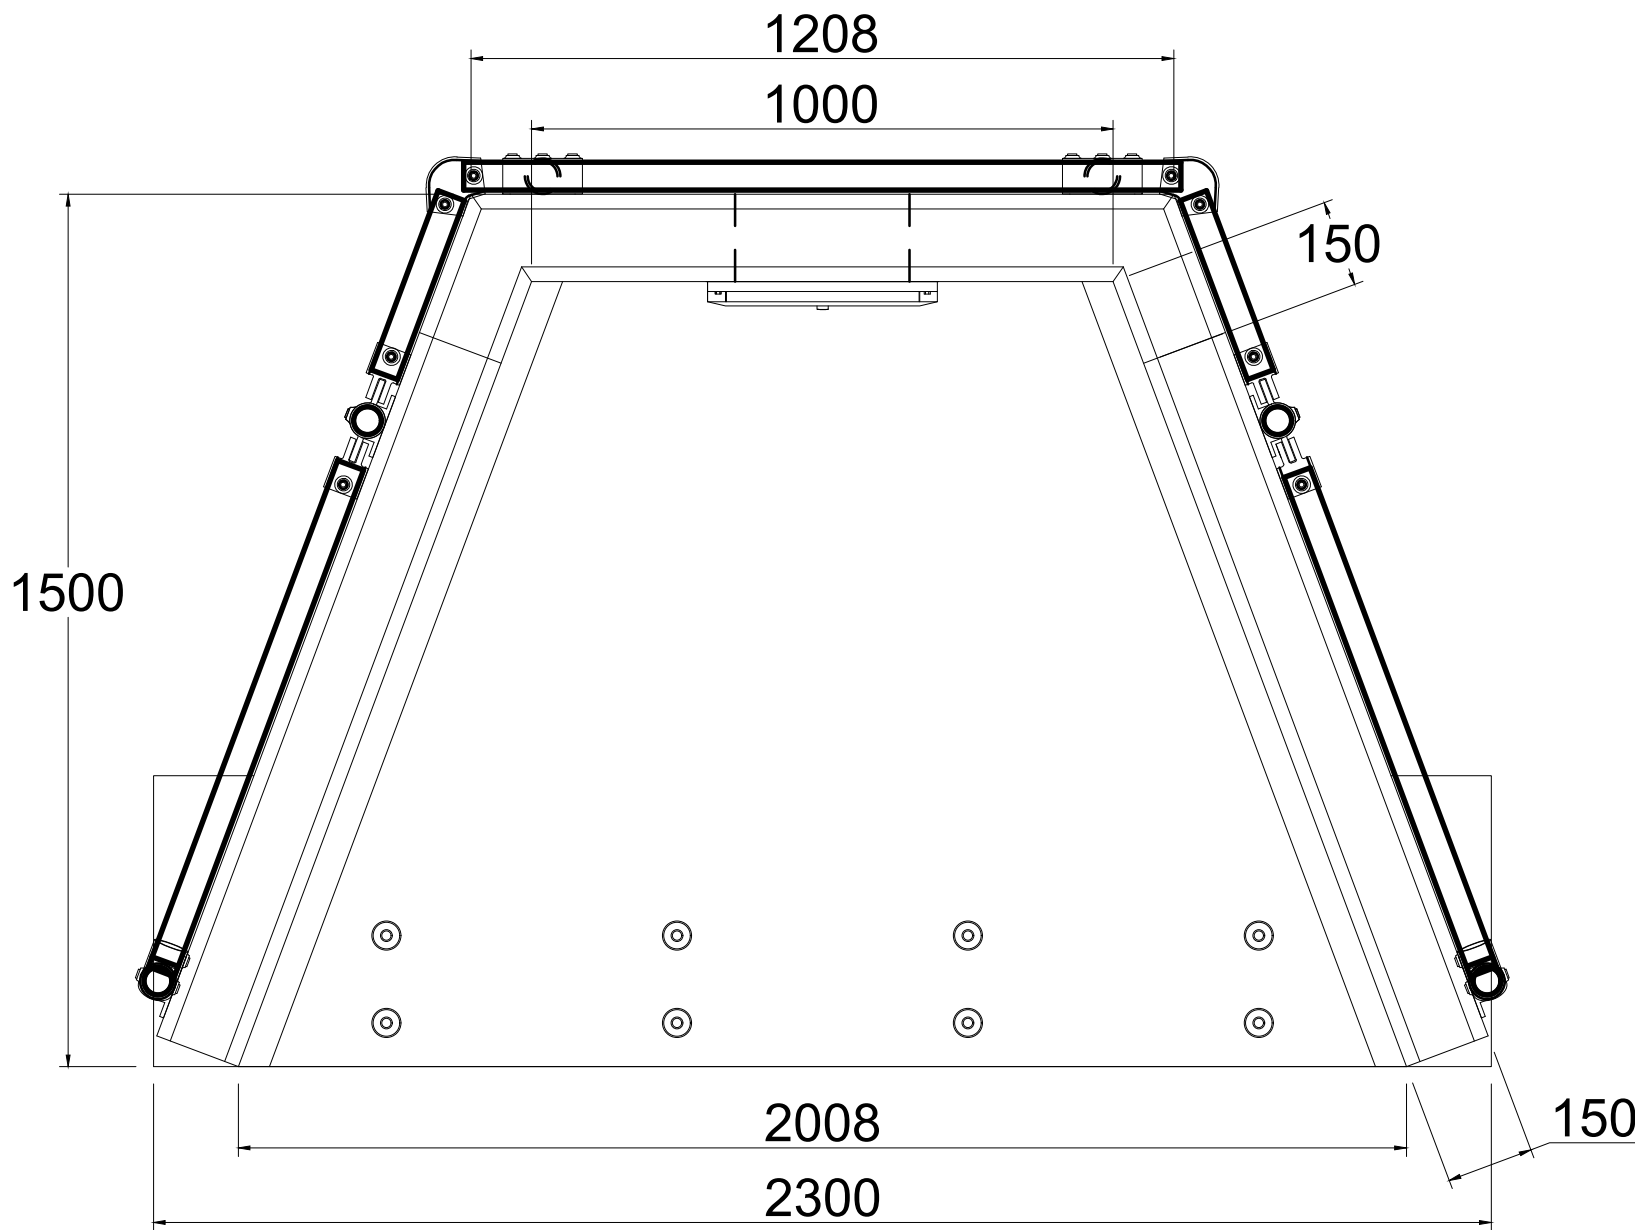


SFA10D Specification Information




- Opening in back wall cast to suit outside diameter of the pipework
- Invert level of pipe can be set to your specification
- There is a 50mm fall from the back wall of the headwall to the front of the spillway
- SFA10D suitable for pipework up to 450mm ID Plastic or C'ware and 450mm ID PCC
 - with Sewers for Adoption compliant grating, or up to 600mm ID Plastic or C'ware and 600mm ID PCC without Sewers for Adoption compliant grating

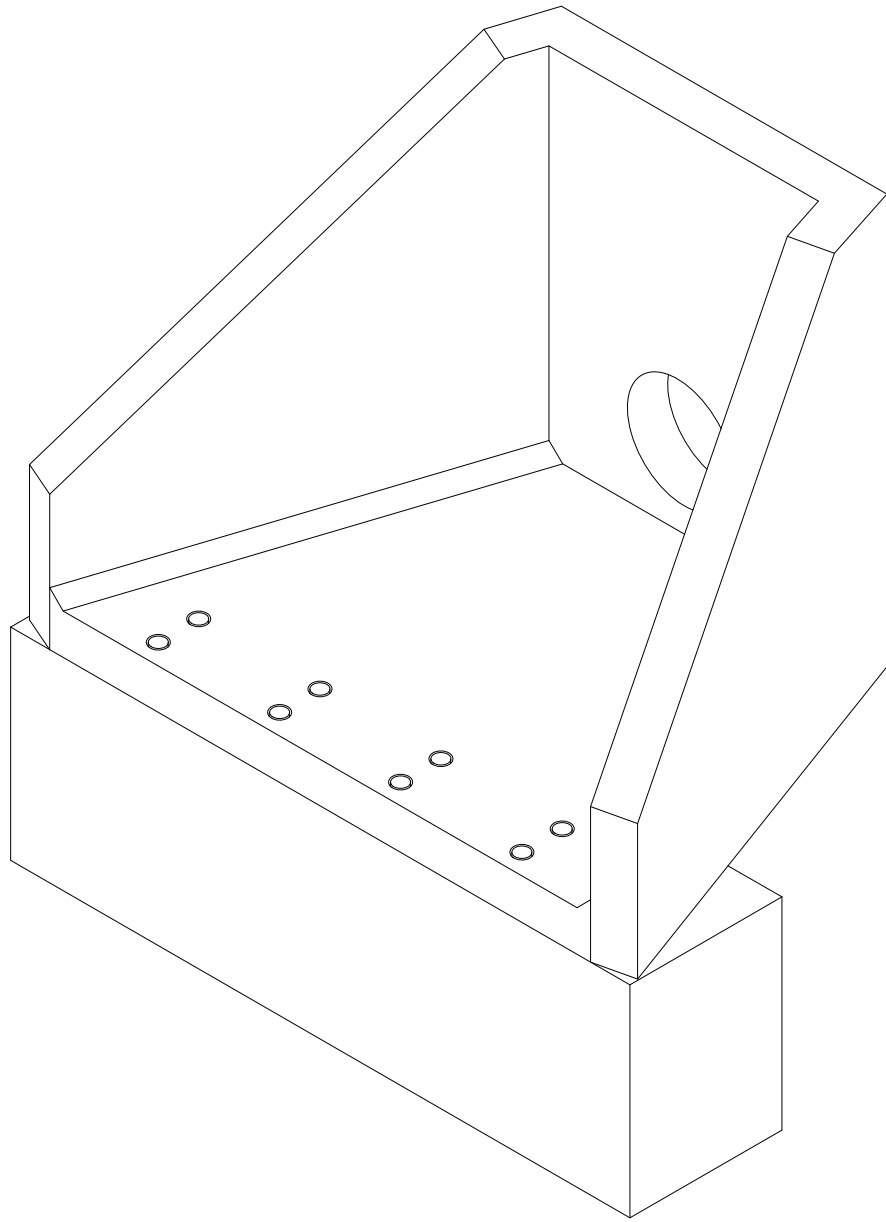


Althon 300 HDPE/SS Flap Valve Specification Information

- The valve plate and the back plate are produced using HDPE/SS
- The hinge pin and ballast weight are produced in SS316 as standard
- The ballast weight can be easily adjusted if required
- The sealing arrangement consists of an EPDM lips seal in the back plate
- The valve plate is also installed on an angle in relation to the back plate to ensure a good seal

Material: HDPE, SS316, EPDM
Opening: $\varnothing 315\text{mm}$
Working Pressure: Maxium 5 MwC
All dimensions in mm

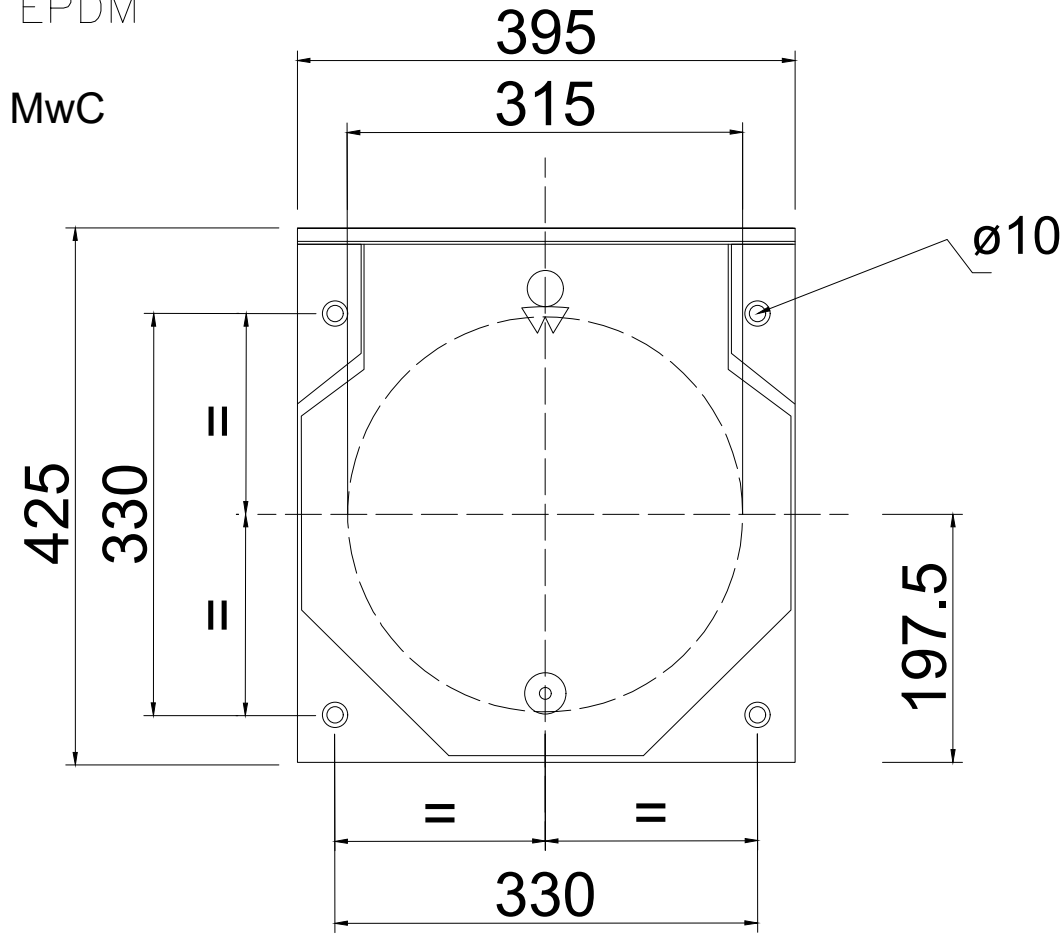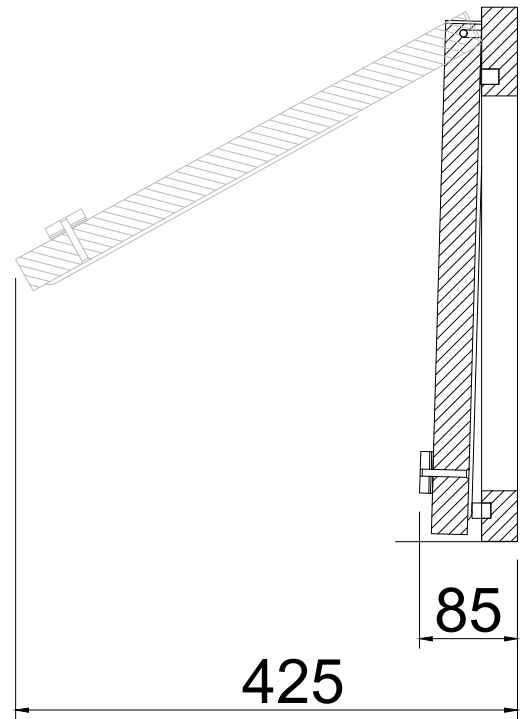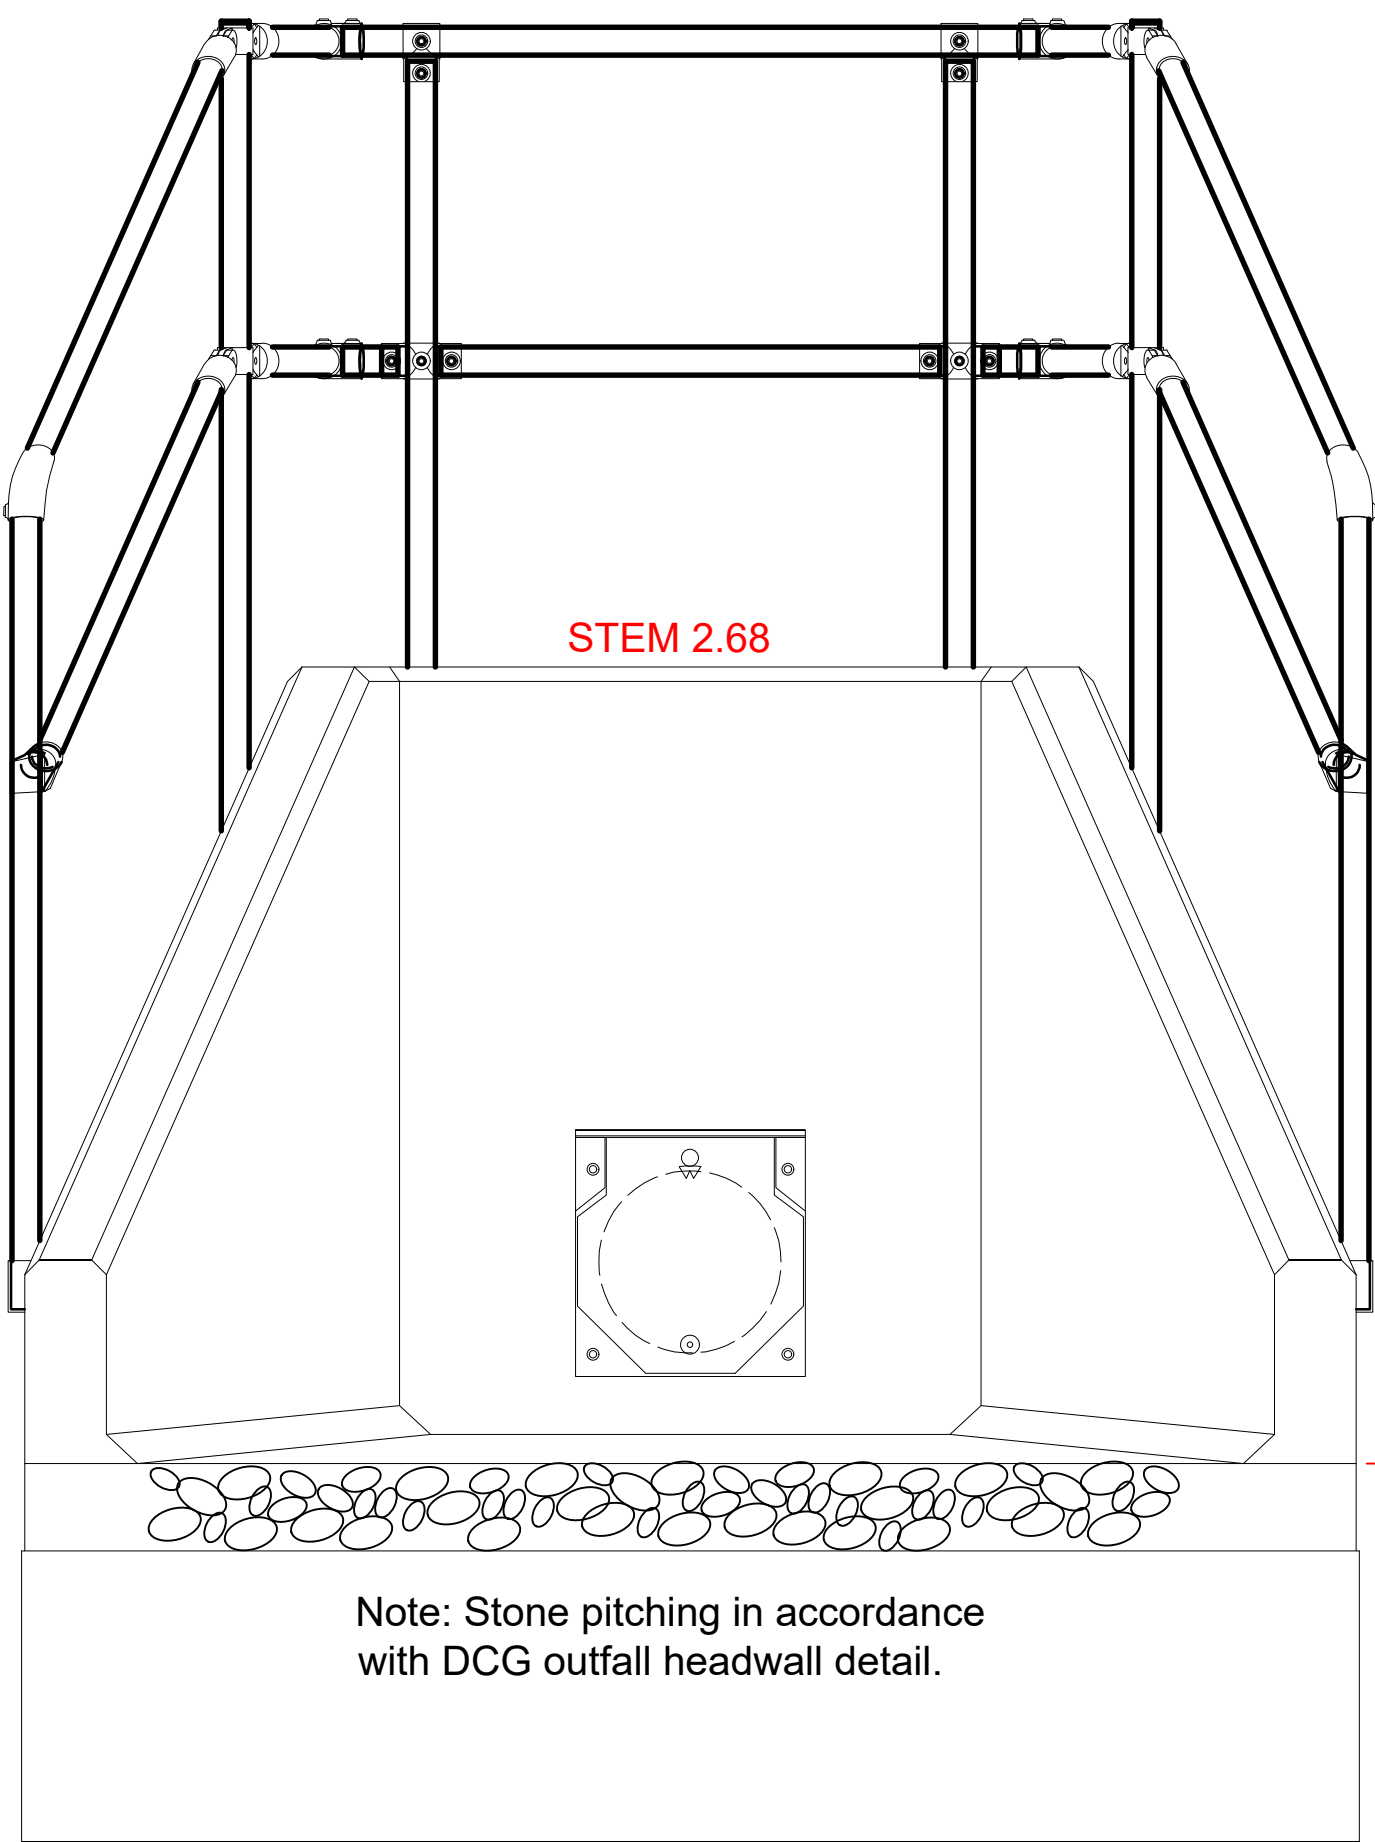

BED LEVEL 1.200
*Site to verify at earliest opportunity

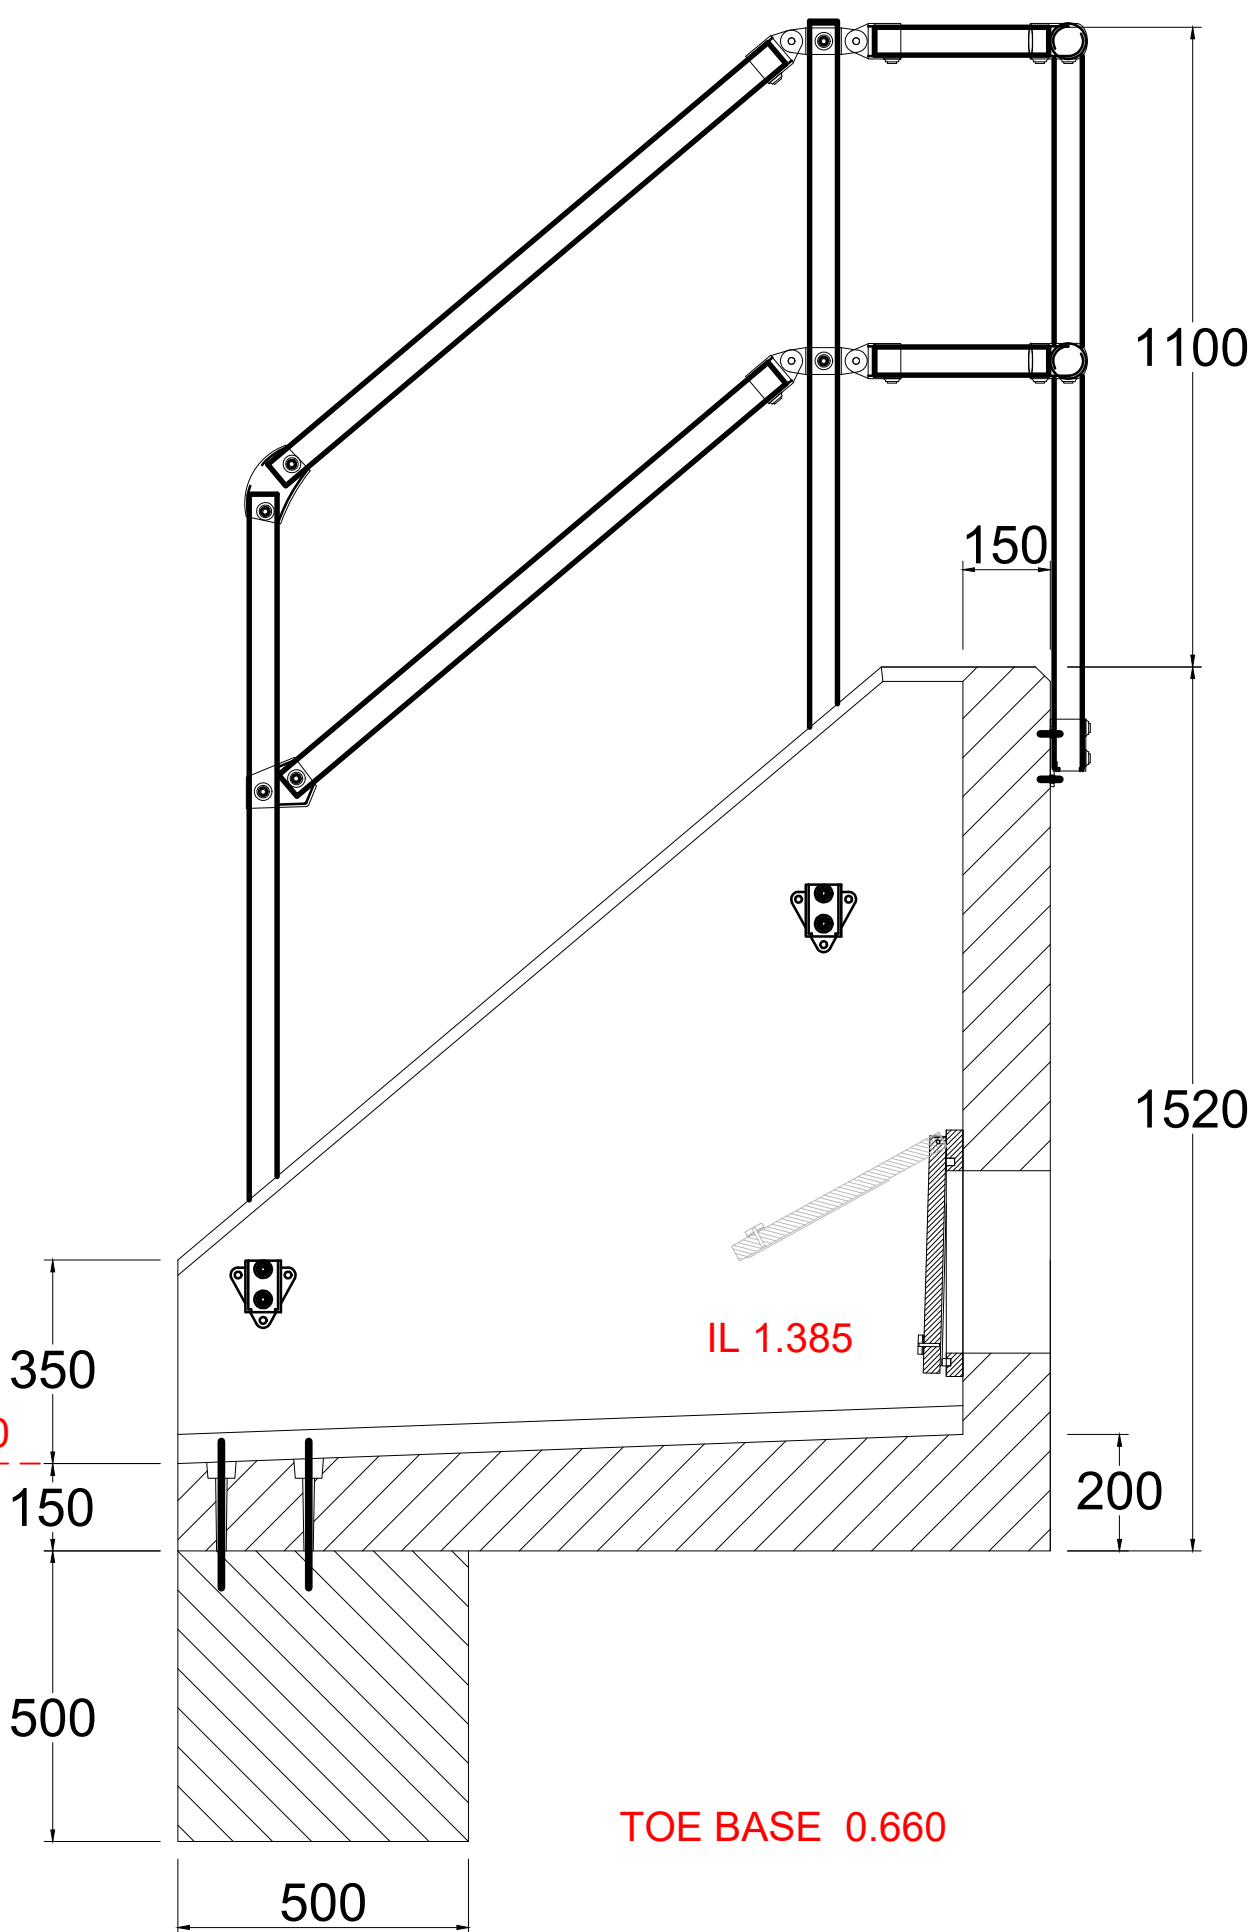

YORK GARDENS
GOSBURTON
WATERCOURSE
OUTFALL HEADWALL
S30

CLIENT: GLEESON

Kee Klamp Specification Information

- Galvanised steel kee klamp handrail
- 1100mm high above back wall
- GRP / FRP hand rails also available

Althon SFA10D Headwall Installation

Units should be bedded on minimum 100mm of semi-dry concrete.
Material: Reinforced concrete
Weight approximately 4010kg
All dimensions in mm

A	Amended in line with client mark-ups (26.08.22)	05.09.22	EN
rev	description	date	initial

ADDRESS: ALTHON LIMITED
VULCAN ROAD SOUTH
NORWICH
NR6 6AF

TEL: 01603 488700
FAX: 01603 488598
EMAIL: sales@althon.co.uk
WEBSITE: www.althon.co.uk

DRAWING TITLE: SDC REF 'S31'			
SFA10D HEADWALL + 500MM TOE + 300MM FLAP VALVE + 3 SIDED KEE KLAMP			
SCALE: NTS	PAPER: A1	DATE: 27 - 05 - 16	REVISION: A
DRAWING No: SDC REF E827-43			

DRAWING FOR ILLUSTRATION PURPOSES ONLY