




Approved

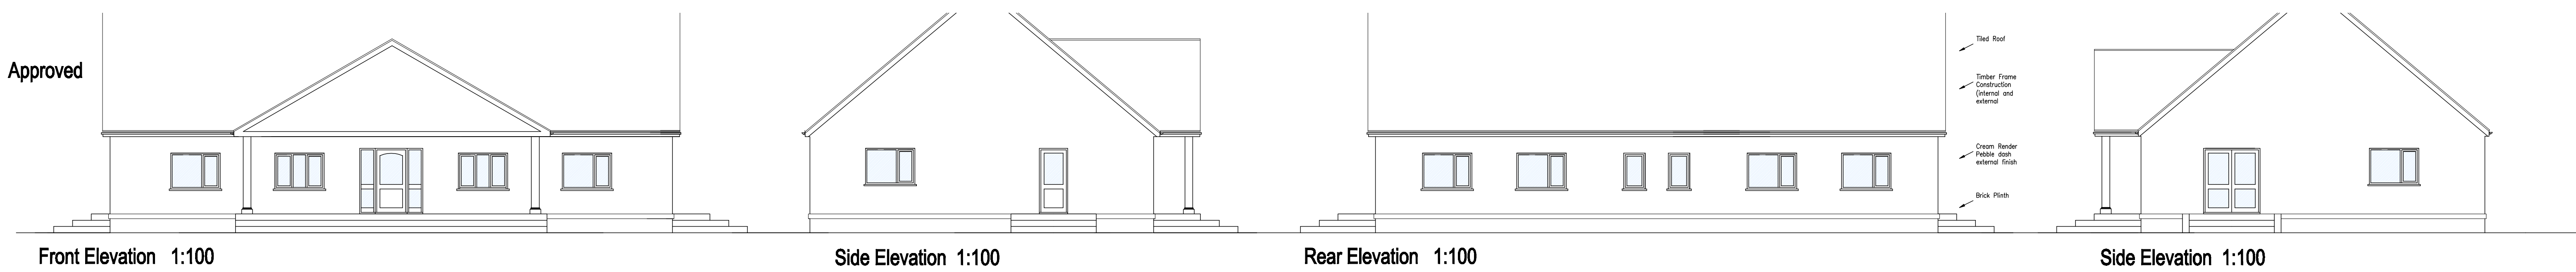

As Built

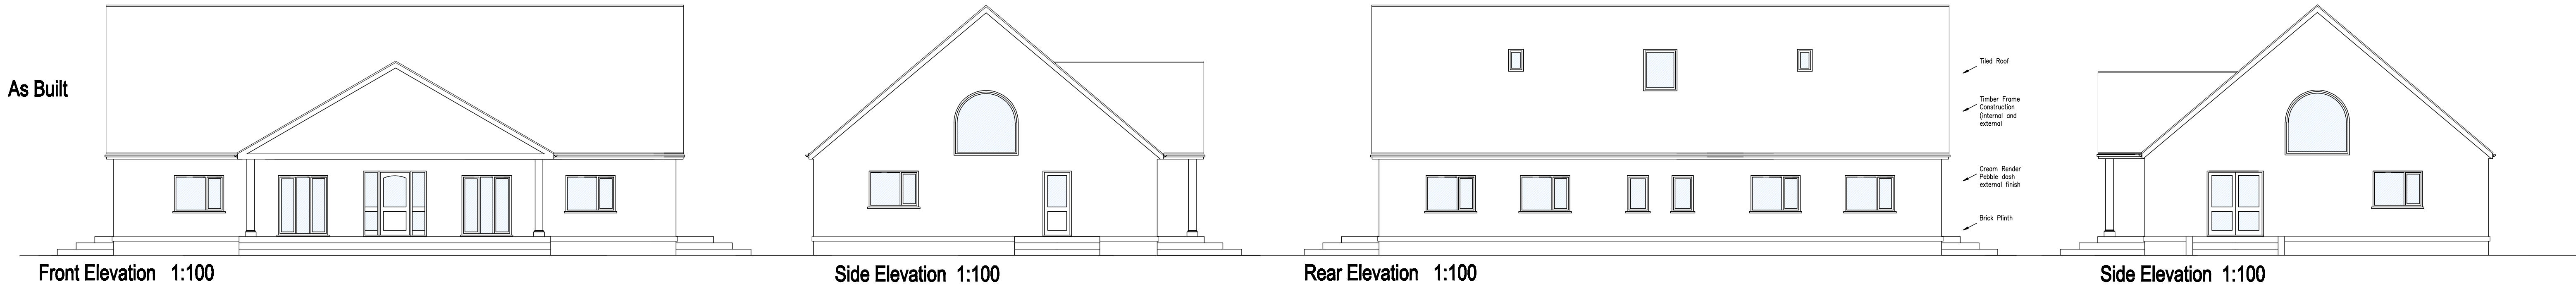



Approved

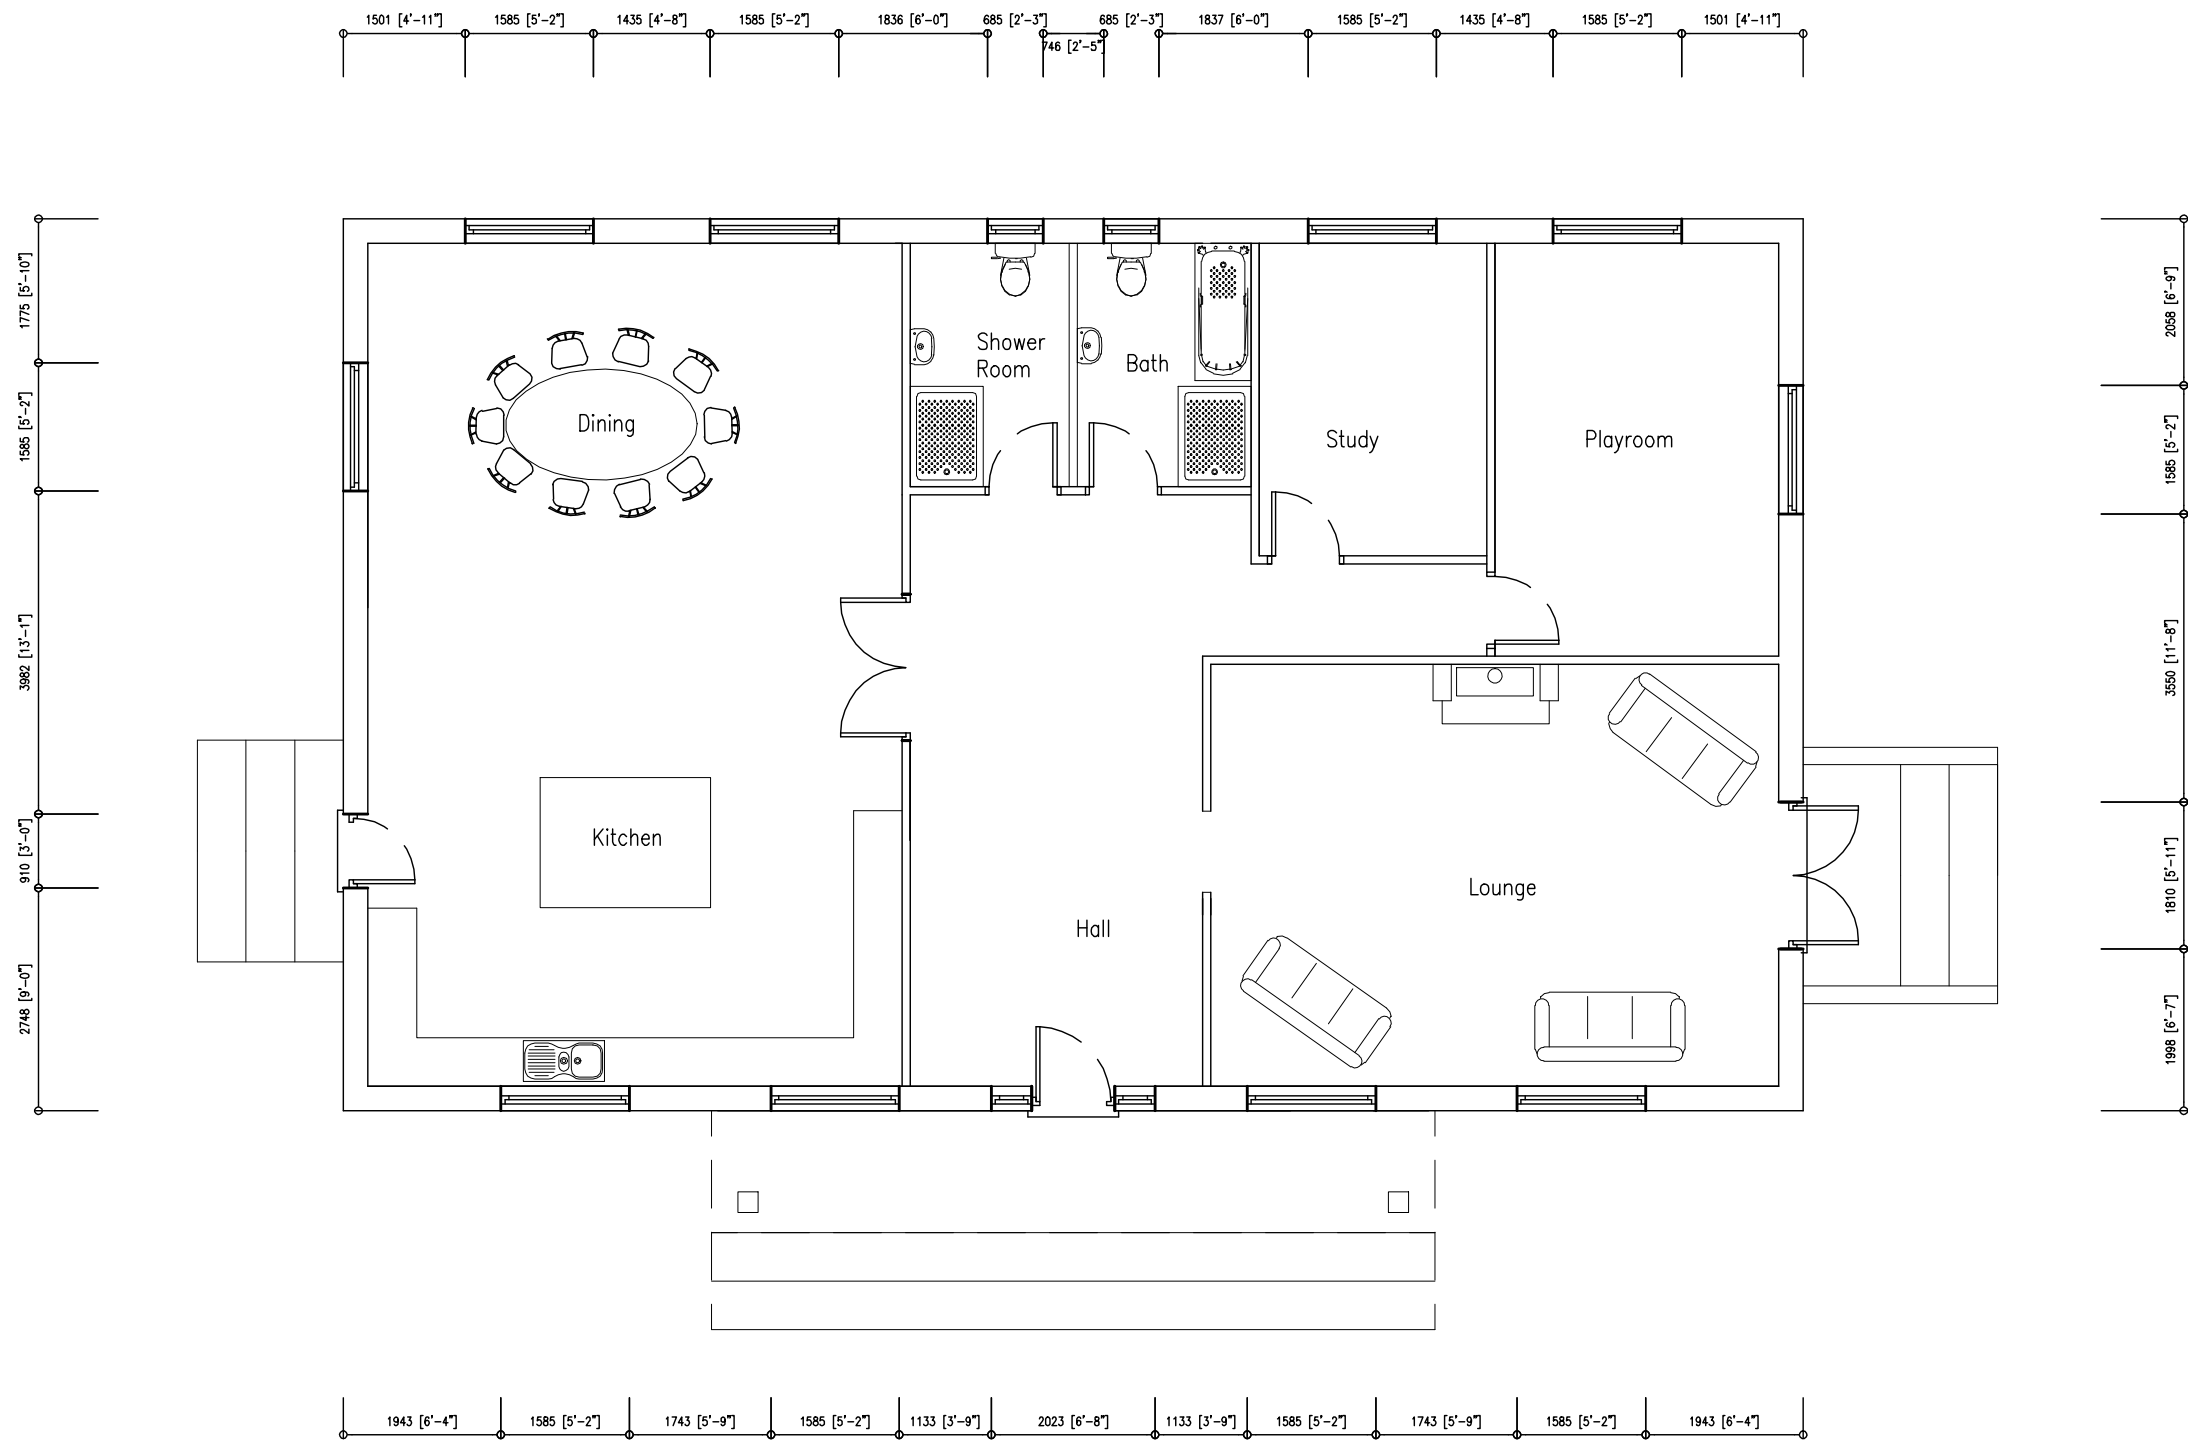

As Built



As Built First Floor Plan 1:50

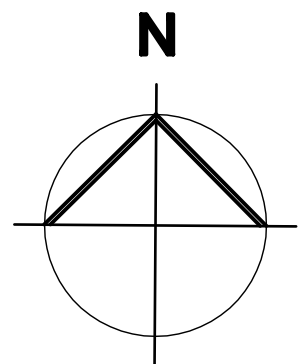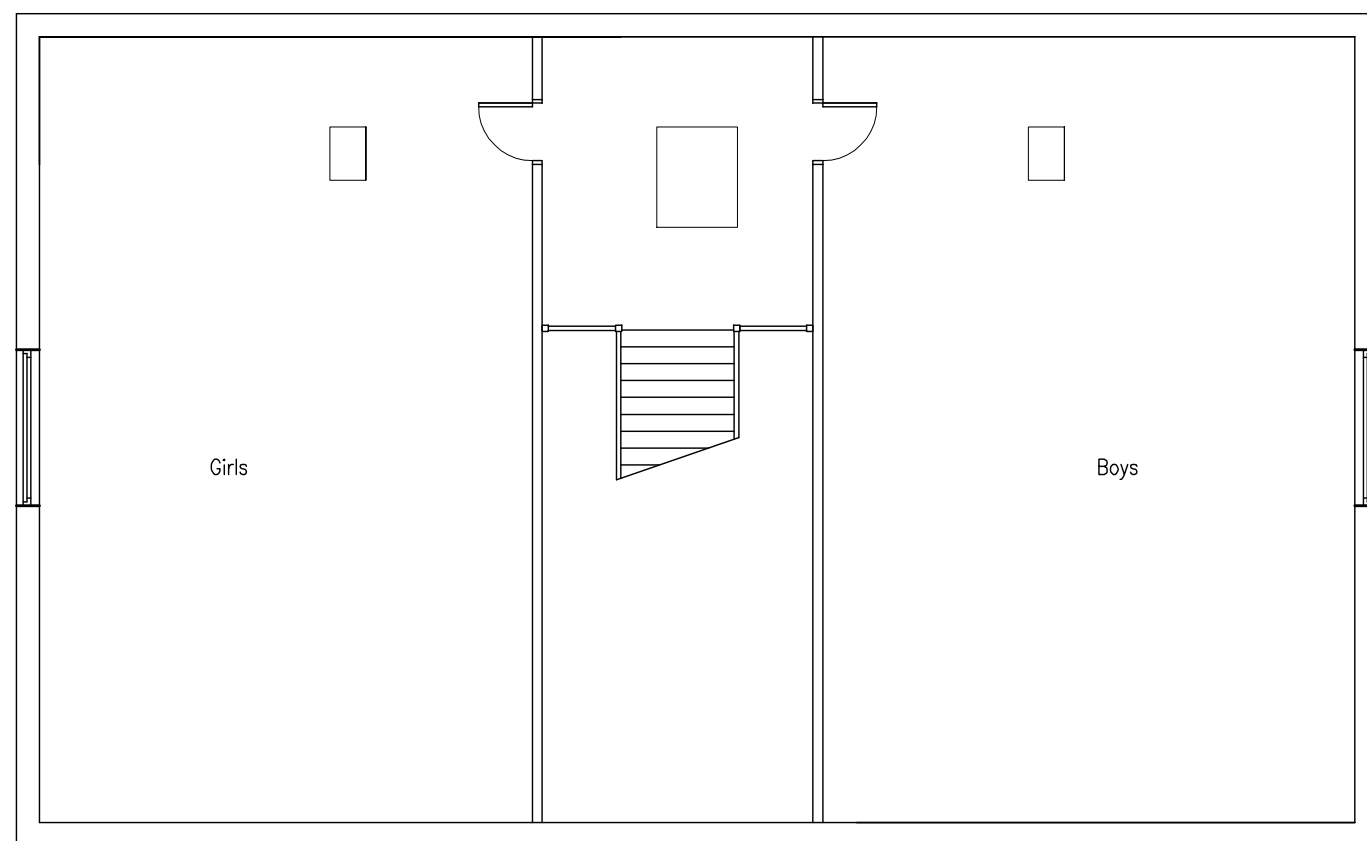

Peter Humphrey Associates Ltd.
ARCHITECTURAL DESIGN AND BUILDING

PROJECT
Proposed Dayroom with existing Caravan
for sleeping purposes only

SITE
5 Rose View Drive
A151
Holbeach
PE12 7LD

DRAWING
As Built Plan

CLIENT
Mr William Gaskin

DATE July 2016 **SCALE** As Shown **JOB No.** 5282

DO NOT SCALE FROM THIS DRAWING
COPYRIGHT: THIS DRAWING MUST NOT BE ISSUED, LOANED OR COPIED
WITHOUT THE CONSENT OF PETER HUMPHREY ASSOCIATES

Peter Humphrey Associates
ARCHITECTURAL DESIGN AND BUILDING
TELEPHONE: 01945 466 966
E-MAIL: info@peterhumphrey.co.uk

31 OLD MARKET WISBECH CAMBS PE13 1NS
Fenland District Council
Building Design Awards
Building Design Awards
Category Winner 08.09.10
Overall Winner 2010