




DR/02 Elevation of PV Array

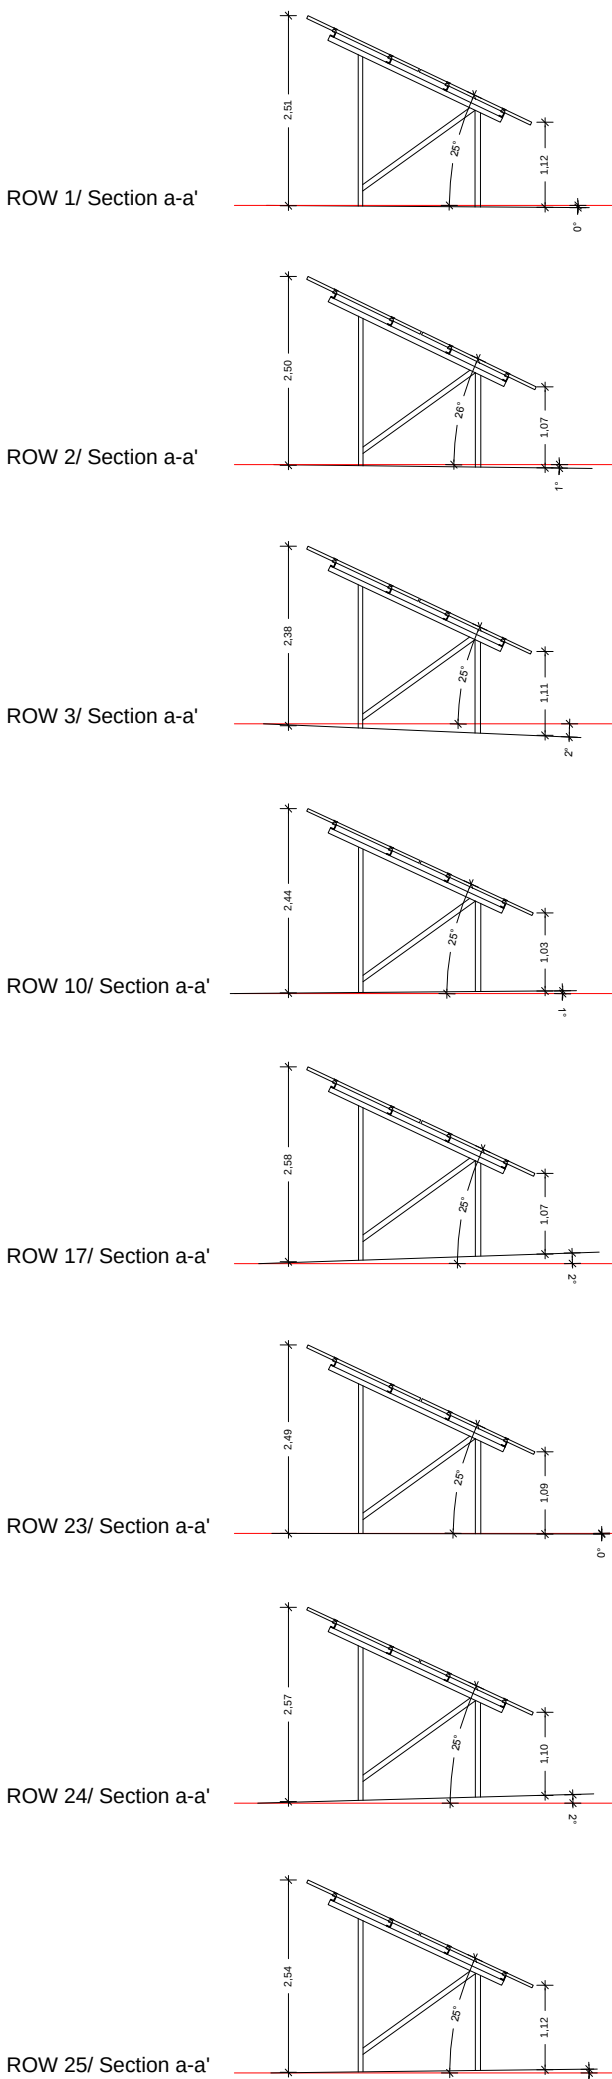


DR/03 Sections of PV Arrays

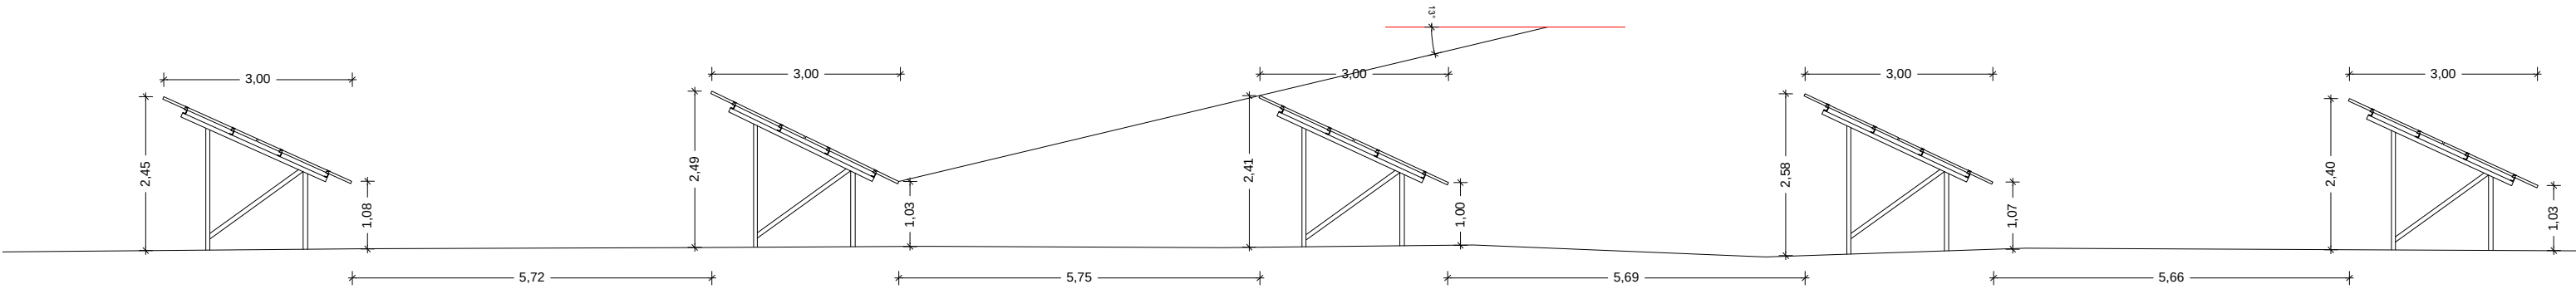


DR/04 Section of Detail 1

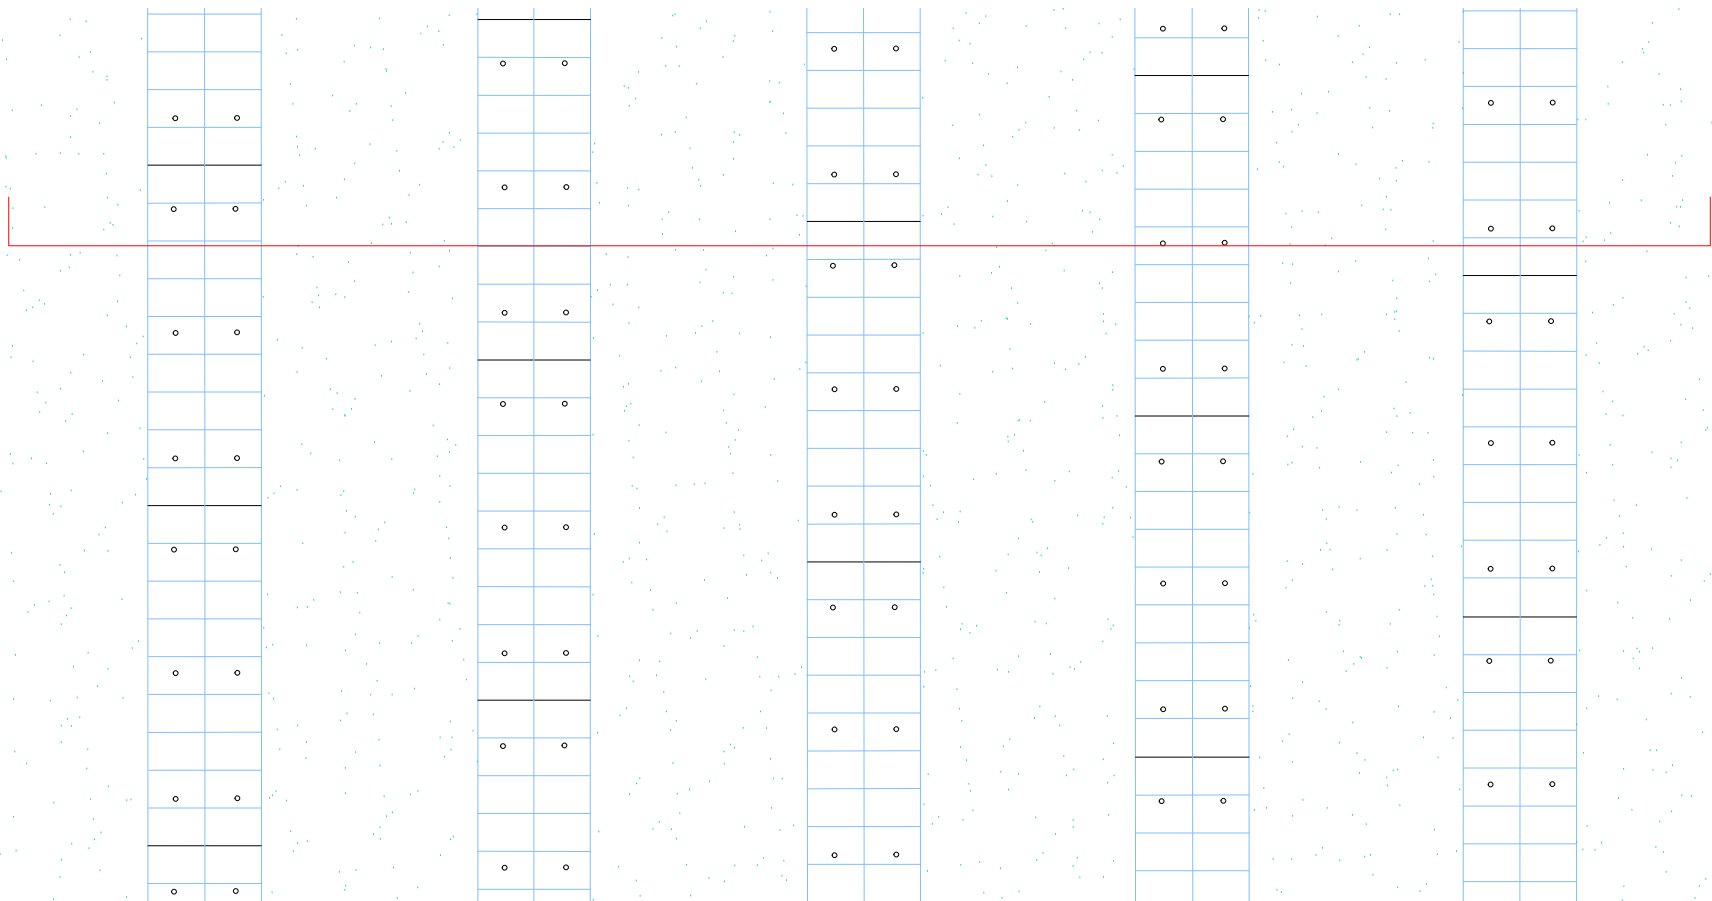

DR/05 Plan of Detail 1

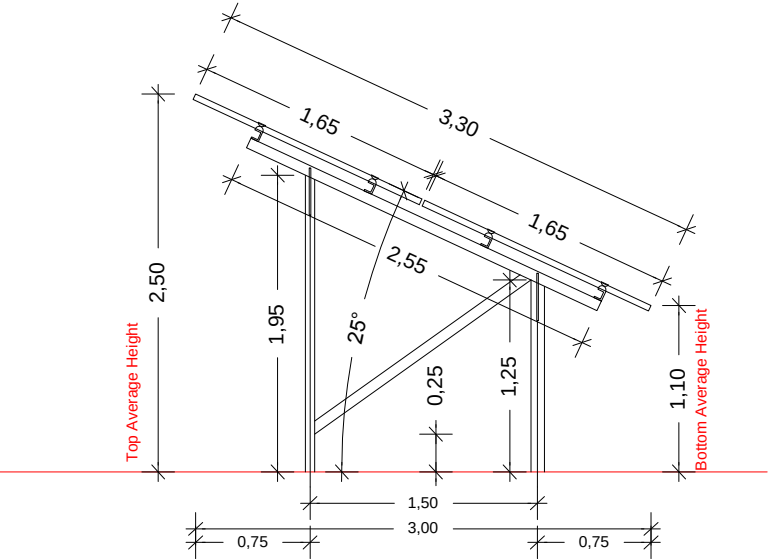

DR/06 PV Structure Detail

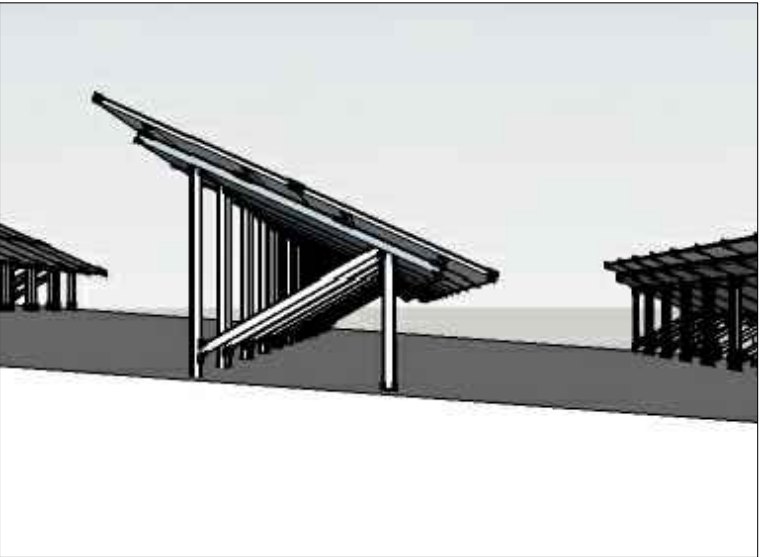

3D Stimulation

CONTRACTOR NAME	Lightsource Renewable Energy Limited Level 5, 20 Old Bailey / London / EC4M 7AN		
PROJECT	MOOR SOLAR 2 As built plans & drawings		
PROJECT SITE	Long Sutton Butterfly & Wildlife Park Long Sutton , Lincolnshire PE12 9LE		
PROJECT PARTS	DR/02 Elevation of PV Array	SCALE	1:100
02	DR/03 Sections of PV Array		1:100
	DR/04 Section of Detail 1		1:100
	DR/05 Plan of Detail 1		1:200
	DR/06 PV Structure Detail		1:50
ISSUE DATE	08/2014		
PROJECT ENGINEER	Vazouras Alexandros Land Surveyor Engineer		
PARTNERS	Gaitanaros Grigoris _ Civil Engineer		
	Gaitanarou Afroditi _ Architect Engineer		

