

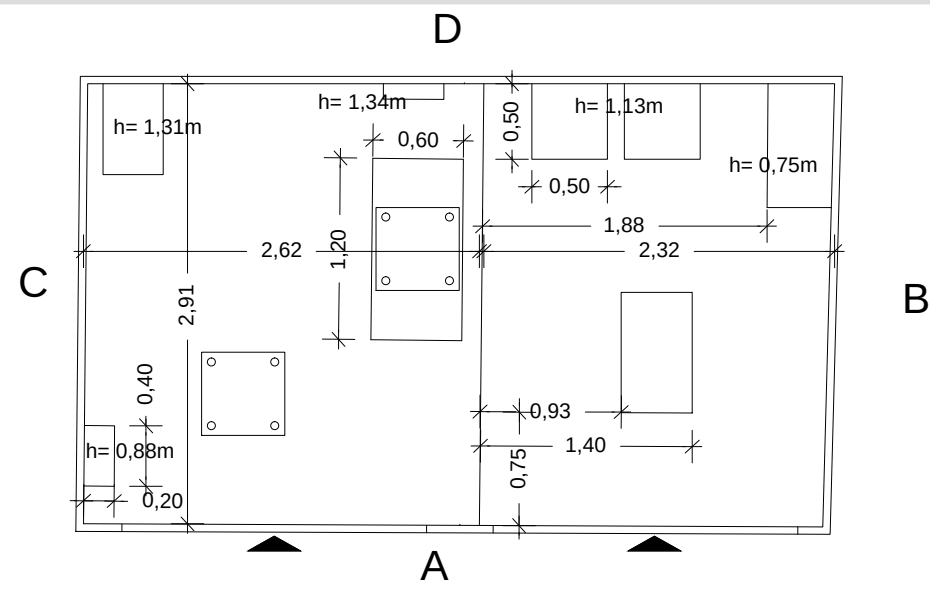
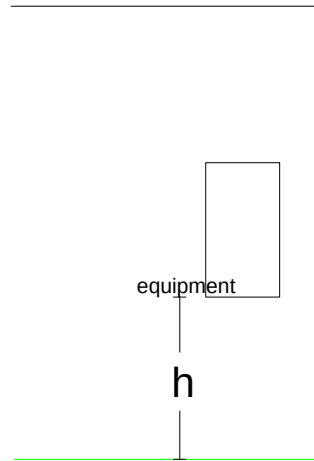
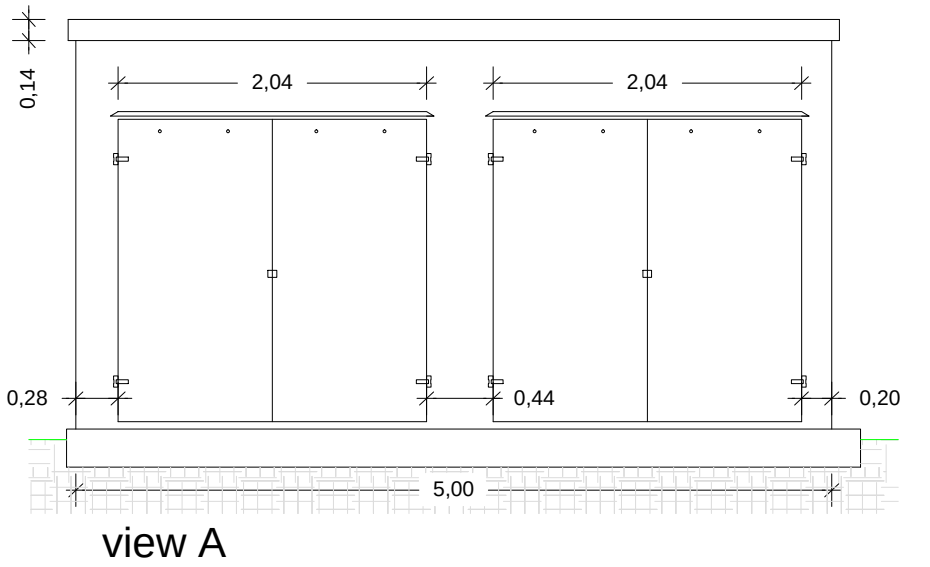
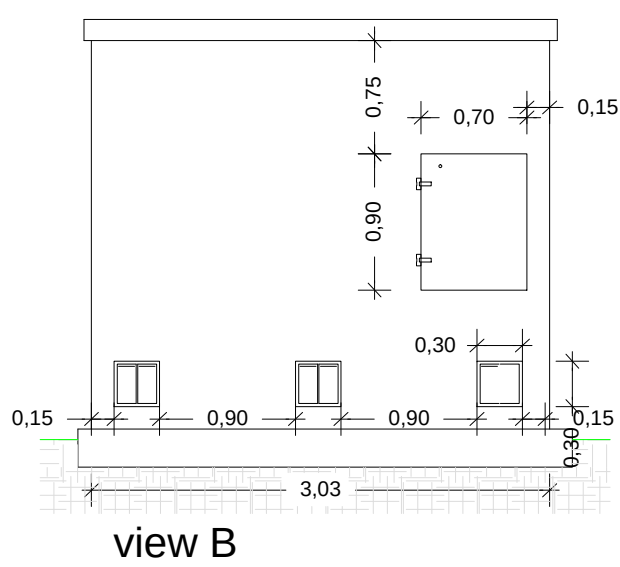
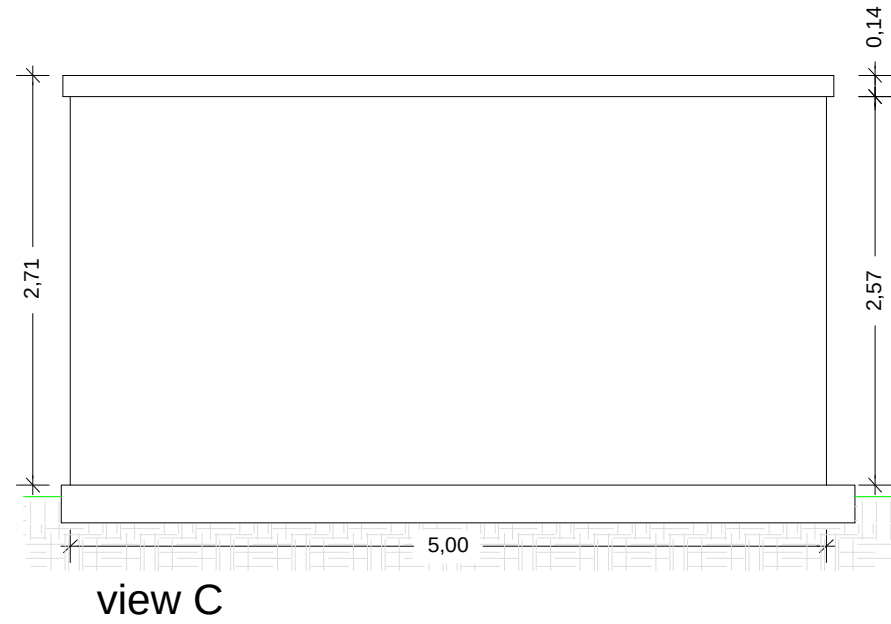
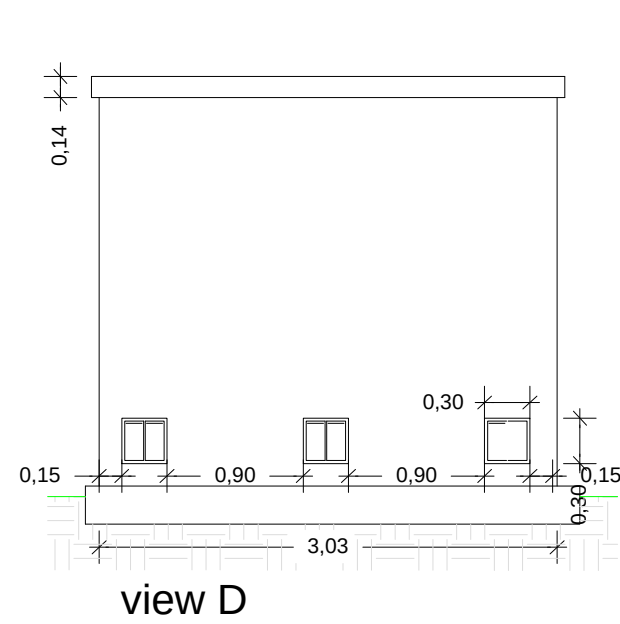
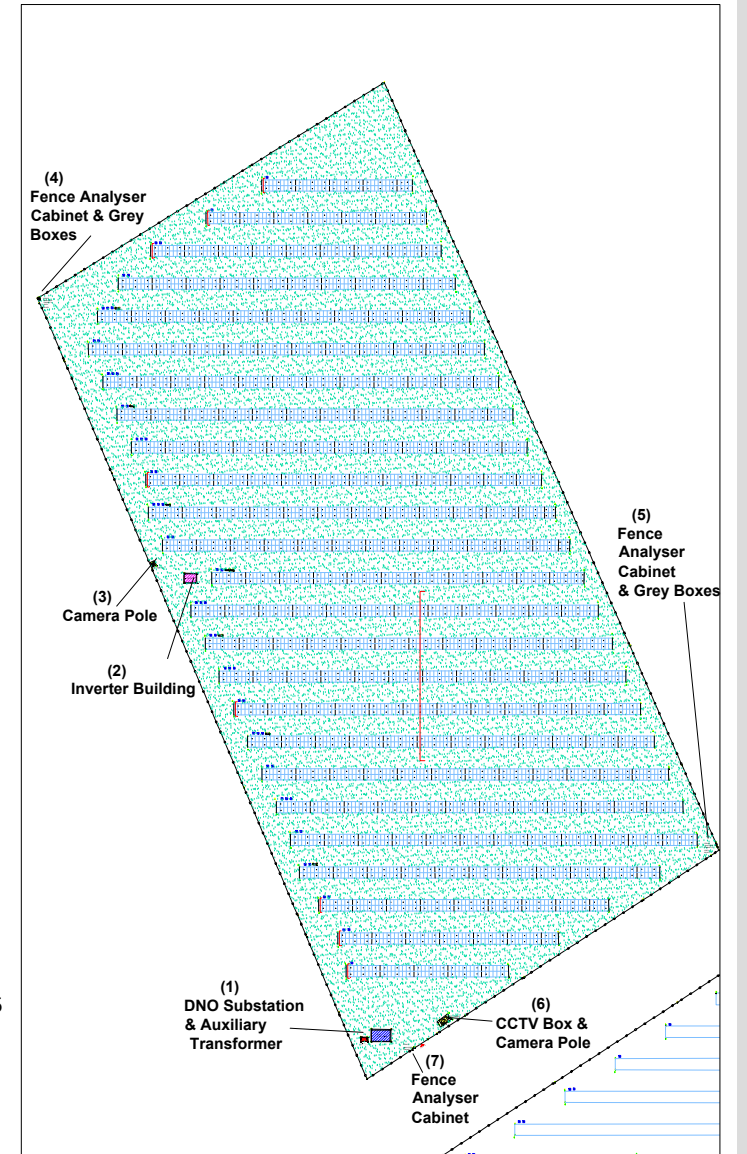
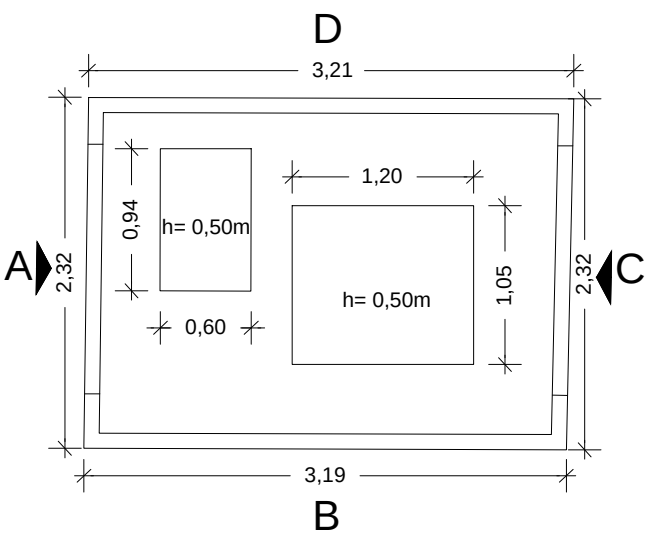
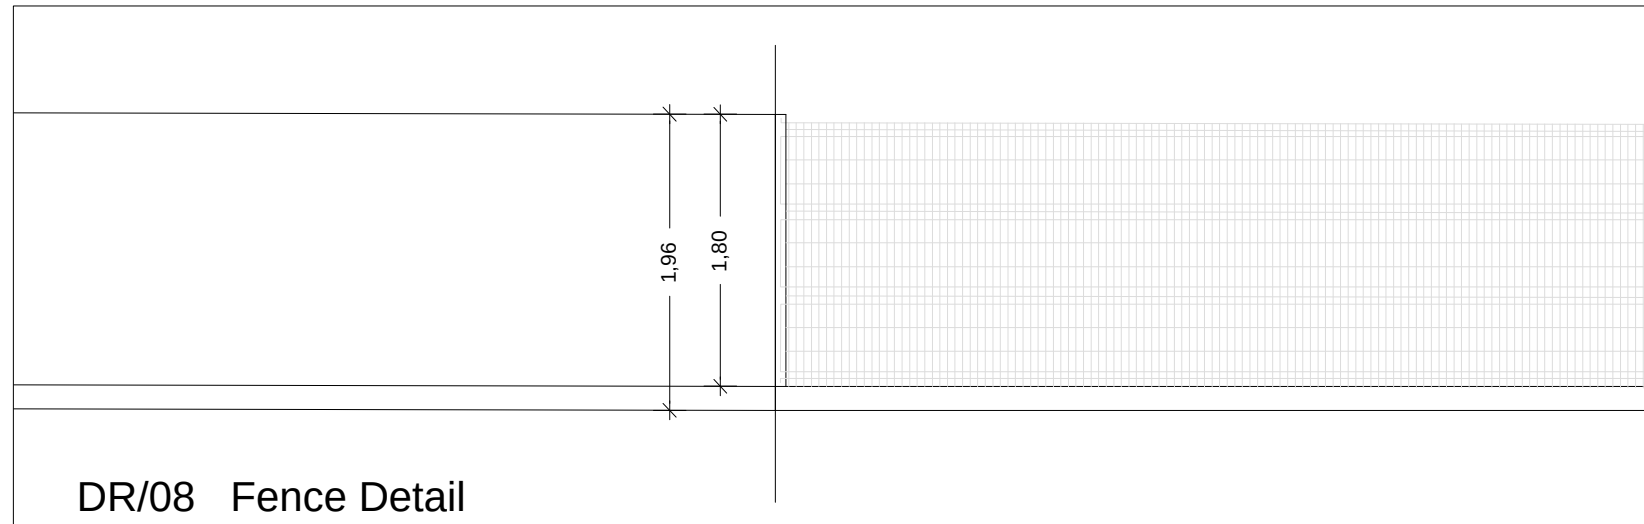
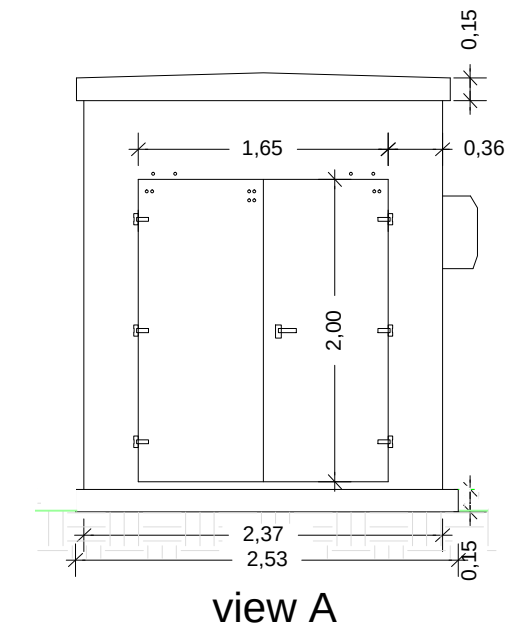
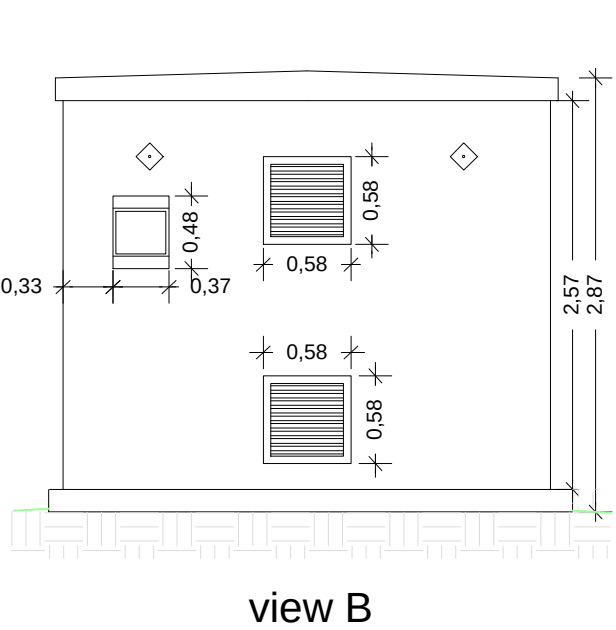


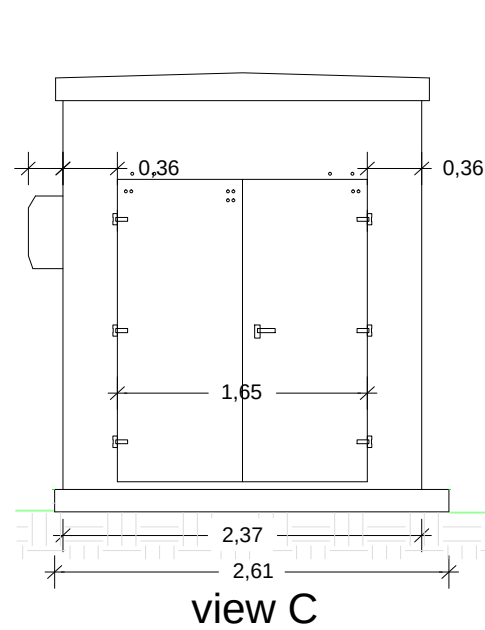

DR/07 DNO Substation Building

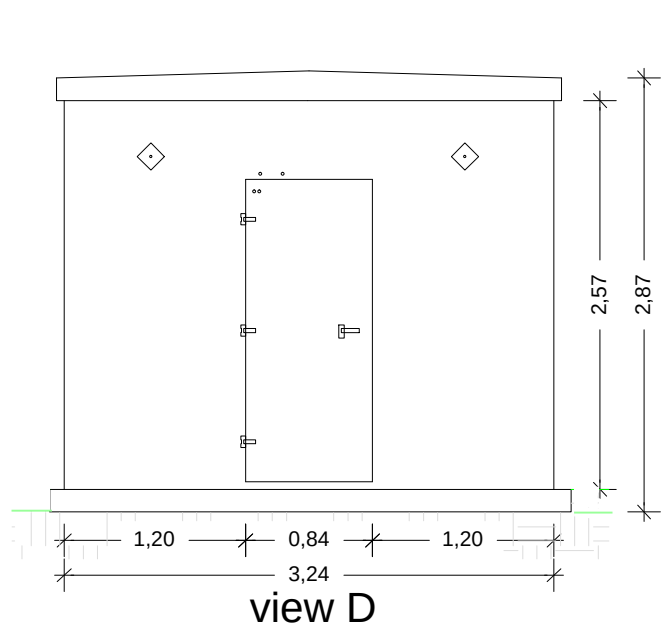

DR/09 Inverter Building

CONTRACTOR NAME		Lightsource Renewable Energy Limited Level 5, 20 Old Bailey / London / EC4M 7AN	
PROJECT		MOOR SOLAR 2 As built plans & drawings	
PROJECT SITE		Long Sutton Butterfly & Wildlife Park Long Sutton , Lincolnshire PE12 9LE	
PROJECT PARTS	DR/07	DNO Substation Building	SCALE 1:50
	DR/08	Fence Detail	1:50
	DR/09	Inverter Building	1:50
ISSUE DATE		08/2014	
PROJECT ENGINEER		Vazouras Alexandros Land Surveyor Engineer	
PARTNERS		Gaitanaros Grigoris _ Civil Engineer Gaitanarou Afroditi _ Architect Engineer	