

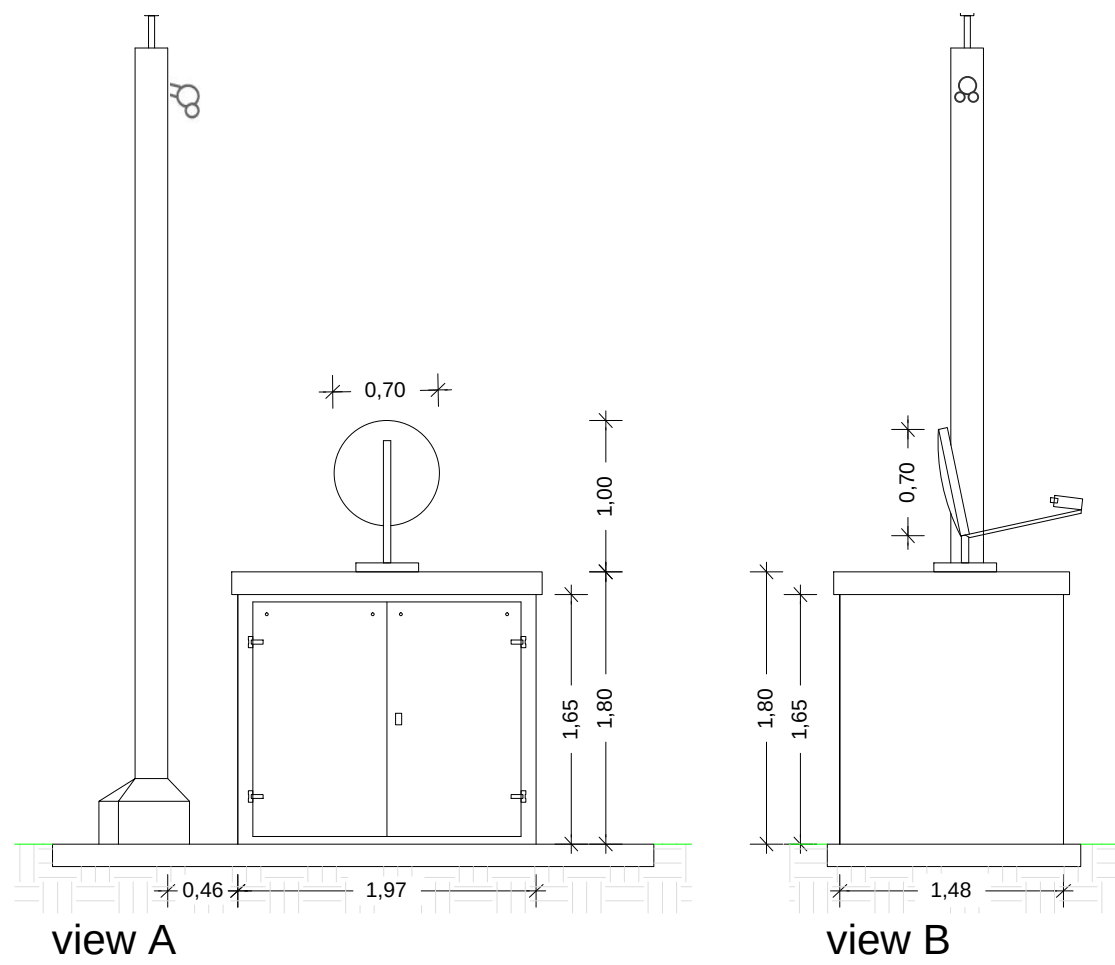
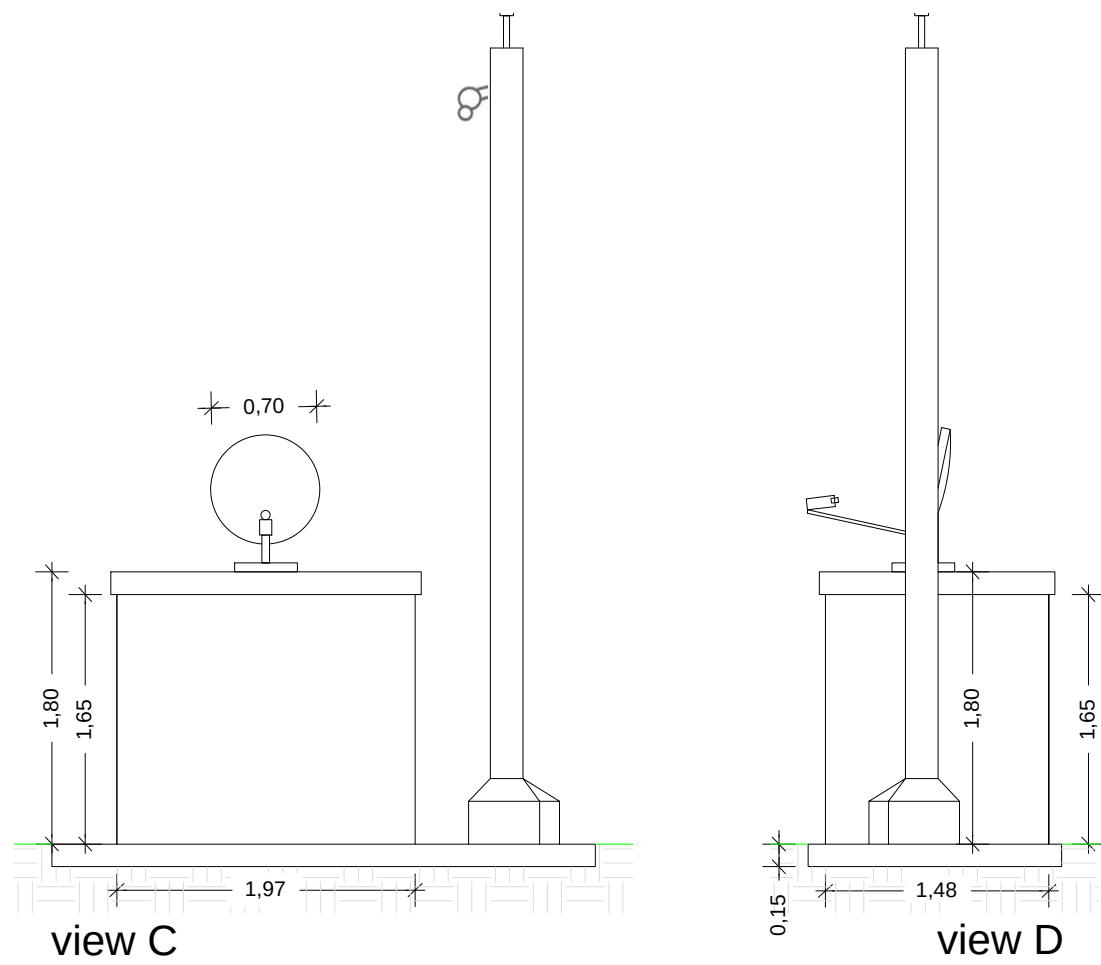
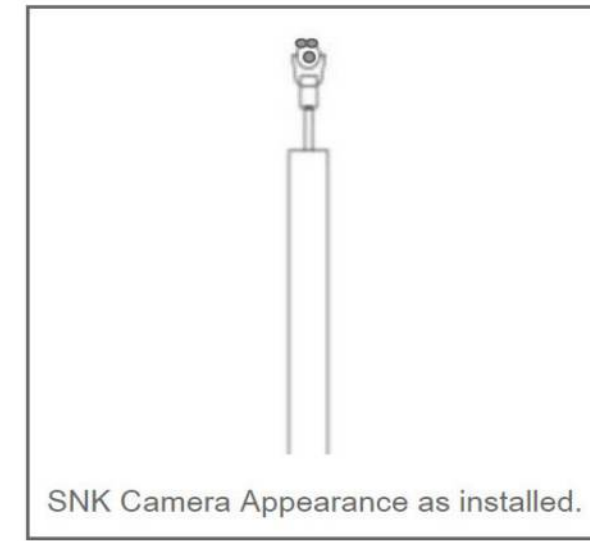
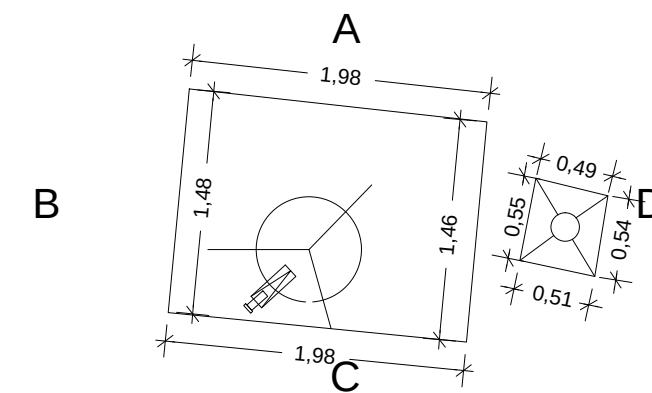
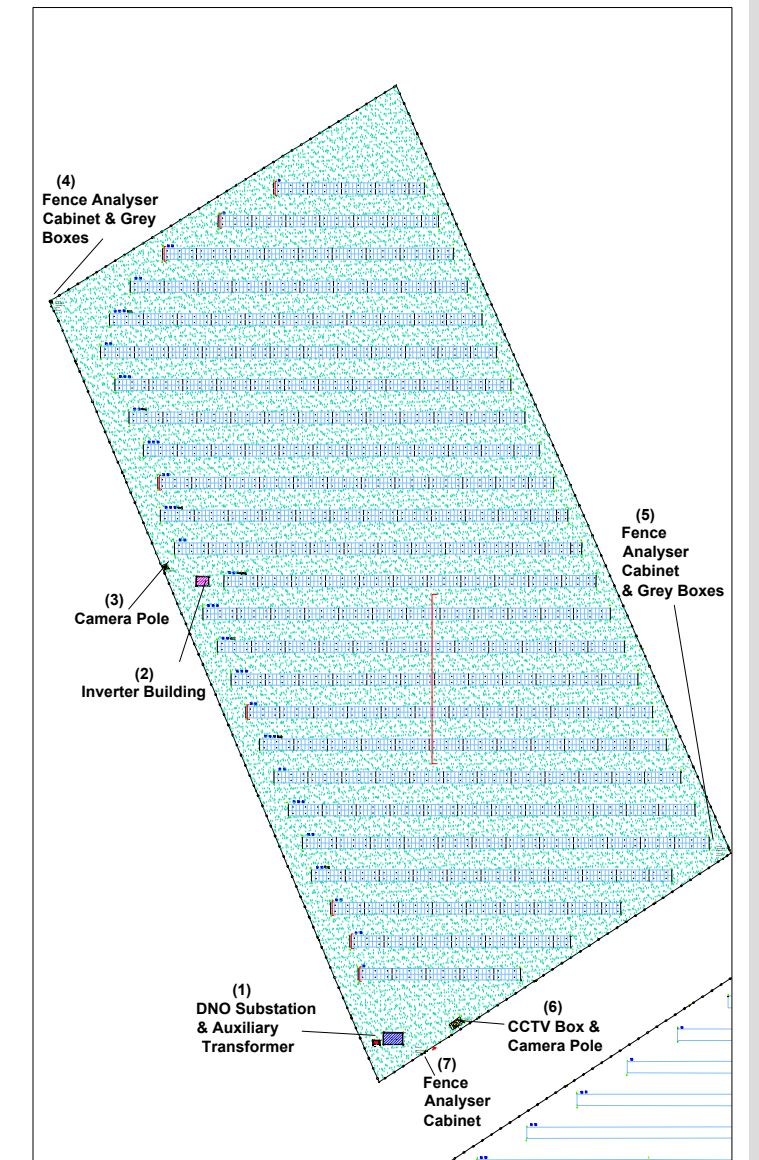



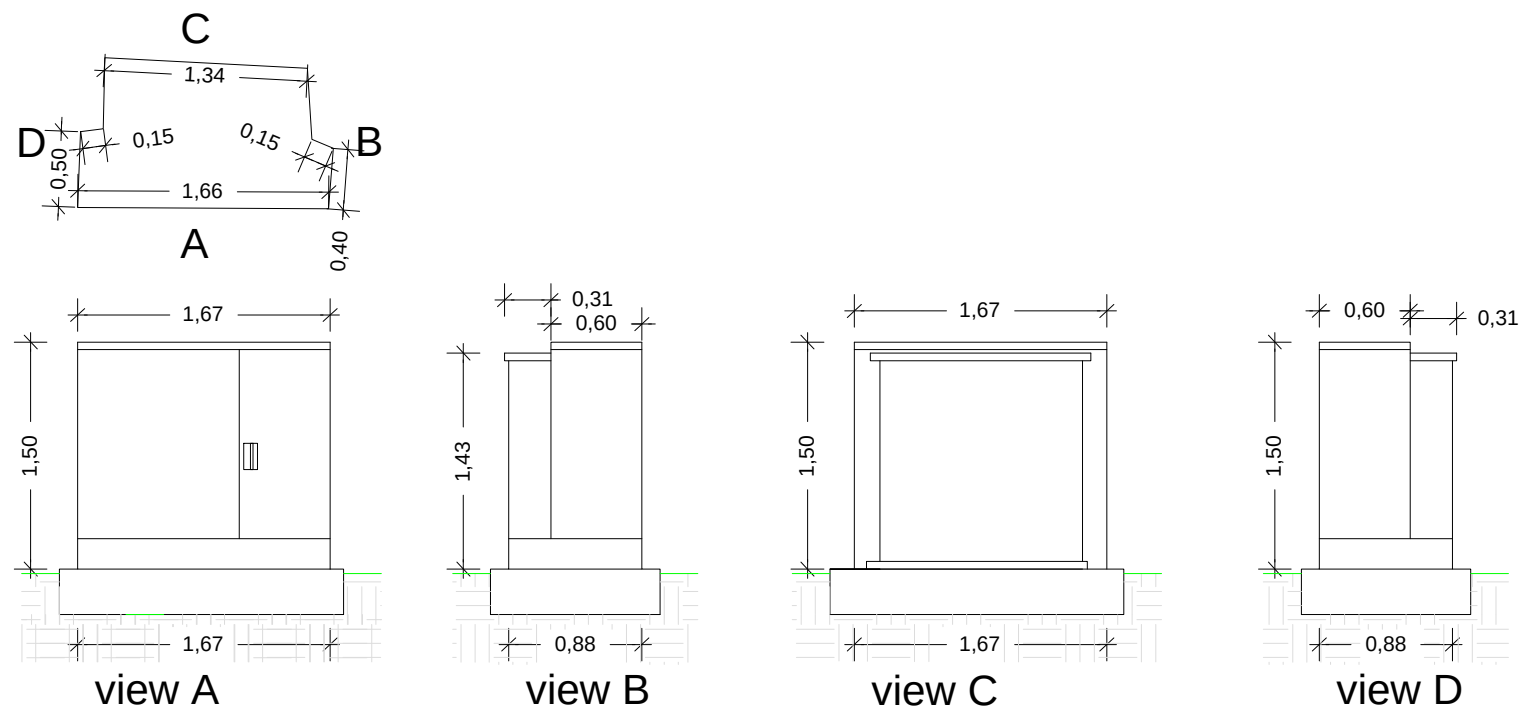


DR/10 CCTV Box / Camera Pole / Satellite Dish

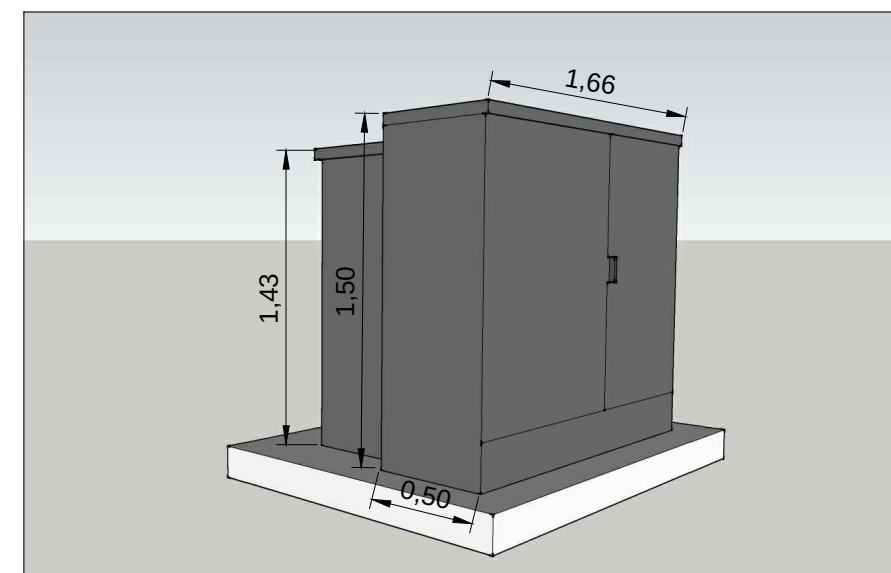


DR/11 Auxiliary Transformer

3D Stimulation of Auxiliary Transformer

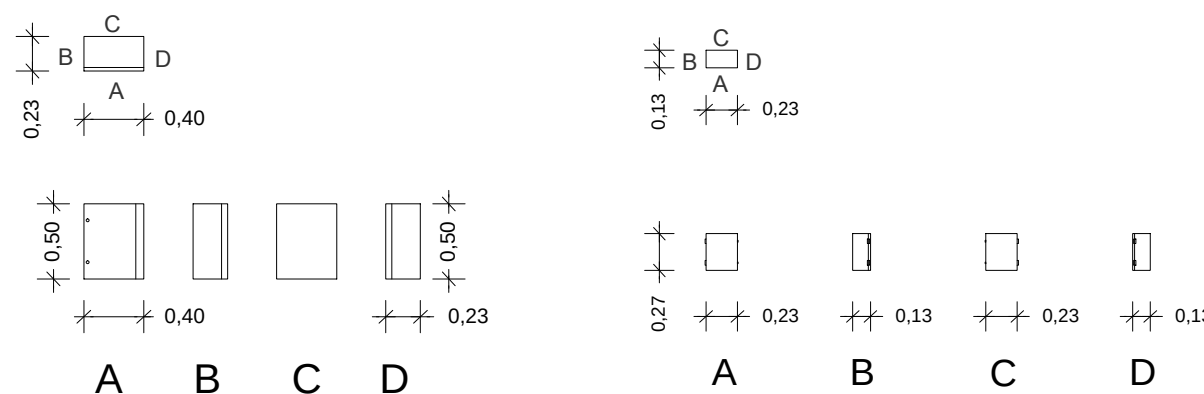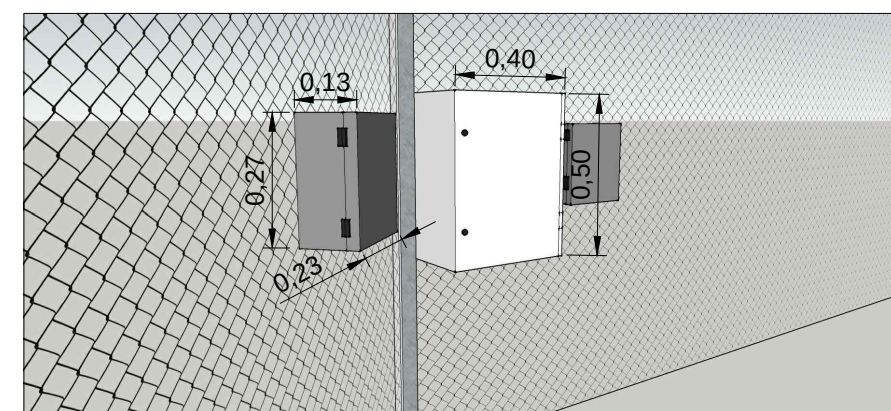

DR/12 Fence Analyser Cabinet & Grey Box

3D Stimulation of Fence Analyser Cabinet & Gray Box

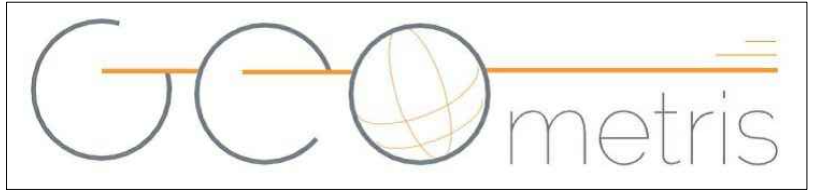CONTRACTOR NAME	Lightsource Renewable Energy Limited Level 5, 20 Old Bailey / London / EC4M 7AN		
PROJECT	MOOR SOLAR 2 As built plans & drawings		
PROJECT SITE	Long Sutton Butterfly & Wildlife Park Long Sutton , Lincolnshire PE12 9LE		
PROJECT PARTS	DR/10 CCTV Box / Camera Pole / Satellite Dish	SCALE	1:50
	DR/11 Auxiliary Transformer		1:50
	DR/12 Fence Analyser Cabinet & Grey Box		1:50
ISSUE DATE	08/2014		
PROJECT ENGINEER	Vazouras Alexandros Land Surveyor Engineer 		
PARTNERS	Gaitanaros Grigoris _ Civil Engineer Gaitanarou Afroditi _ Architect Engineer		