
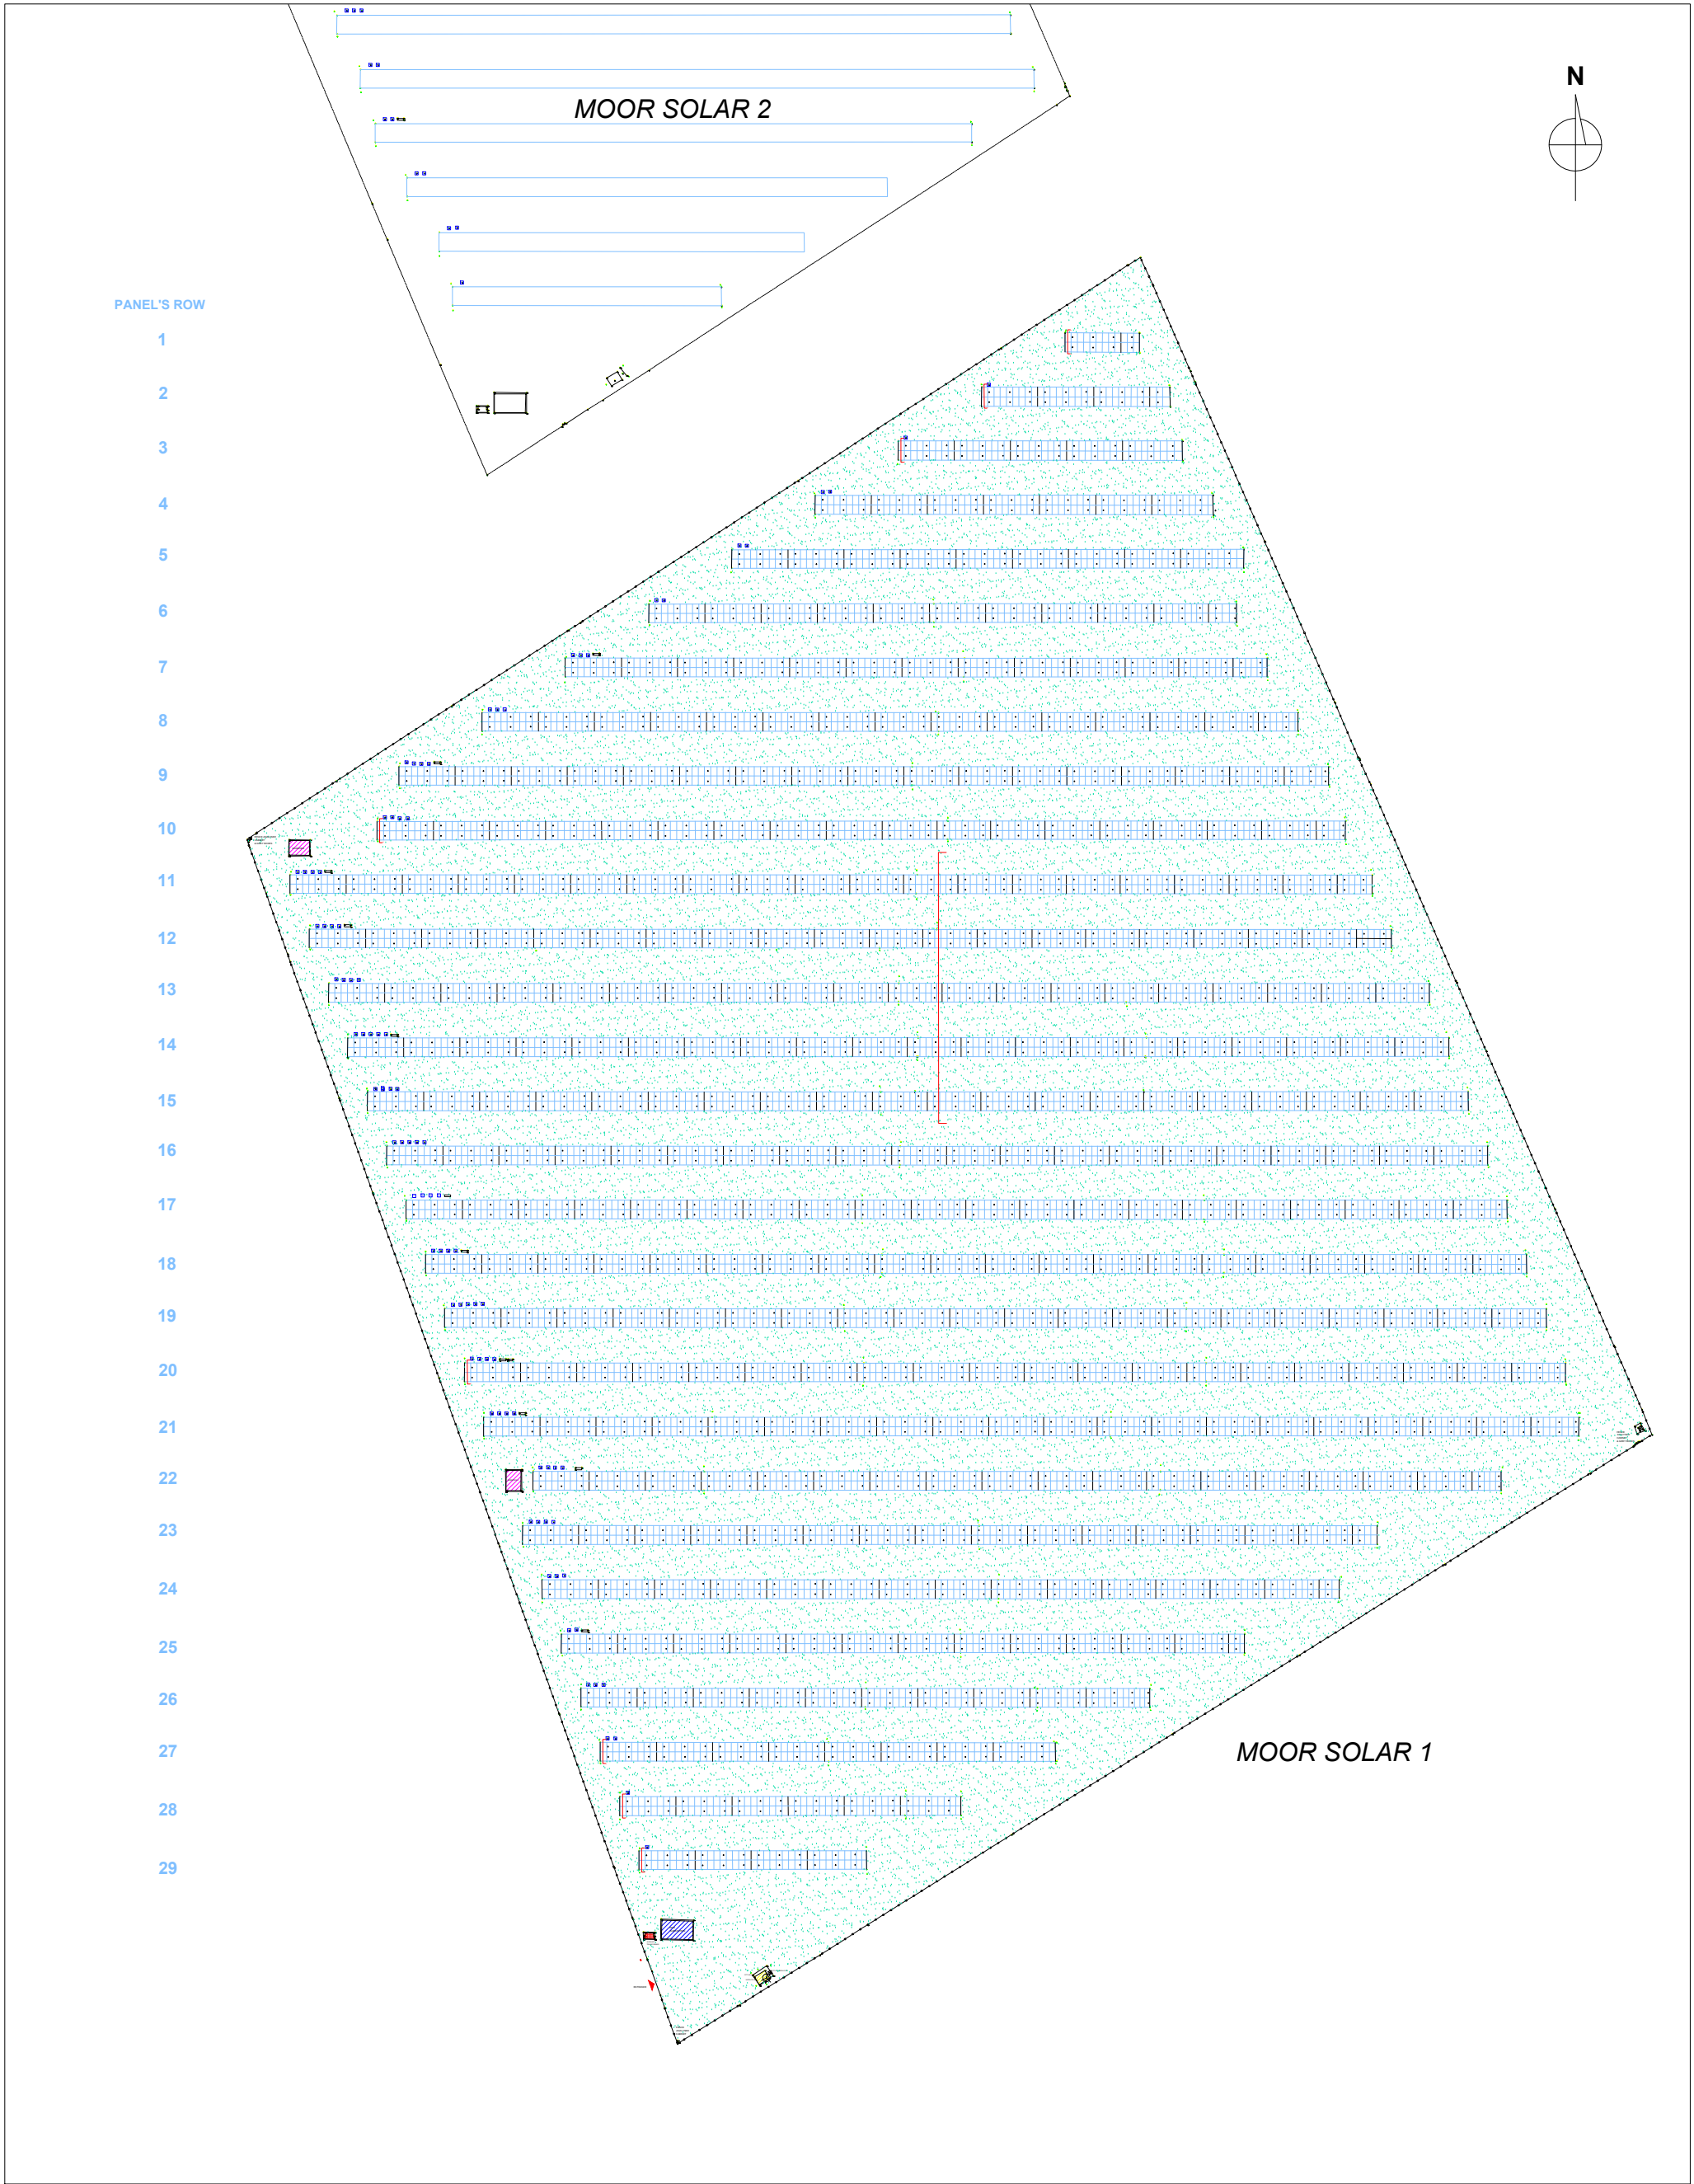


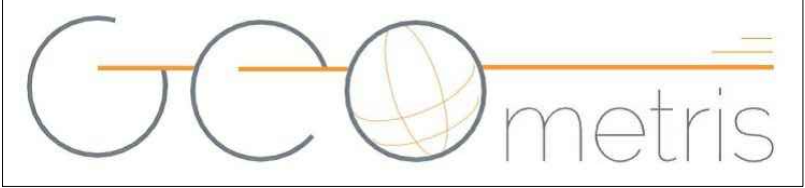

LAYOUT PLAN'S LEGEND			
	PV Panels		White Box
	Fence		Fence Analyser Cabinet
	Grass		SMA Box
	Inverter Building		Entrance
	Substation Building		Pipe
	CCTV Webbox		Concrete Base
	CCTV Camera Pole		Satellite Dish
	Auxiliary Transformer		

CONTRACTOR NAME	Lightsource Renewable Energy Limited Level 5, 20 Old Bailey / London / EC4M 7AN		
PROJECT	MOOR SOLAR 1 As built plans & drawings		
PROJECT SITE	Long Sutton Butterfly & Wildlife Park Long Sutton , Lincolnshire PE12 9LE		
PROJECT PARTS	01	DR/01 AS BUILT LAYOUT PLAN	SCALE 1:1000
ISSUE DATE	08/2014		
PROJECT ENGINEER	Vazouras Alexandros Land Surveyor Engineer 		
PARTNERS	Gaitanaros Grigoris _ Civil Engineer		
	Gaitanarou Afroditi _ Architect Engineer		