


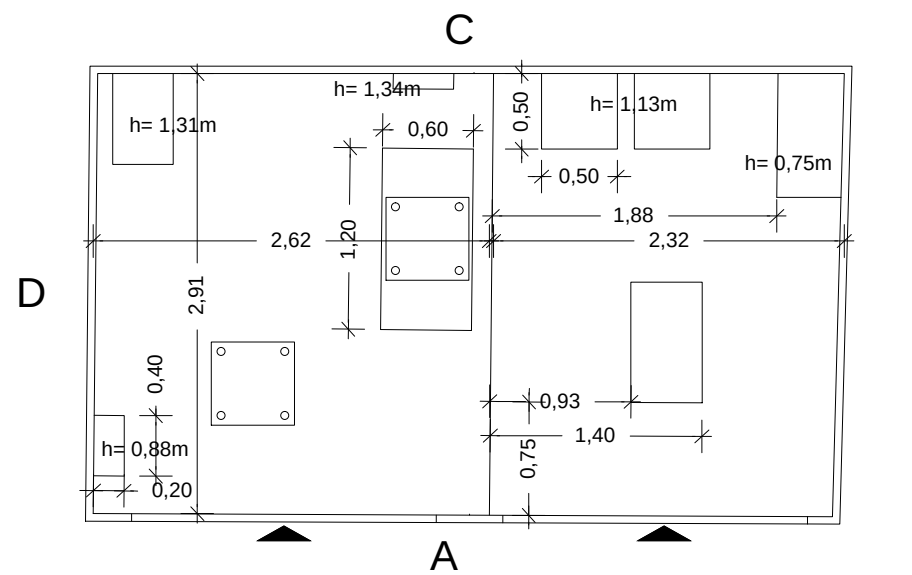
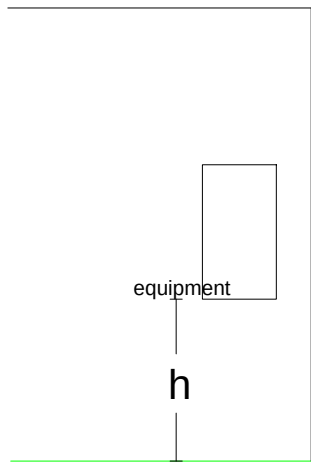


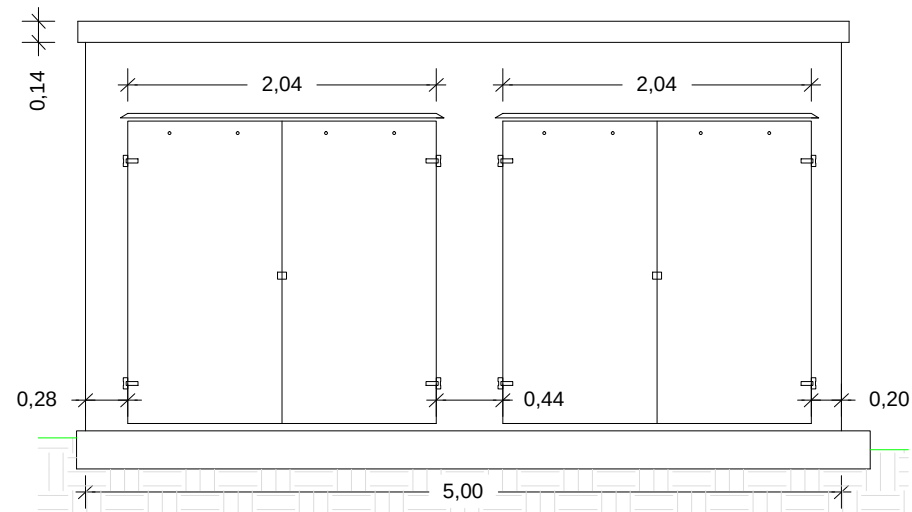


view A

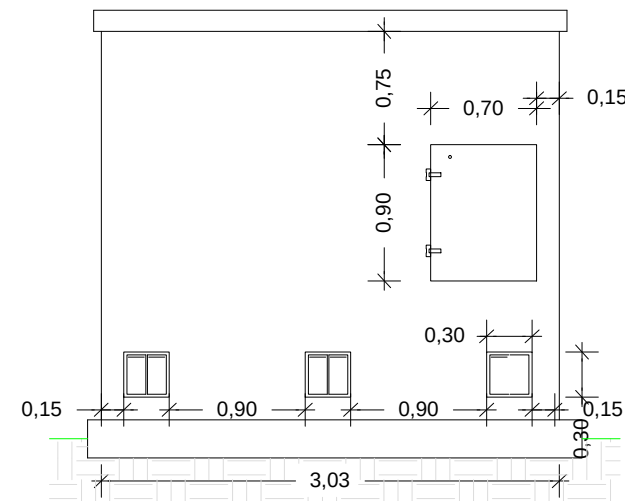


view B

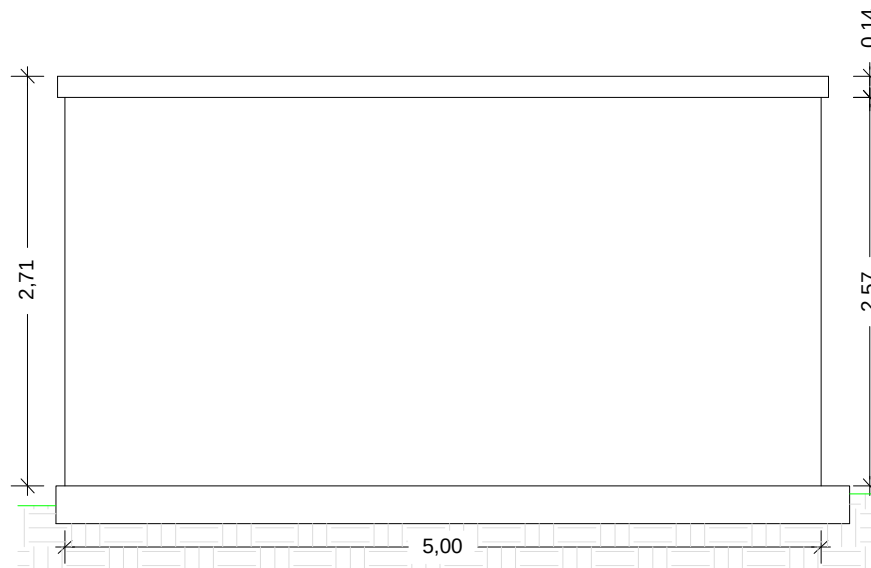



view C

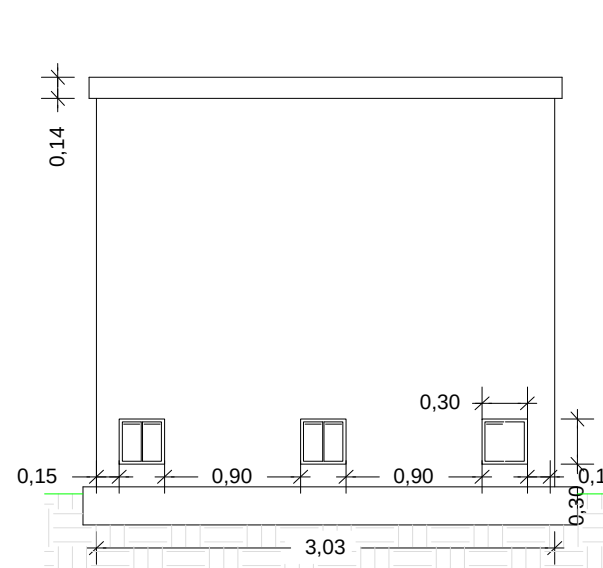


view D

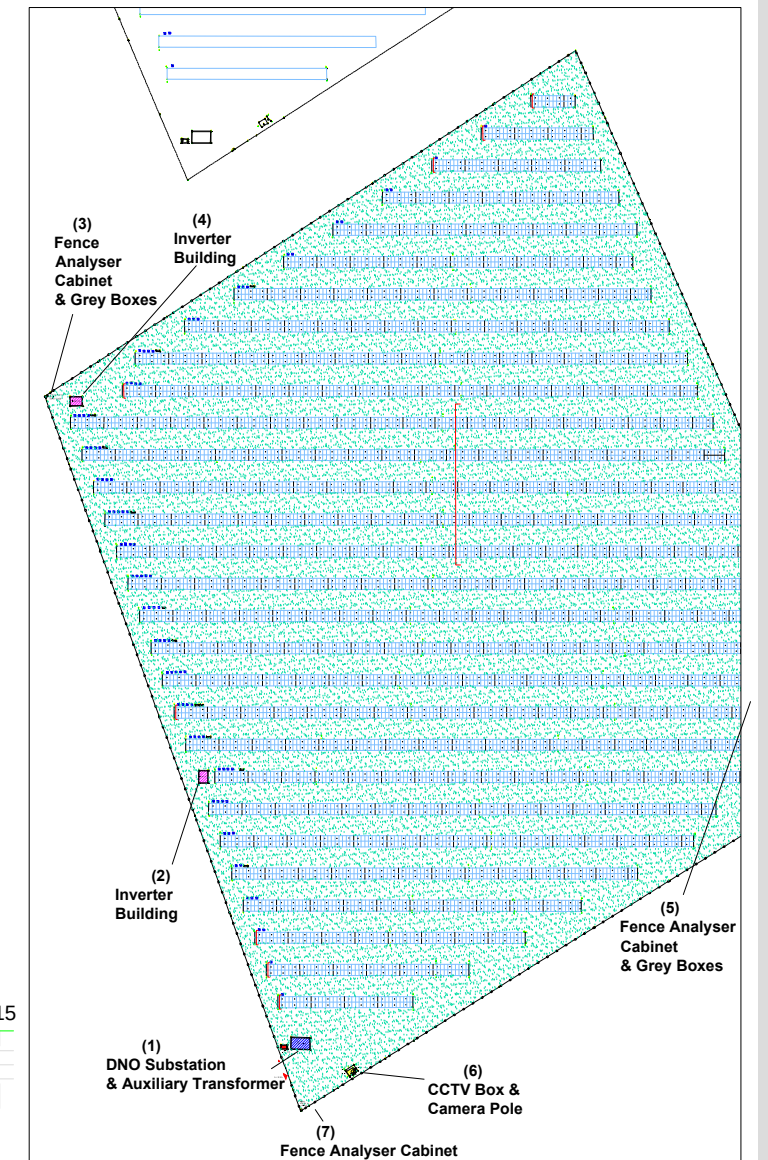


DR/07 DNO Substation Building

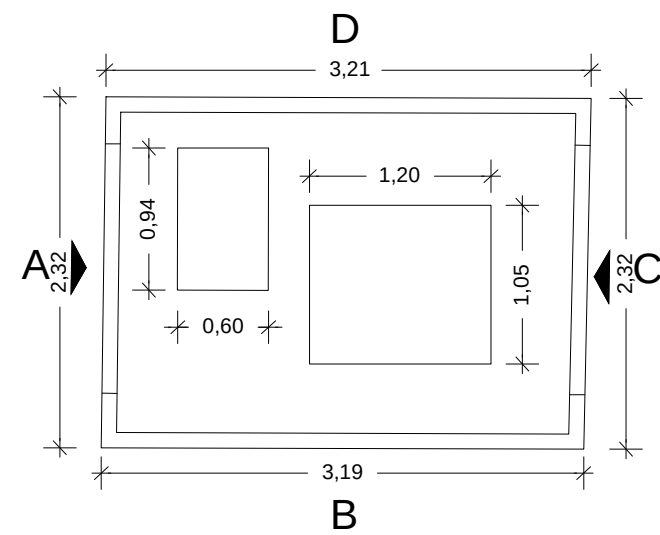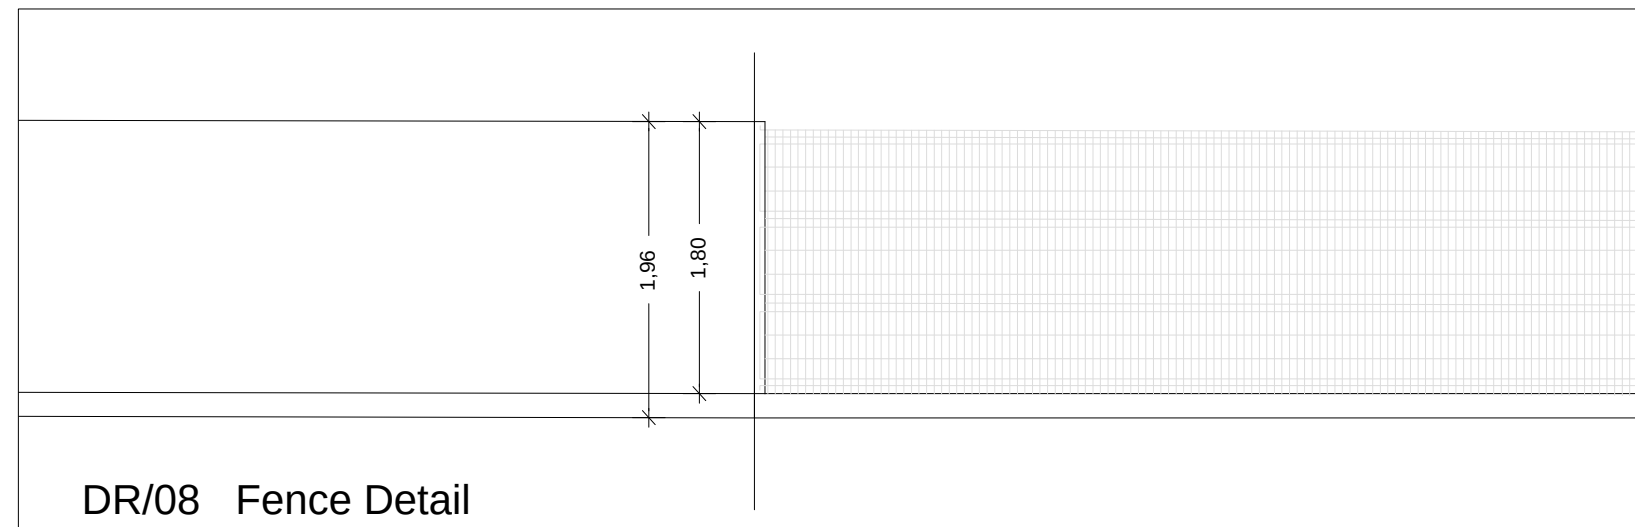


DR/08 Fence Detail

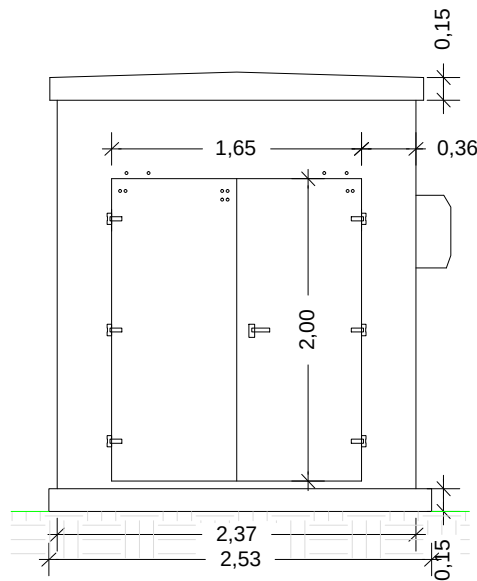


view A

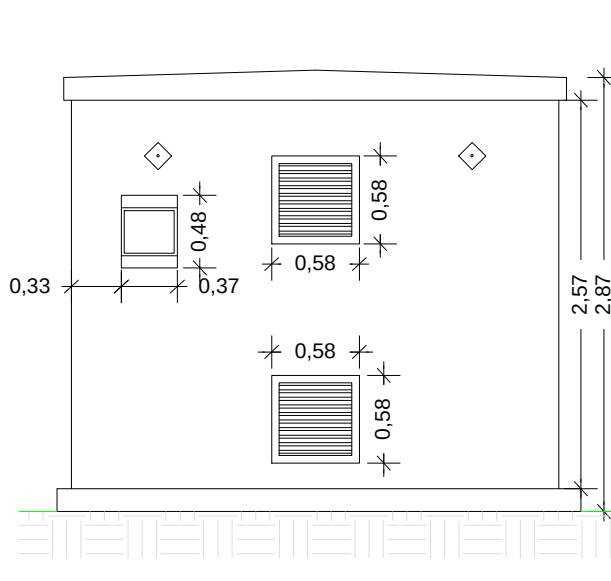

view B

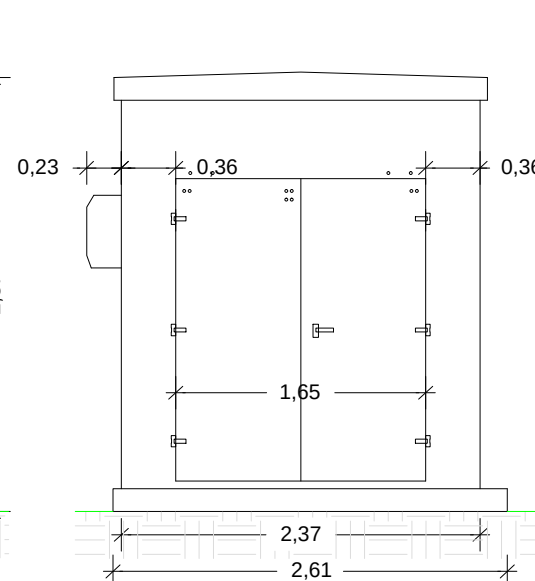

view C

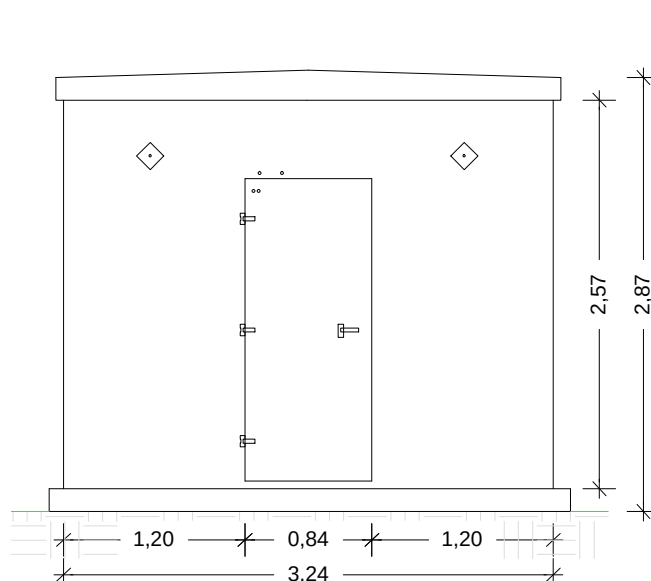

view D

DR/09 Inverter Building

CONTRACTOR NAME
Lightsource Renewable Energy Limited
Level 5, 20 Old Bailey / London / EC4M 7AN

PROJECT
MOOR SOLAR 1
As built plans & drawings

PROJECT SITE
Long Sutton Butterfly & Wildlife Park
Long Sutton , Lincolnshire
PE12 9LE

PROJECT PARTS
DR/07 DNO Substation Building
DR/08 Fence Detail
DR/09 Inverter Building
SCALE
1:50
1:50
1:50

ISSUE DATE
08/2014

PROJECT ENGINEER
Vazouras Alexandros
Land Surveyor Engineer



PARTNERS
Gaitanaros Grigoris _ Civil Engineer
Gaitanarou Afroditi _ Architect Engineer