


Note Position of red lines amended with consent of Les Brown, brought with 4/12/01/08/02 DMG 14/3/06.

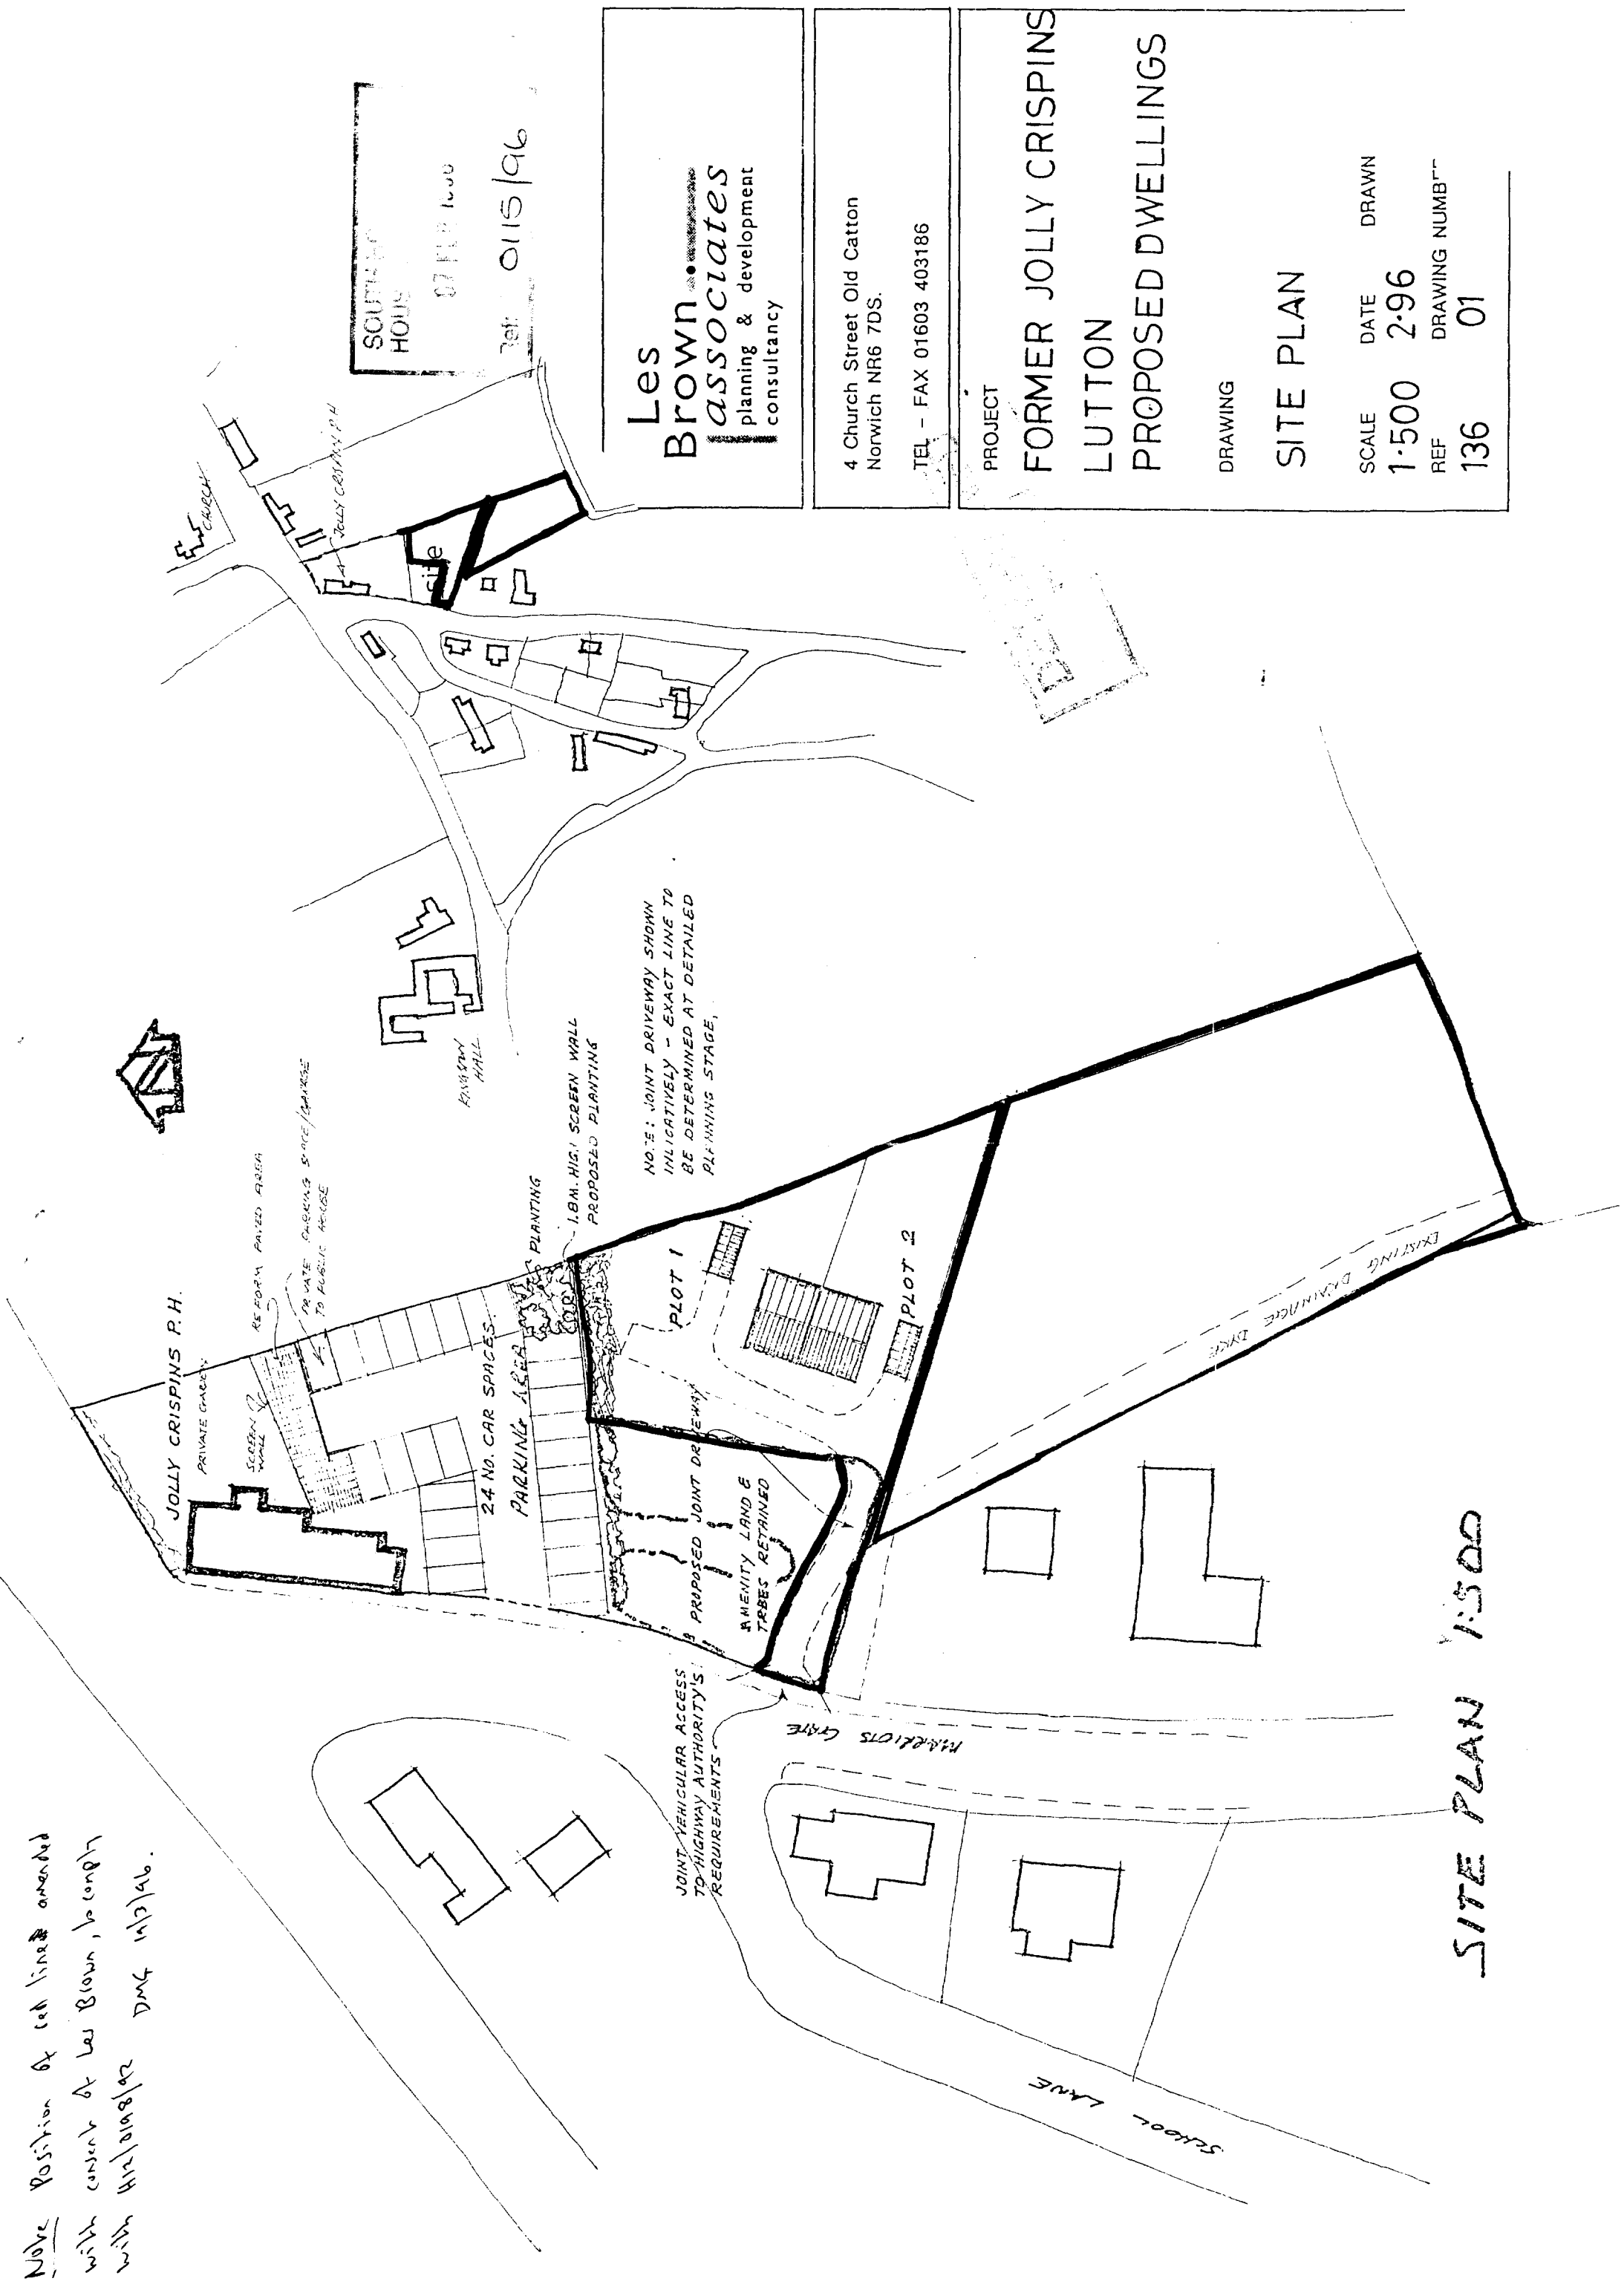

Les
Brown
associates
planning & development
consultancy

4 Church Street Old Catton
Norwich NR6 7DS.

TEL - FAX 01603 403186

PROJECT

FORMER JOLLY CRISPINS
LUTTON
PROPOSED DWELLINGS

DRAWING

SITE PLAN

SCALE DATE DRAWN

1:500 2.96

REF DRAWING NUMBER

136 01