




Location Plan

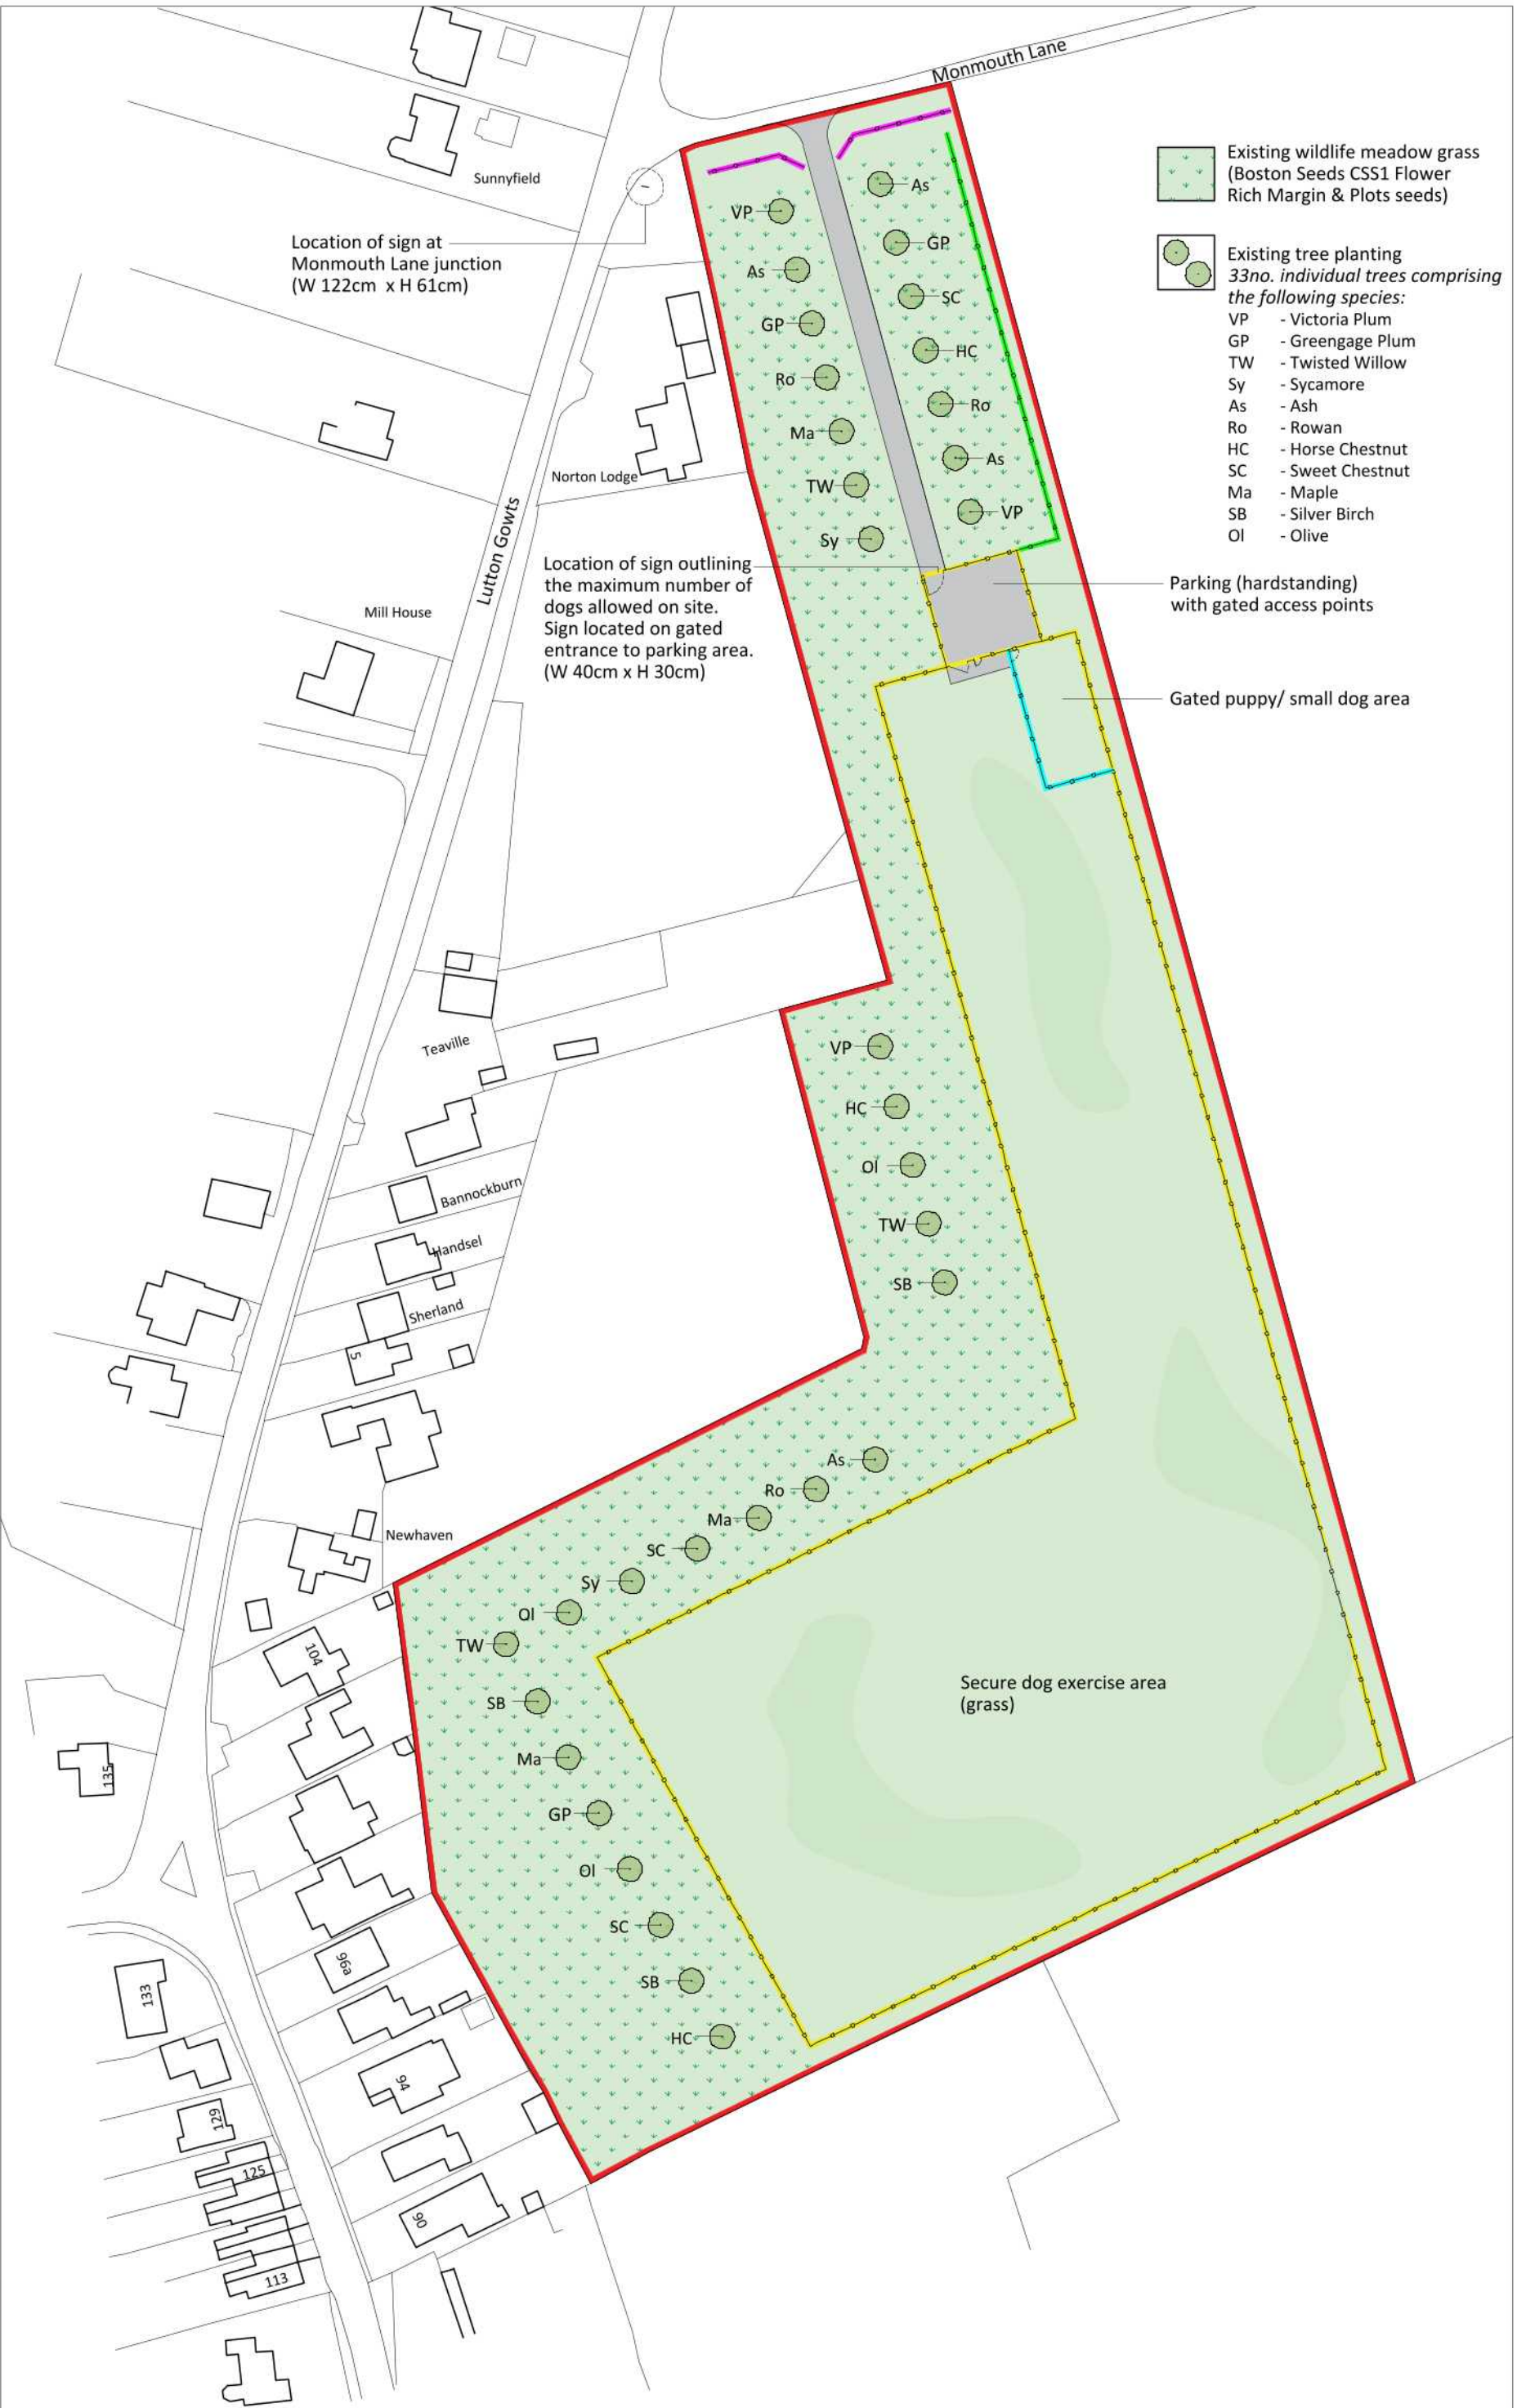

Proposed Site Plan

Notes

Copyright
© Robert Doughty Consultancy Limited.
All rights described in the Copyright, Designs and Patents Act 1988 have been asserted.


Ordnance Survey Map
© Crown Copyright. OS Licence No: AR 100010613.

Dimensions
All dimensions shown are for the purposes of obtaining the relevant planning permission only.

CDM 2015
This drawing is for illustrative purposes and/or obtaining the relevant planning permission only. It should not be used for construction and accordingly, risk identification under the Construction (Design & Management) Regulations 2015 has not been undertaken.

Boundary treatments

- 1.2m high post & rail fence
- 1.9m high dog proof fence
- 1.2m high dog proof fence
- 0.75m high temporary netting

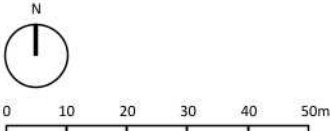

C	WW	Plan updated to match on site arrangements	17.03.25
B	WW	Tree planting revised	14.11.24
A	WW	Red line revised	05.07.24
Rev	By	Description	Date

Current revision checked by: -

rdc
Robert Doughty
Consultancy

32 High Street, Helpringham
Sleaford, Lincolnshire, NG34 0RA

Tel: 01529 421646
Email: admin@rdc-landplan.co.uk
Web: www.rdc-landplan.co.uk

Client
GH Hoyles Ltd

Project
Dog exercise field
Lutton

Drawing
Location plan & site plan

Scale @ A2	Date
1: 1250	19/06/24

Drawn By	Checked By
WW	LMS

Job Number	Status	Purpose of Issue
1622-1	FP	Planning

Drawing No.	Rev
1622-1_FP_SP01	C