




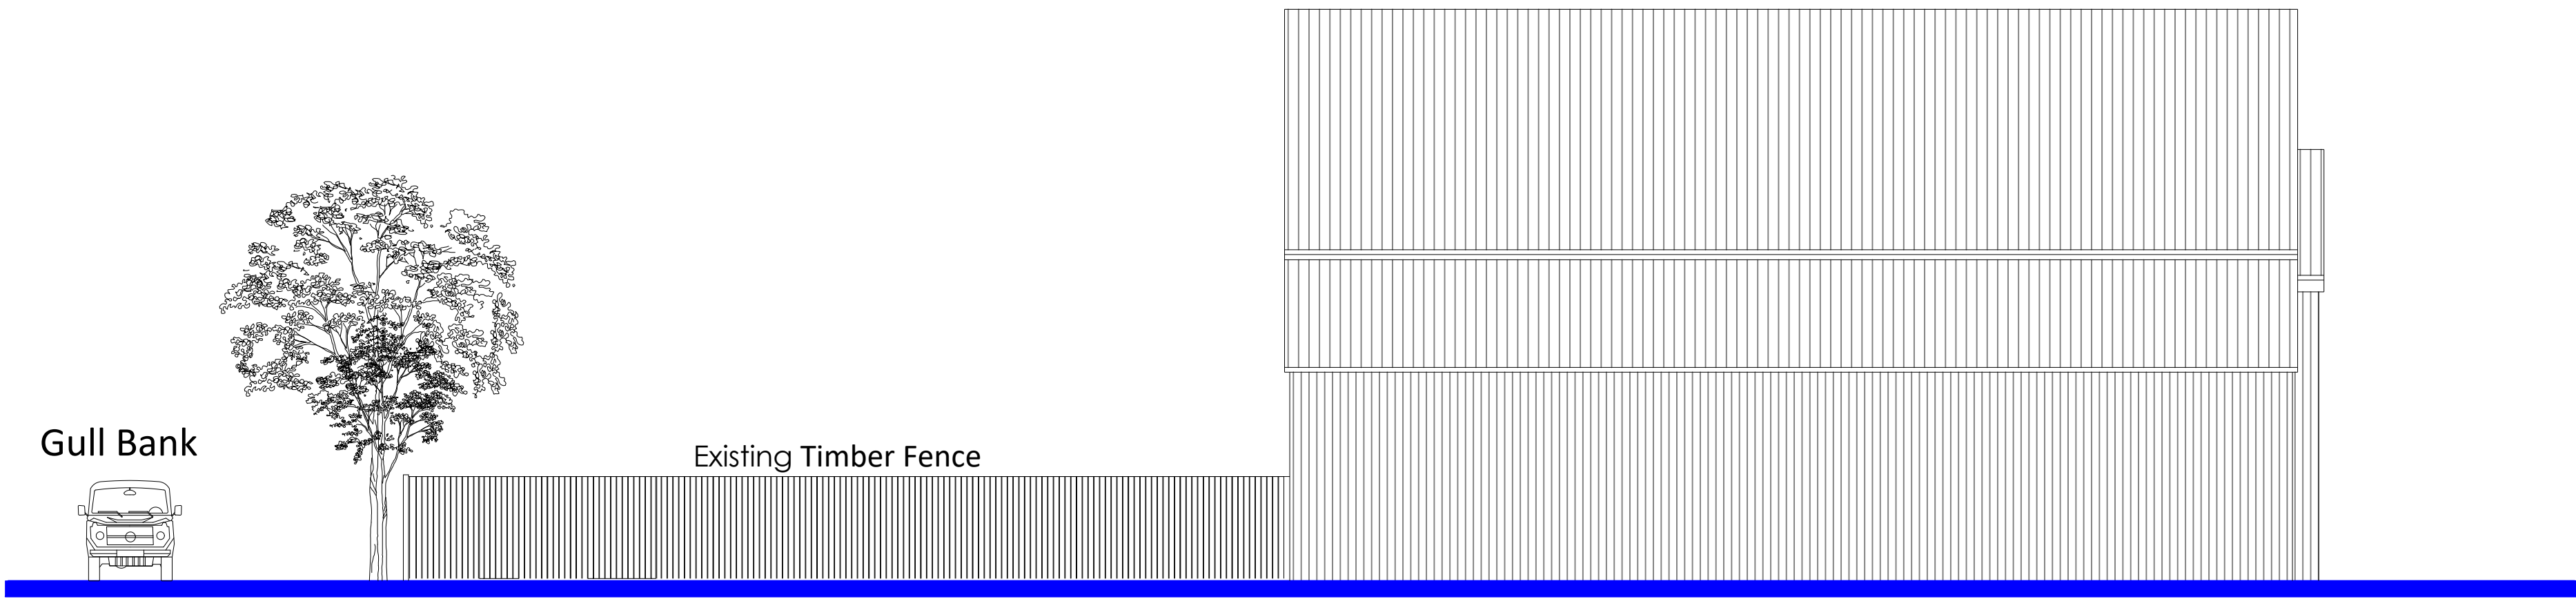


Existing North (Side-2) Elevation - 1:100

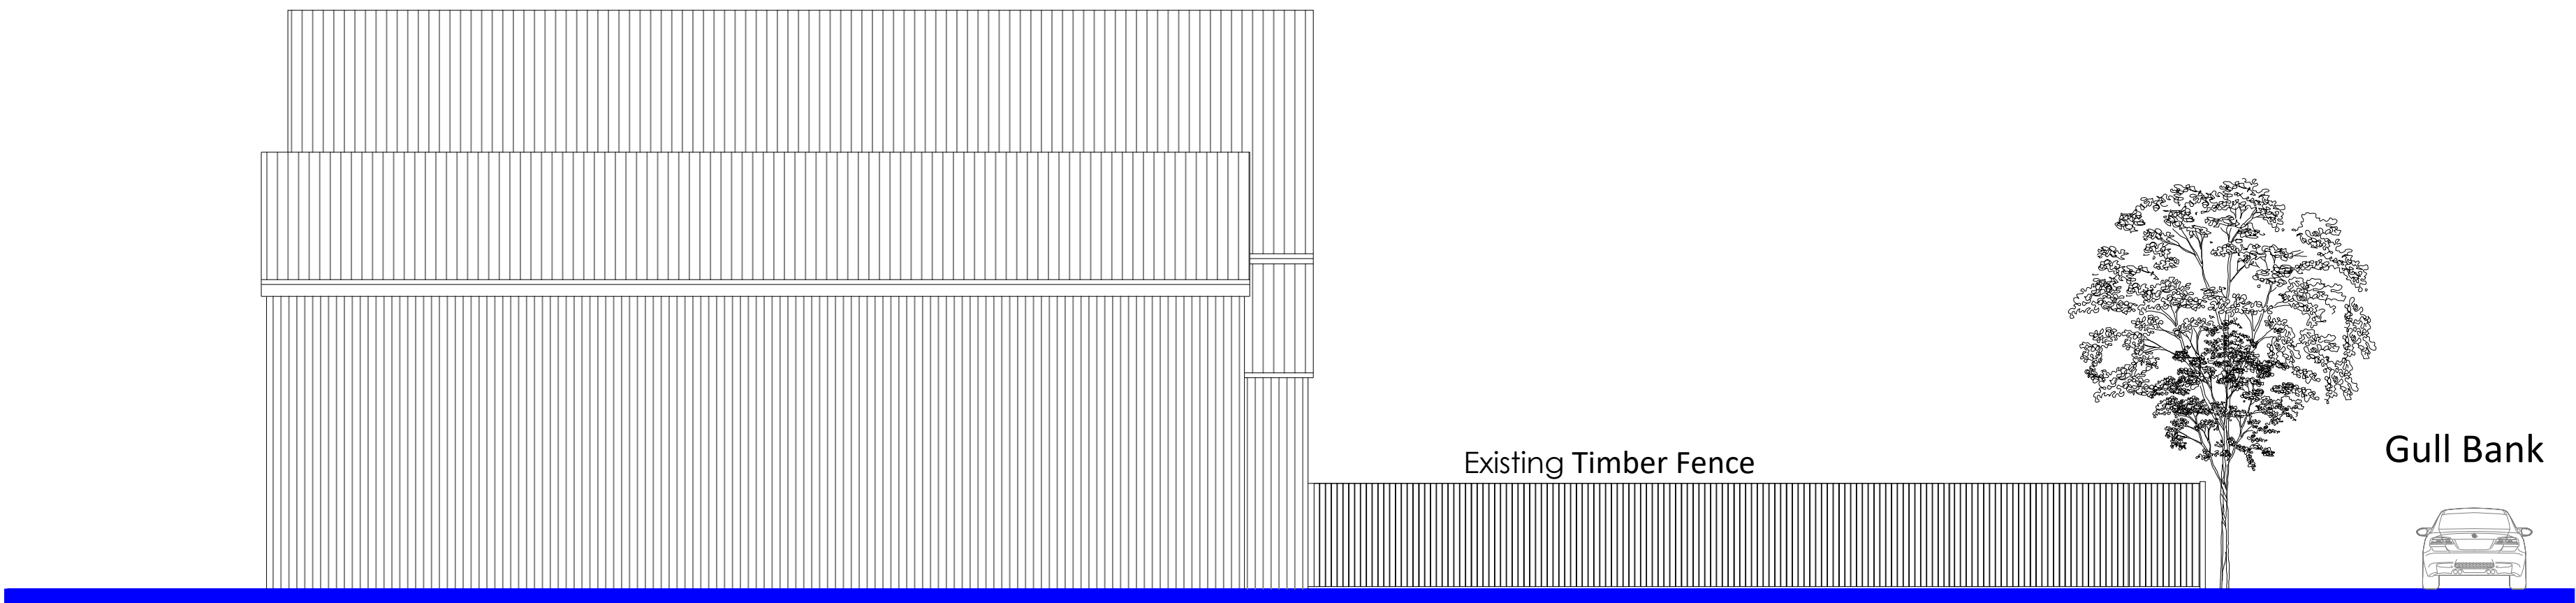


Existing South (Side-1) Elevation - 1:100

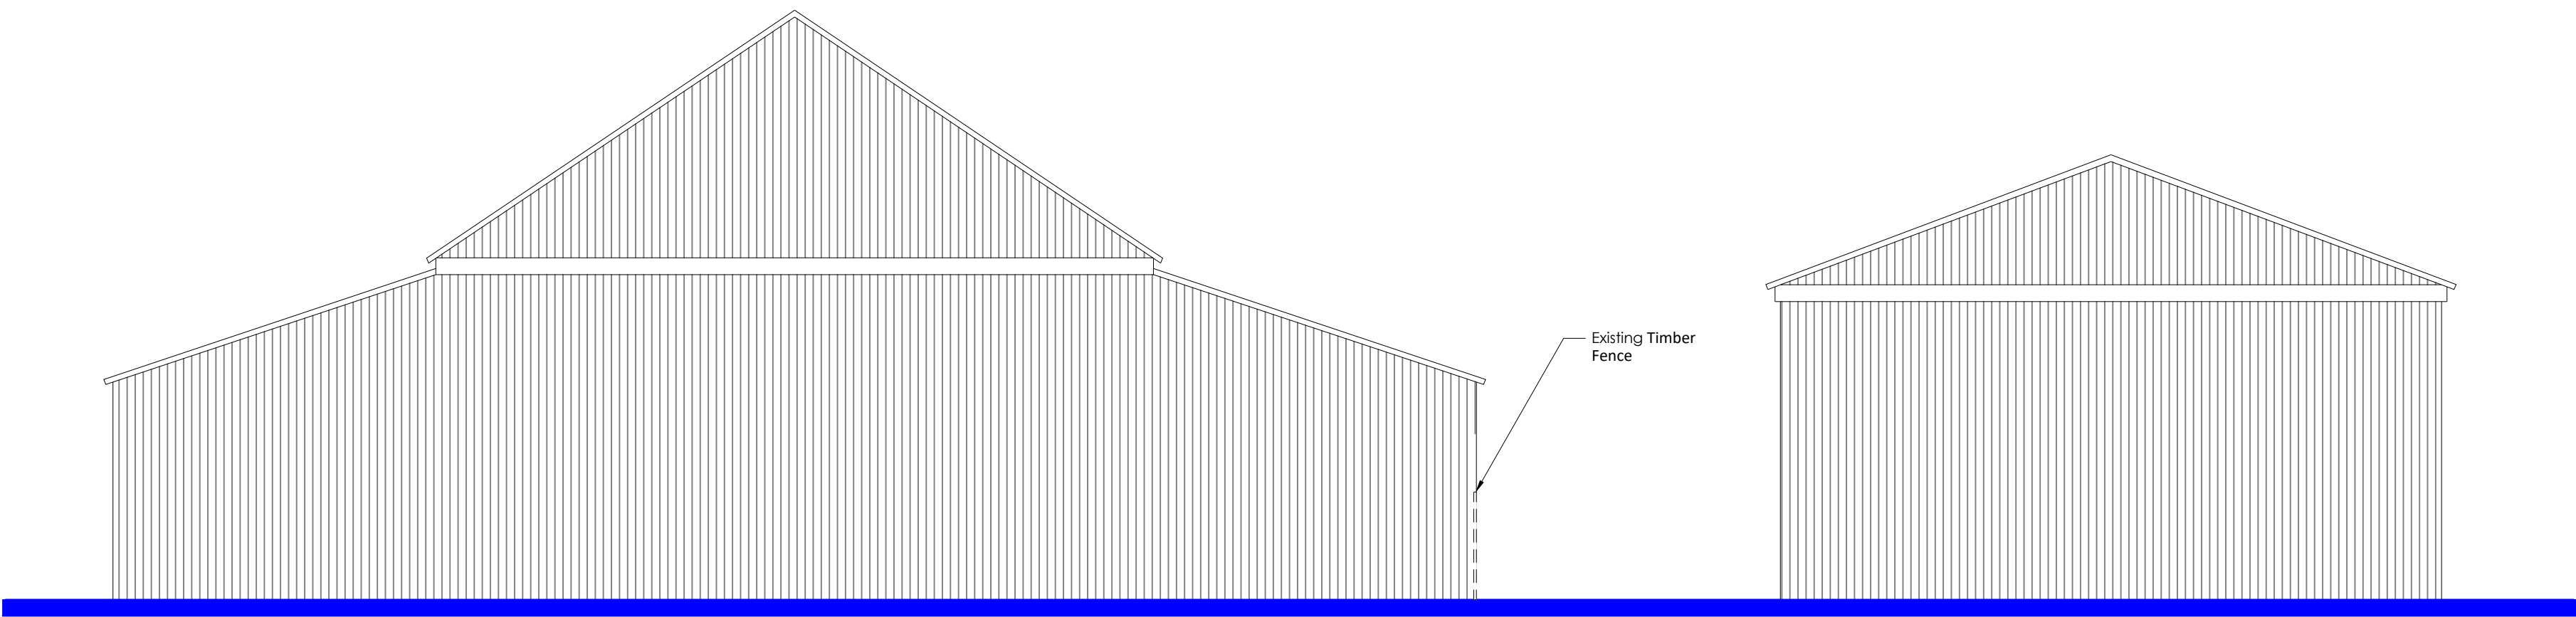


Existing West (Rear) Elevation - 1:100

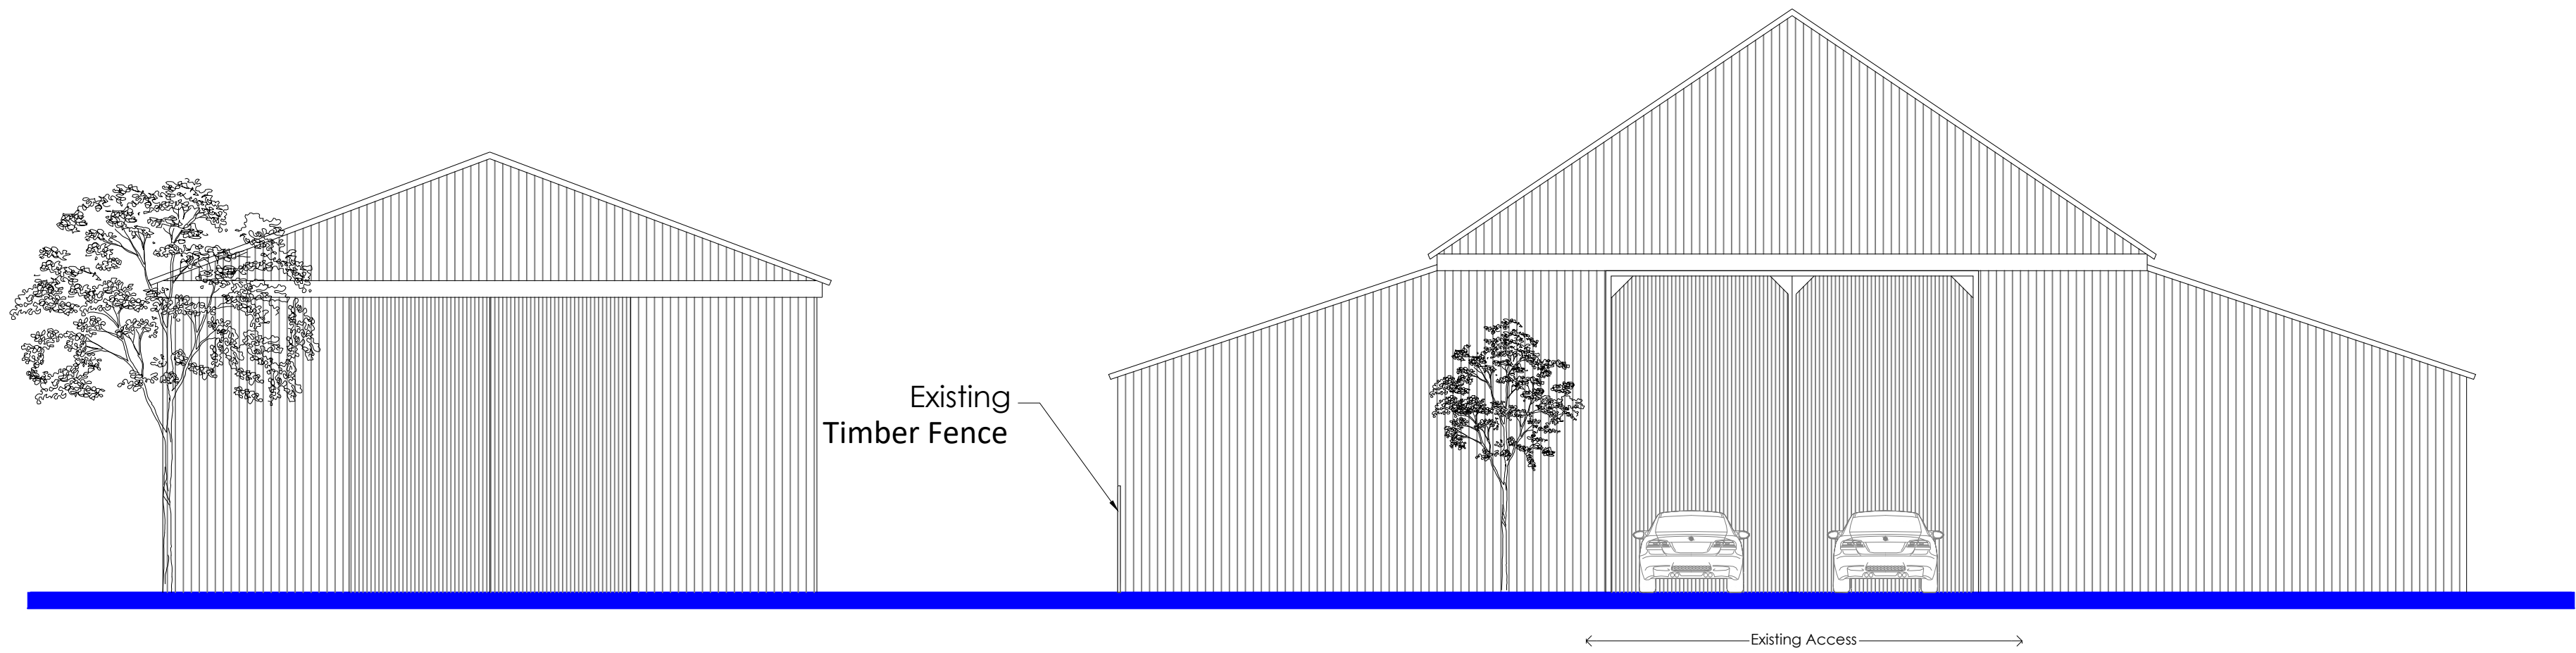

Existing East (Front) Elevation (View from Gull Bank) - 1:100

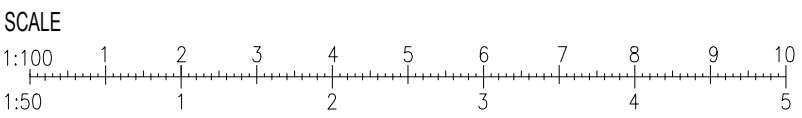

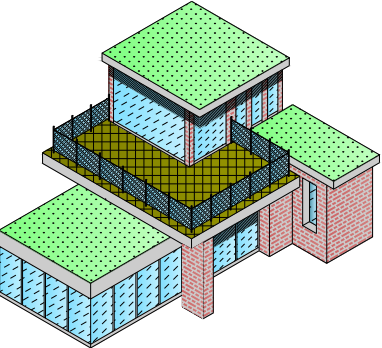

HDI (House Design & Ideas)
Architecture
Tel: 01162547510
Mob: 07773827382

Site Address:
N K R Motors, Gull Bank, Whaplode
Drive, Spalding

Job Title:
As Built Close-board timber
panels (approx 2000mm High)
and changes to the layout of
the front yard.

DRG: 0301/05A - Existing
Elevations
SCALE: As shown
Size: A1
DATE: 11.08.2025