






NORTH - EAST (towards house)

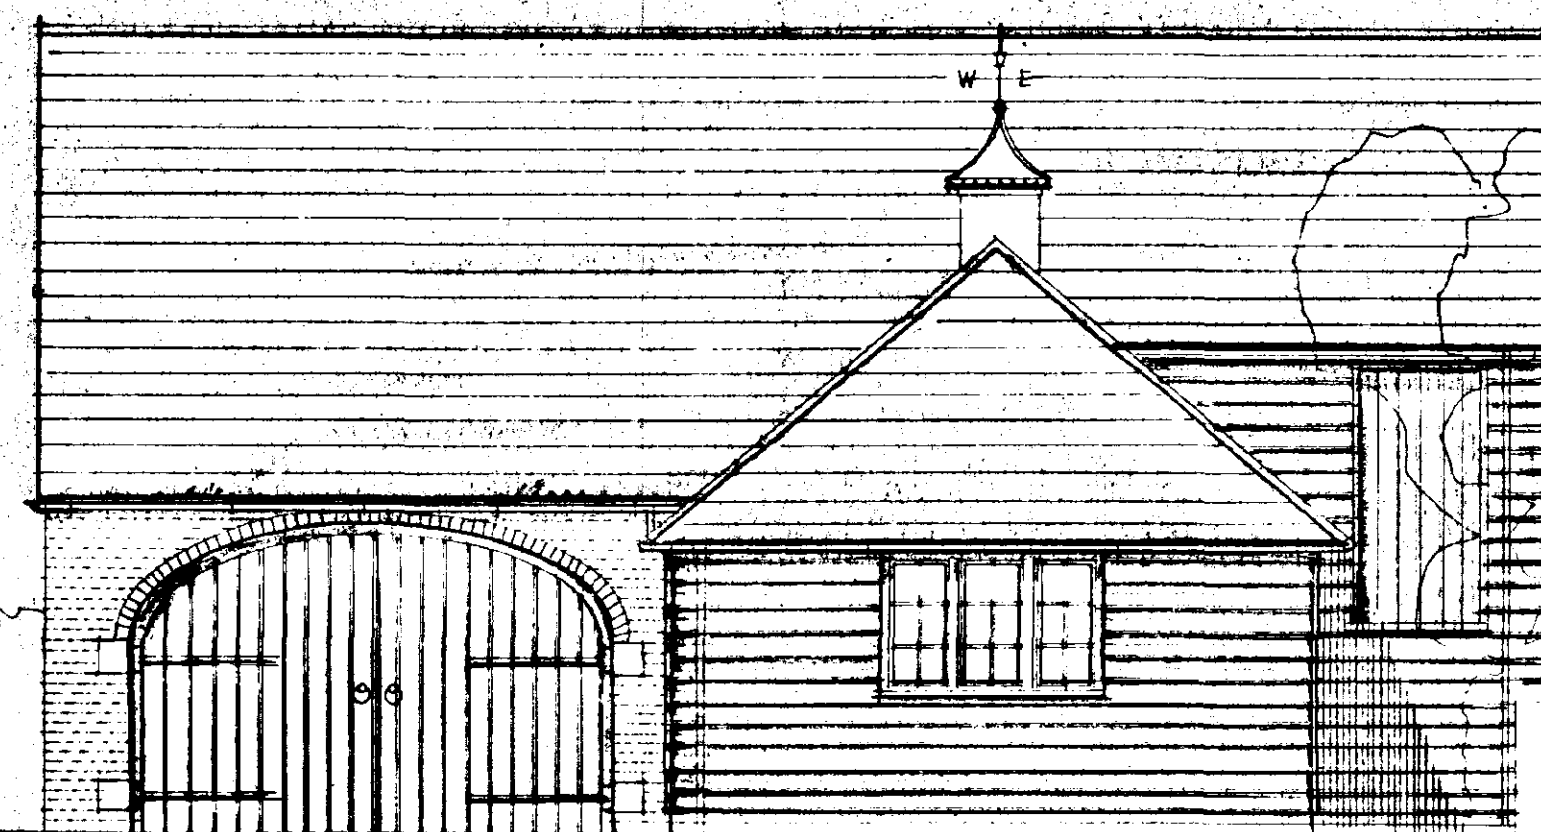


NORTH - WEST (facing new access)

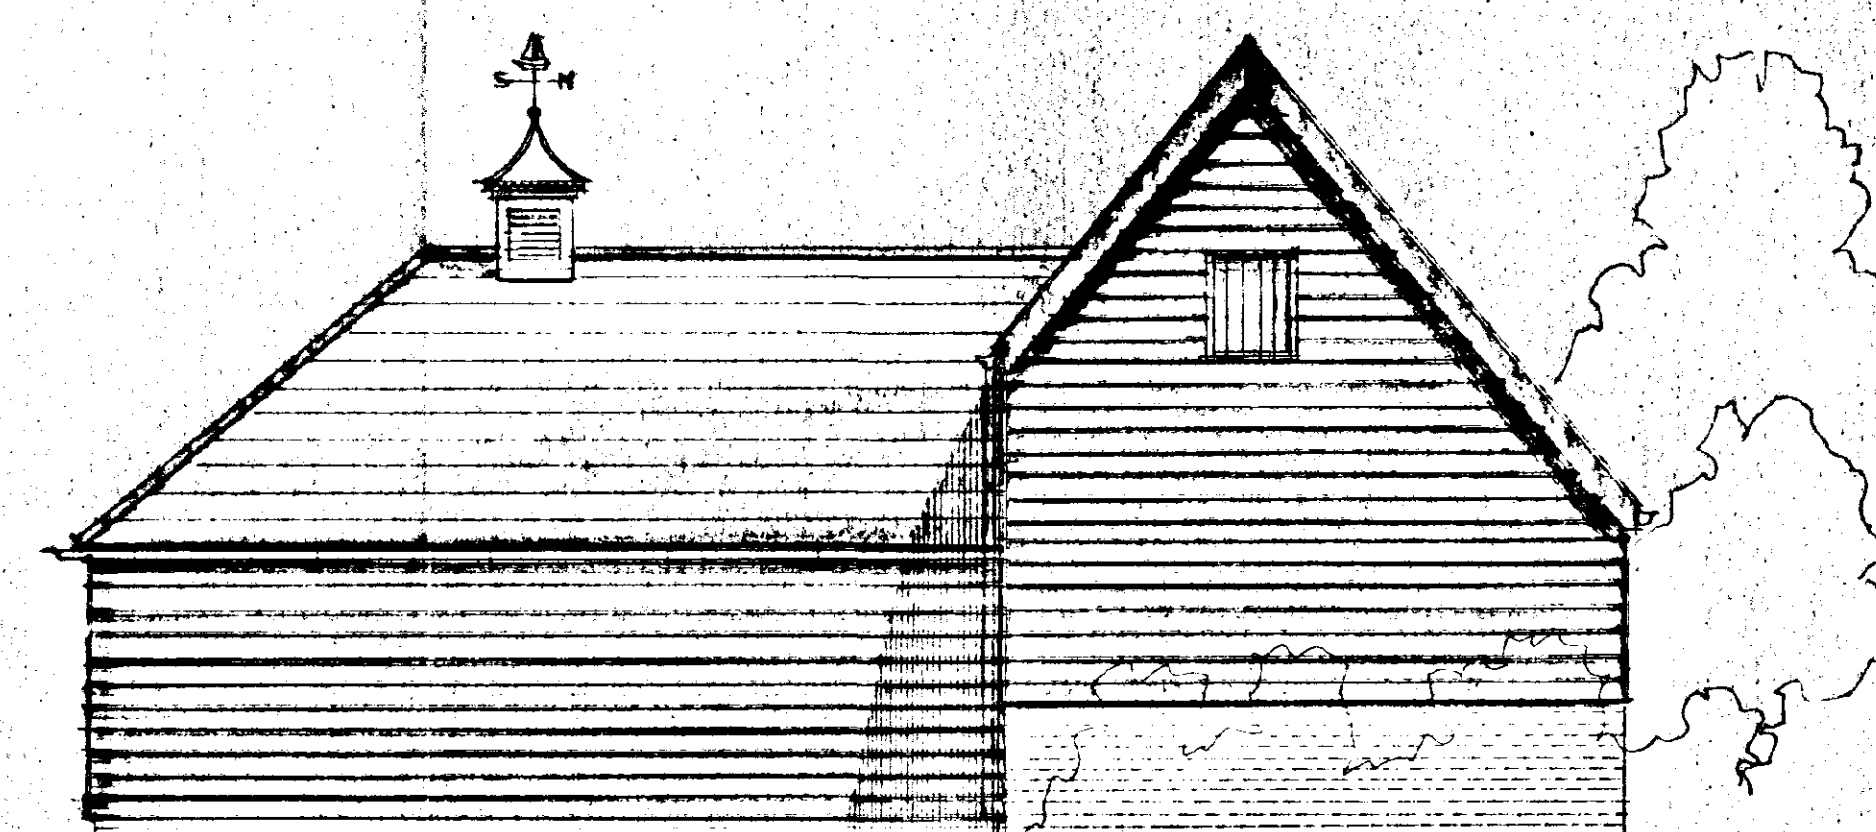

SOUTH - WEST

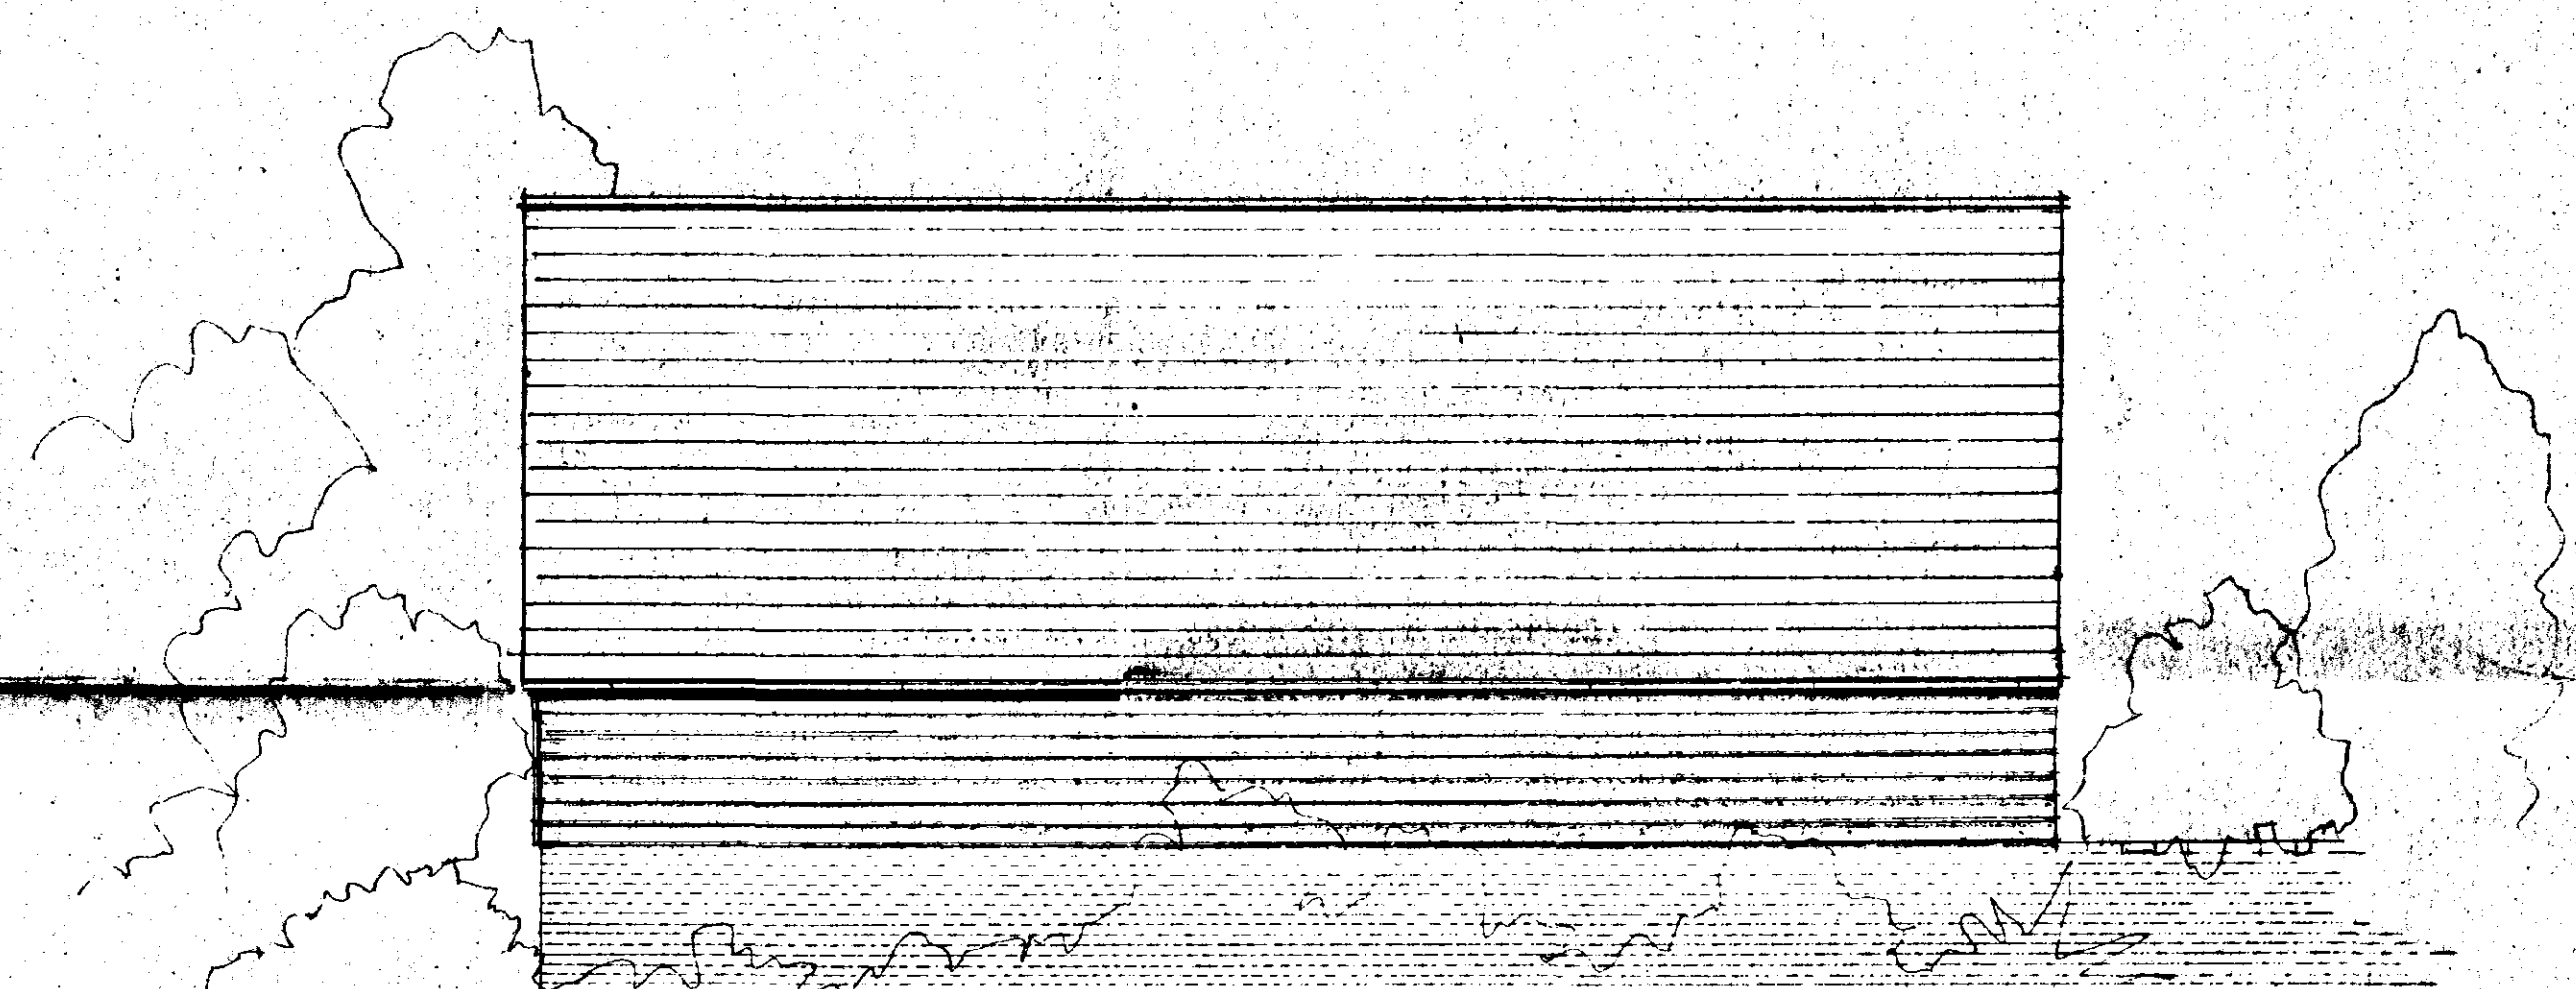

SOUTH - EAST (facing The Old Bowling Green house)

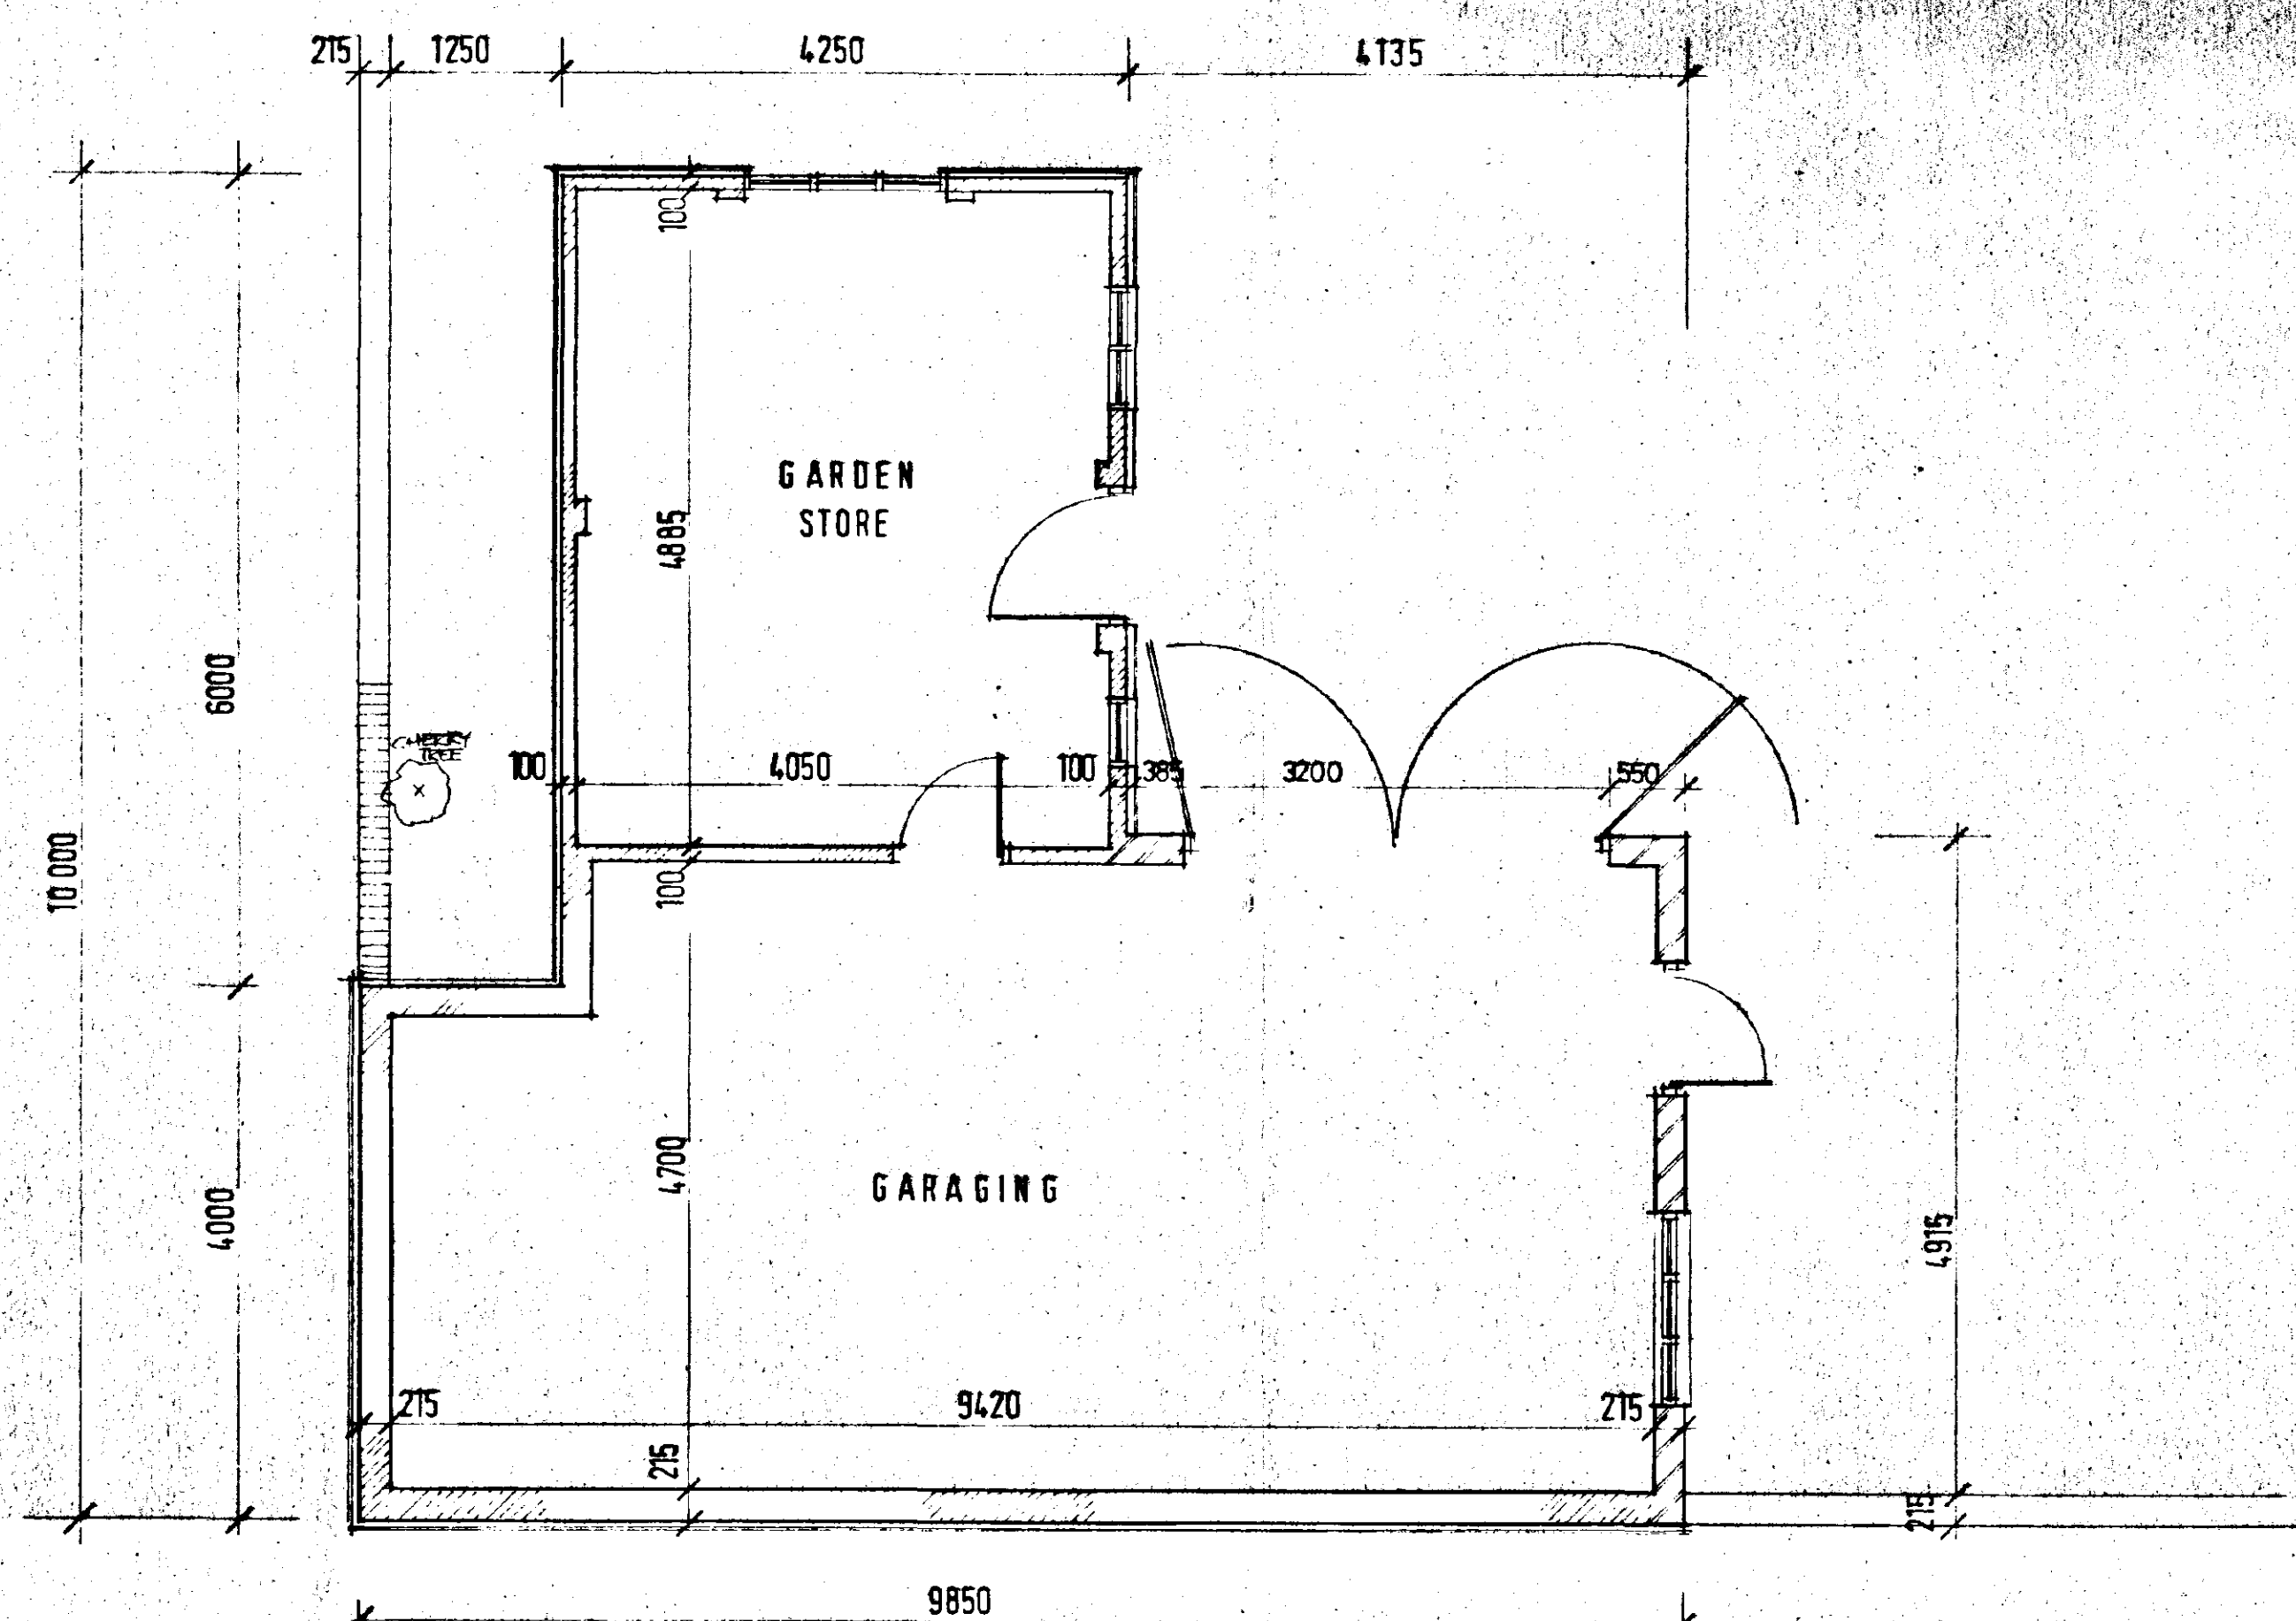

FLOOR LAYOUT

SOUTH HOLLAND DC
HOUSING & PLANNING
26 NOV 1998
Ref: 1173/10

Moulton Design


Planning & Architecture

63 East Cuck Gate, Moulton, Lincolnshire PE12 6QJ
Tel / Fax 01406 370081 Principal: Alan J. Finch

Project
PROPOSED GARAGING & GARDEN STORE
HARRINGTON HOUSE
BROAD LANE MOULTON
for MR. & MRS. C. D. MOORE



Drawing
PROPOSED FLOOR LAYOUT
PROPOSED ELEVATIONS

key	A	WEATHERBOARD TREATMENT COLOURED TO BROWN	11.98	62
scale	1:50	drg no.	980502	03
date	NOV. 1998			

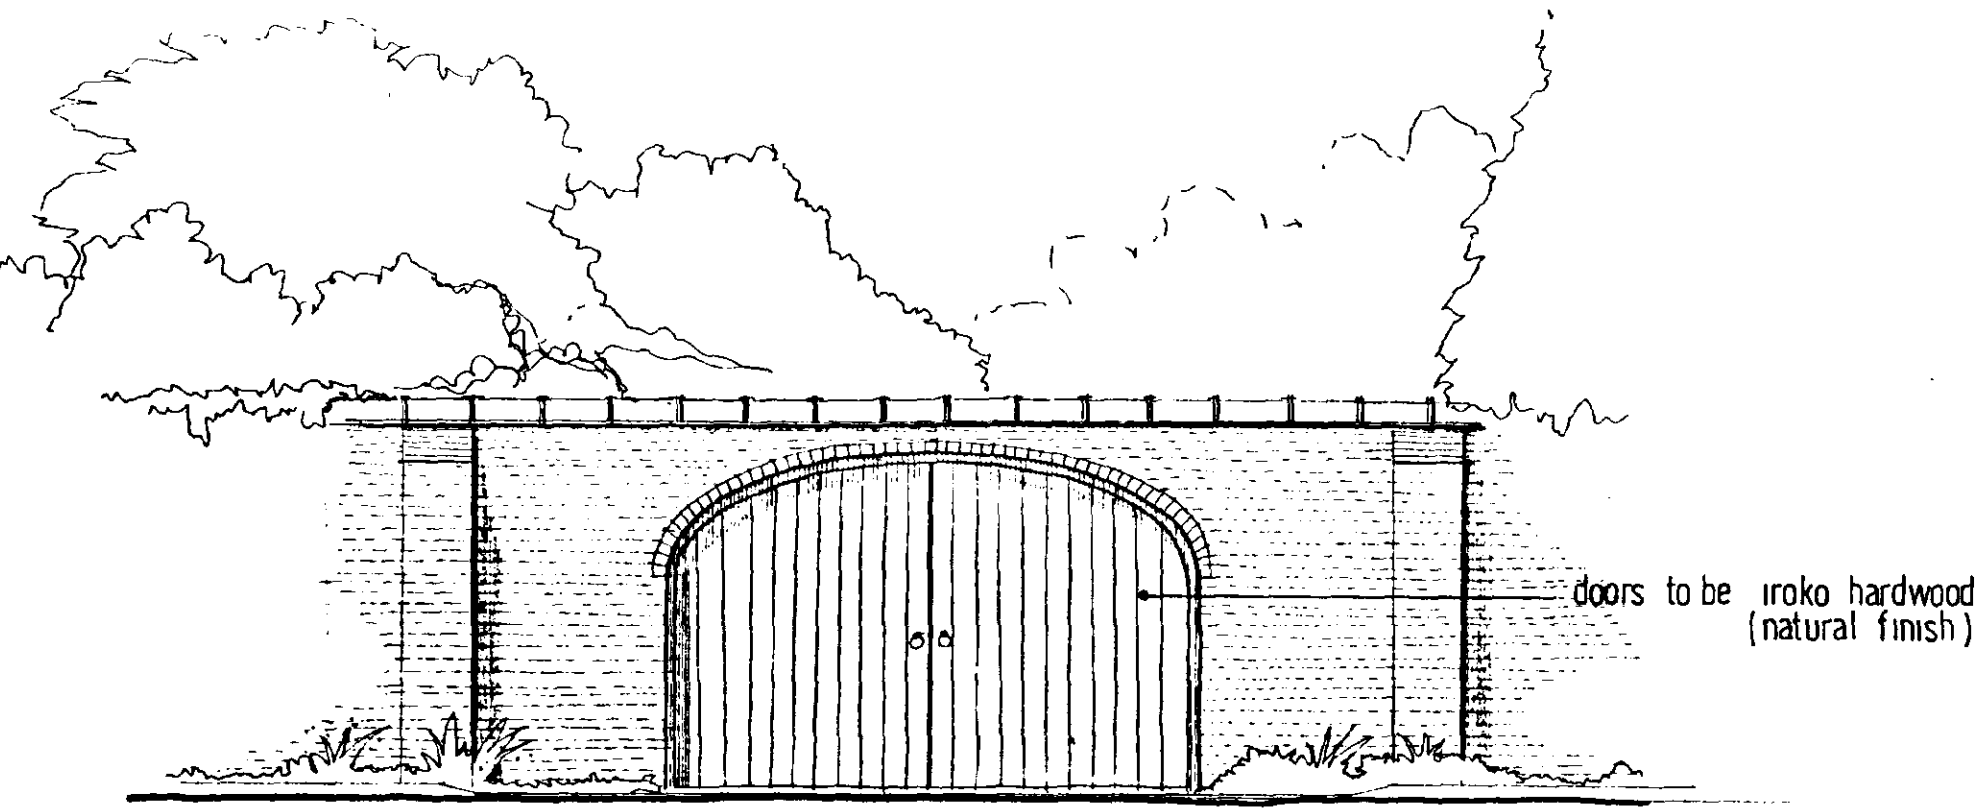

doors to be iroko hardwood
(natural finish)

ELEVATION TO GARDEN WALL SHOWING PROPOSED GATED ACCESS

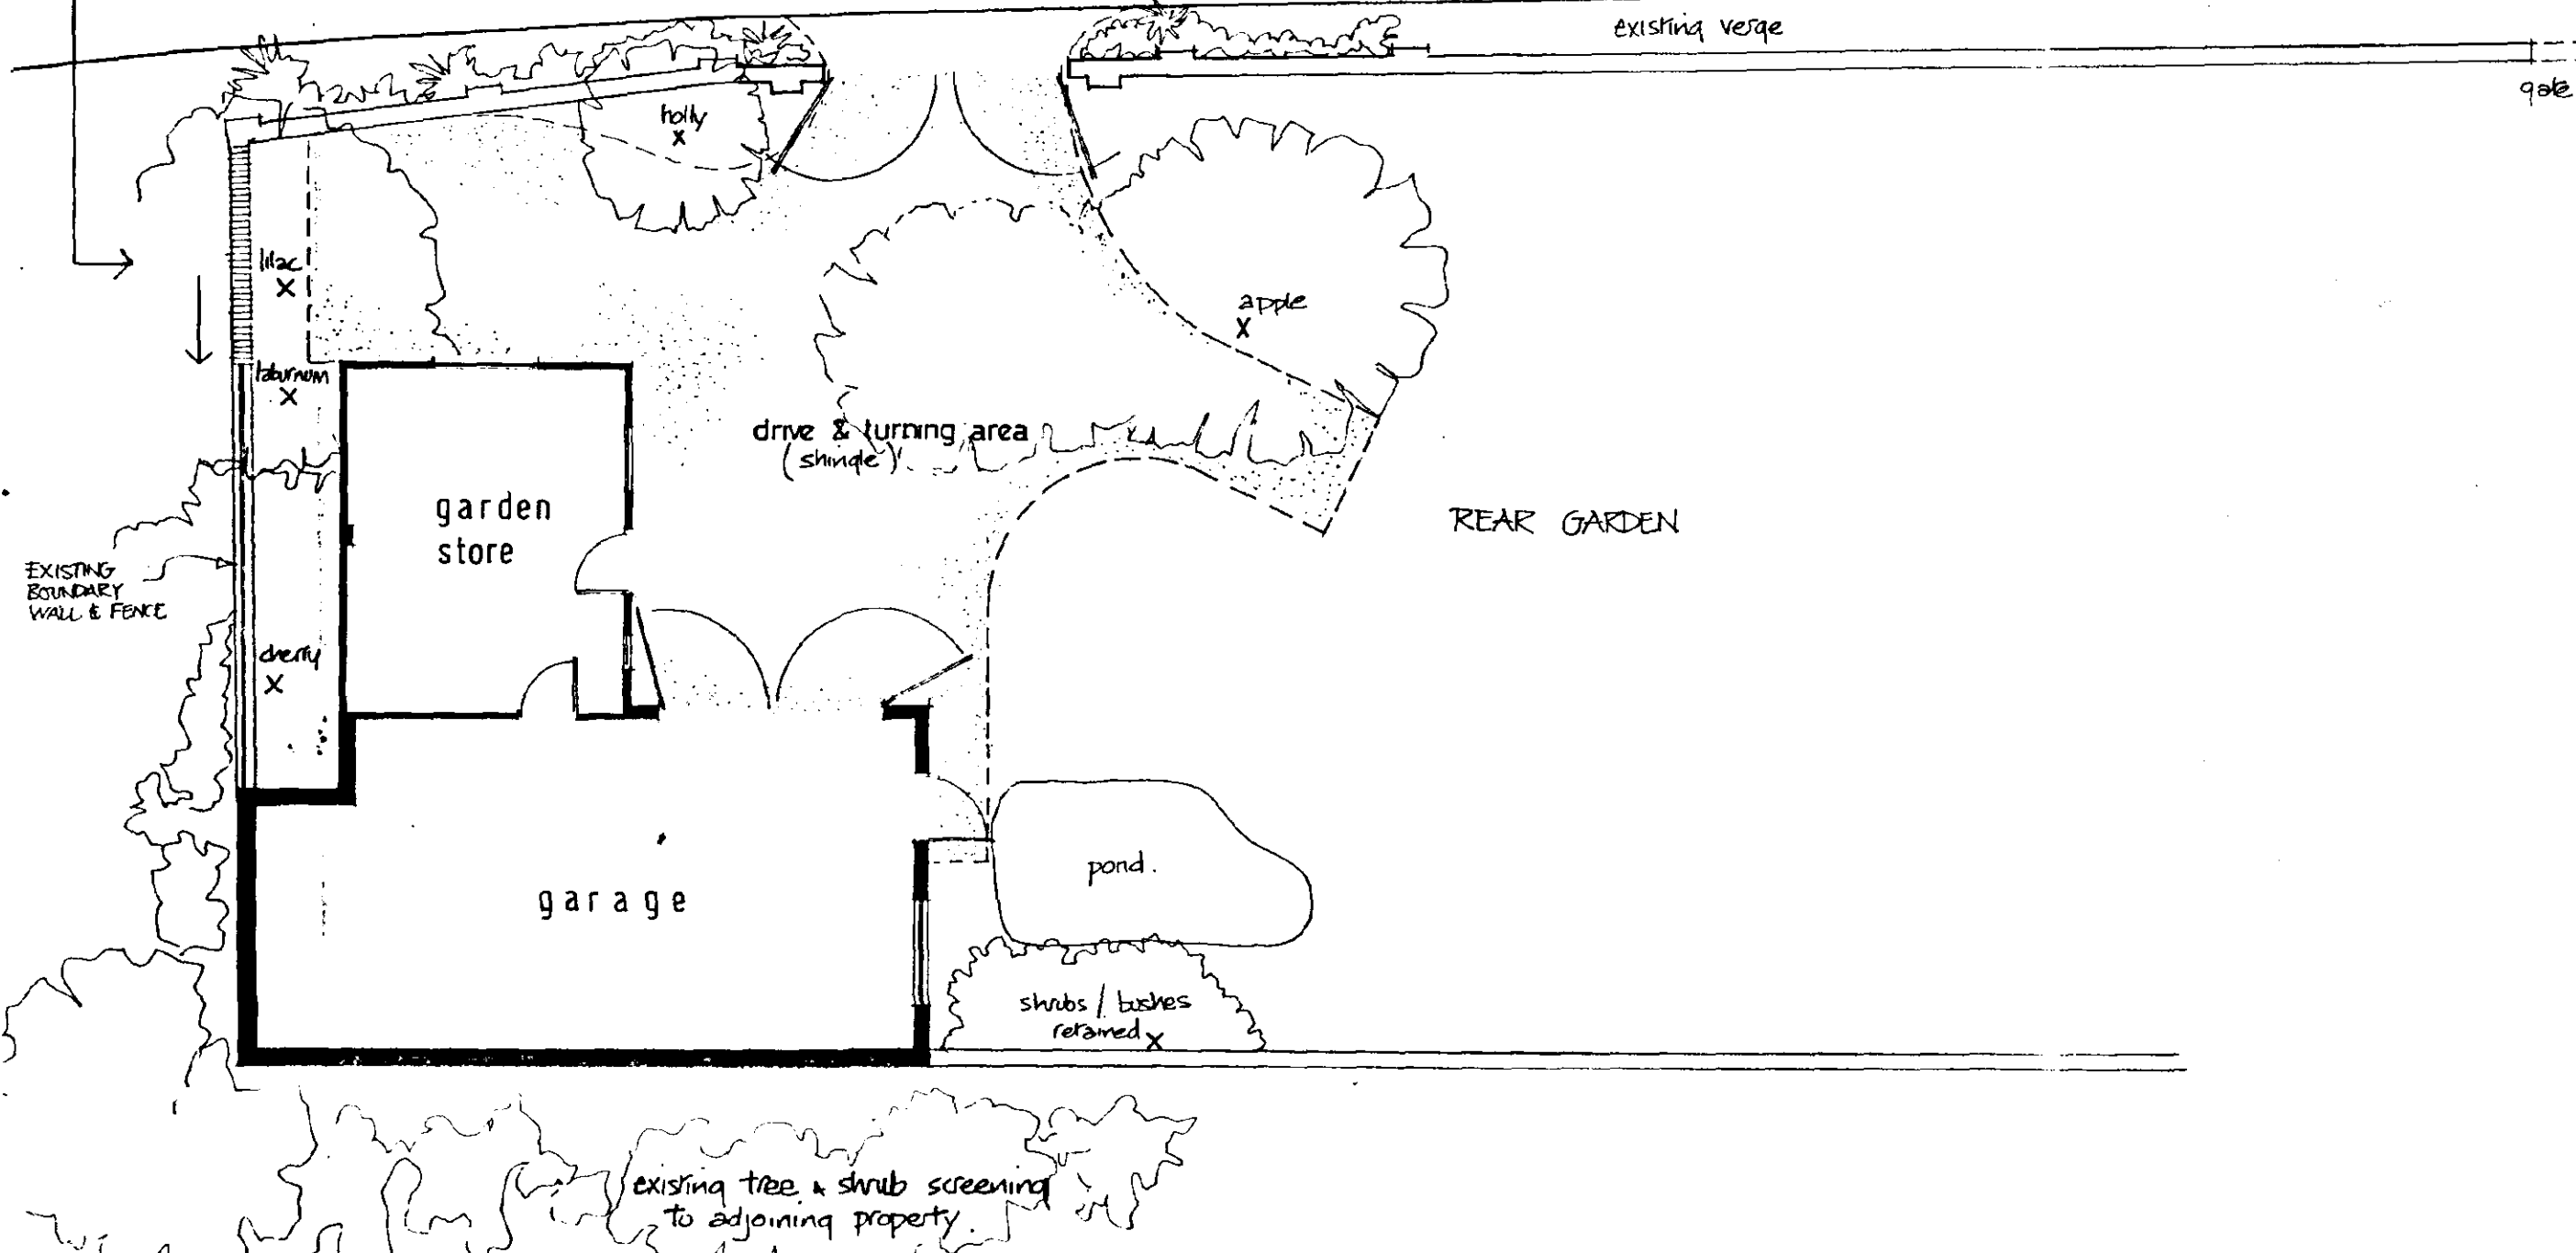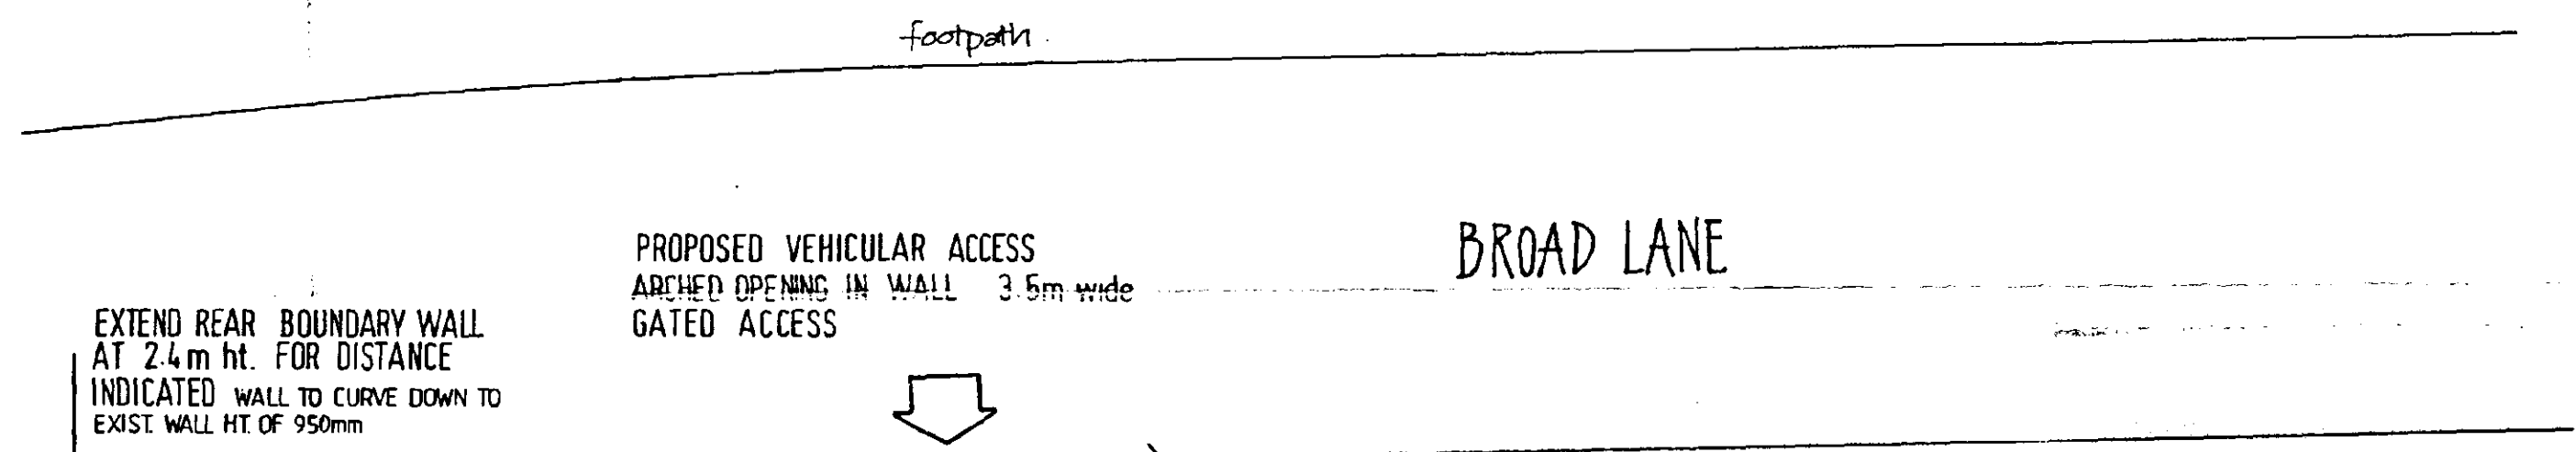

HARRINGTON HOUSE

AMENDED PLAN
Ref.

SOUTH HOLLAND DC
HOUSING & PLANNING
~~2 JAN 1999~~
Ref: 1173/98

AMENDED PLAN
Ref.

SOUTH HOLLAND DC
HOUSING & PLANNING
23 DEC 1998
Ref: ~~1173/98~~
1178/98

Moulton Design


Planning & Architecture

63 East Cob Gate, Moulton, Lincolnshire PE12 6QJ
Tel / Fax 01406 370081 Principal: Alan J. Finch


PROPOSED GARAGING & GARDEN STORE
HARRINGTON HOUSE
BROAD LANE MOULTON
for Mr. & Mrs. C.D. MOORE

SITE LAYOUT AS PROPOSED
ENTRANCE GATE DETAILS


A	TURNING FACILITY REVISED AS REQD BY L.C.C. 12.98				2/1
1:50	1:100				
NOV. 1998					980502 / 02A

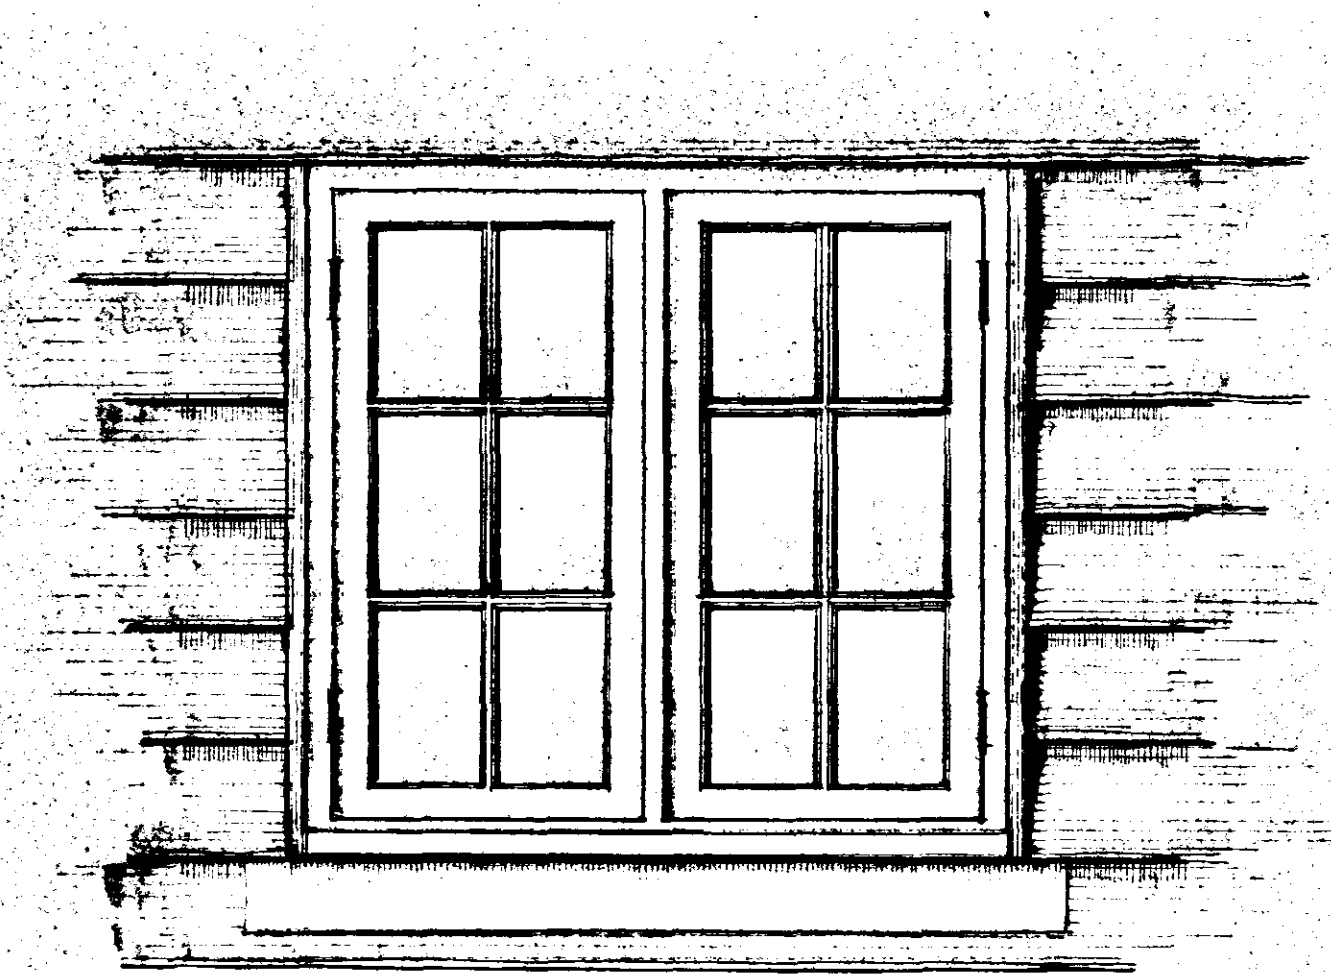


ELEVATION 1:10

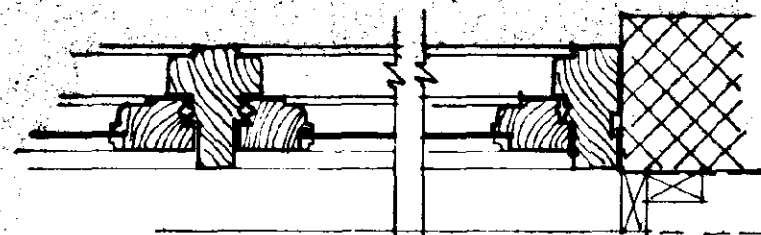


PLAN VIEW - Jamb & Mullion 1:5

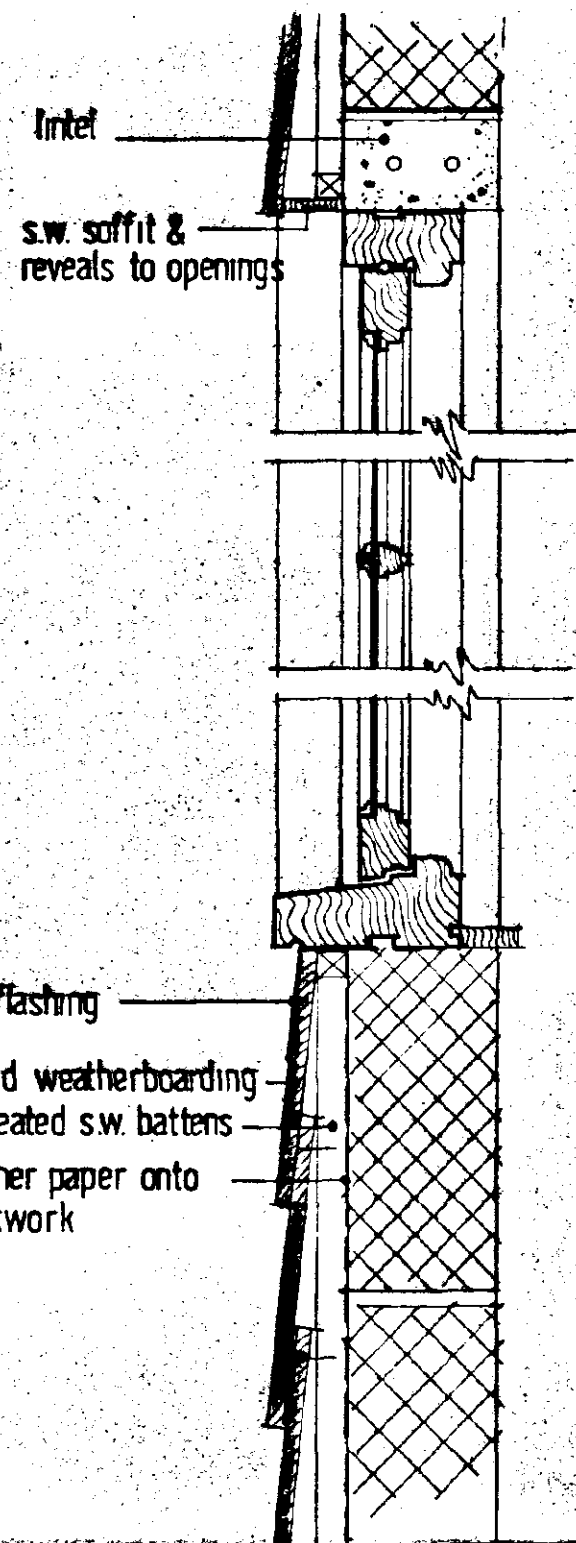

SECTION 1:5

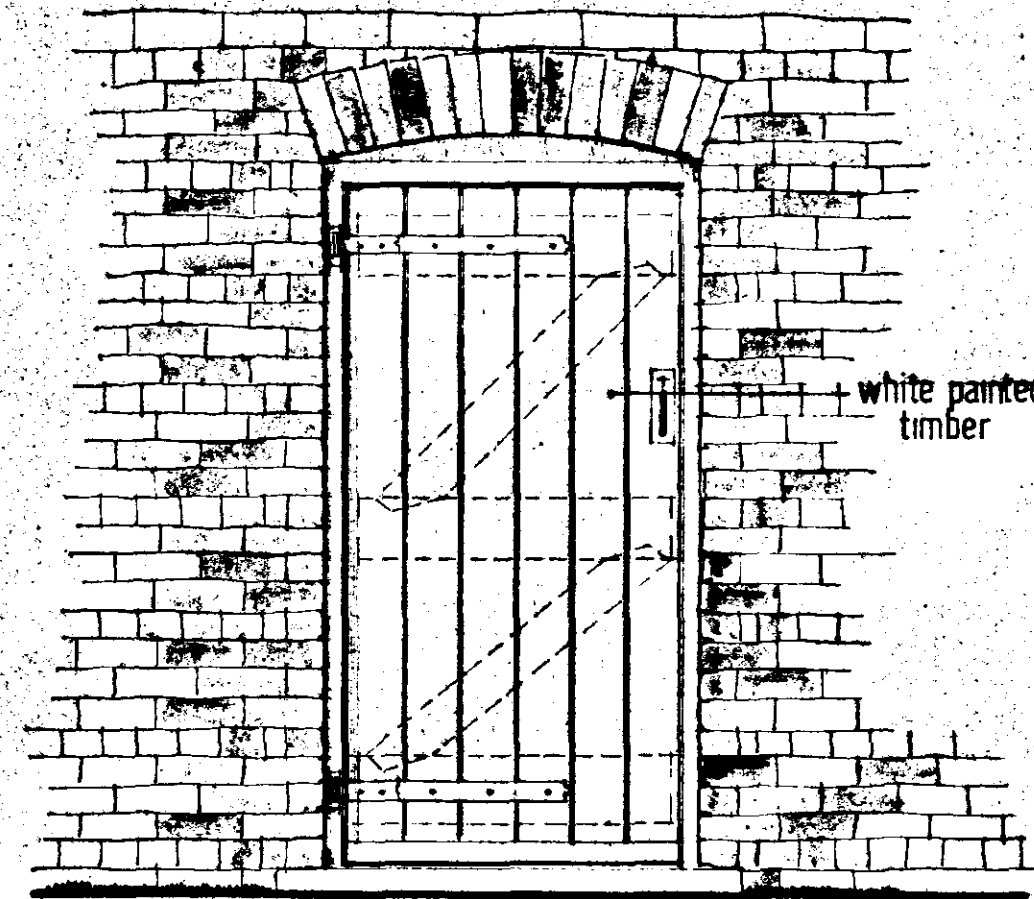


ELEVATION 1:20

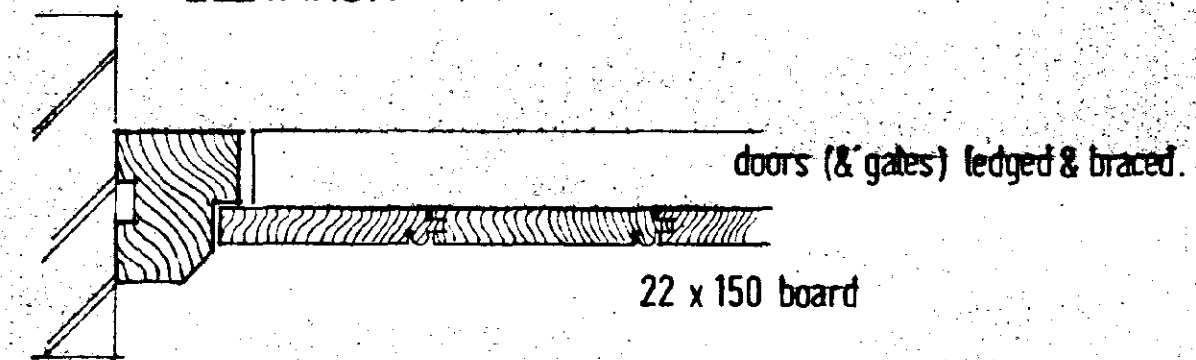

PLAN VIEW 1:5

DOOR CONSTRUCTION TO GATES AS DOORS

TYPICAL WINDOW DETAILS

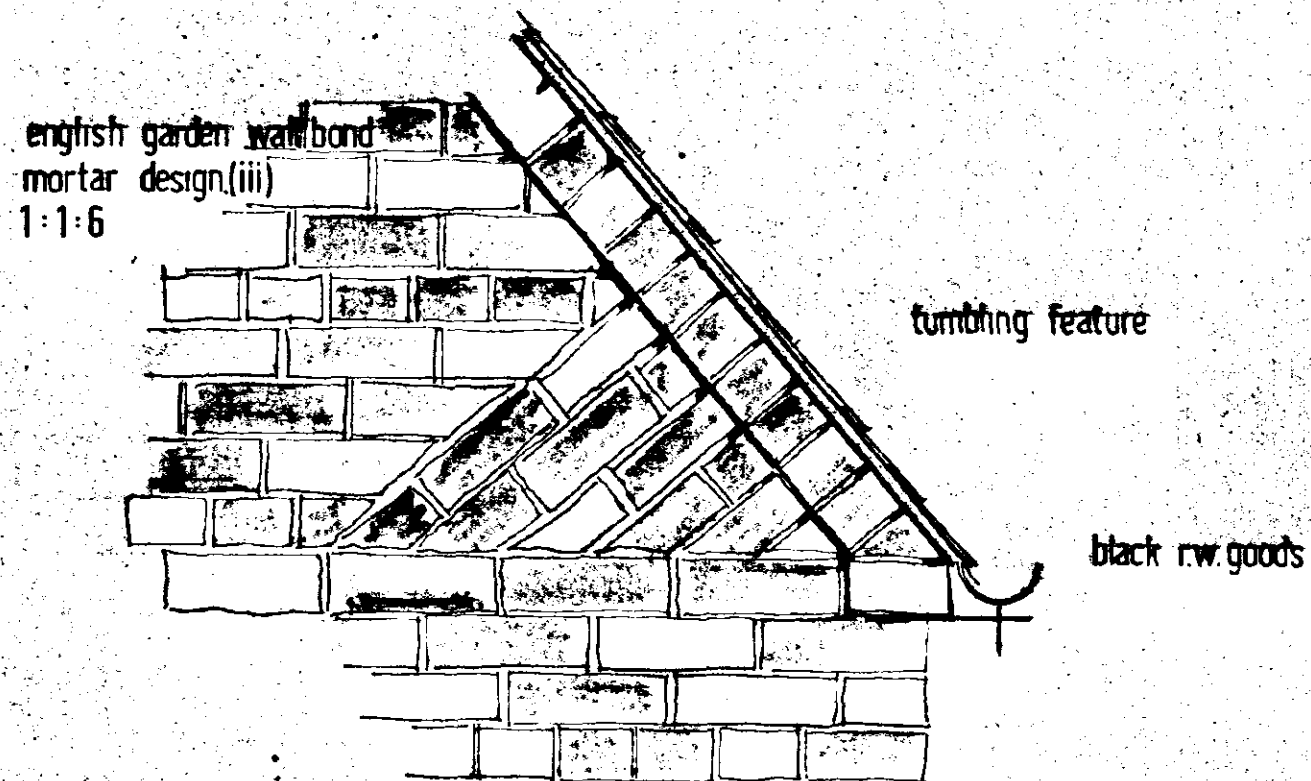

VERGE & EAVES DETAIL 1:10

LATE OBS. Offr..... Dsg.....
Salient points highlighted

H13/1175/98 DG
Recd 29 Jan 99

Moulton Design

Planning & Architecture

63 East Cob Gate, Moulton, Lincolnshire PE12 6QJ
Tel / Fax 01406 370081 Principal: Alan J. Finch


PROPOSED GARAGING / GARDEN STORE
HARRINGTON HOUSE
BROAD LANE MOULTON
for MR. & MRS. C. D. MOORE

DETAILS

1:5 1:10 1:20


NOV. 1998

980502/04

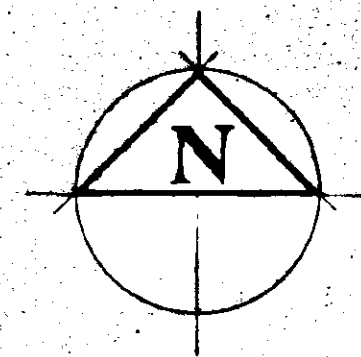


MOULTON

application site

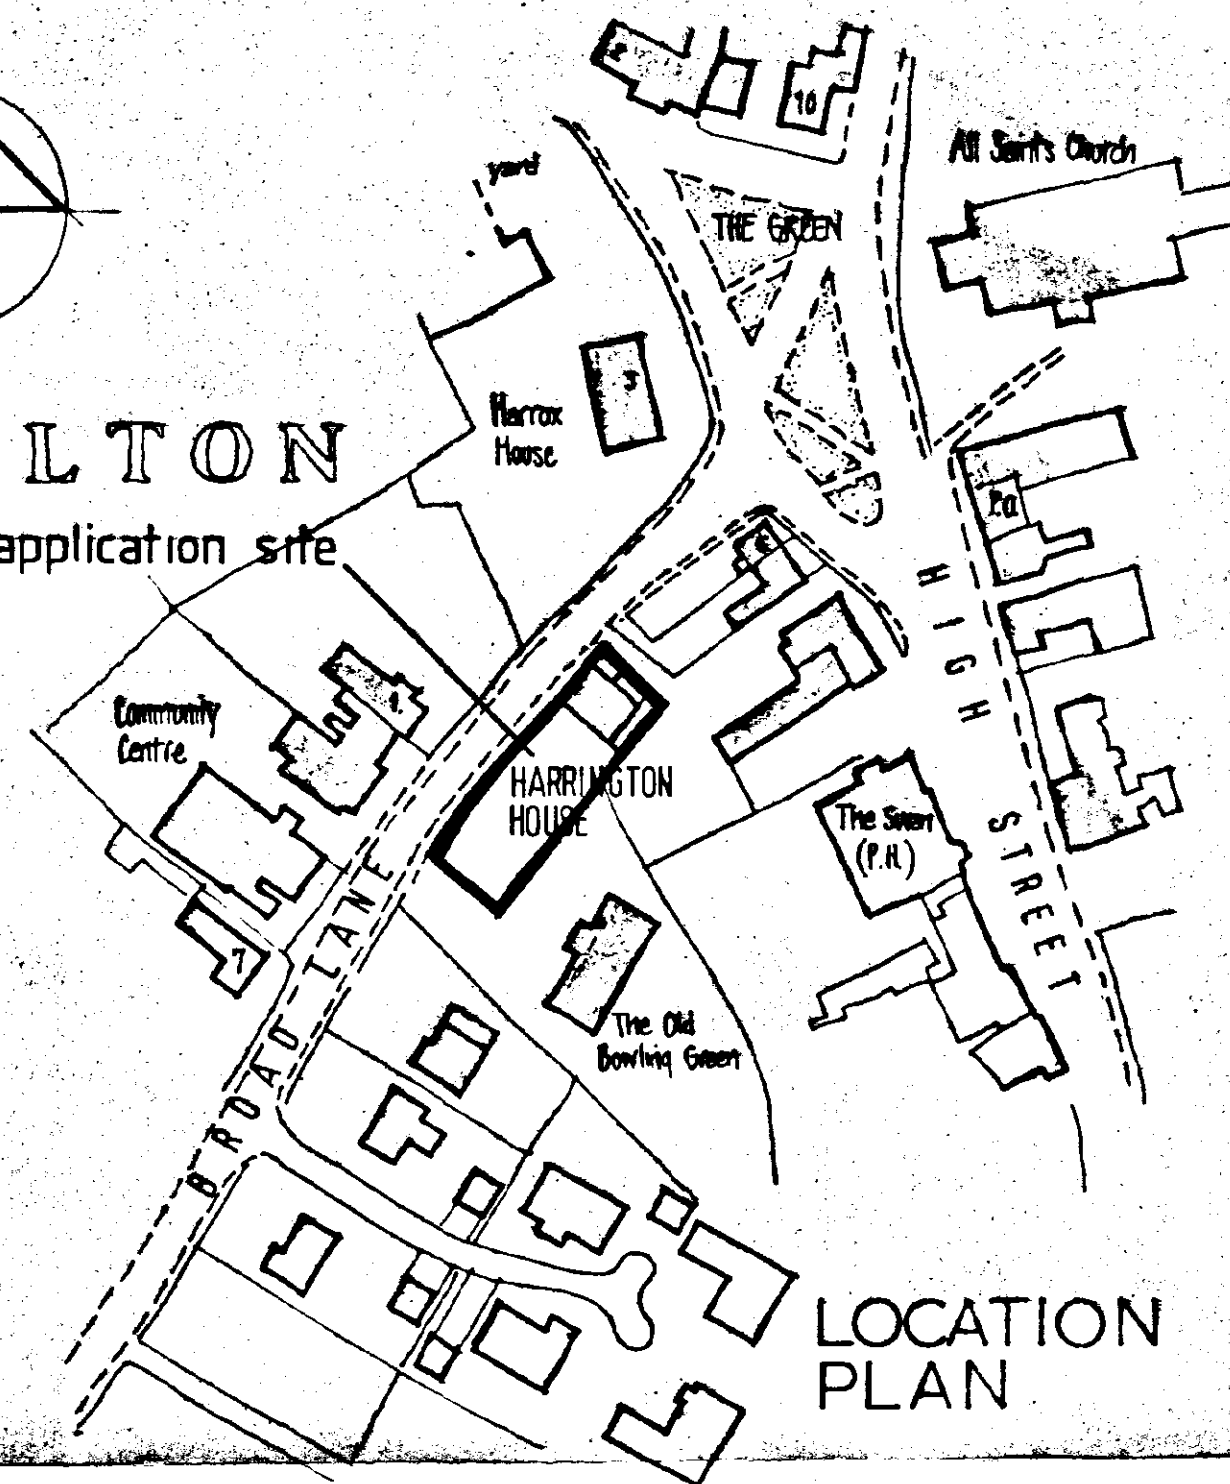

LOCATION
PLAN

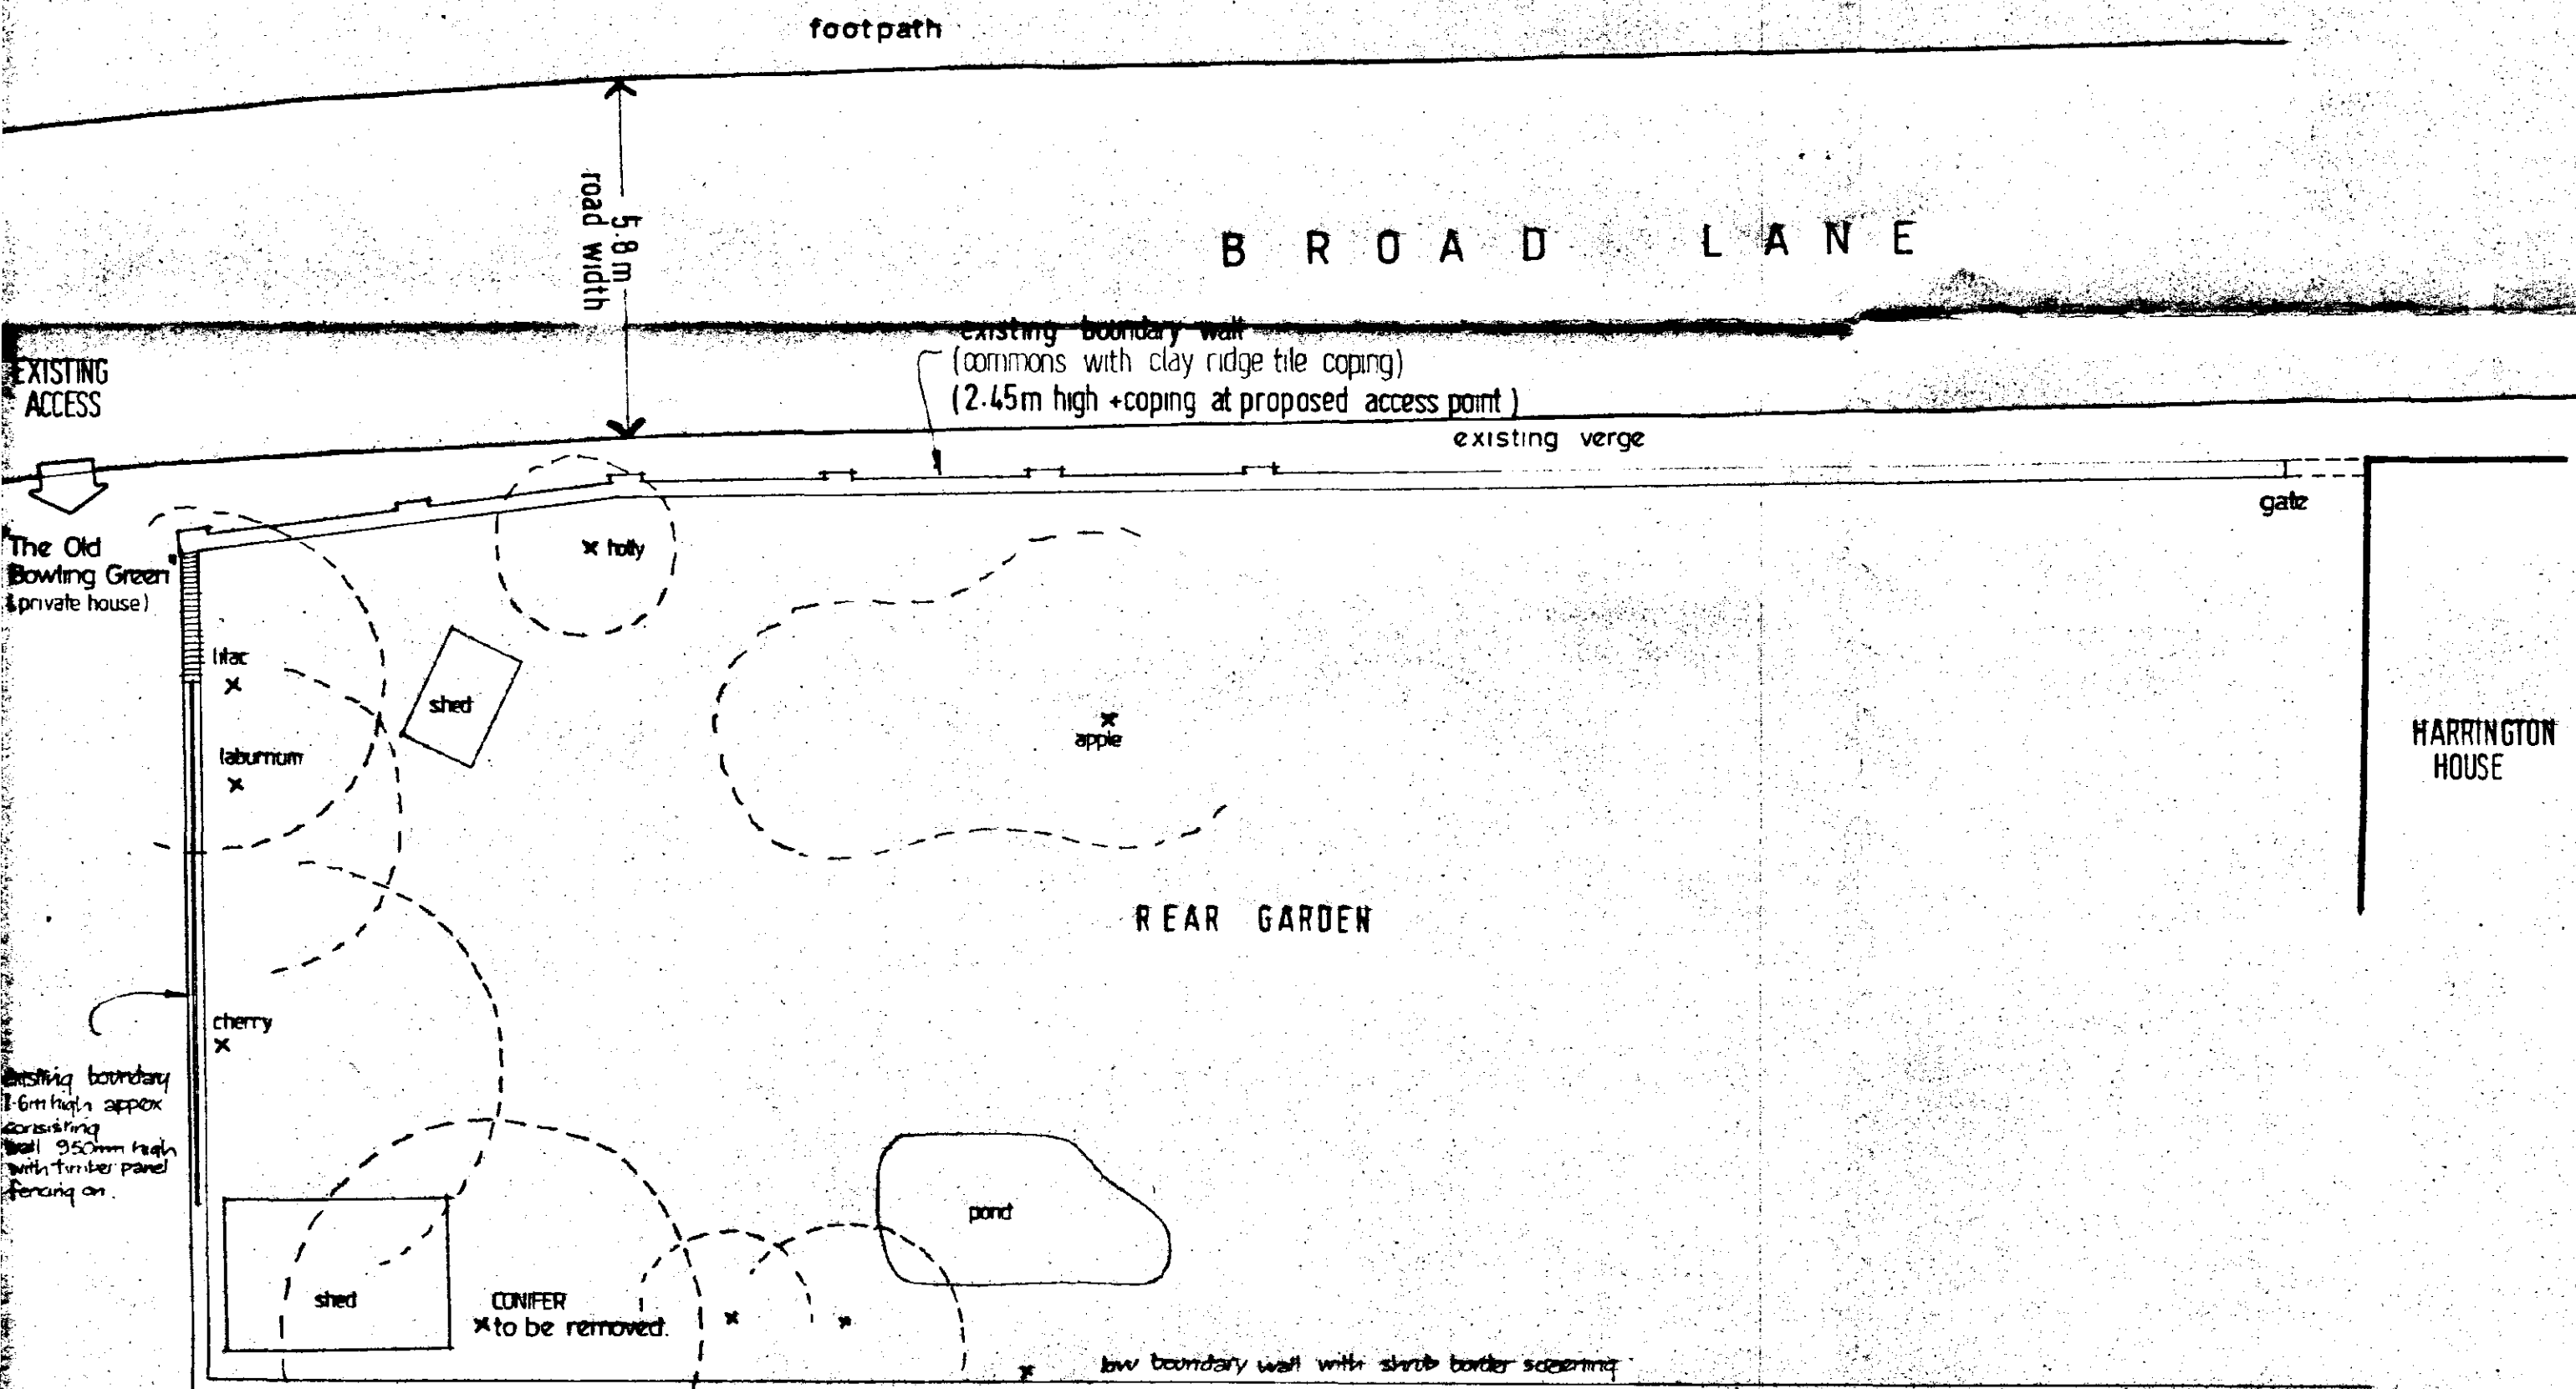

SITE LAYOUT AS EXISTING

Moulton Design Planning & Architecture

63 East Cob Gate, Moulton, Lincolnshire PE12 6QJ
Tel / Fax 01406 370081 Principal: Alan J. Finch

PROPOSED GARAGING & GARDEN STORE
HARRINGTON HOUSE
BROAD LANE MOULTON
for Mr & Mrs C. D. MOORE

LOCATION PLAN
SITE LAYOUT AS EXISTING

SOUTH HOLLAND DC
HOUSING & PLANNING

26 NOV 1998

Ref: 1173/98

1:1250 1:100
NOV. 1998

980502 / 01