

NOTES :

AMENDMENTS SHOWN IN RED

FINISHES

ROOF

Profiled sheet cladding
insulated steel plastisol coated
colour - Meadowland (BS12B17)

Eaves and gutter trim
colour - Heritage Green (RAL 6002)

WALLS

Profiled sheet cladding
insulated steel plastisol coated
colour - Meadowland (BS12B17)


Insulated panel walls; outer face
plastisol coated,

colour - Meadowland (BS12B17)


Exposed steel columns; painted colour - Heritage Green (RAL 6002)

Eaves and gutter trim
colour - Heritage Green (RAL 6002)


NORTH ELEVATION

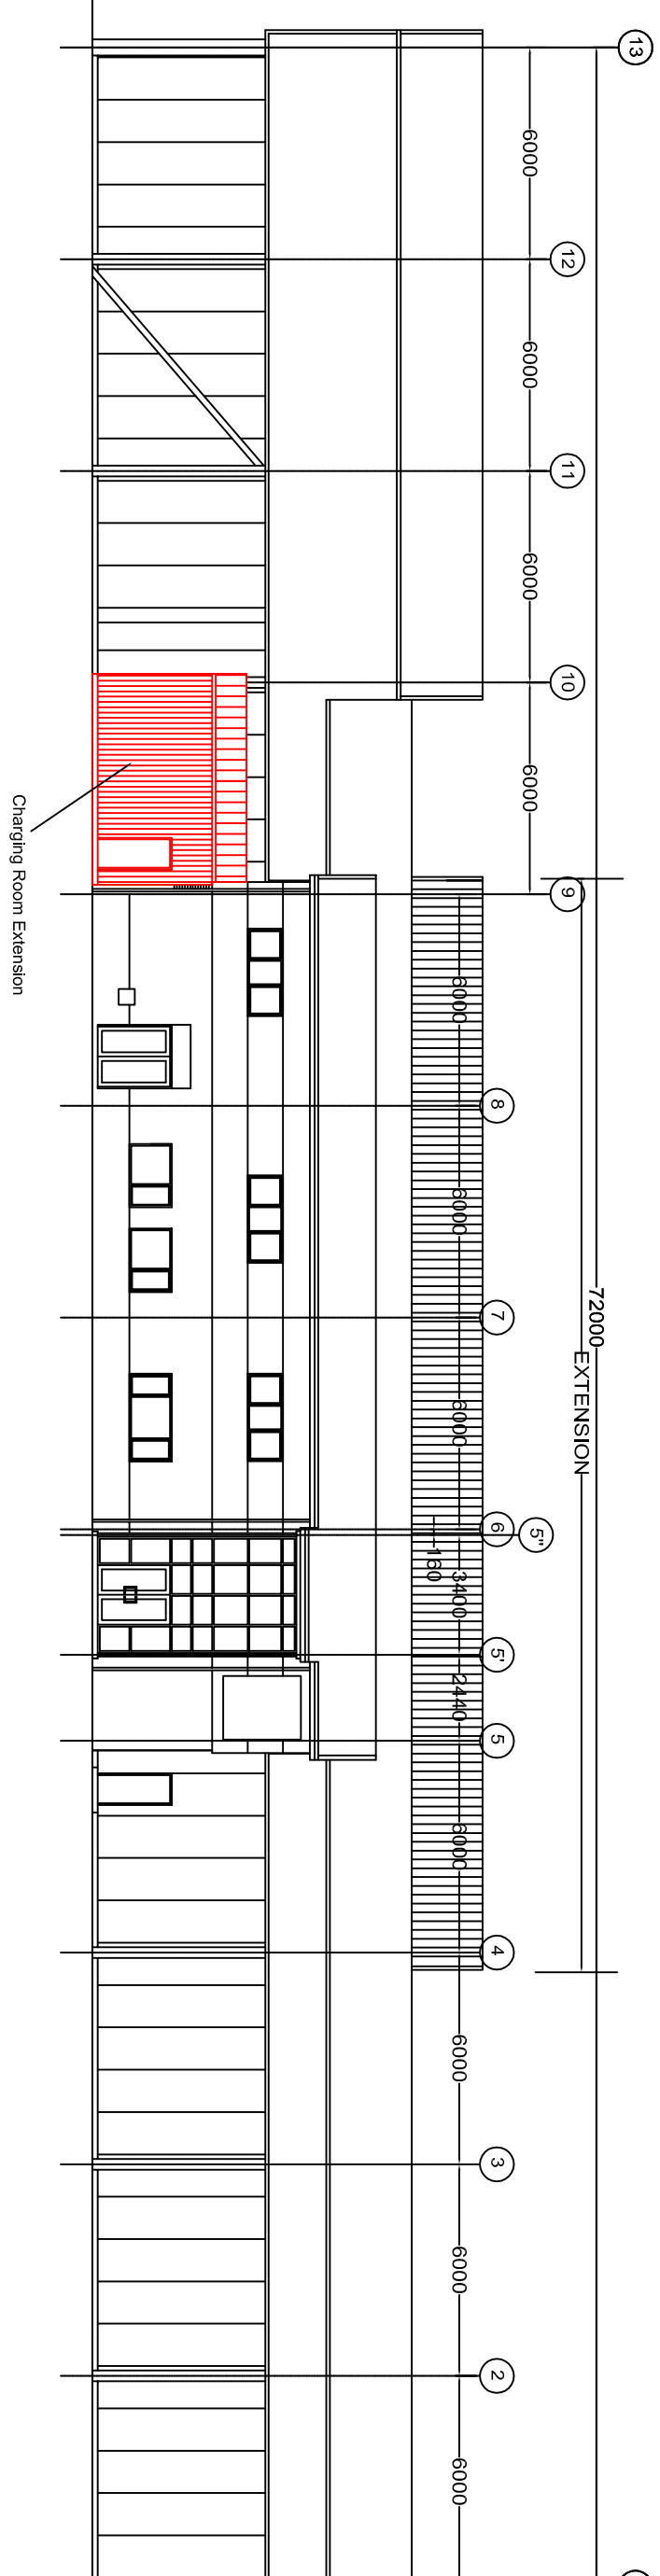


EAST ELEVATION

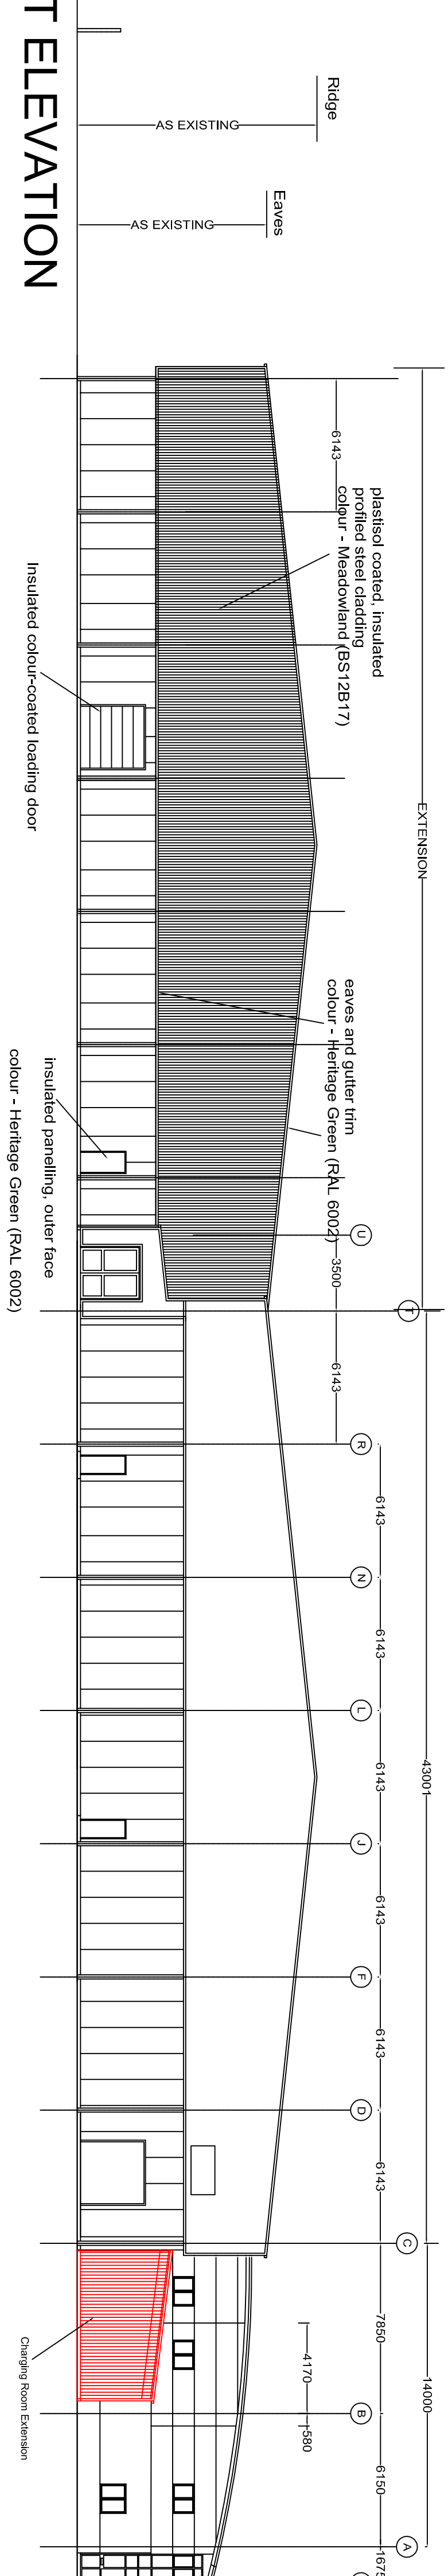

SOUTH ELEVATION

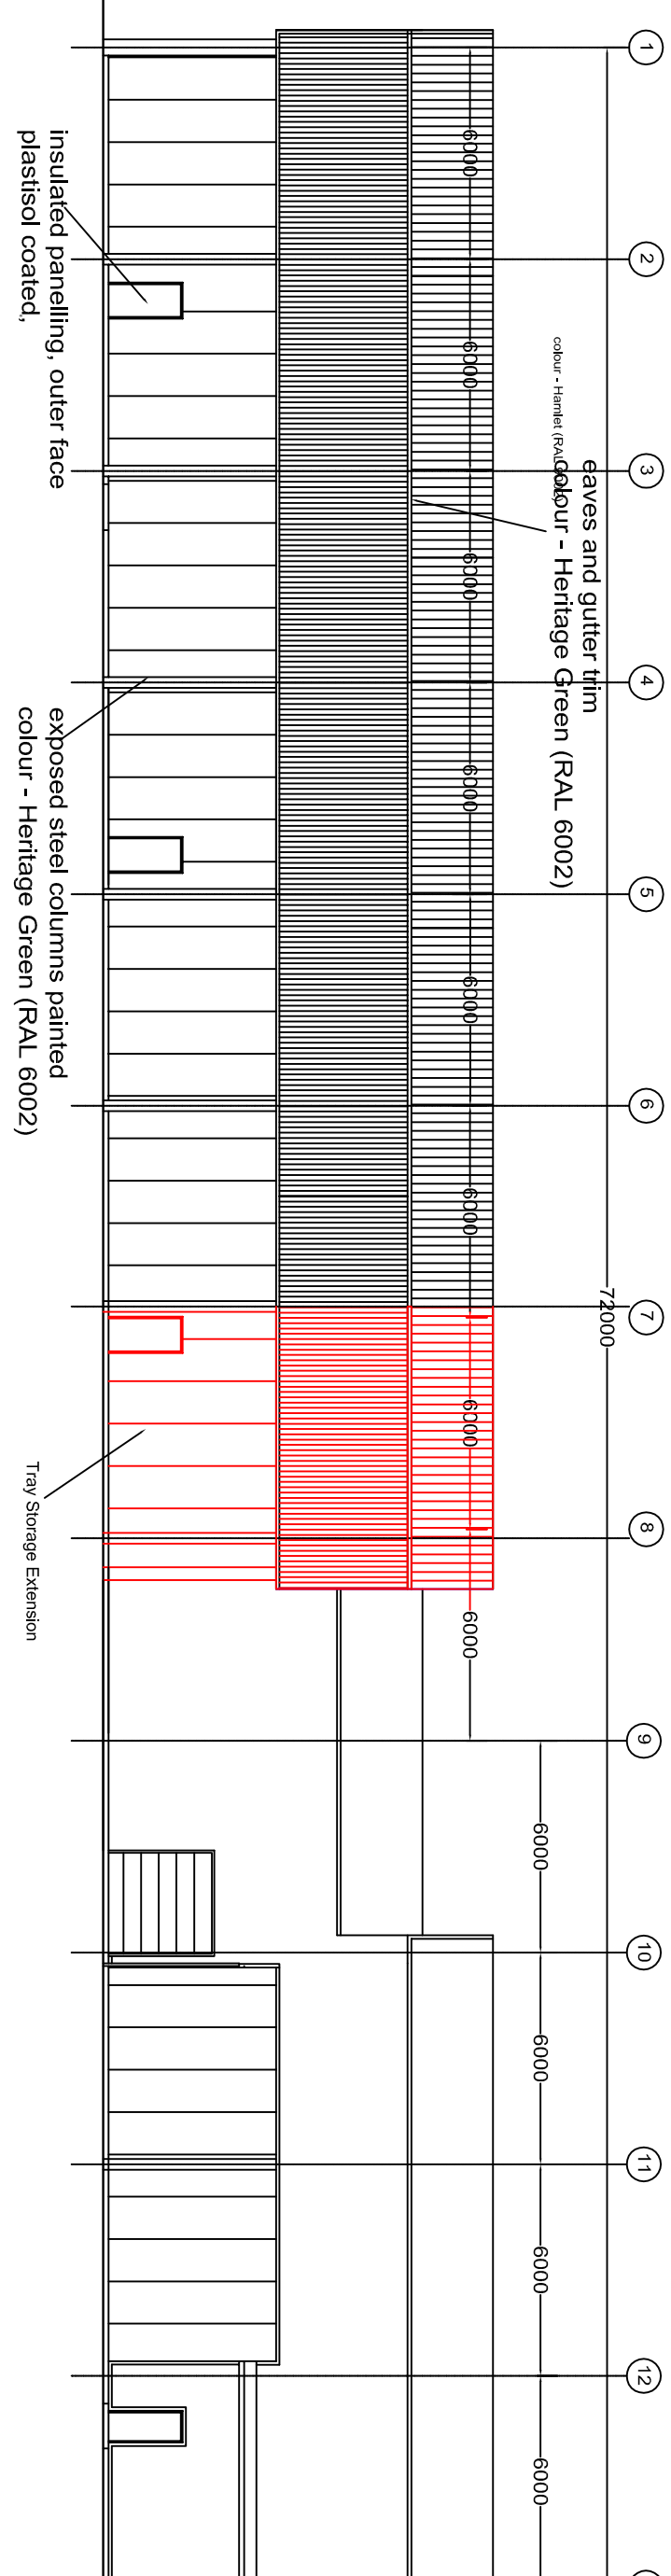

WEST ELEVATION

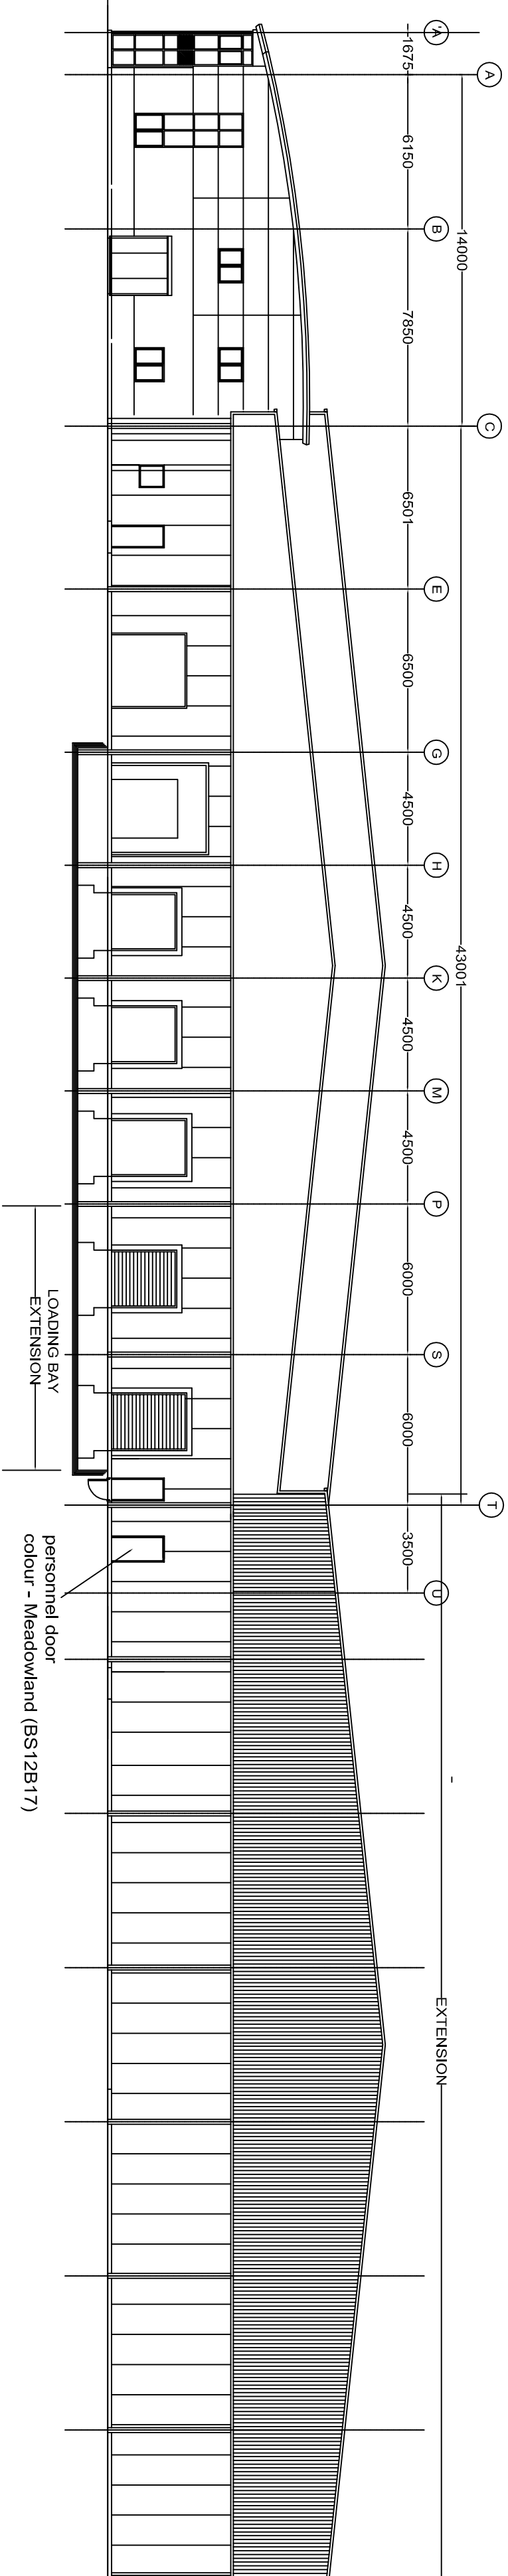[illegible]

PROJECT : 15-63 Worldfresh Extension, Spalding	
DRAWING : Proposed Elevations	
SCALE : 1/3200 @ A1	CLIENT : Total Fresh
NK Ref No. : 15-649-05	DATE : February 2016
DRAWN BY : NK	CHECKED BY : NK

WSA

Wayne Storey Associates Ltd.

CHARTERED BUILDING SURVEYORS

PROJECT MANAGERS
CDM CO-ORDINATORS

46 Strand Avenue

Hollywood, Co Down

BT18 9AW
Tel 028 90422211

Fax 028 90427711

E-mail info@wsa-ni.co.uk