


Nº 43 KNIGHT STREET • MR + MRS R. JARVIS
 • PINCHBECK • SPALDING • Lincs.

DWING NO: 217/5A
 A (omit projection + gable roof over)
 (to front elevation)

Roof Materials: Grey-blue slate
 Walls: Fine Sandtex rendering (cream)
 Windows: Contain aluminium-coated double glazed with thin oblong leaded panes.

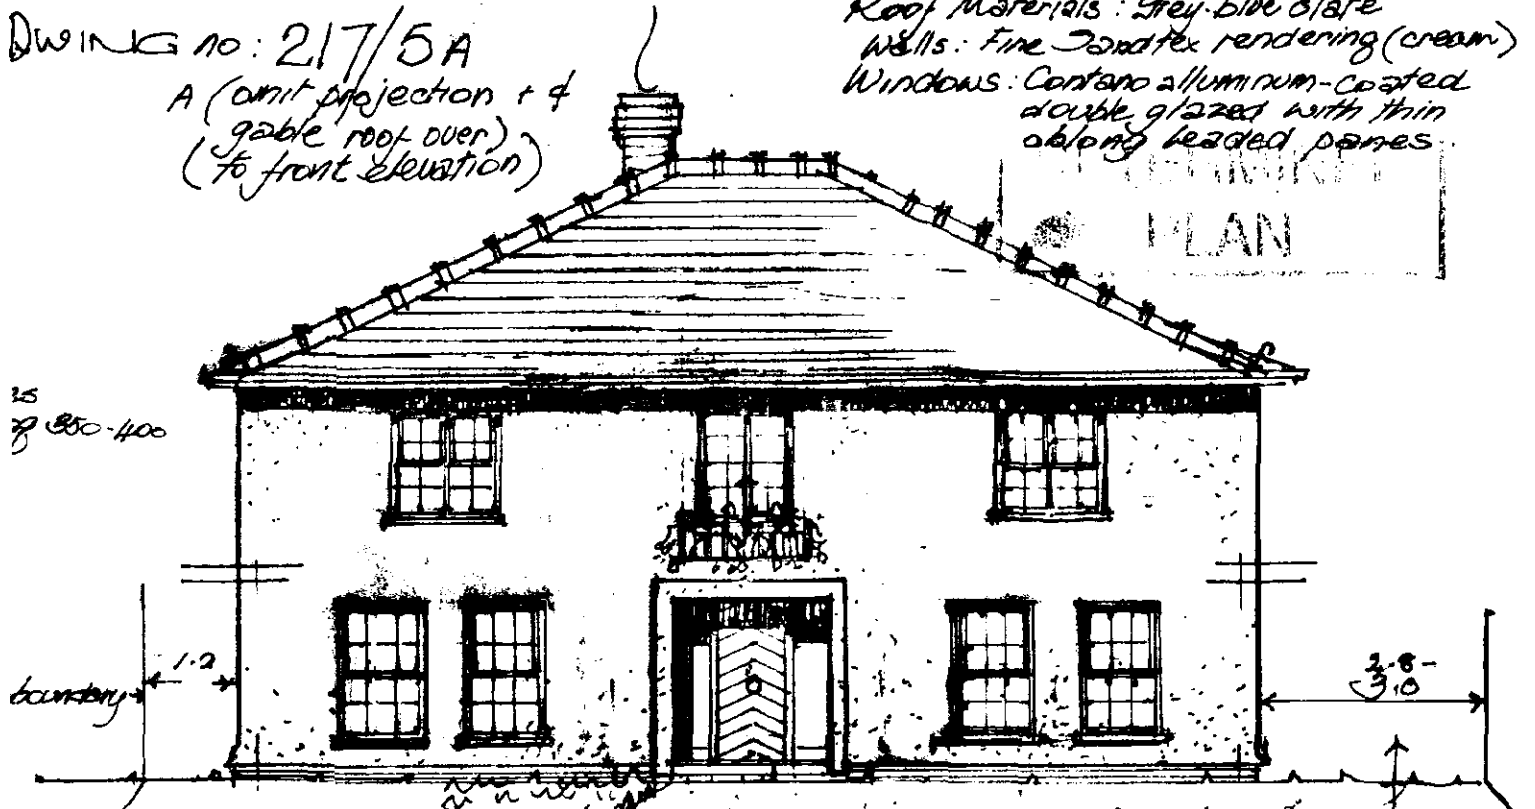

25
 of 350-400

• FRONT ELEVATION


AMENDED PLAN
 H1410805/00




25
 of 50-400mm

• REAR ELEVATION n/north-west

vertical

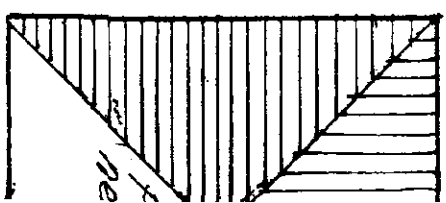

* Front Elevation only

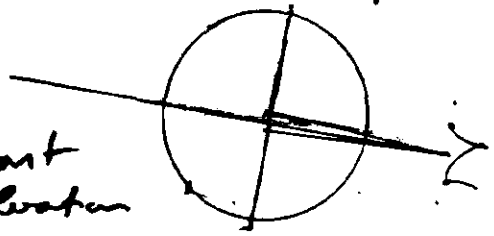

SHAW & PARTNERS
HOUSING & PLANNING
26 JUN 2000

Ref: 0805/00




Side entrance /
with stable door


SECTION THRO
hipped roof to
DAY ROOM
with exposed timber
ceiling

• FRONT ELEVATION to SOUTH •

• SIDE ELEVATION to EAST •

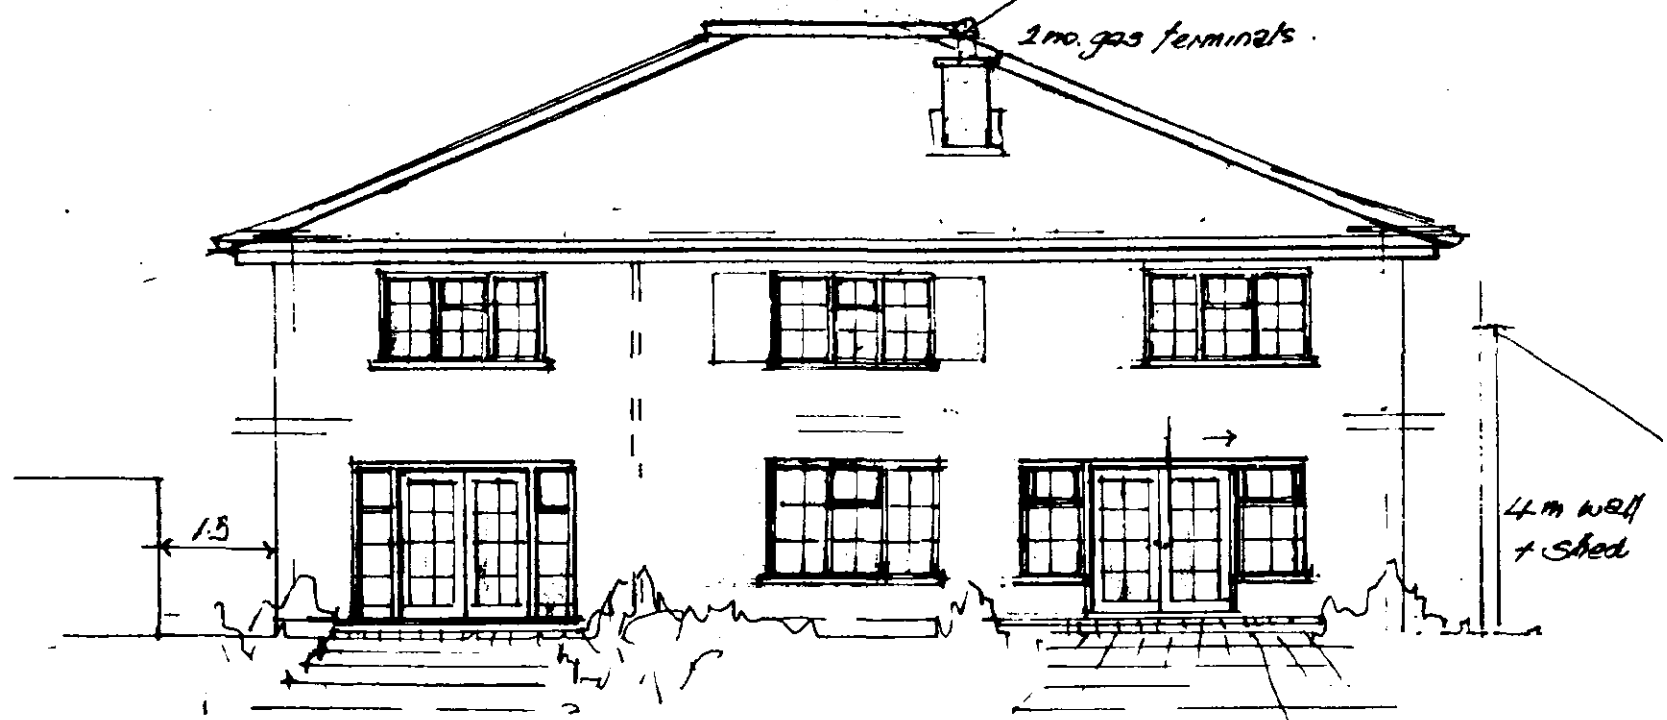

REAR ELEVATION

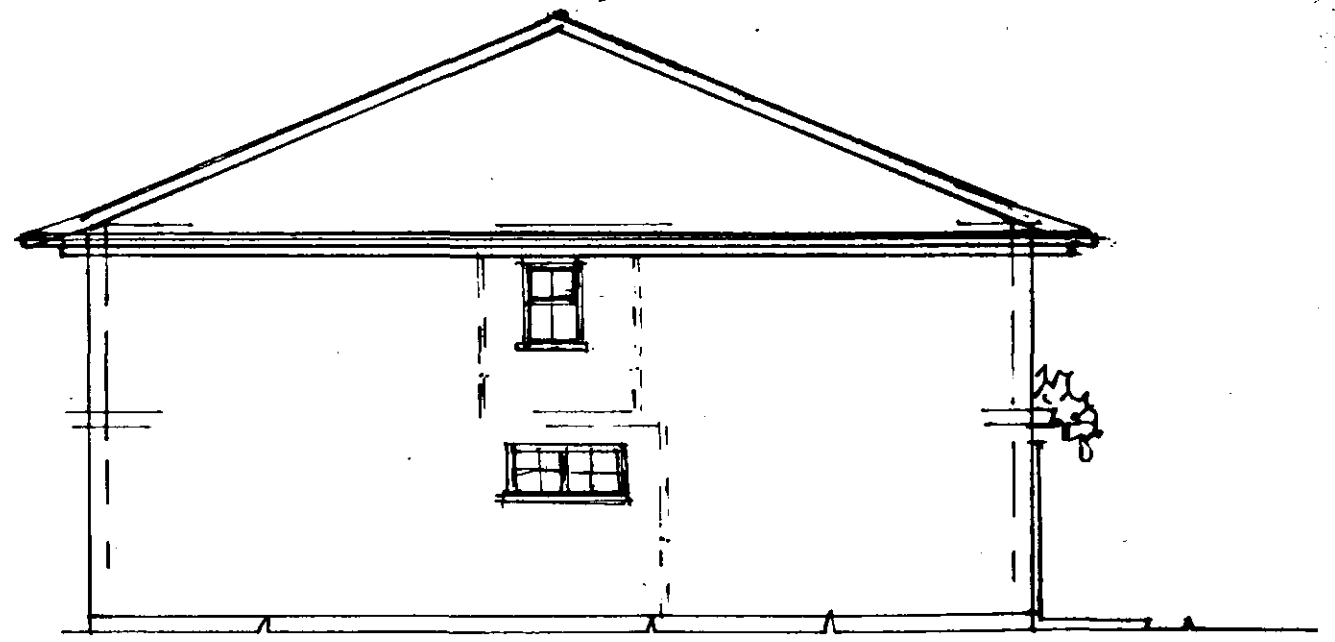


~~SUPPLEMENTARY~~ SIDE ELEVATION to West

(3RD) AMENDED...

Drawing no: 214/3 A B

Shaw & Partners
4 Victoria Street
Sydney, New South Wales
Tel: (02) 9550 1775

Retain
• ELEVATIONS.
DWELLING OF PINCHBECK
for Mr & Mrs. R. JARVIS.

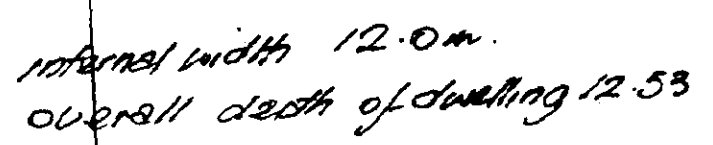

Note: Internal structural break on block walls indicated this ~~time~~

internal width 14.5mm.
overall " of drawing 15.03mm

FIRST FLOOR

SUPERSEDED

Refam

Drawing no. 3^a May 24th
June 3rd

Scale: 1:100 m

Drawing no: 244/44D

Covered
 Beds 1 + 2
 + M/Bedro
 + add WC.
 + gas flues







14-00000 LAND D
GND PLAN 113
25 JUN 2000

No 3 amended
 SITING
 Drug no: 214/4 ABC
 Scale: 1:100 mm
 Existing
 Access
 May 19 2000.
 24
 June 3rd
 C-100s fires

PROPOSED DWELLING at BROOKSIDE (Holly Cottage) 43 KNIGHT STREET - PINCHBECK - SPALDING - Lincs.
Roof Materials: Grey-blue slate

Scales: 1:100 and 1:200mm. PLANS, ELEVATIONS & BLOCK PLAN. amended design Sept 26 2000. Drawing no: 217/5

Roof Materials: Grey-blue slate
Walls: Fine sand-text rendering (cream)
Windows: Corroboralum-coated
double glazed with thin
oblong leaded panes.

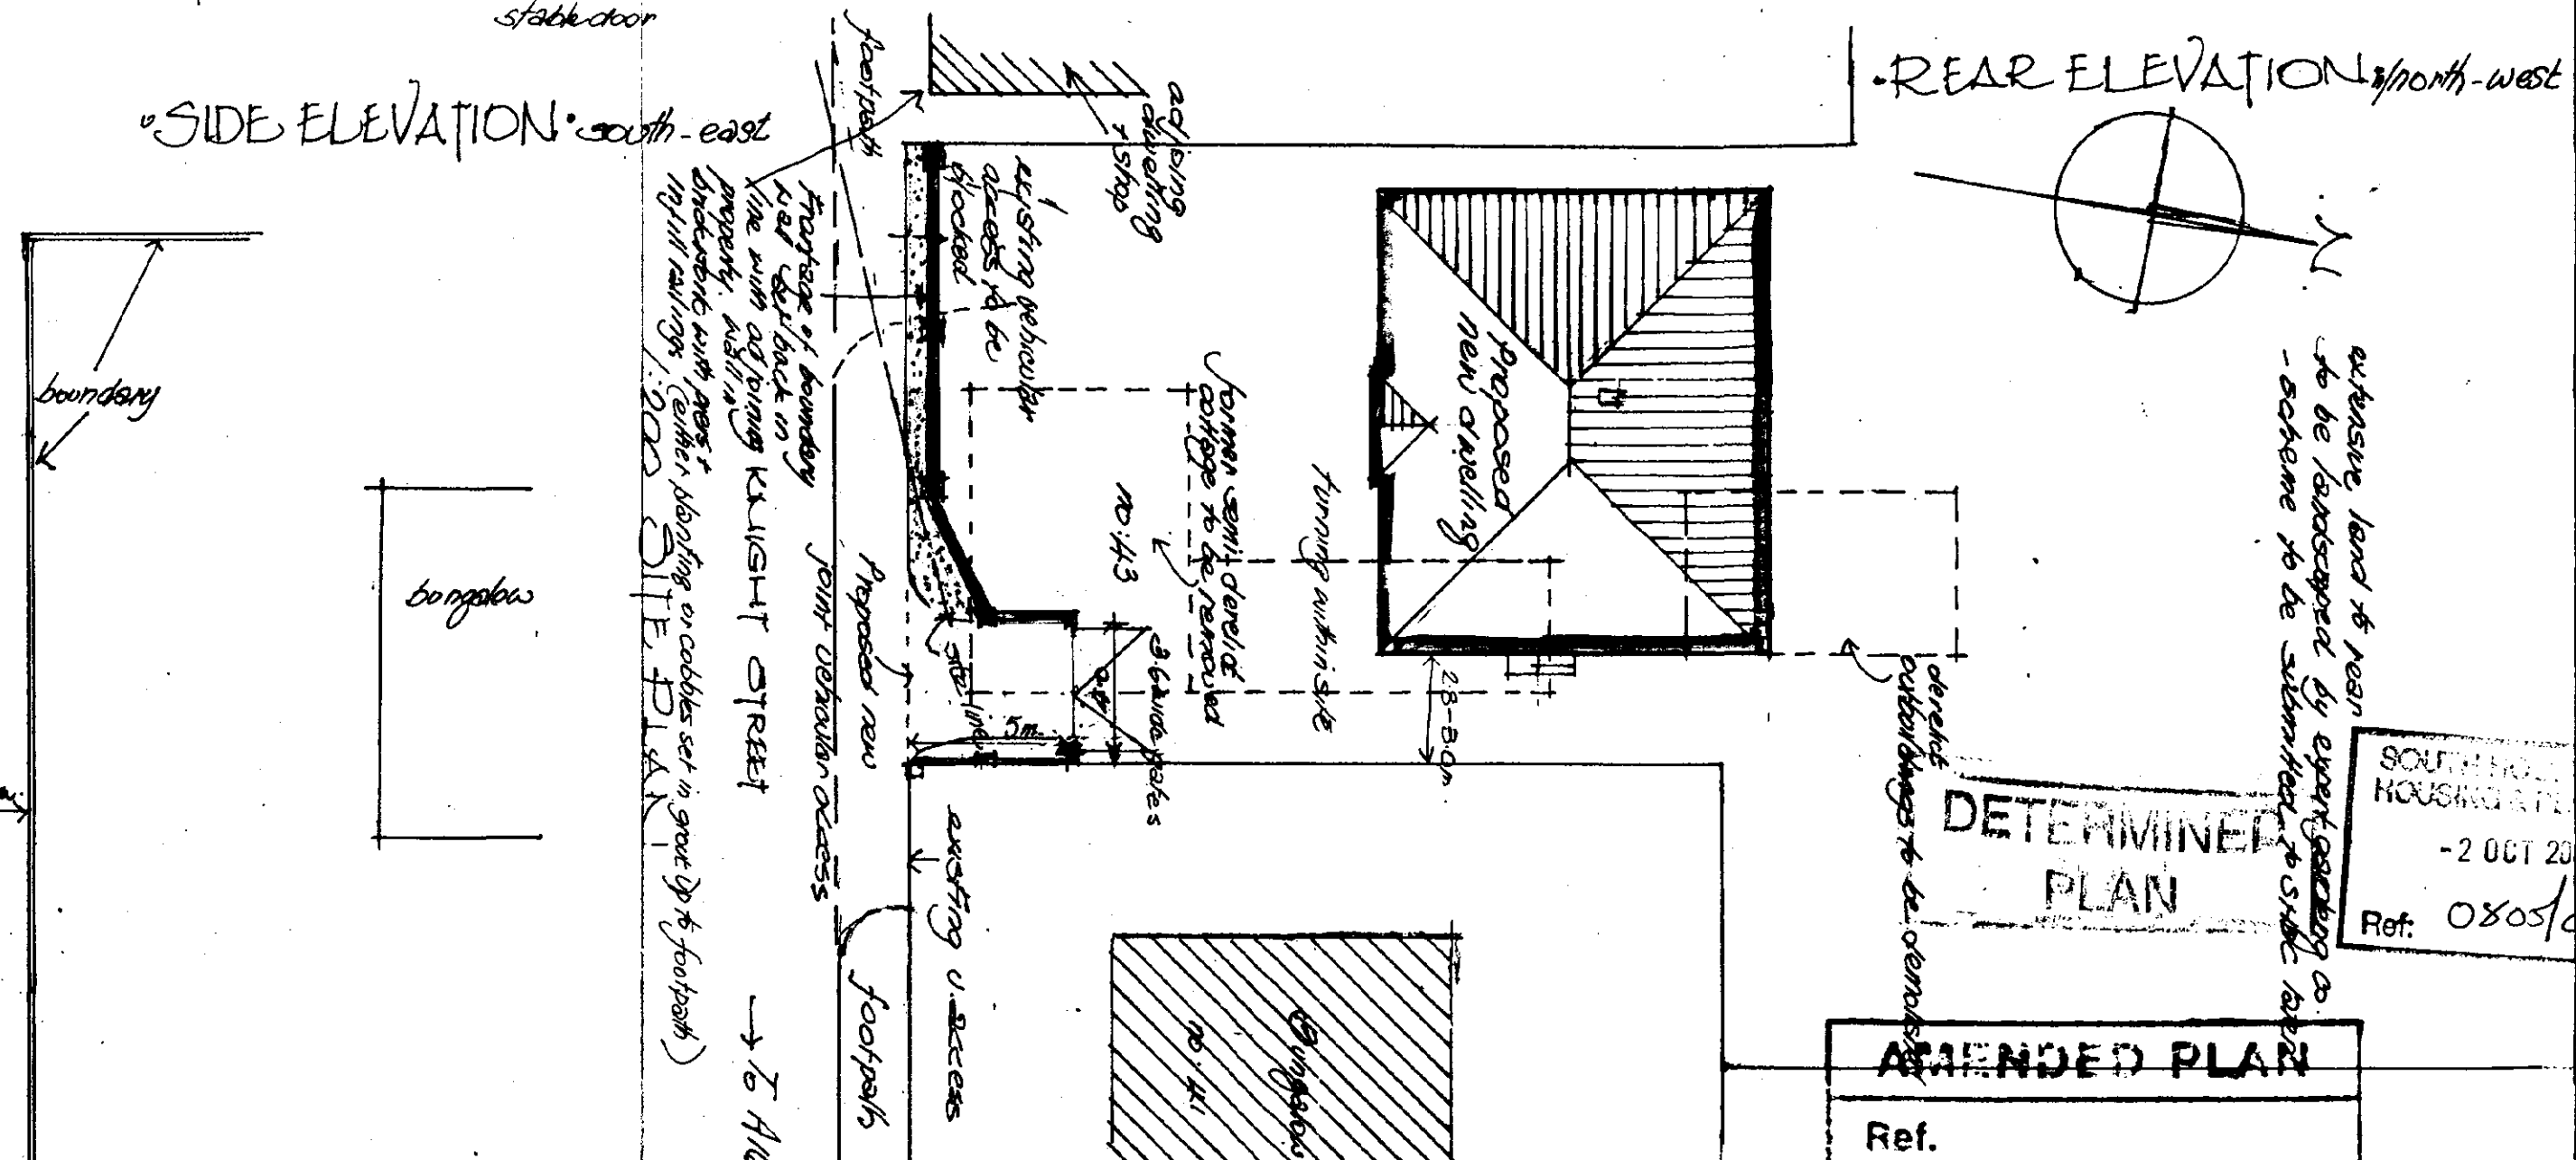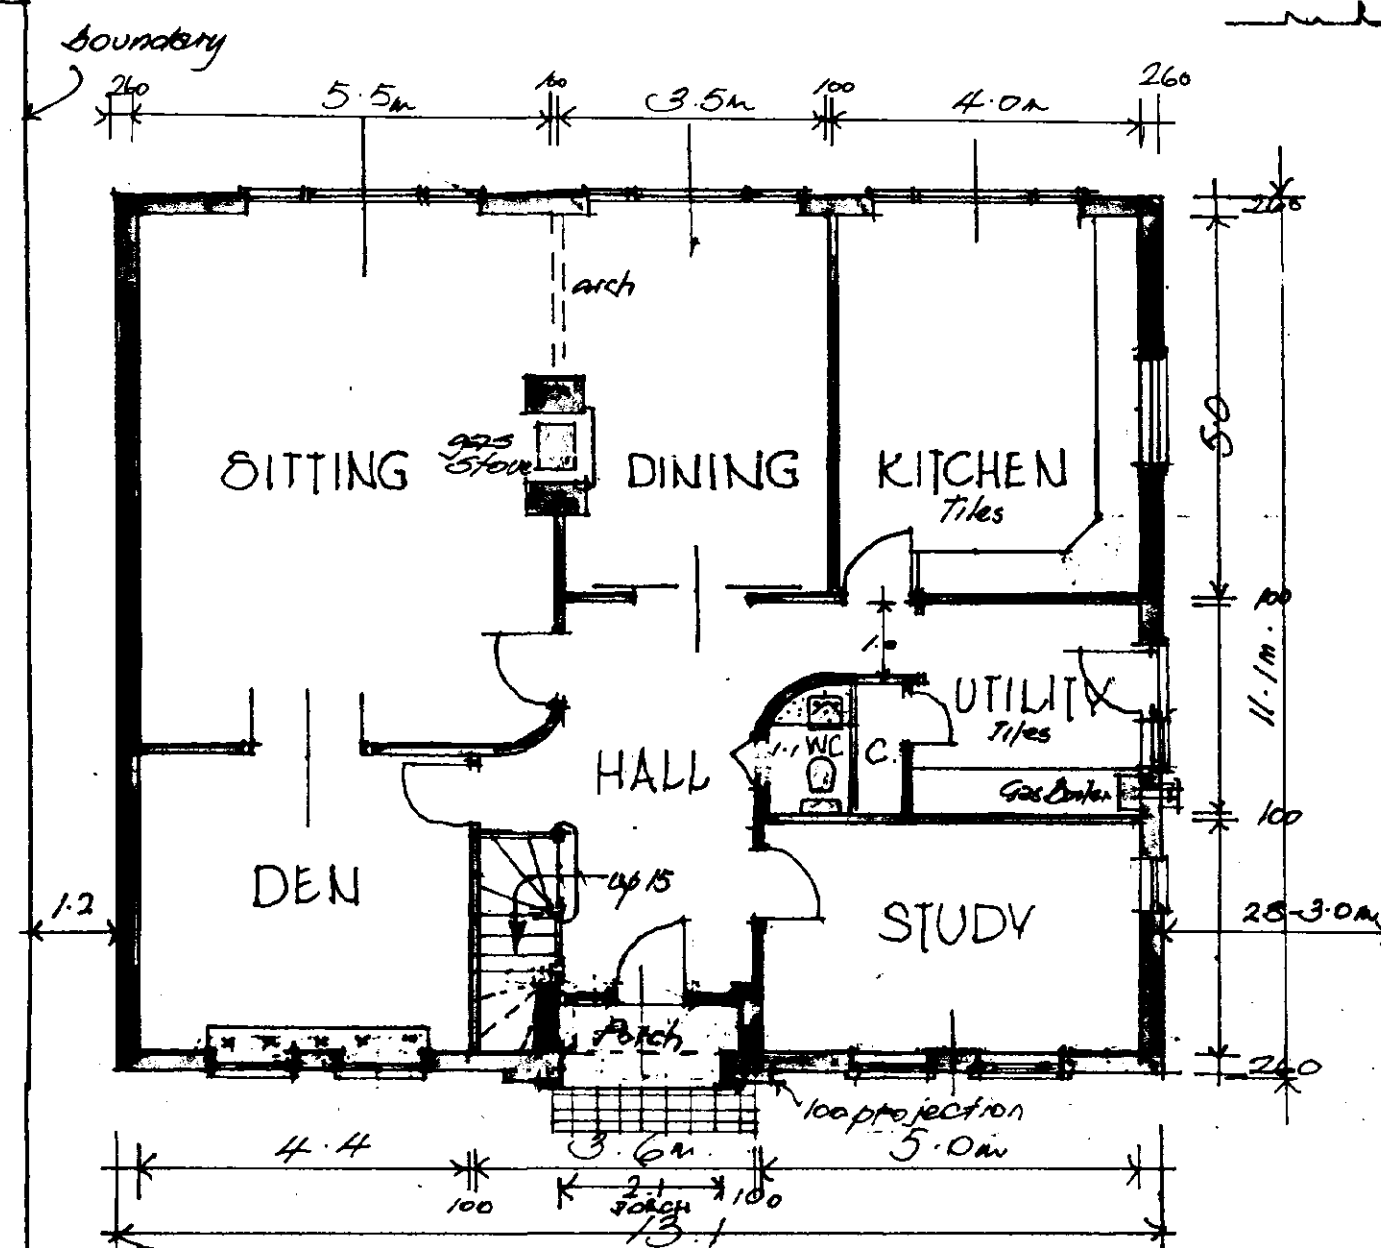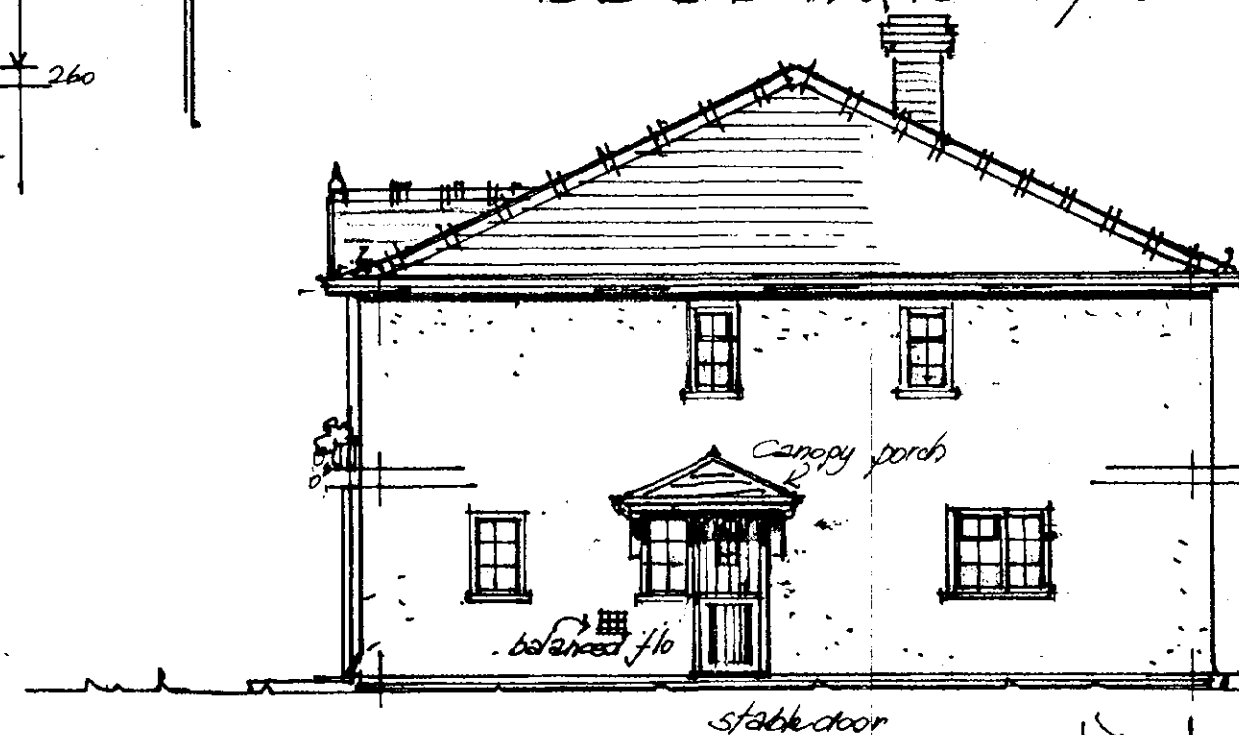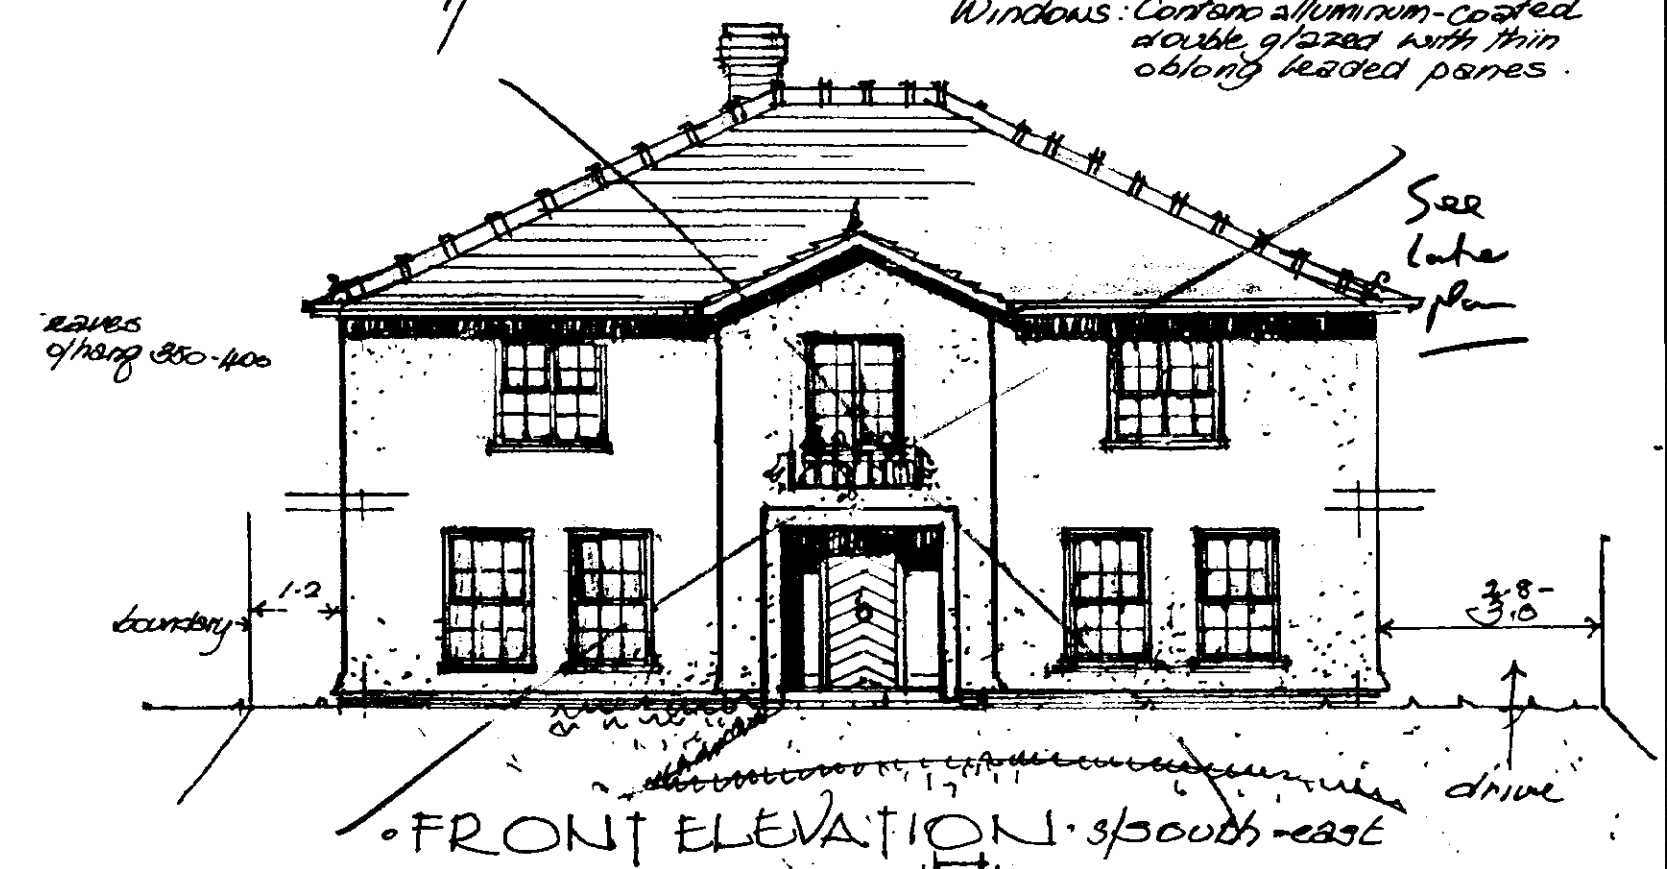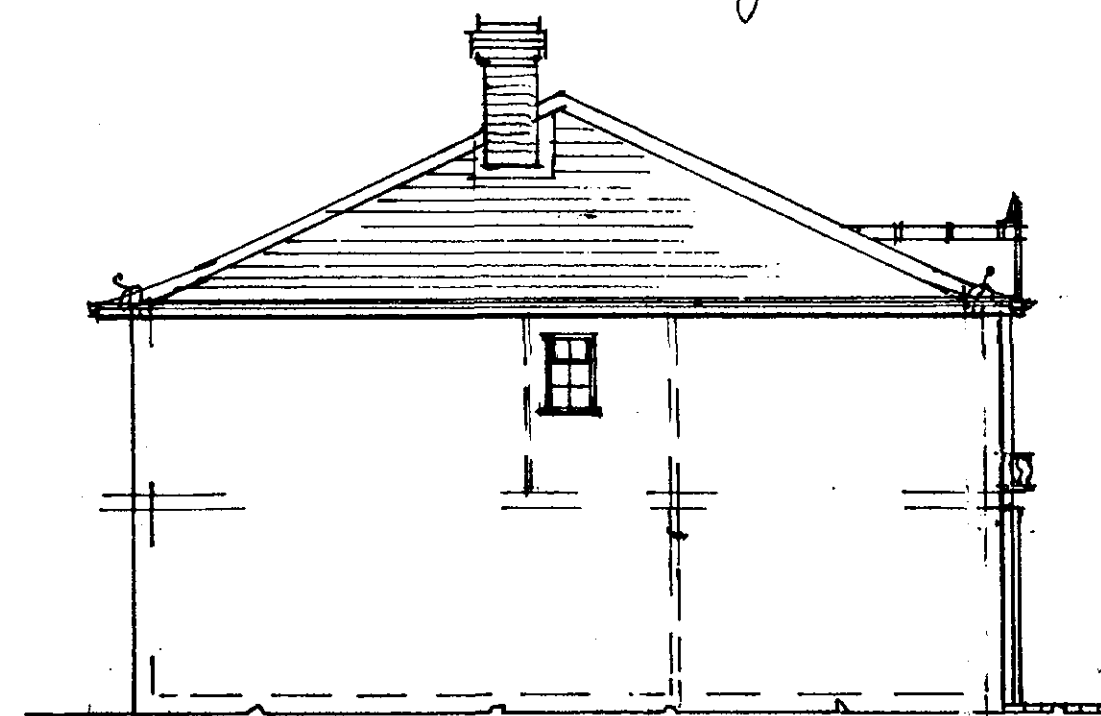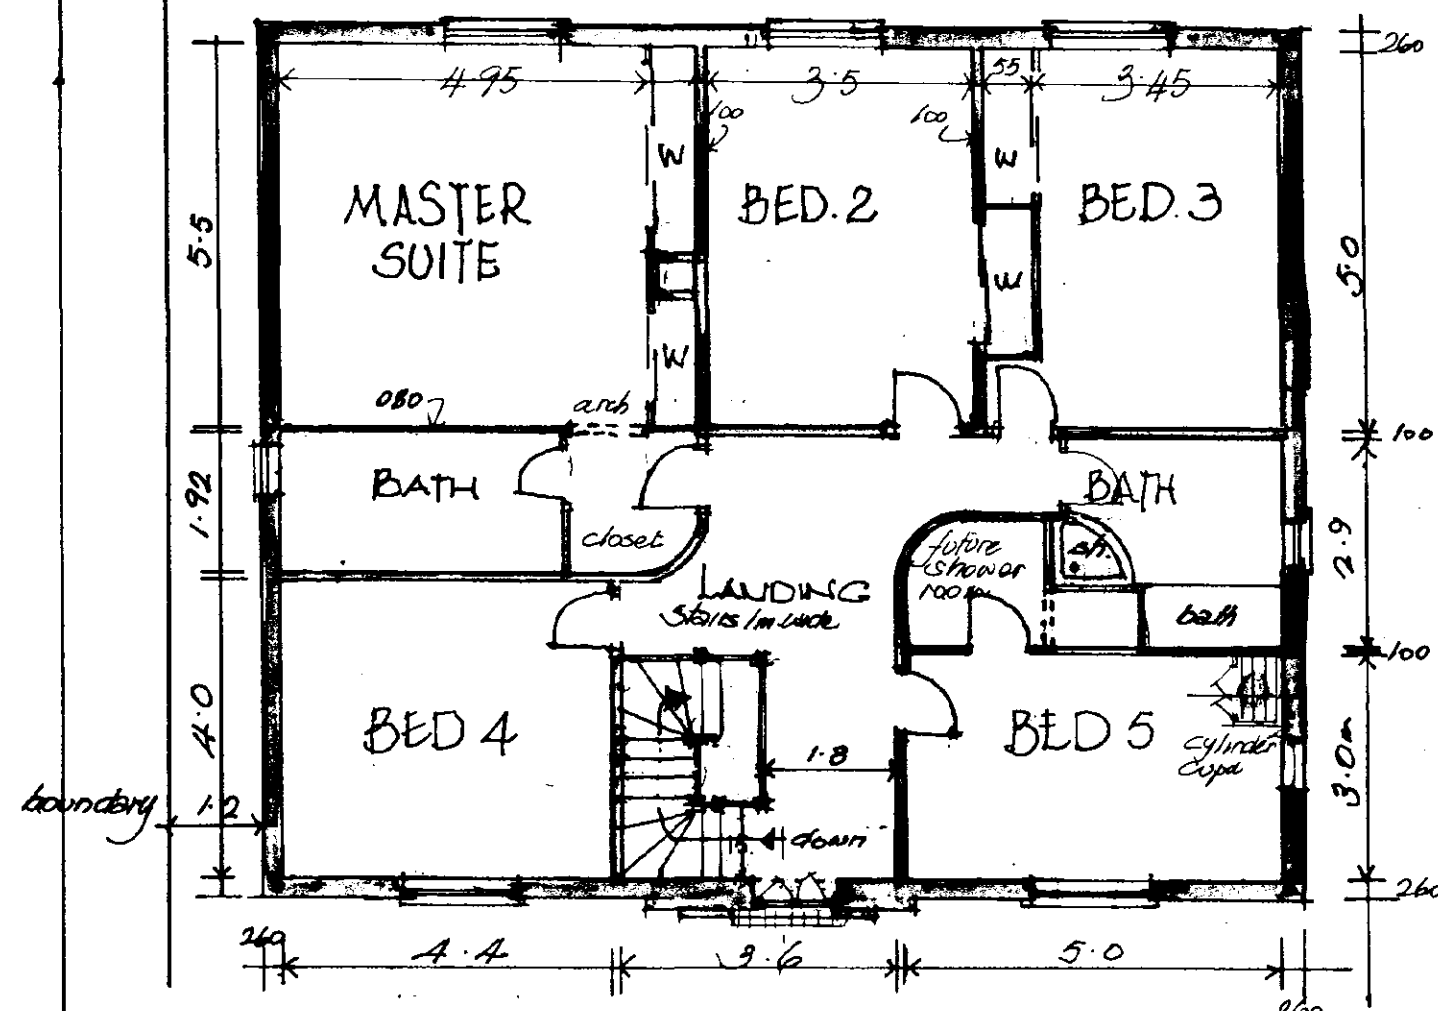

**DETERMINED
PLAN**

ATTENDED PLAN

Ref.

SOUTH HOUSING & PLANNING

- 2 OCT 2000

Ref: 0805/06