



- Notes
1. All dimensions must be checked on site by the Contractor.
 2. Written dimensions to take precedence over scaled dimensions.
 3. Drawings to be used in conjunction with specification and any Structural Engineers and/or manufacturers written information

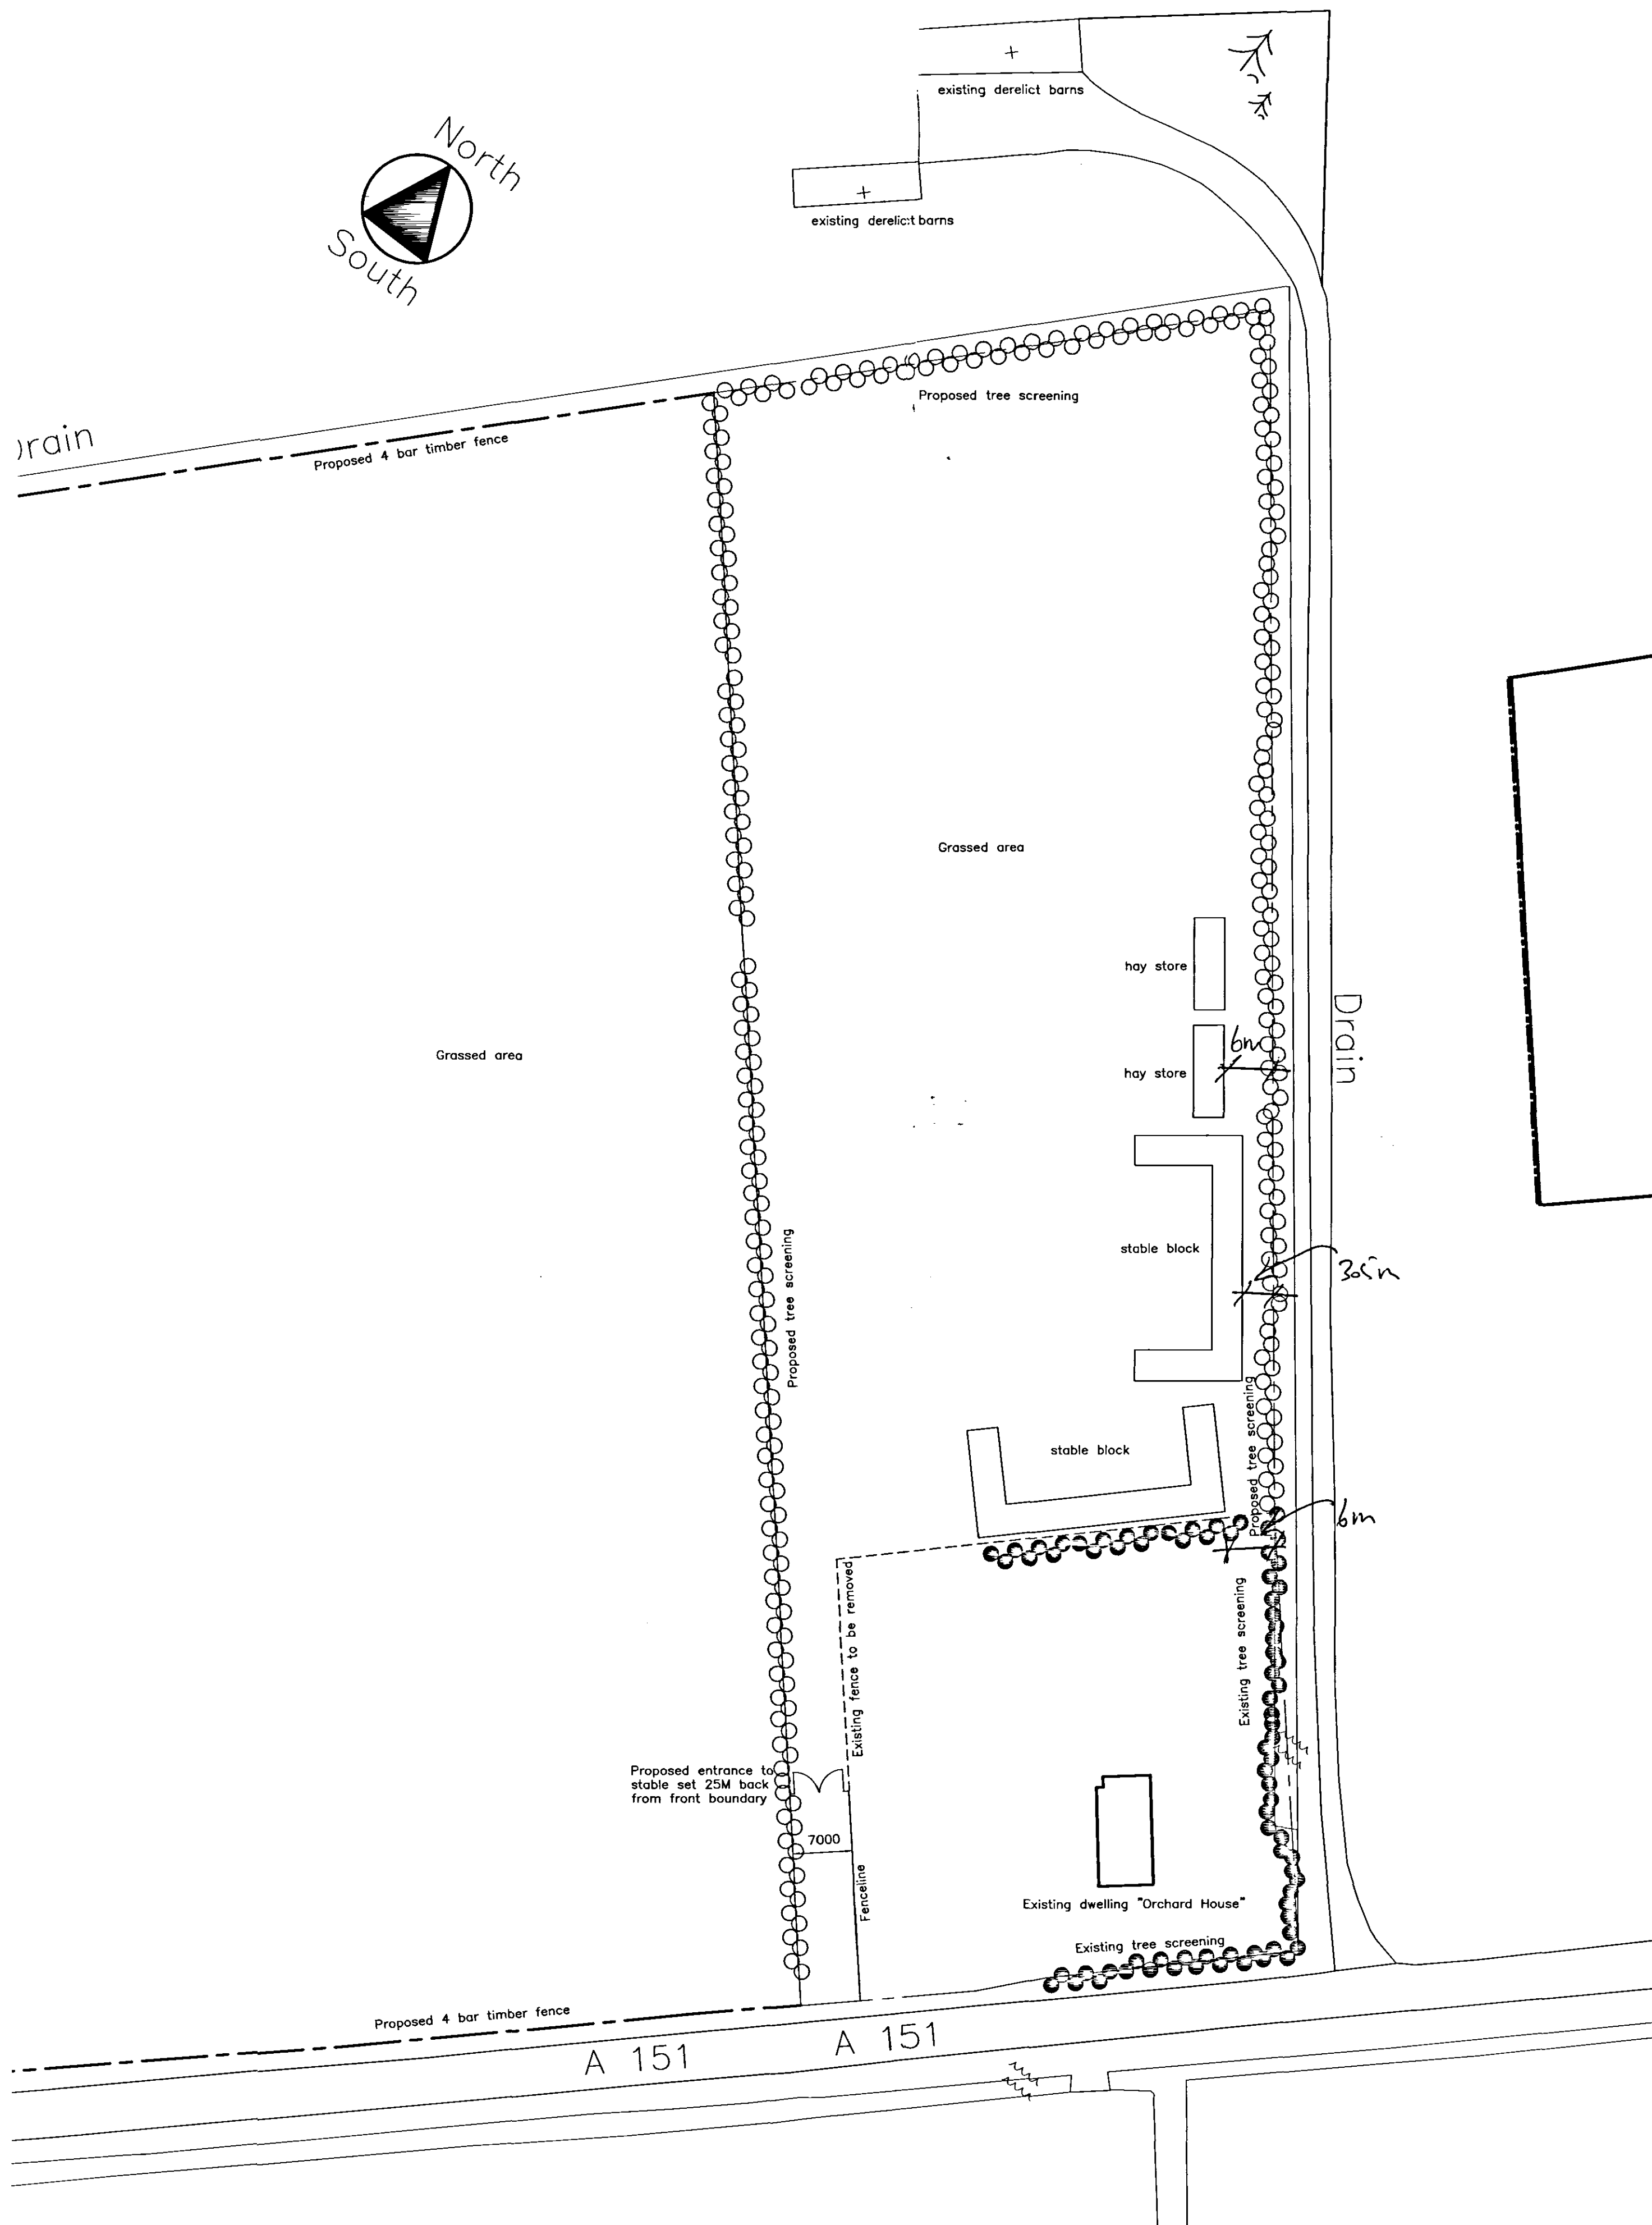

PART SITE PLAN
SCALE 1:500

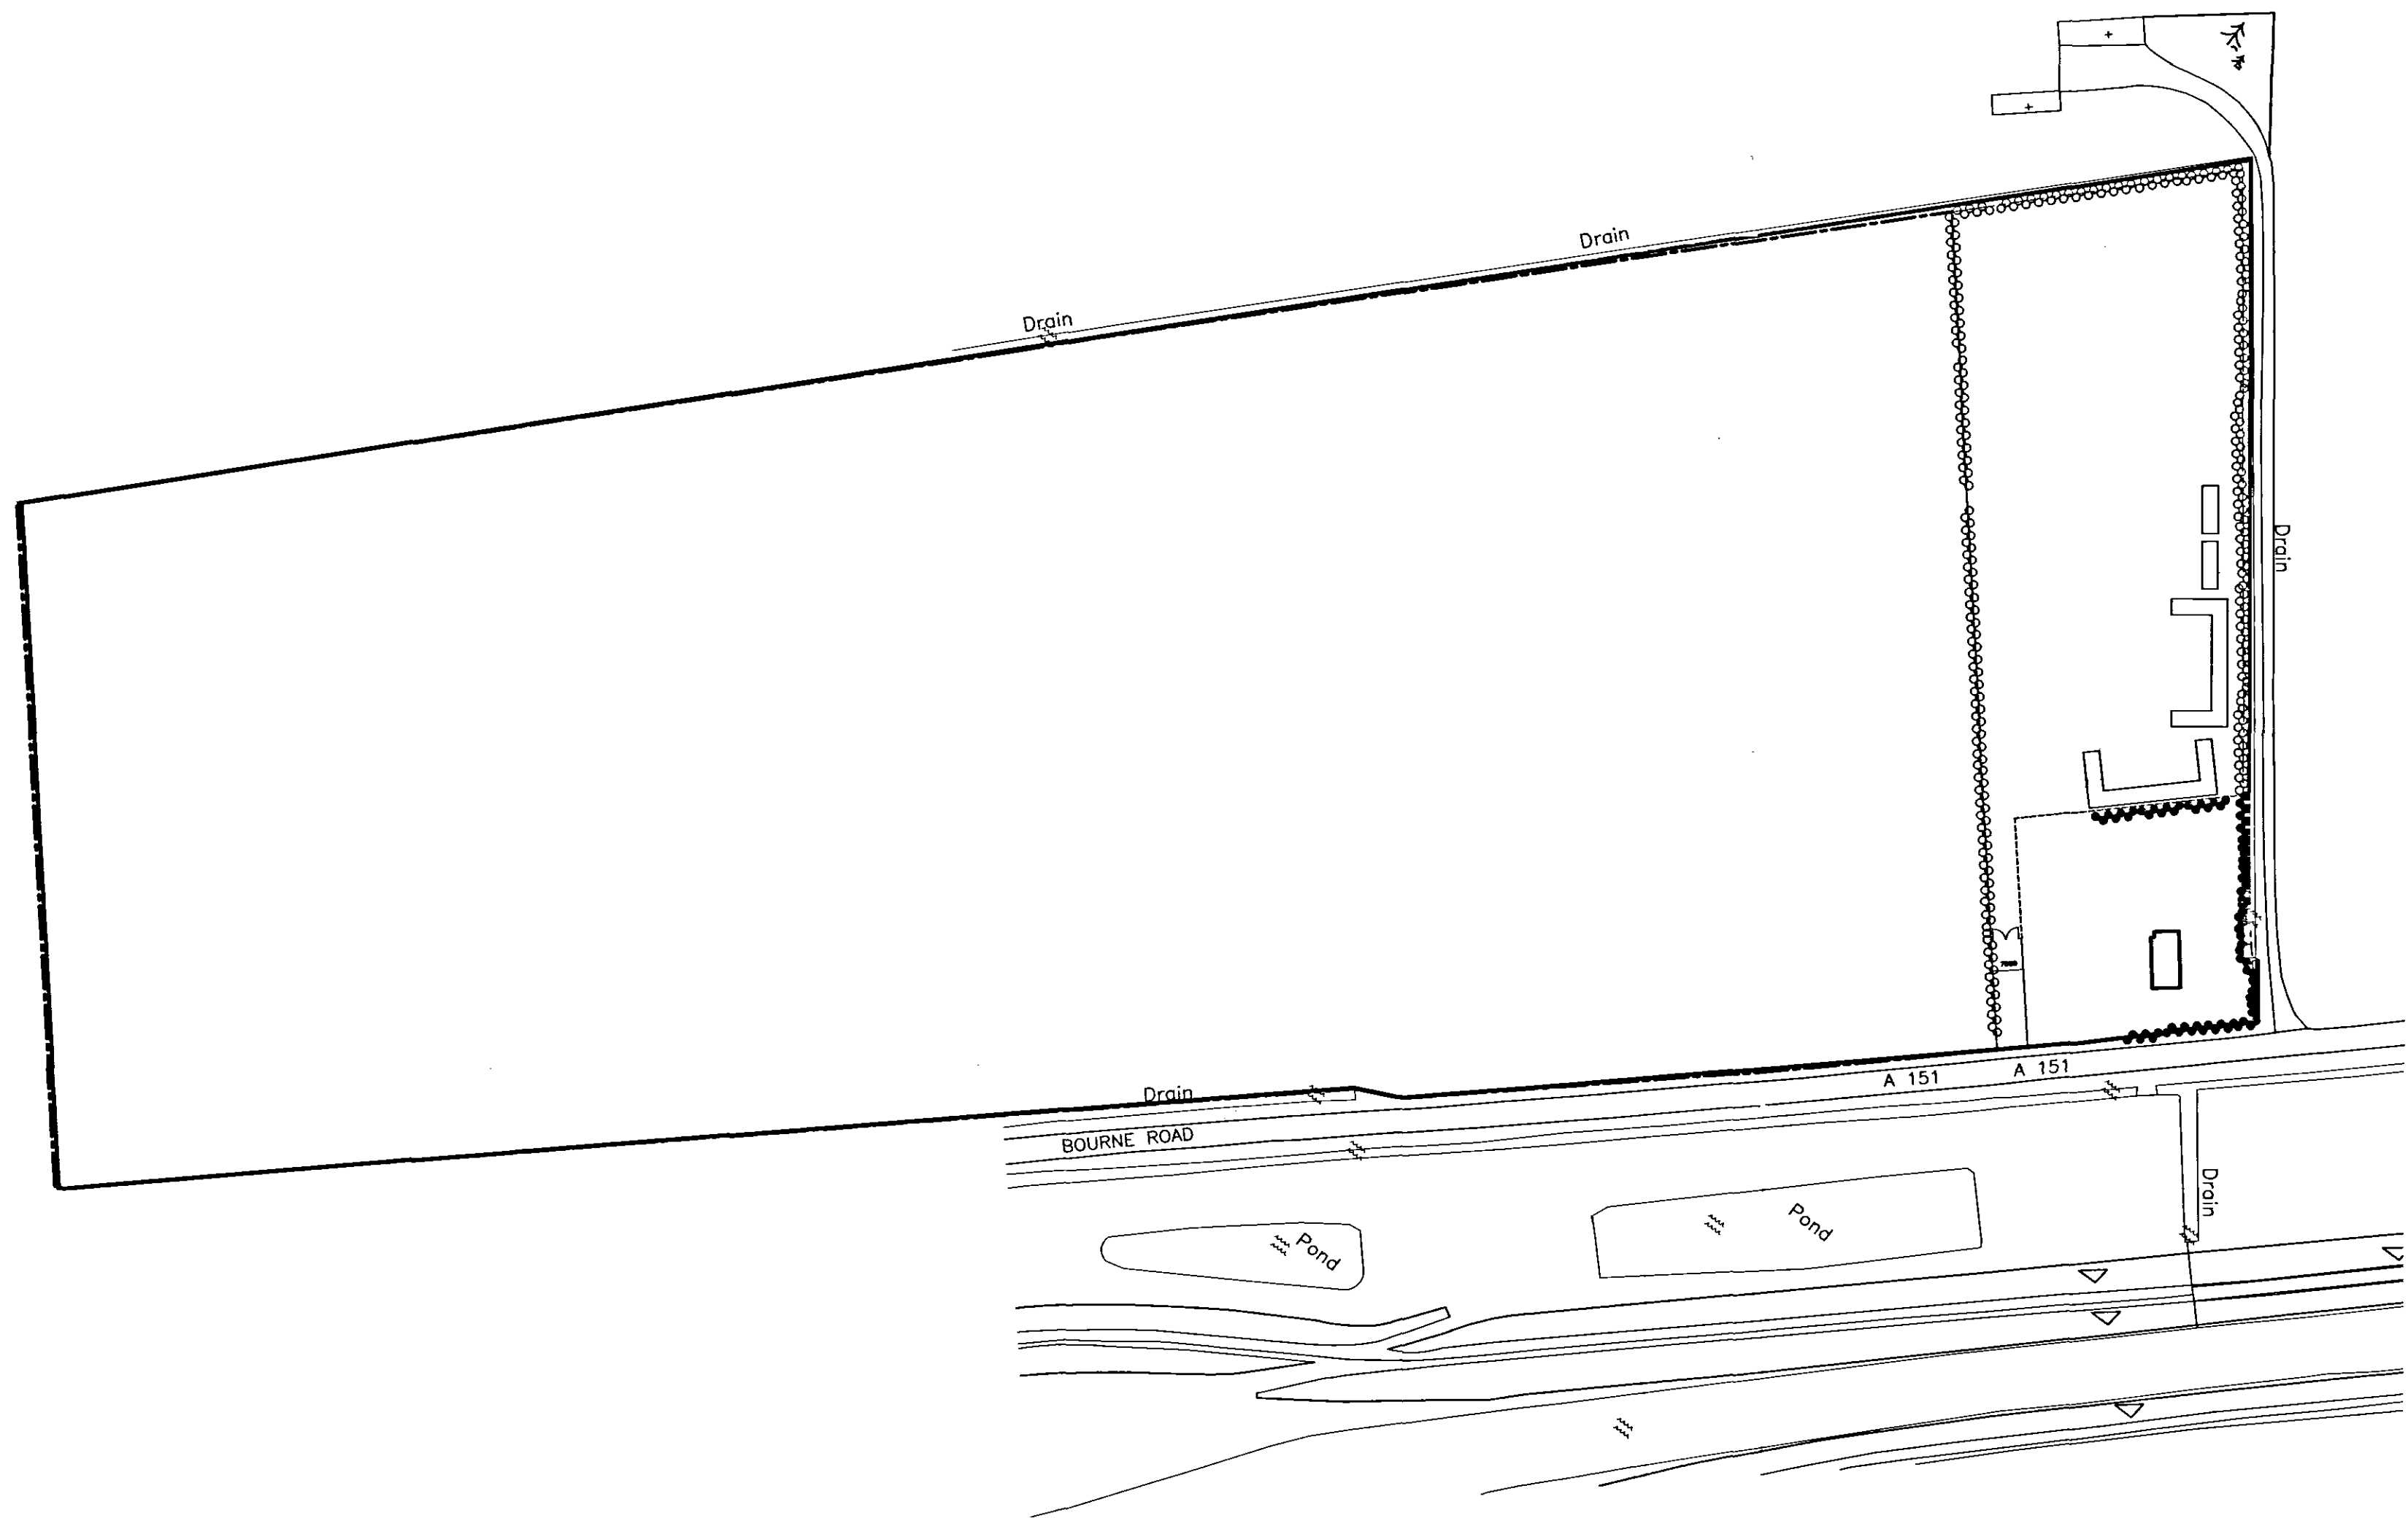

SITE LOCATION PLAN
SCALE 1:1250

SHDC
Planning & Development
28 OCT 2005
Ref: 1482/05

DETERMINED
PLAN

Revisions	Date	Description
Amendments		

GOODING DESIGN

26 Fane Road Peterborough PE4 6ES
Telephone 01733 324065

PROJECT
PROPOSED HORSE STABLES ADJACENT
ORCHARD HOUSE, BOURNE ROAD,
WEST PINCHBECK

DRAWING NUMBER	REVISION
300905/01	

DRAWING TITLE			
SCHEME PLANS			
SCALE AS SHOWN	SKETCH PLAN	TENDER ONLY	
DATE SEP 05	DETAIL DESIGN	CONSTRUCTION * AS-BUILT *	