


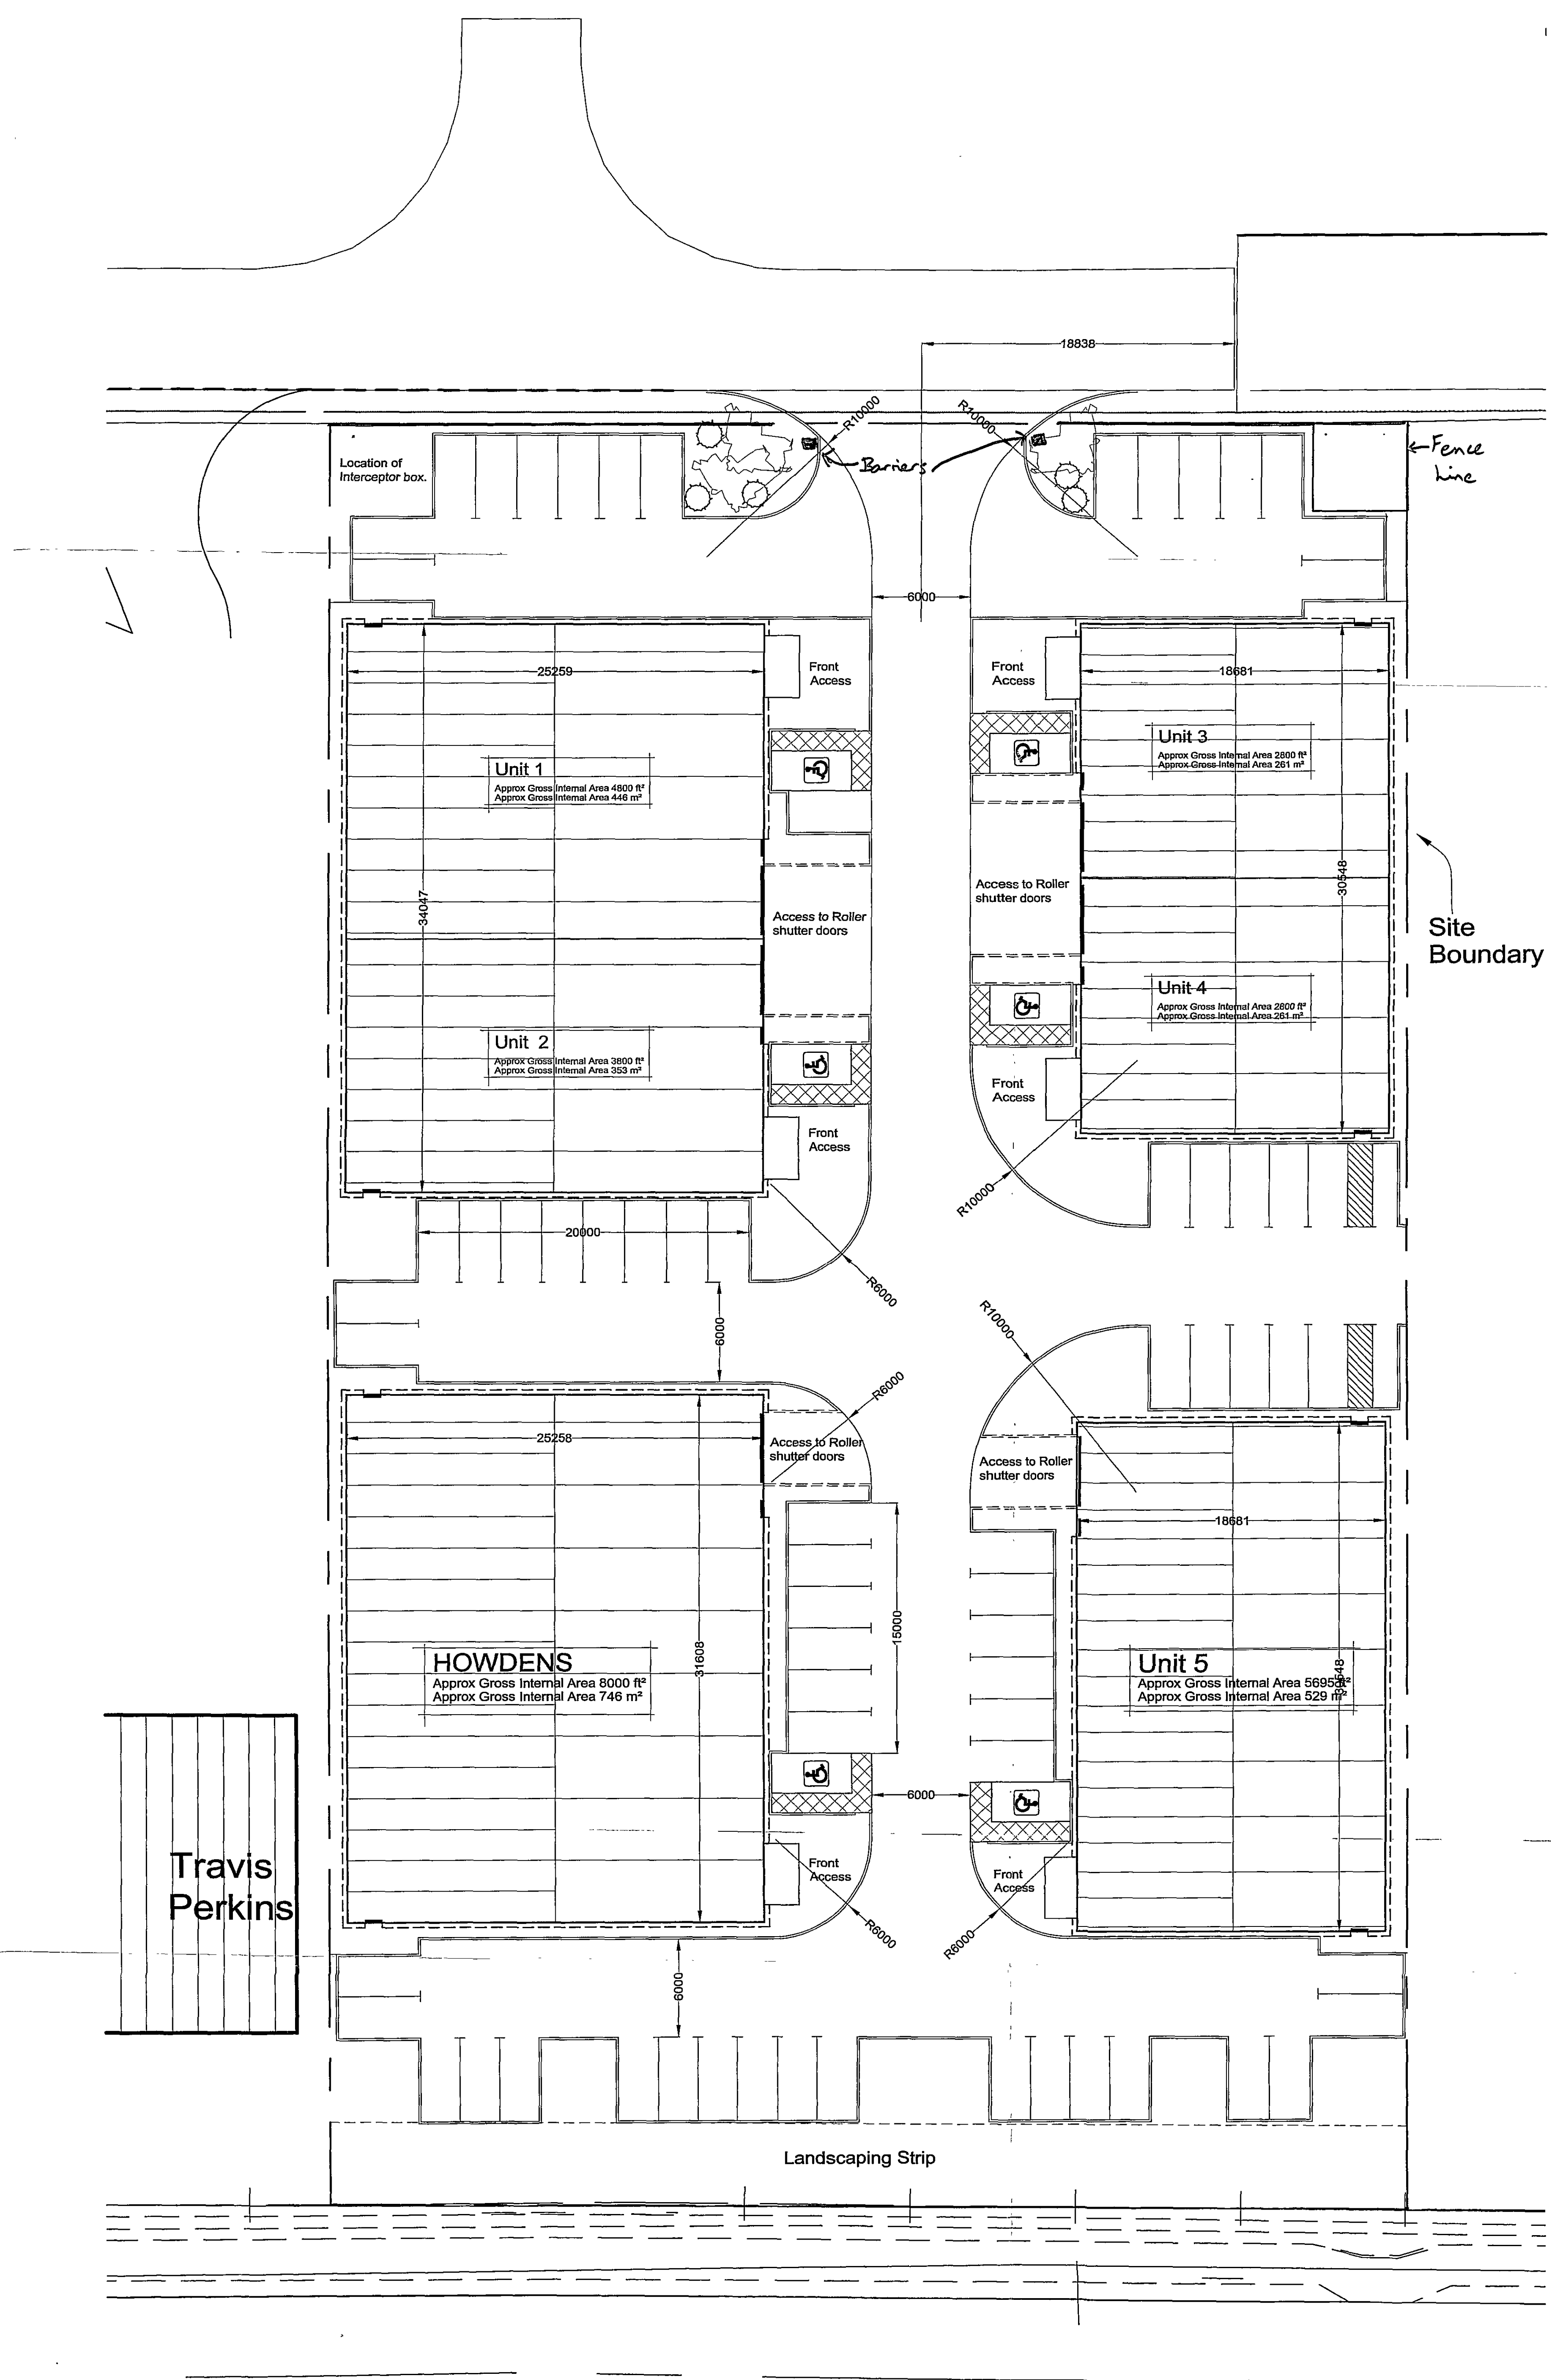

External dimensions of the Buildings are taken from finished edge of cladding.

As Built

Rev 'F' - 26/03/07 - Amendment made to road markings
 Rev 'E' - 06/03/07 - As Built
 Rev 'D' - 08/01/07 - Site Plan updated to match Landscaping layout.
 Rev 'C' - 05/10/06 - Landscaping taken out of areas adjacent to Unit 2 & Unit 4.
 Rev 'B' - 14/09/06 - Site Plan altered to suit exact building positions and sizes, general movement to front facing car parking spaces and ramps.
 Rev 'A' - 17/08/06 - Slight change to area calculations and adjustment to site layout around perimeter of units. Plus Unit 2 decreased in size, and minimal movement to Unit 3 & 4.



Lindum Business Park, Station Road
 North Hykeham, Lincoln LN6 3QX
 Tel: (01522) 500300
 Fax: (01522) 852221
 E-Mail: design@lindumgroup.co.uk

Client
Lindum Developments Ltd

Project
Proposed New Unit's
Wardentree Park
Spalding

Drawing Title
Site Plan

Date
August 2006

Drawn By
Ryan Holmes

Drawing Number
25- 0139/ 120



Scale
1/200

Client Ref
-

Revision
F

CHDC
 Planning & Development
 - 8 NOV 2007
 Ref: 149067