

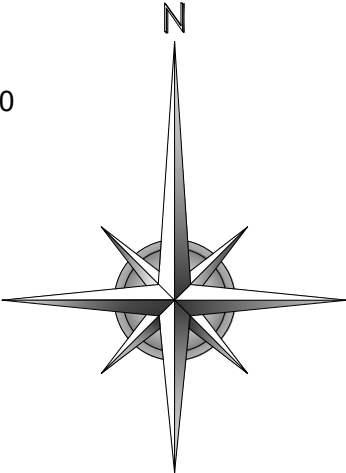


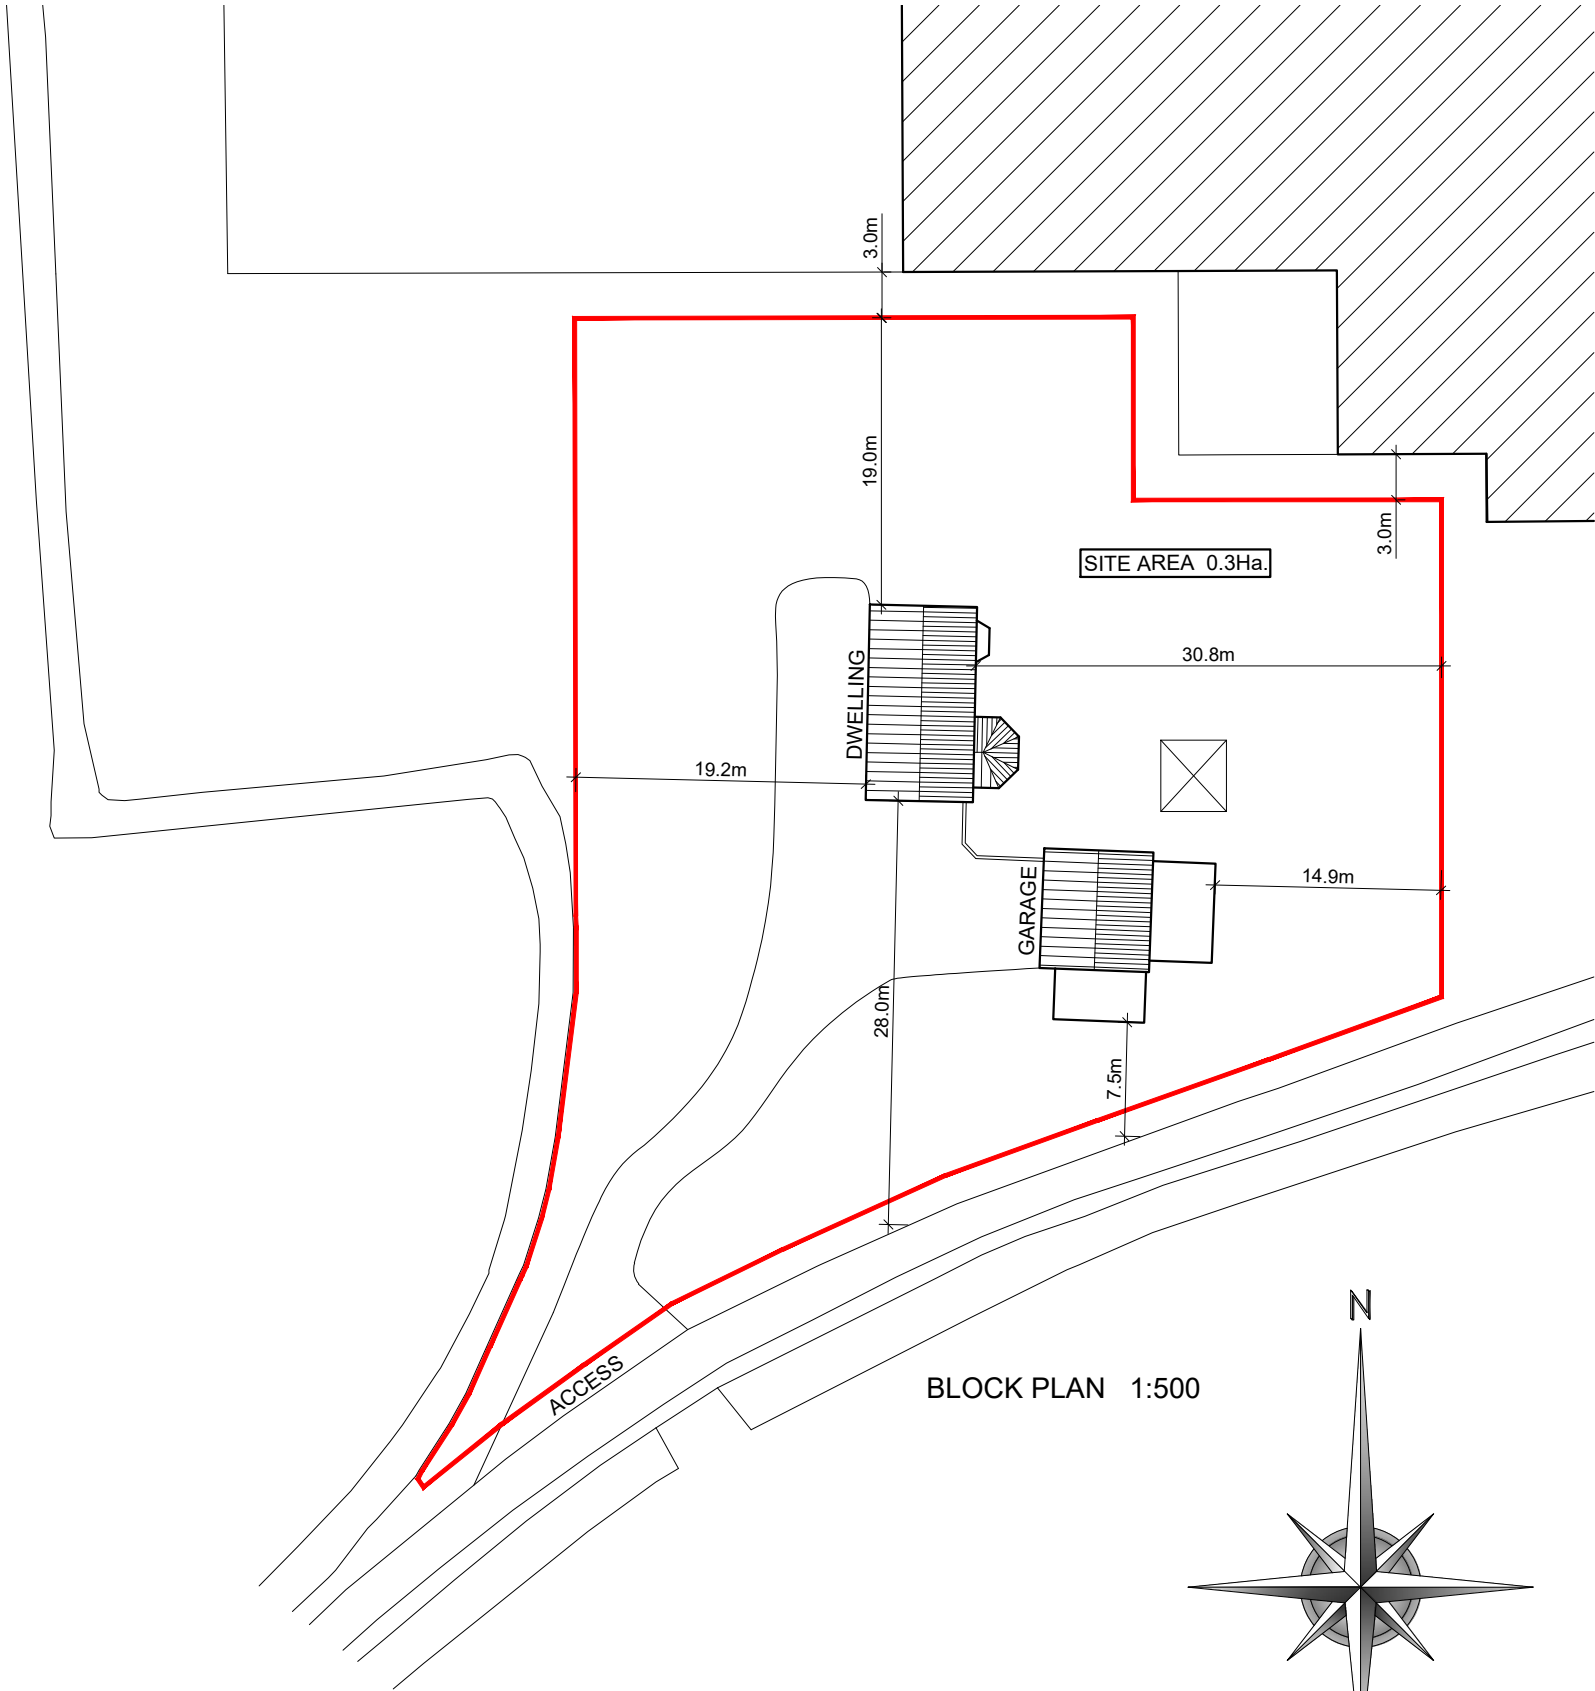

BLOCK PLAN 1:500

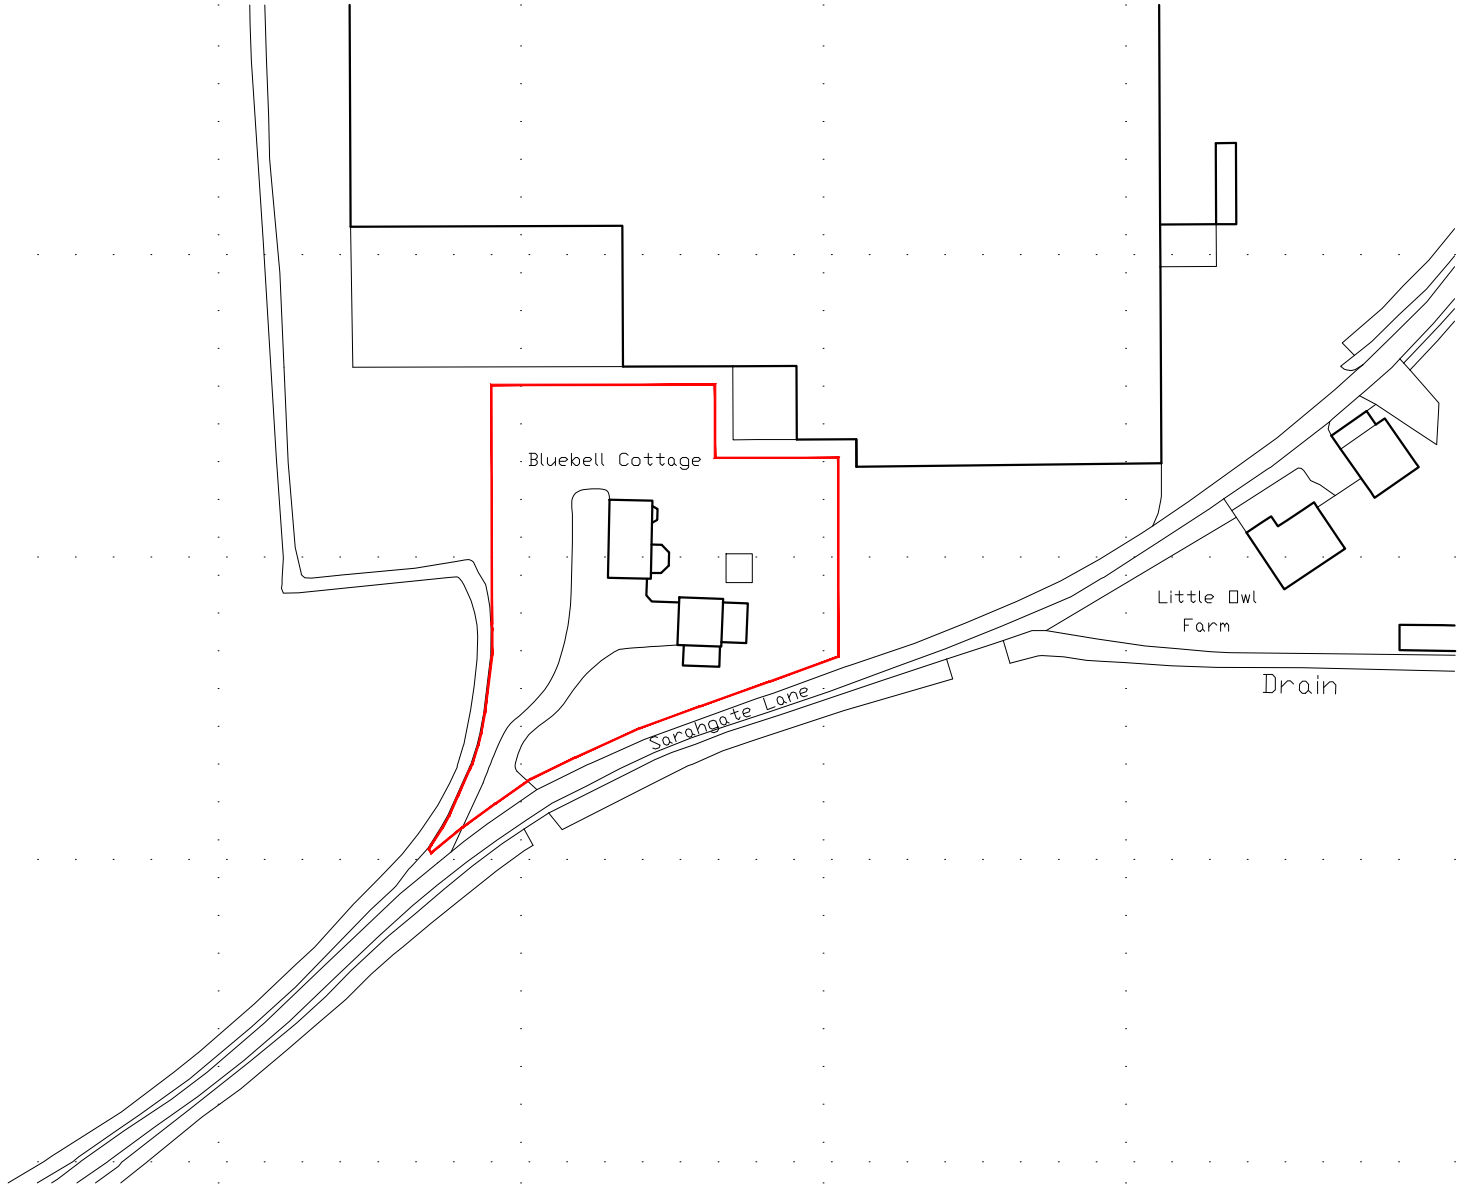

Ordnance Survey (c) Crown Copyright 2025. All rights reserved. Licence number 100022432

LOCATION PLAN 1:1250

revision	date	init.	revision details.



**COOPER
ARCHITECTURAL
DESIGN**
90 WINSOVER ROAD
SPALDING, LINC'S PE11 1HA
Mobile : 07808 125 778
E-MAIL : c.a.d@btconnect.com

Client.
MRS S BINGHAM

Project.
**BLUEBELL COTTAGE
SARAHGATE LANE
QUADRING
PE11 2QE**

Drawing.
**AS BUILT
BLOCK & LOCATION PLANS**

Scale 1:500 1:1250@A1	Drawing No. 0429-05
Date. FEB. '25	Drawn.