


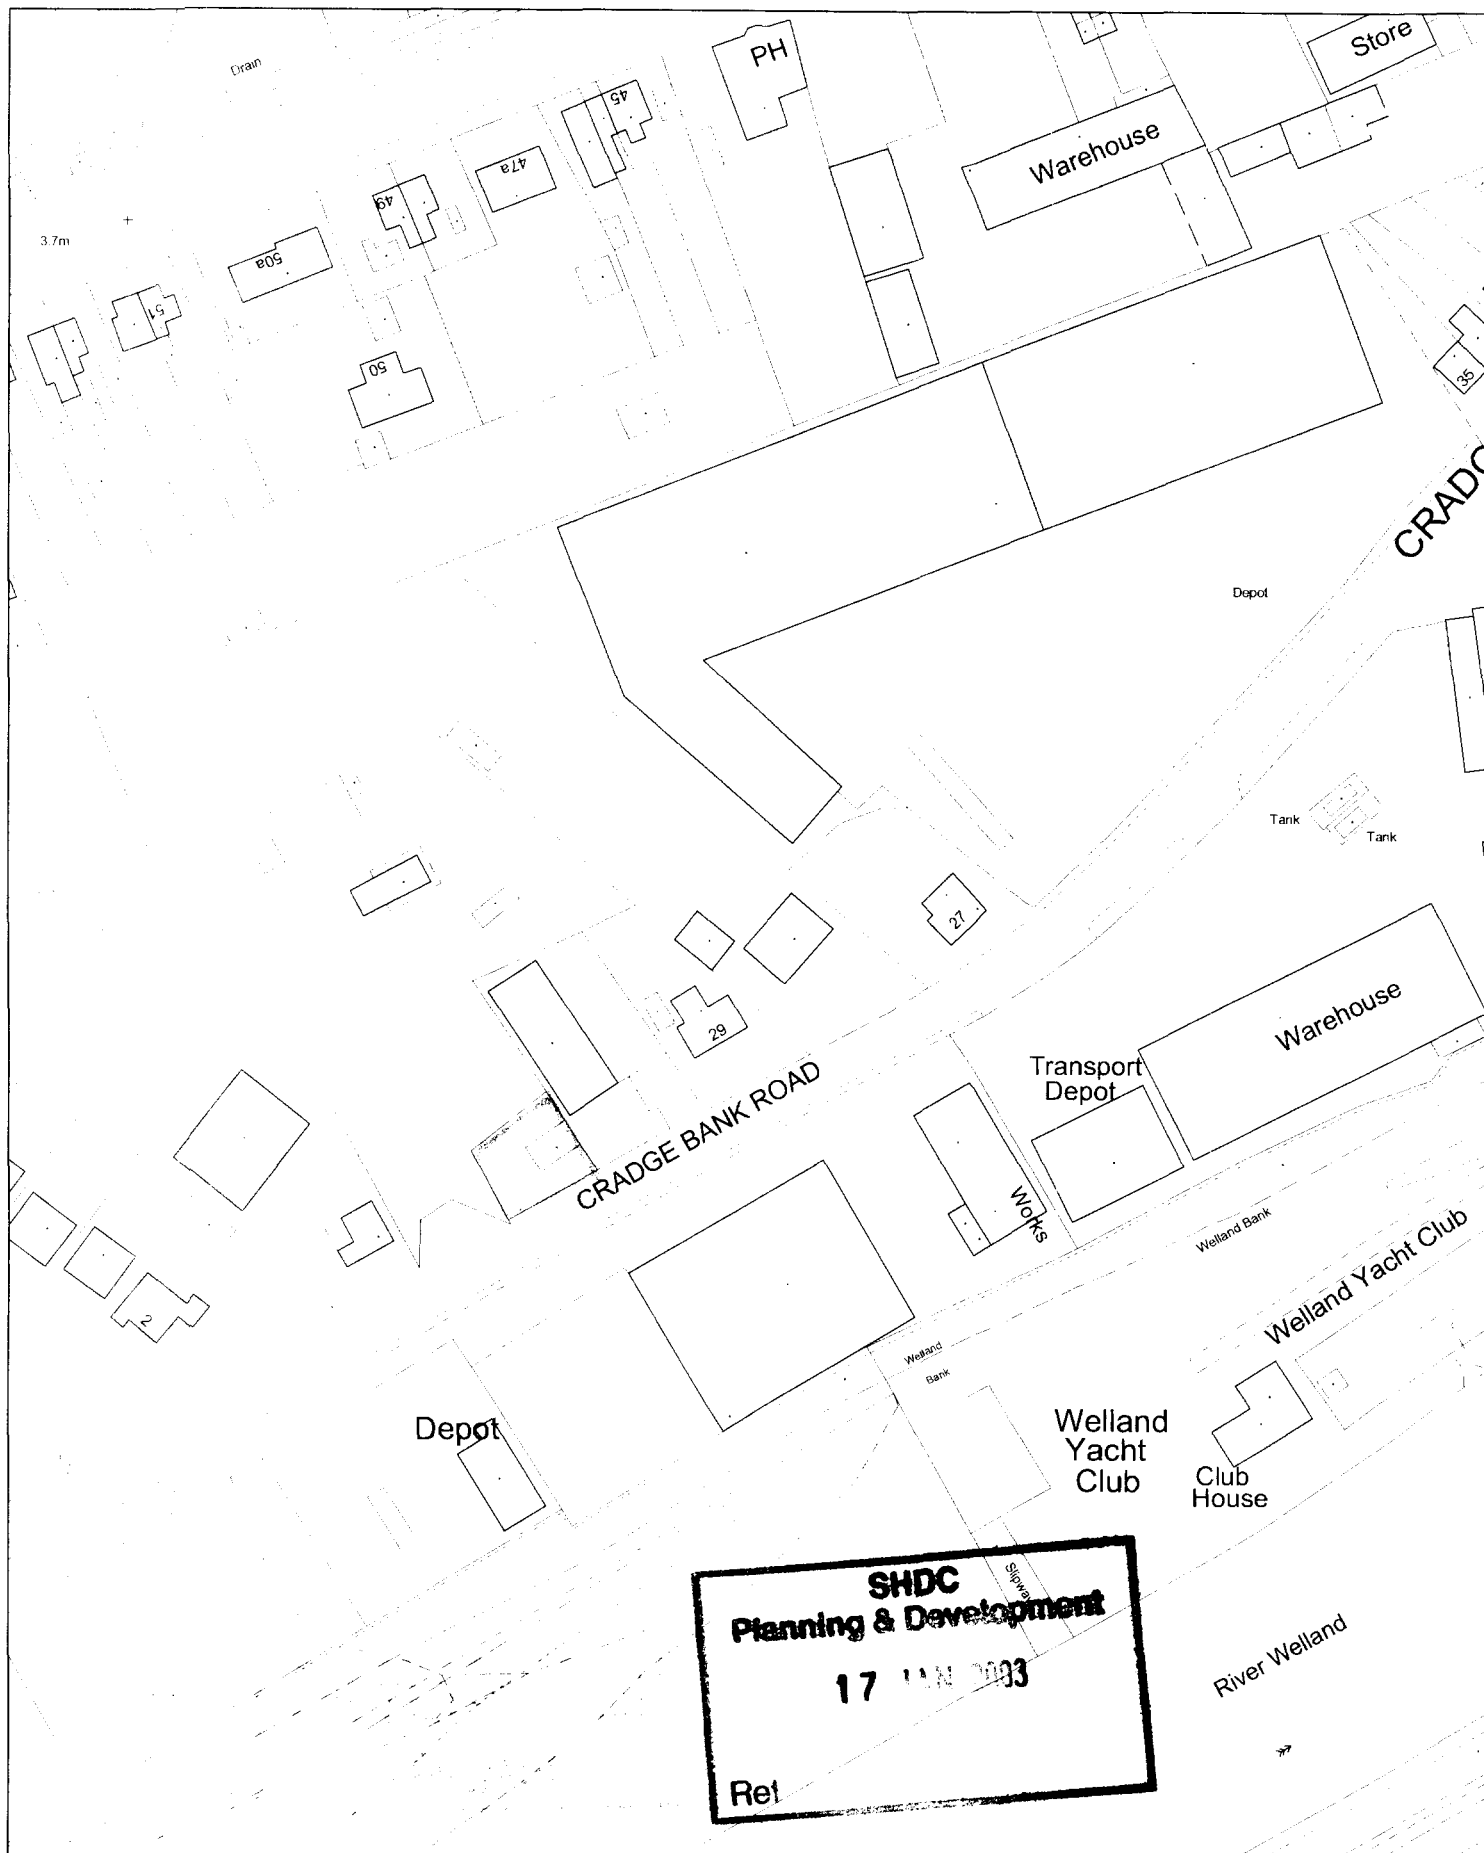


SHDC
Planning & Development
17 JAN 2003
Rel

This copy has been produced specifically for the map return scheme purposes only. No further copies may be made.

Scale:
 1:1250


Council Offices, Priory Road, Spalding,
 Lincolnshire PE11 2XE

This map is reproduced from Ordnance Survey material with permission of Ordnance Survey on behalf of Her Majesty's Stationery Office (c) Crown copyright. Unauthorised reproduction infringes Crown copyright and may lead to prosecution or civil proceedings. South Holland District Council LA079413 2003

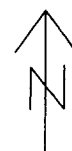






• SOUTH-EAST ELEVATION •

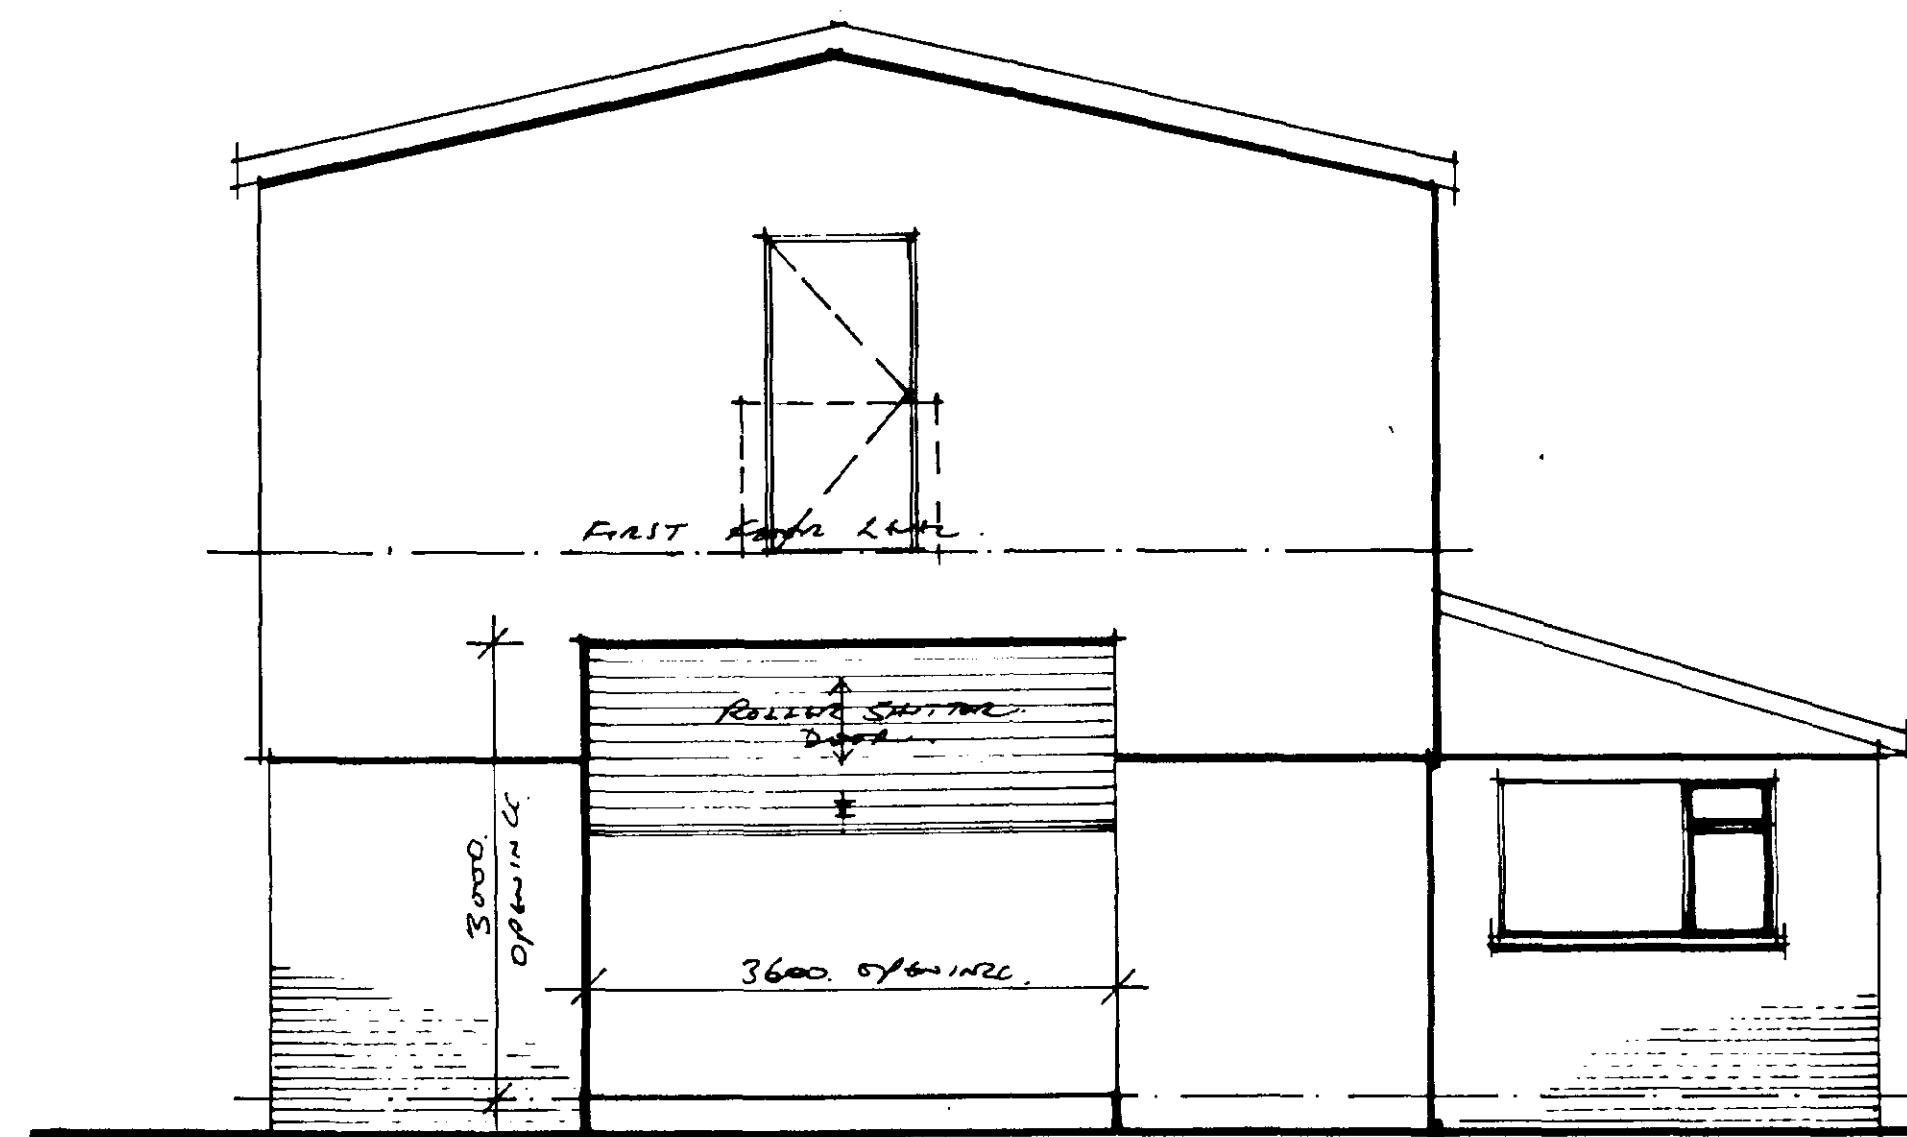


• SOUTH-WEST ELEVATION •

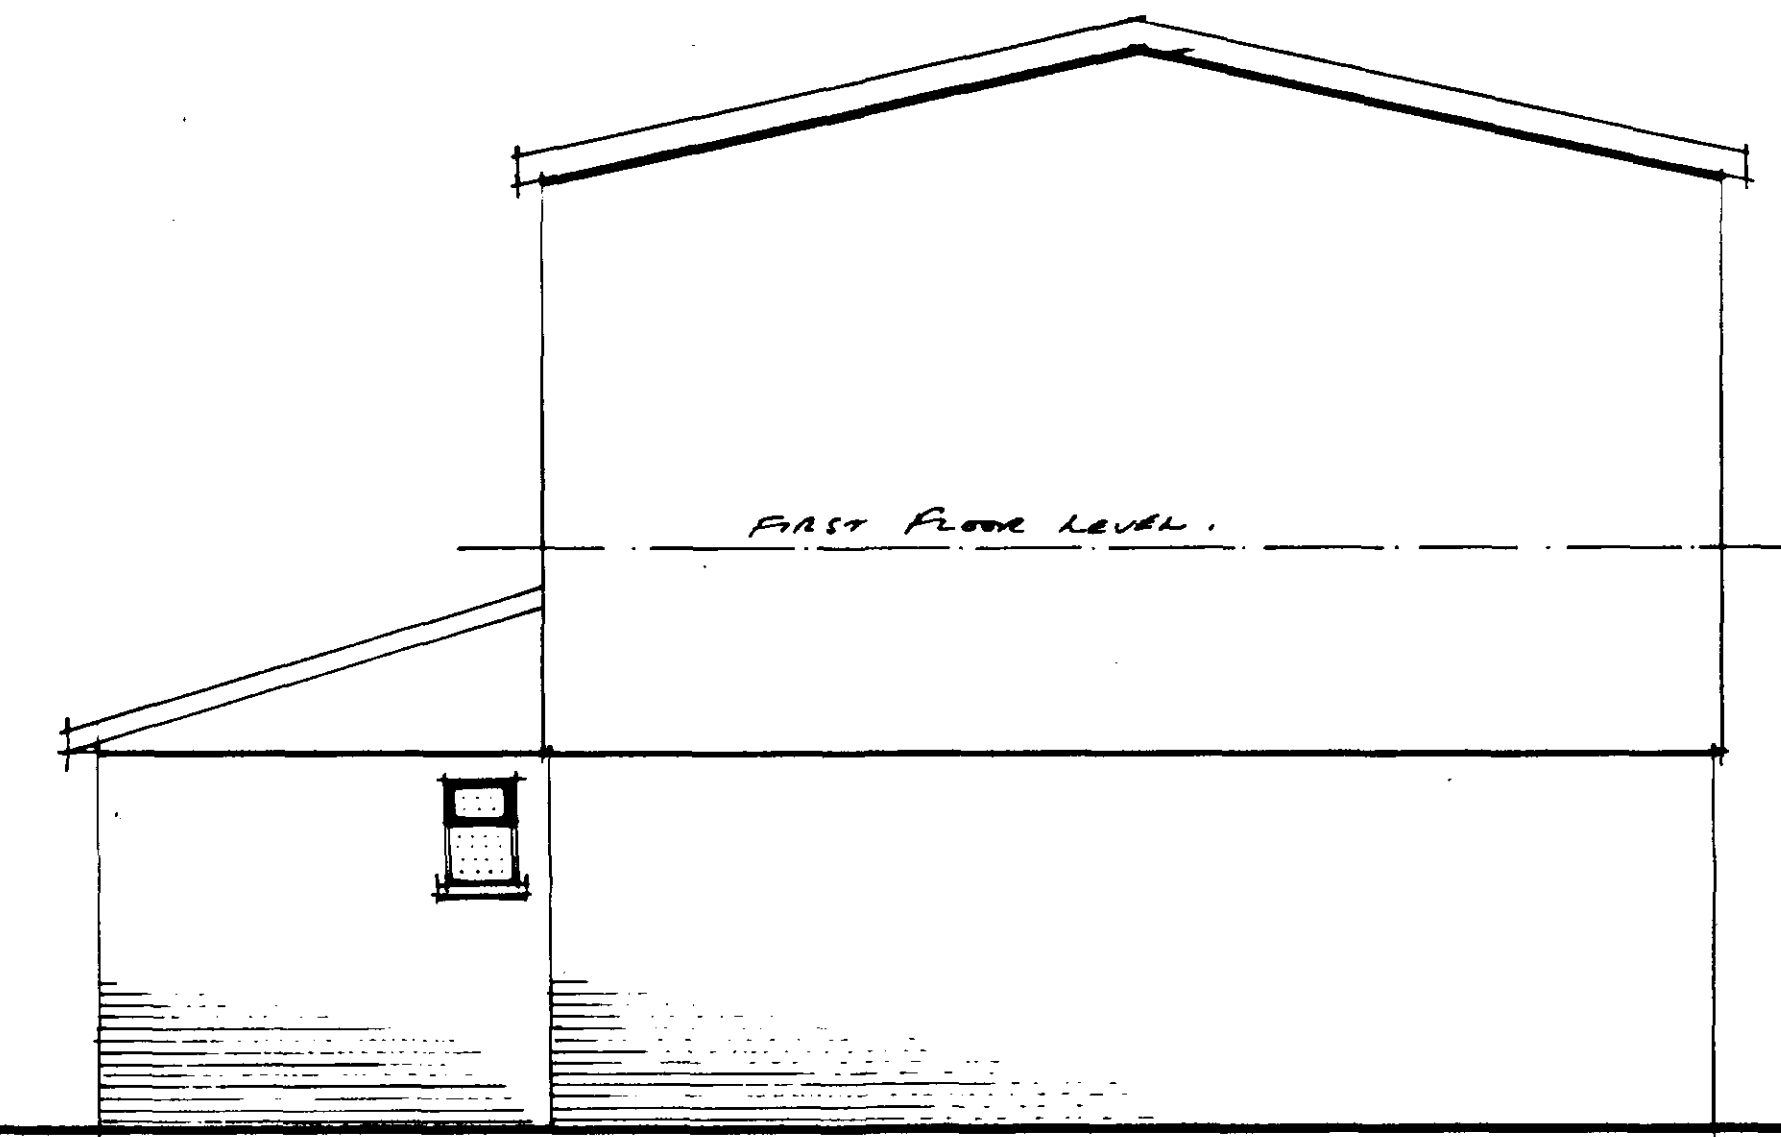

• NORTH-EAST ELEVATION •

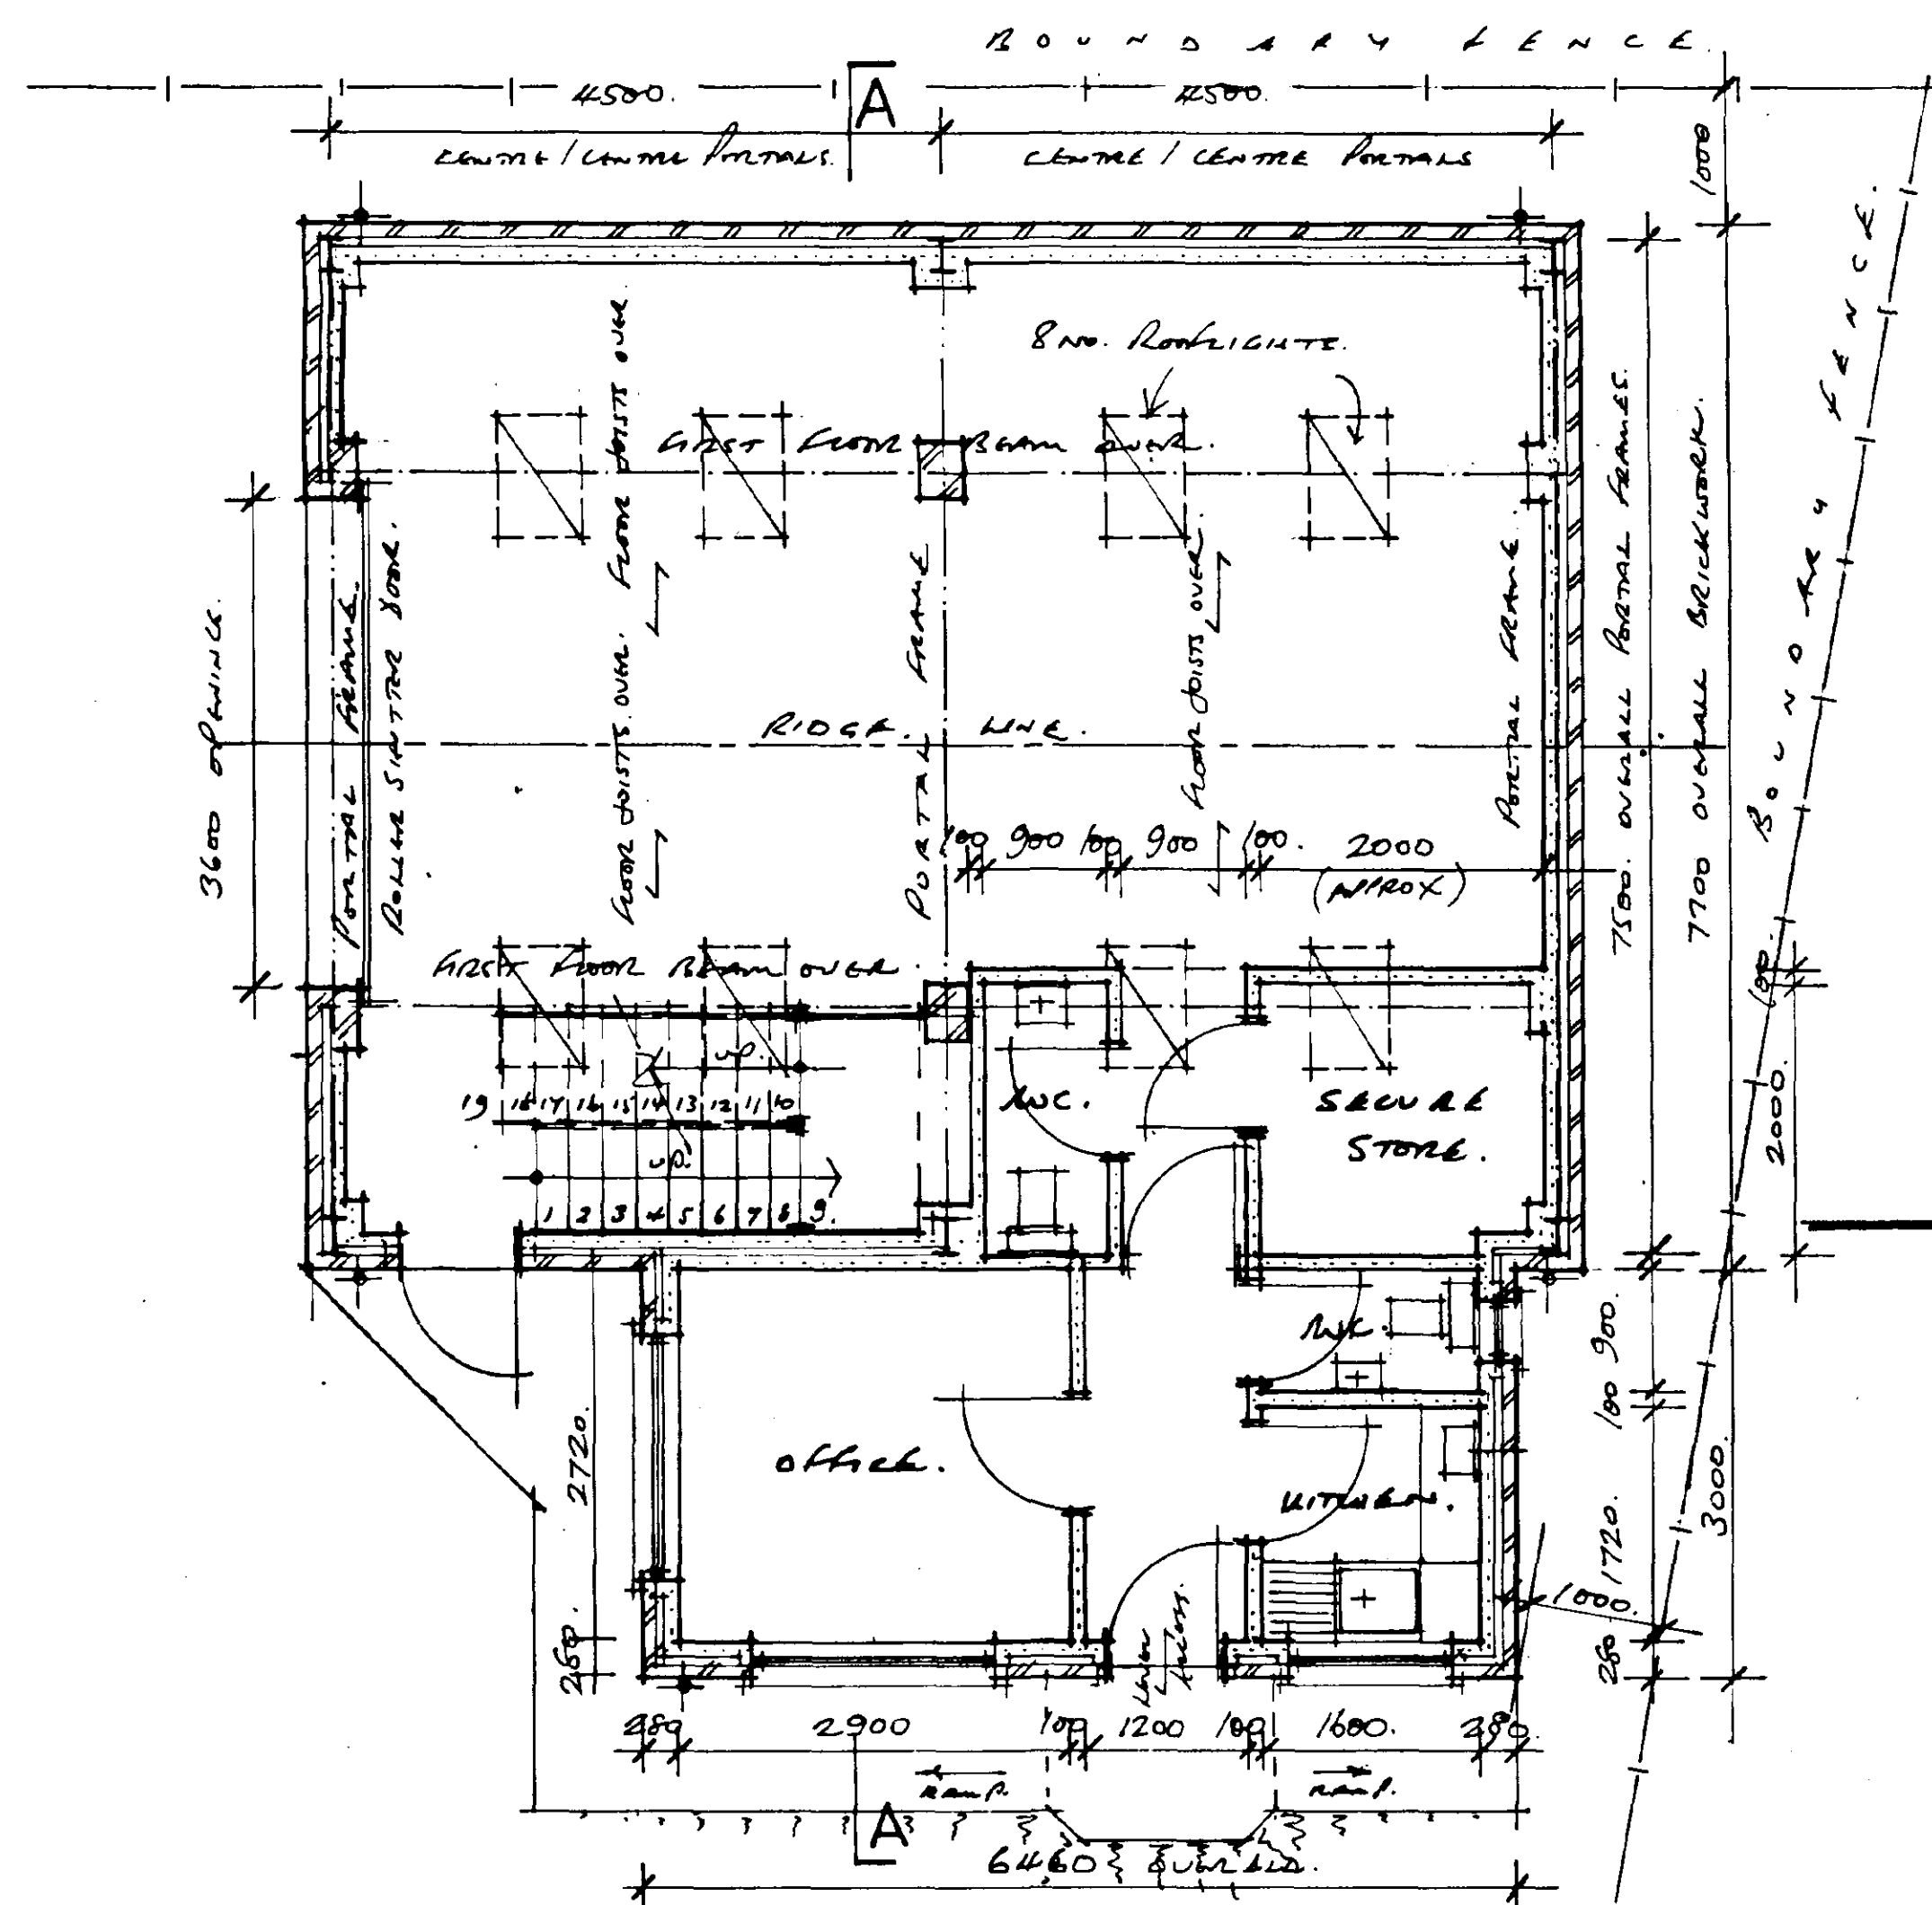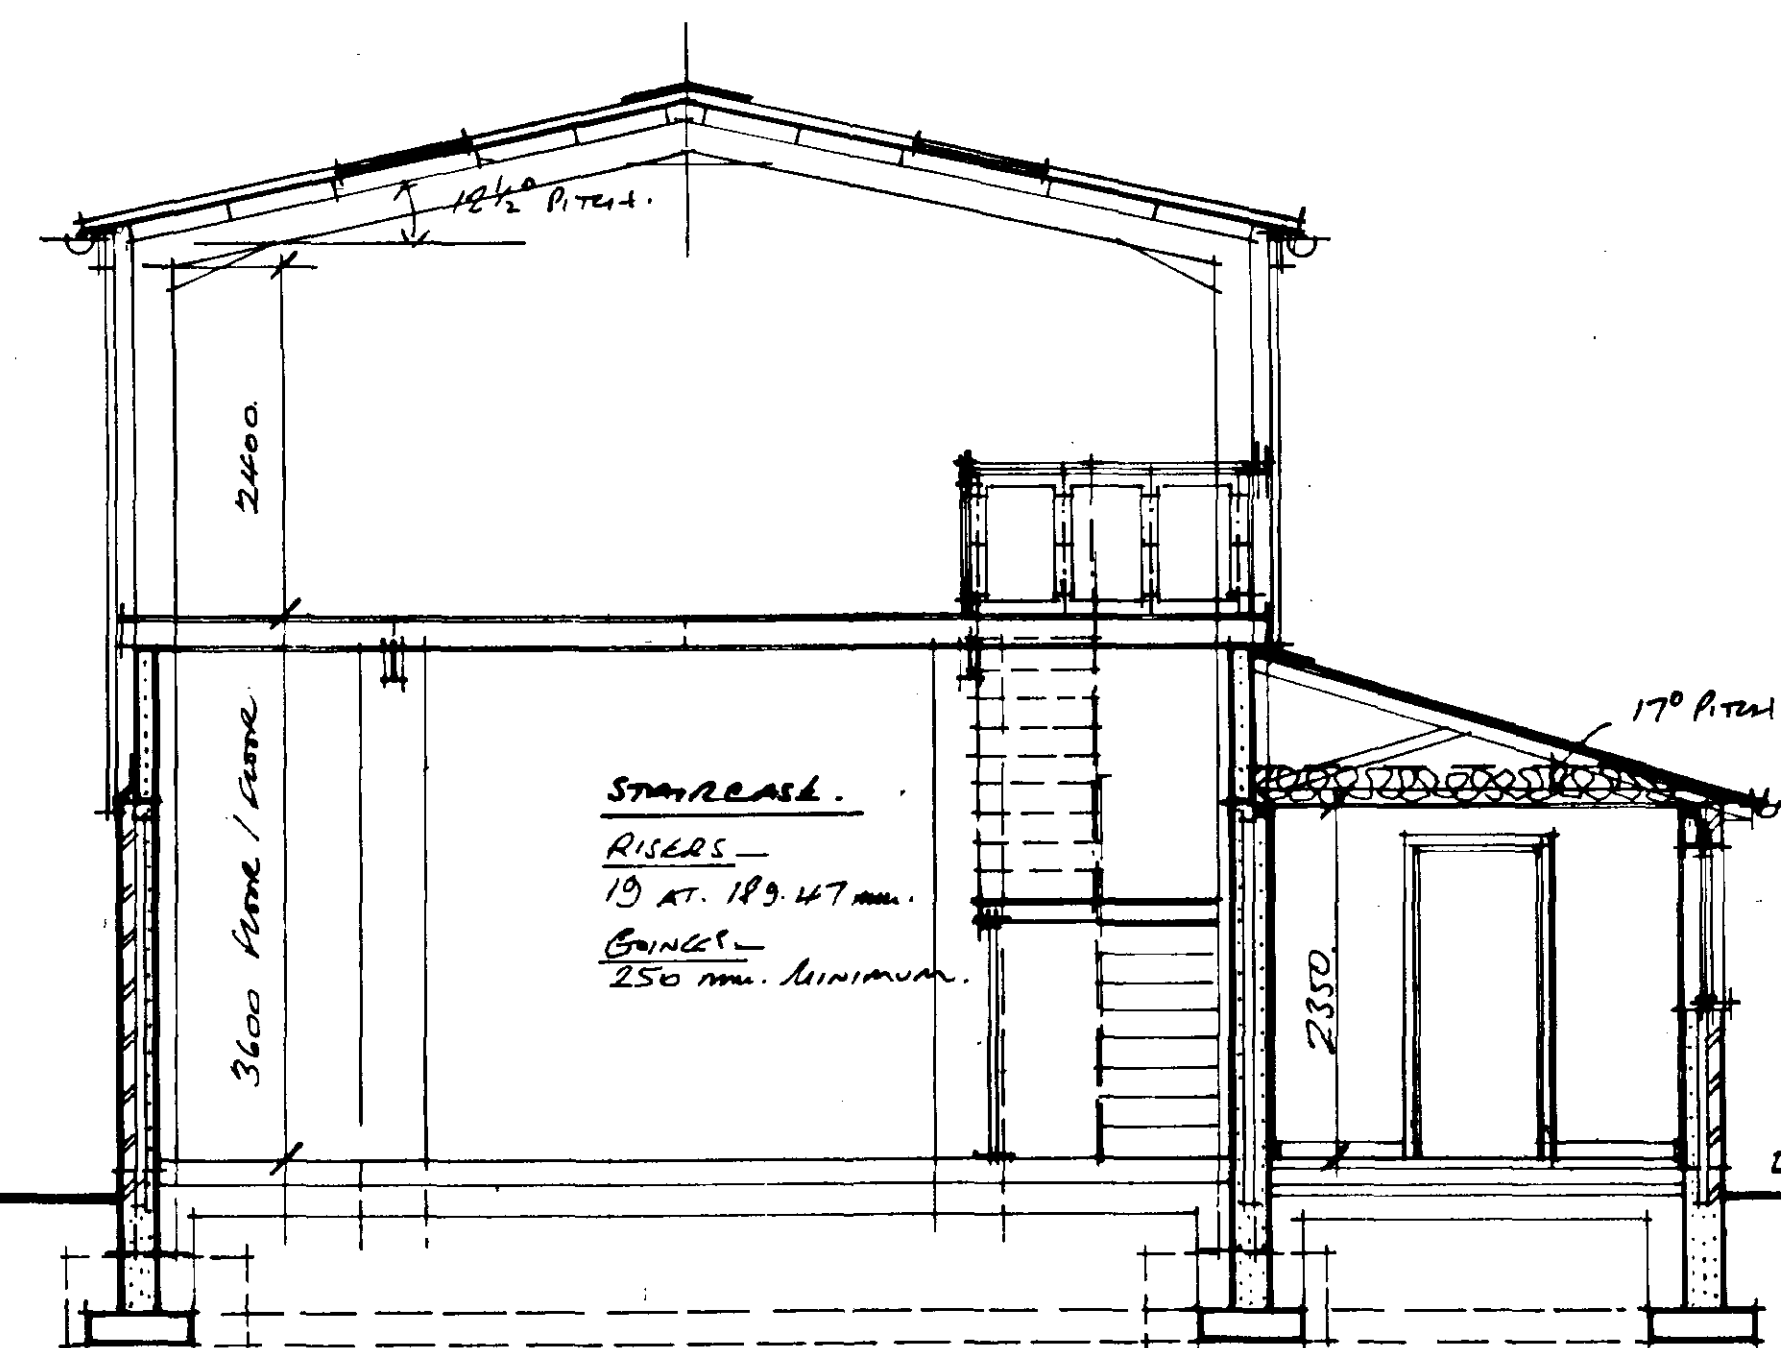

• SECTION A-A •

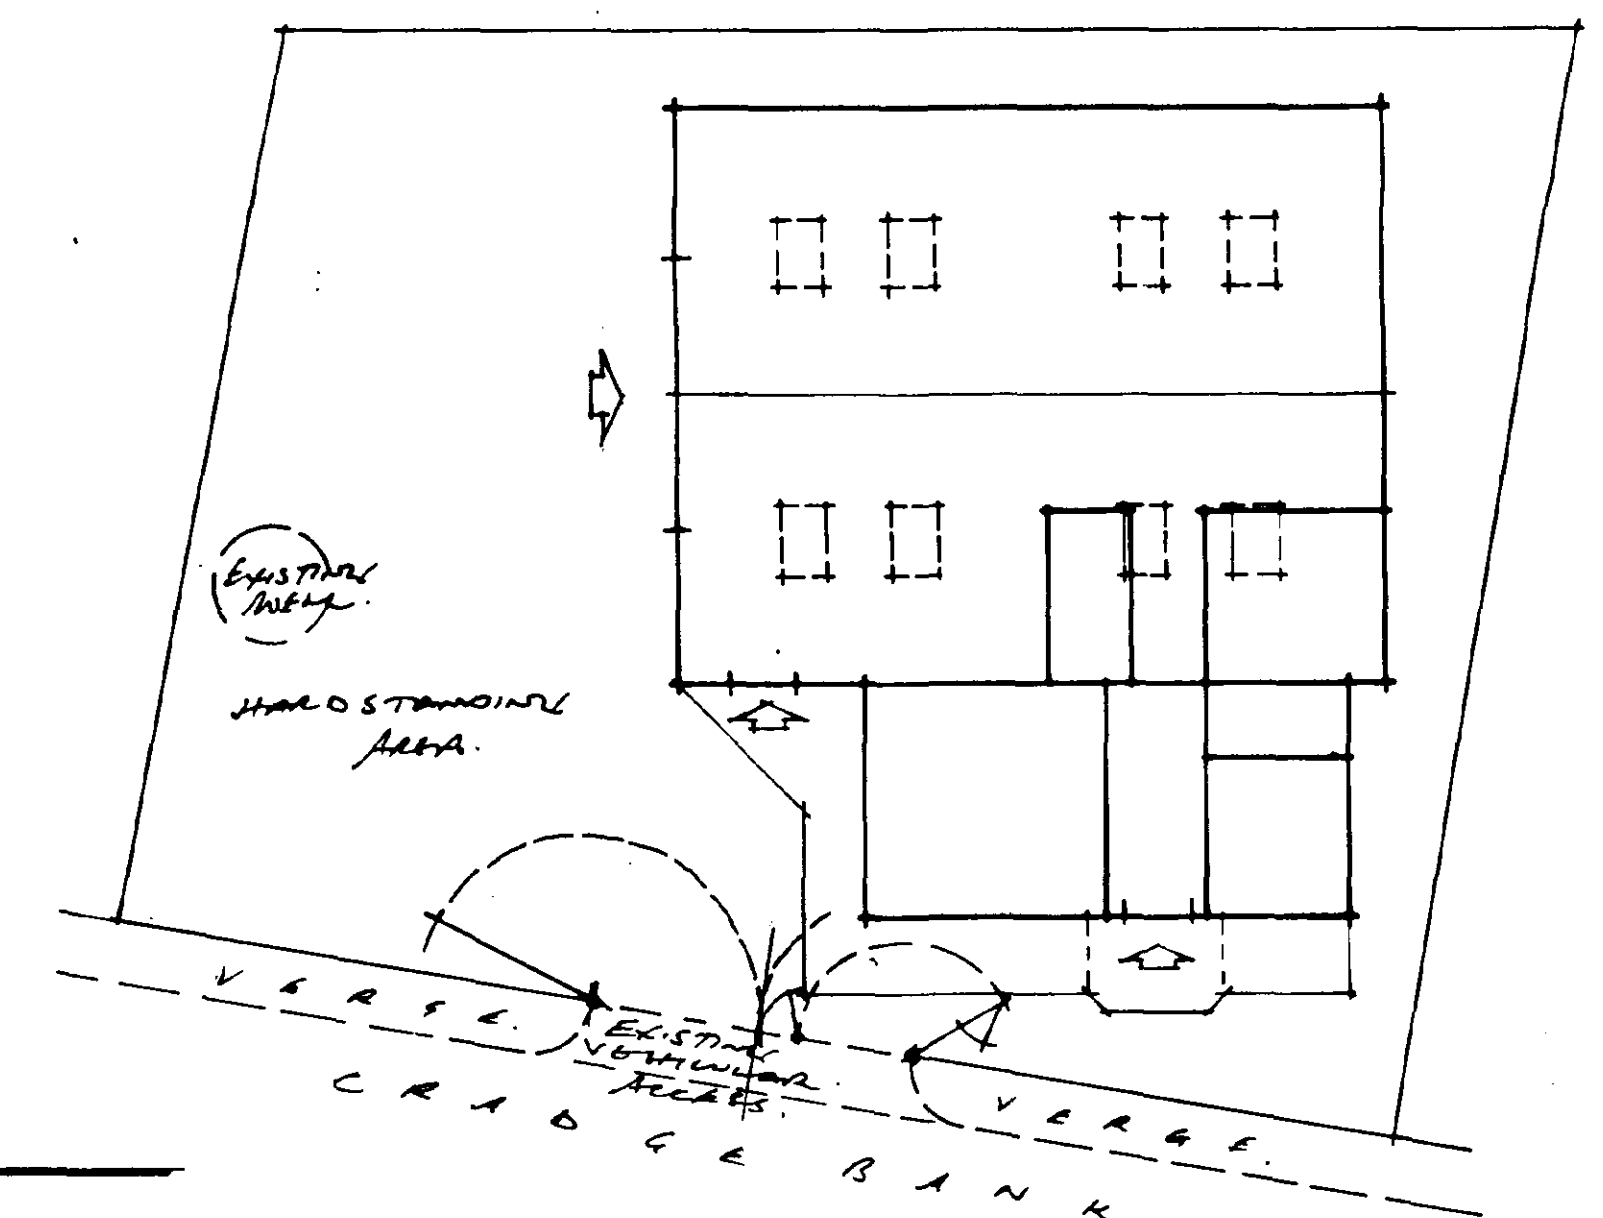

• BLOCK PLAN • SCALE 1:100 •

• PROPOSED BUILDERS STORE + ADMIN. BLOCK • CRADGE BANK • SPALDING • Lincs. • G. DENTONE BUILDING CONTRACTORS •

• DRAWING NO. 01/05/10. • SCALE 1:50 • JANUARY 2003 • R. N. COWLING MBAT. ARCHITECTURAL TECHNOLOGIST. 9. GALWAY CLOSE. SPALDING. Lincs. • TEL/FAX 01775 723836 •

SHDC
Planning & Development
17 JAN 2003
Ref: 0042/03

DETERMINED
PLAN

R N Cowling M.B.I.A.T. Architectural Technologist

9 Galway Close
Spalding
Lincolnshire
PE11 3FL


Tel/Fax 01775 723836

E-Mail address - gina@spalding87.freemove.co.uk

Head of Planning and Development
South Holland District Council
Council Offices
Priory Road
Spalding
Lincs
PE11 2XE

8th December 2003

My Ref:- 01/05/RNC

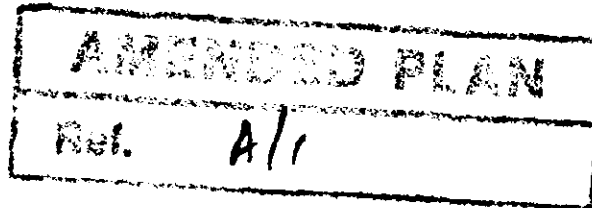

Dear Sir,

**Proposed Builders Store and Admin. Block.
Cradge Bank, Spalding, Lincs..
Dentone Building Contractors.**

Full Planning Permission Ref: H16/0042/03 and dated 12th March 2003.


I enclose herewith a copy of the Block Plan from my Drawing No. 01/05/10 as submitted with the original application documents relating to the above Planning Permission.

In order to maximise the area of this Site and subject to being granted a parallel approval by Building Control for compliance with the relevant 'parts' of the Building Regulations, Mr Tony Long, Dentone Building Contractors, has asked me to seek your formal permission, given that the property to the rear is an aggregate distribution yard, to move the proposed building as close as possible to the rear boundary, say to within 300mm. (as superimposed in red on the Block Plan).


Because the ground works and foundations for this Project are due to be commenced later this week, your prompt attention to this matter, by return of post if possible or, initially, by e-mail message would be appreciated.

With many thanks.

Yours faithfully,

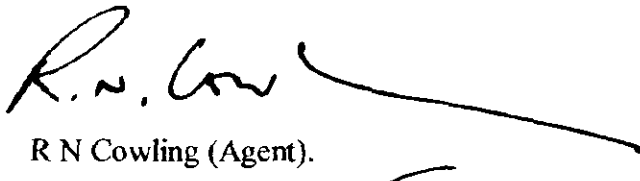
R N Cowling (Agent).

NORTH EAST ELEVATION.

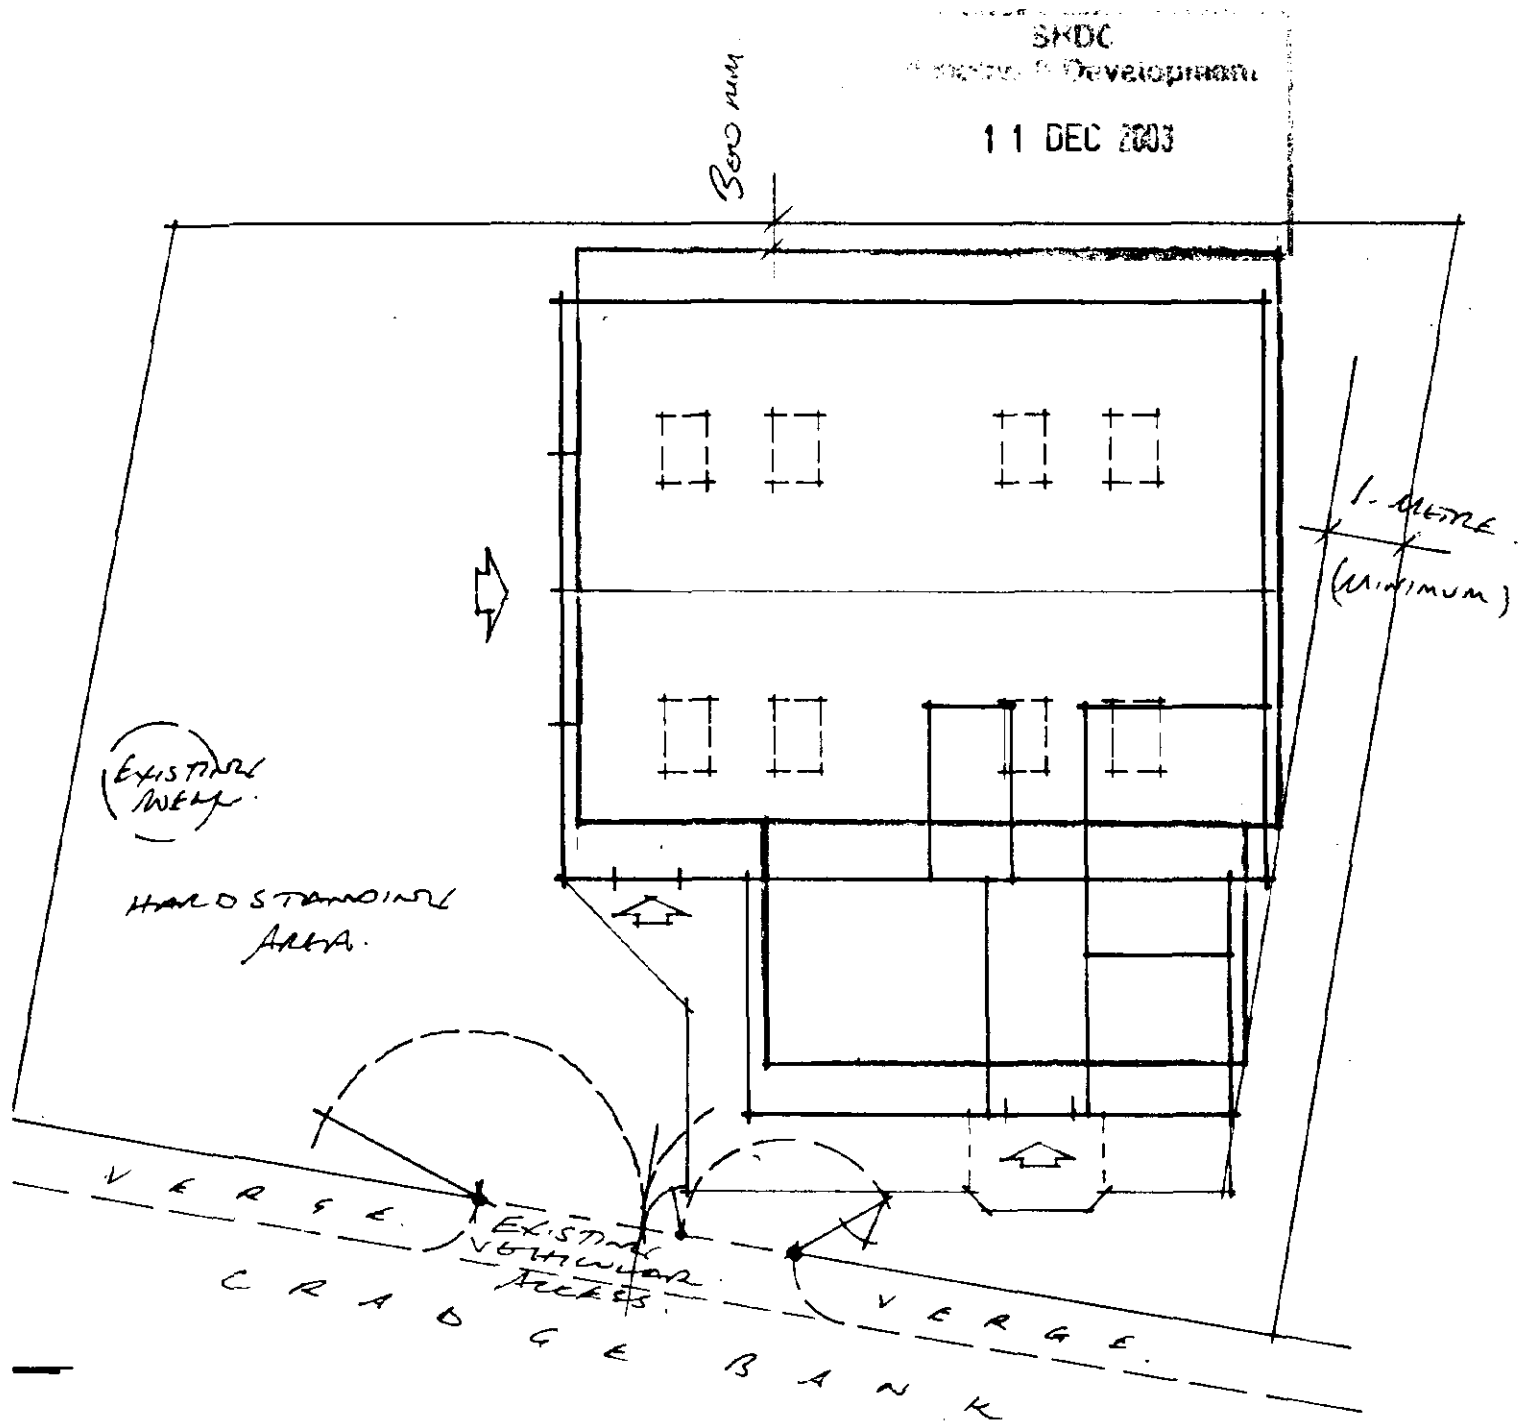

BLOCK PLAN. SCALE. 1:100.

~~UNLESS ASSOCIATED AND RELATED DOCUMENTS~~

~~ING SUBJECT~~

~~ETC. DRAWINGS GAI, GAZ, GAZ, GAI, AND APT. SOUTH KOREA CON~~