
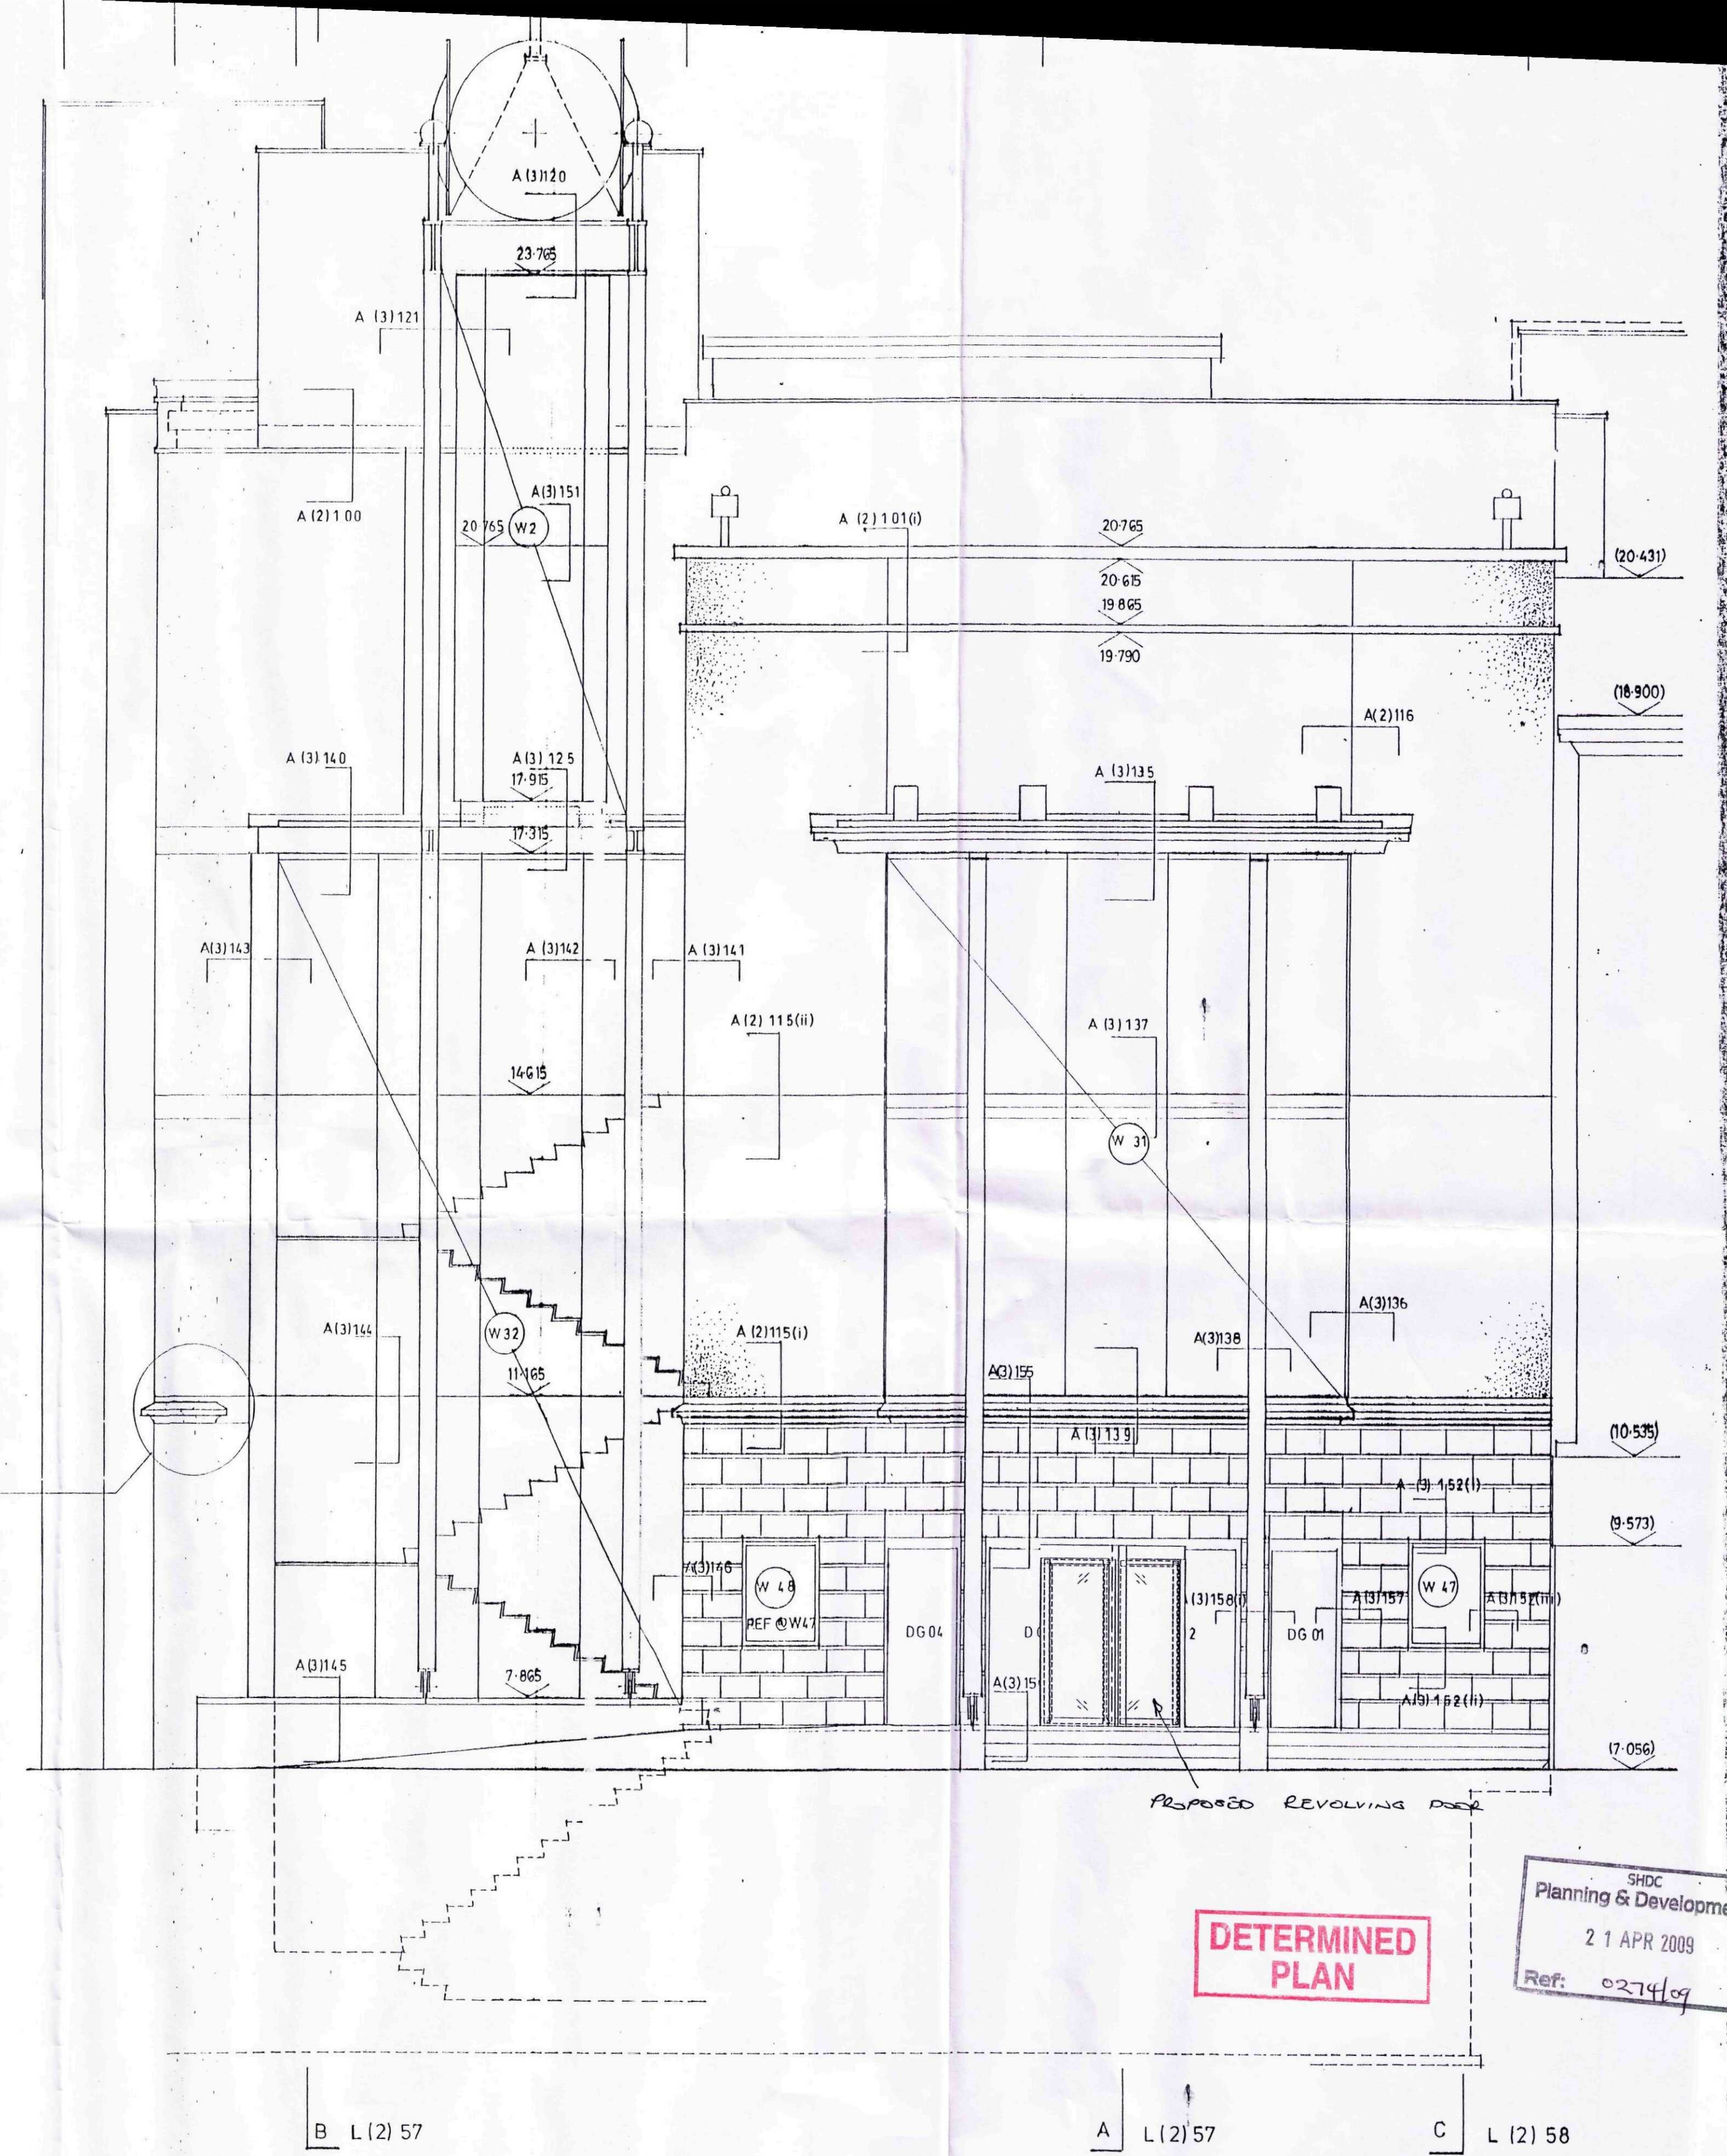


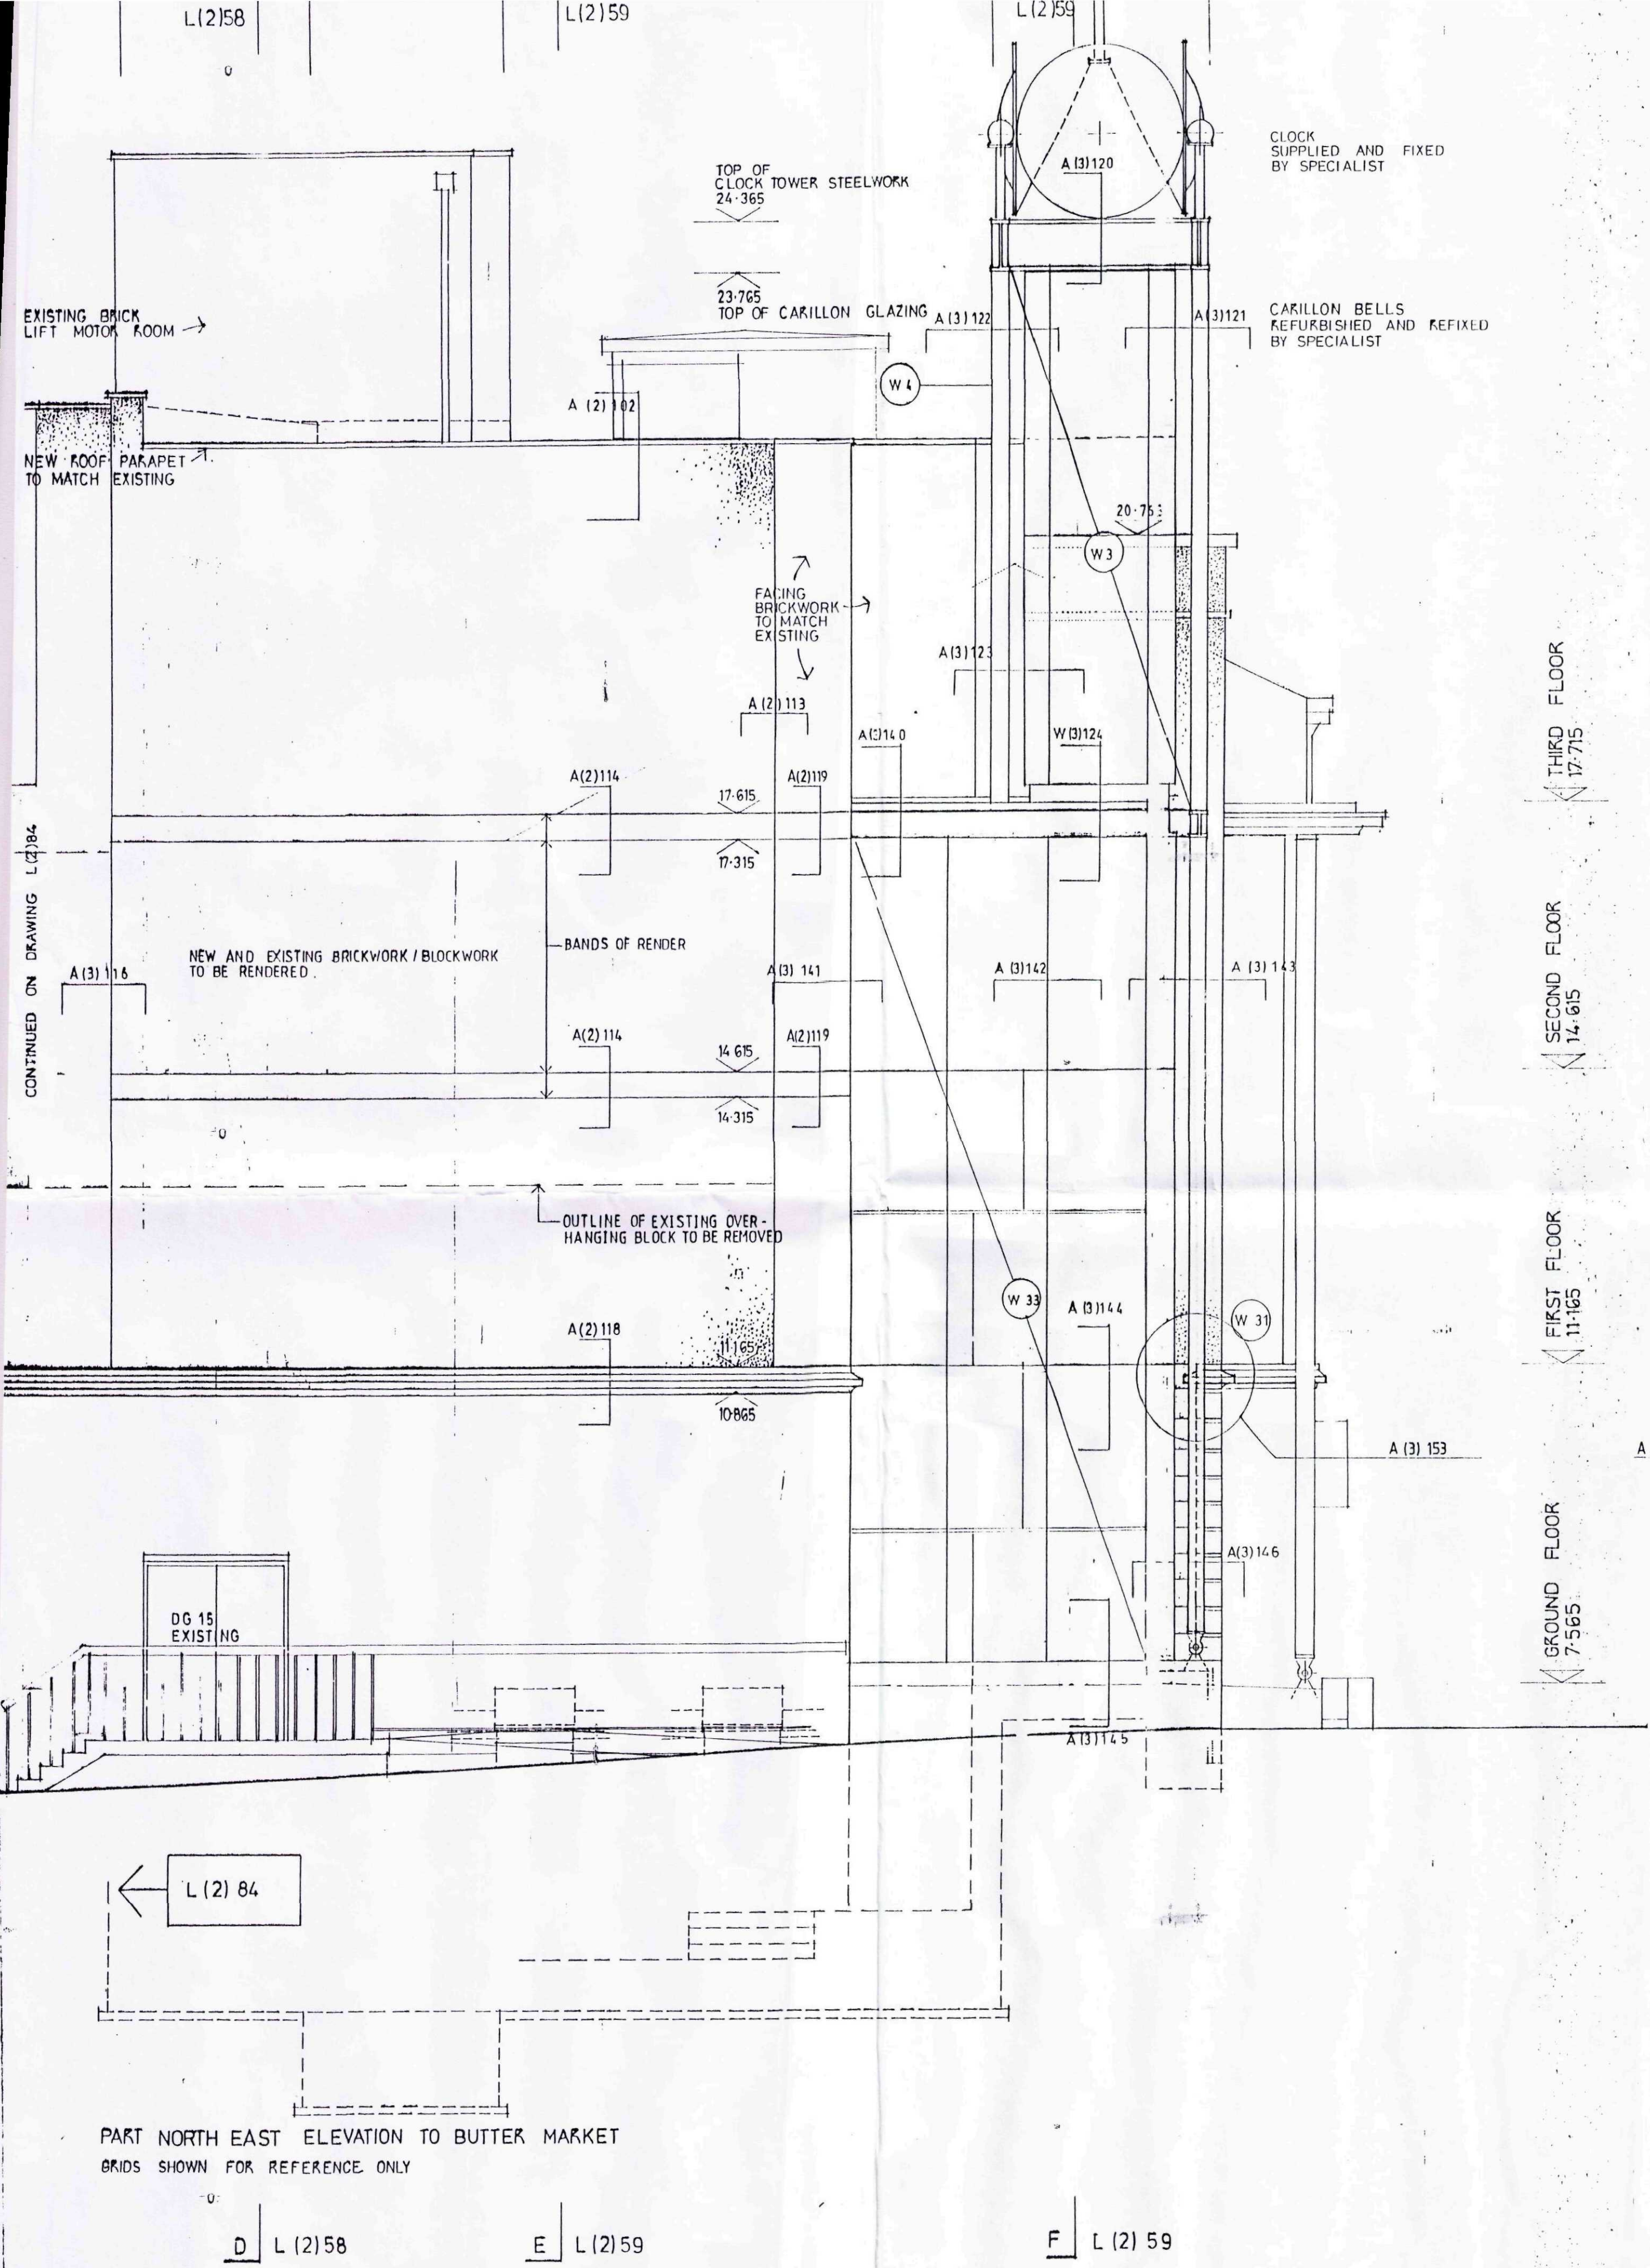

DETERMINED PLAN

SHDC
Planning & Development
21 APR 2009
Ref: 0274/09

SURVEY INFORMATION BASED ON RANDALL SURVEYS DRAWINGS. EXISTING LEVELS THUS (-18.900)
FOR STRUCTURAL DETAILS SEE WS ATKINS DRAWINGS

ISANSOME HALL ARCHITECTS

REGENCY COURT 220 UPPER FIFTH ST. CENTRAL MILTON KEYNES MK9 2HR TEL: 01908 866555 FAX: 01908 866555

PROJECT:
SOUTH HOLLAND CENTRE - SPALDING

TITLE:
FRONT OF HOUSE - NE ELEVATION (PART) AND NW ELEVATION TO MARKET PL.

SCALE: 1:50 DATE: 4-6-96 JOB: 9215 DWG: L(2) 60(A) REV: AS BUILT

