
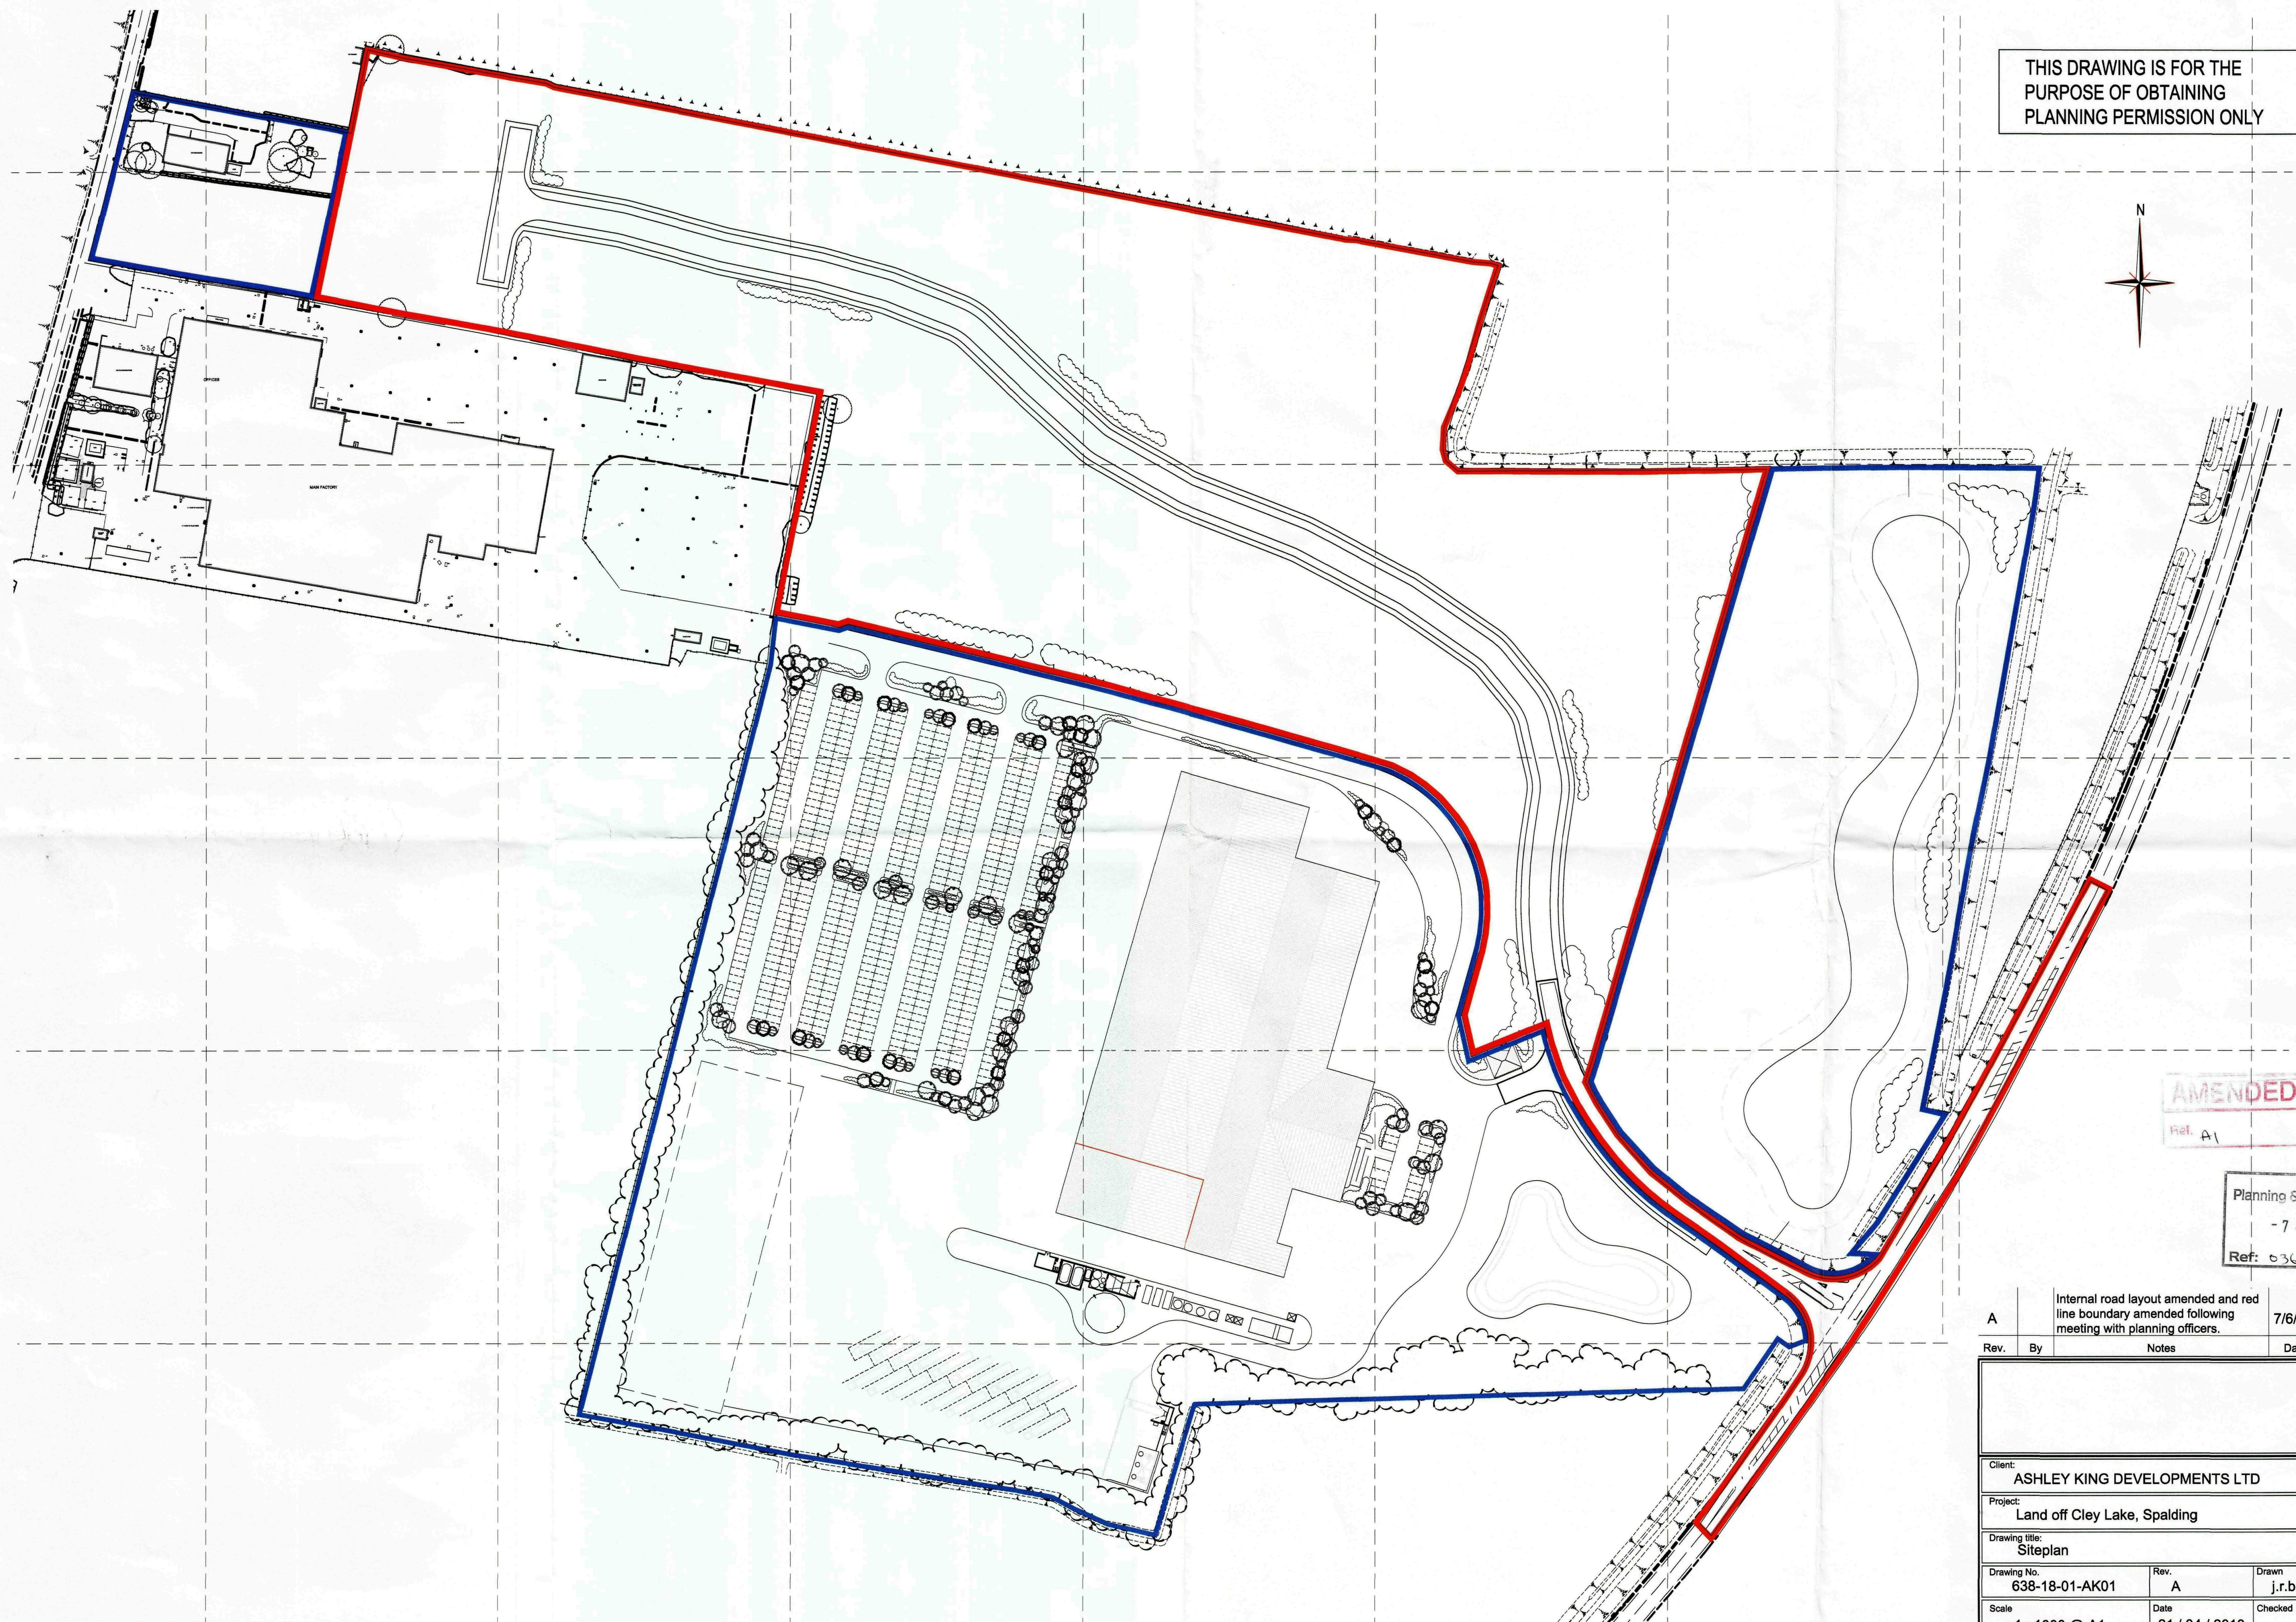


THIS DRAWING IS FOR THE
PURPOSE OF OBTAINING
PLANNING PERMISSION ONLY

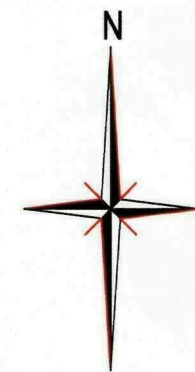

AMENDED PLAN
Ref. A1

SHDC
Planning & Development
- 7 JUL 2010
Ref: 6367-10

A		Internal road layout amended and red line boundary amended following meeting with planning officers.	7/6/10
Rev.	By	Notes	Date

Client: ASHLEY KING DEVELOPMENTS LTD		
Project: Land off Cley Lake, Spalding		
Drawing title: Siteplan		
Drawing No. 638-18-01-AK01	Rev. A	Drawn j.r.b.
Scale 1 : 1000 @ A1	Date 21 / 04 / 2010	Checked

All measurements should be checked against on site conditions and any discrepancies should be brought to the attention of the Robert Douglas Consultancy.