


DIMENSIONS SHOWN ARE WORKED FROM AS MEASURED DIMENSIONS FROM SITE AS BUILT ON 26-02-08

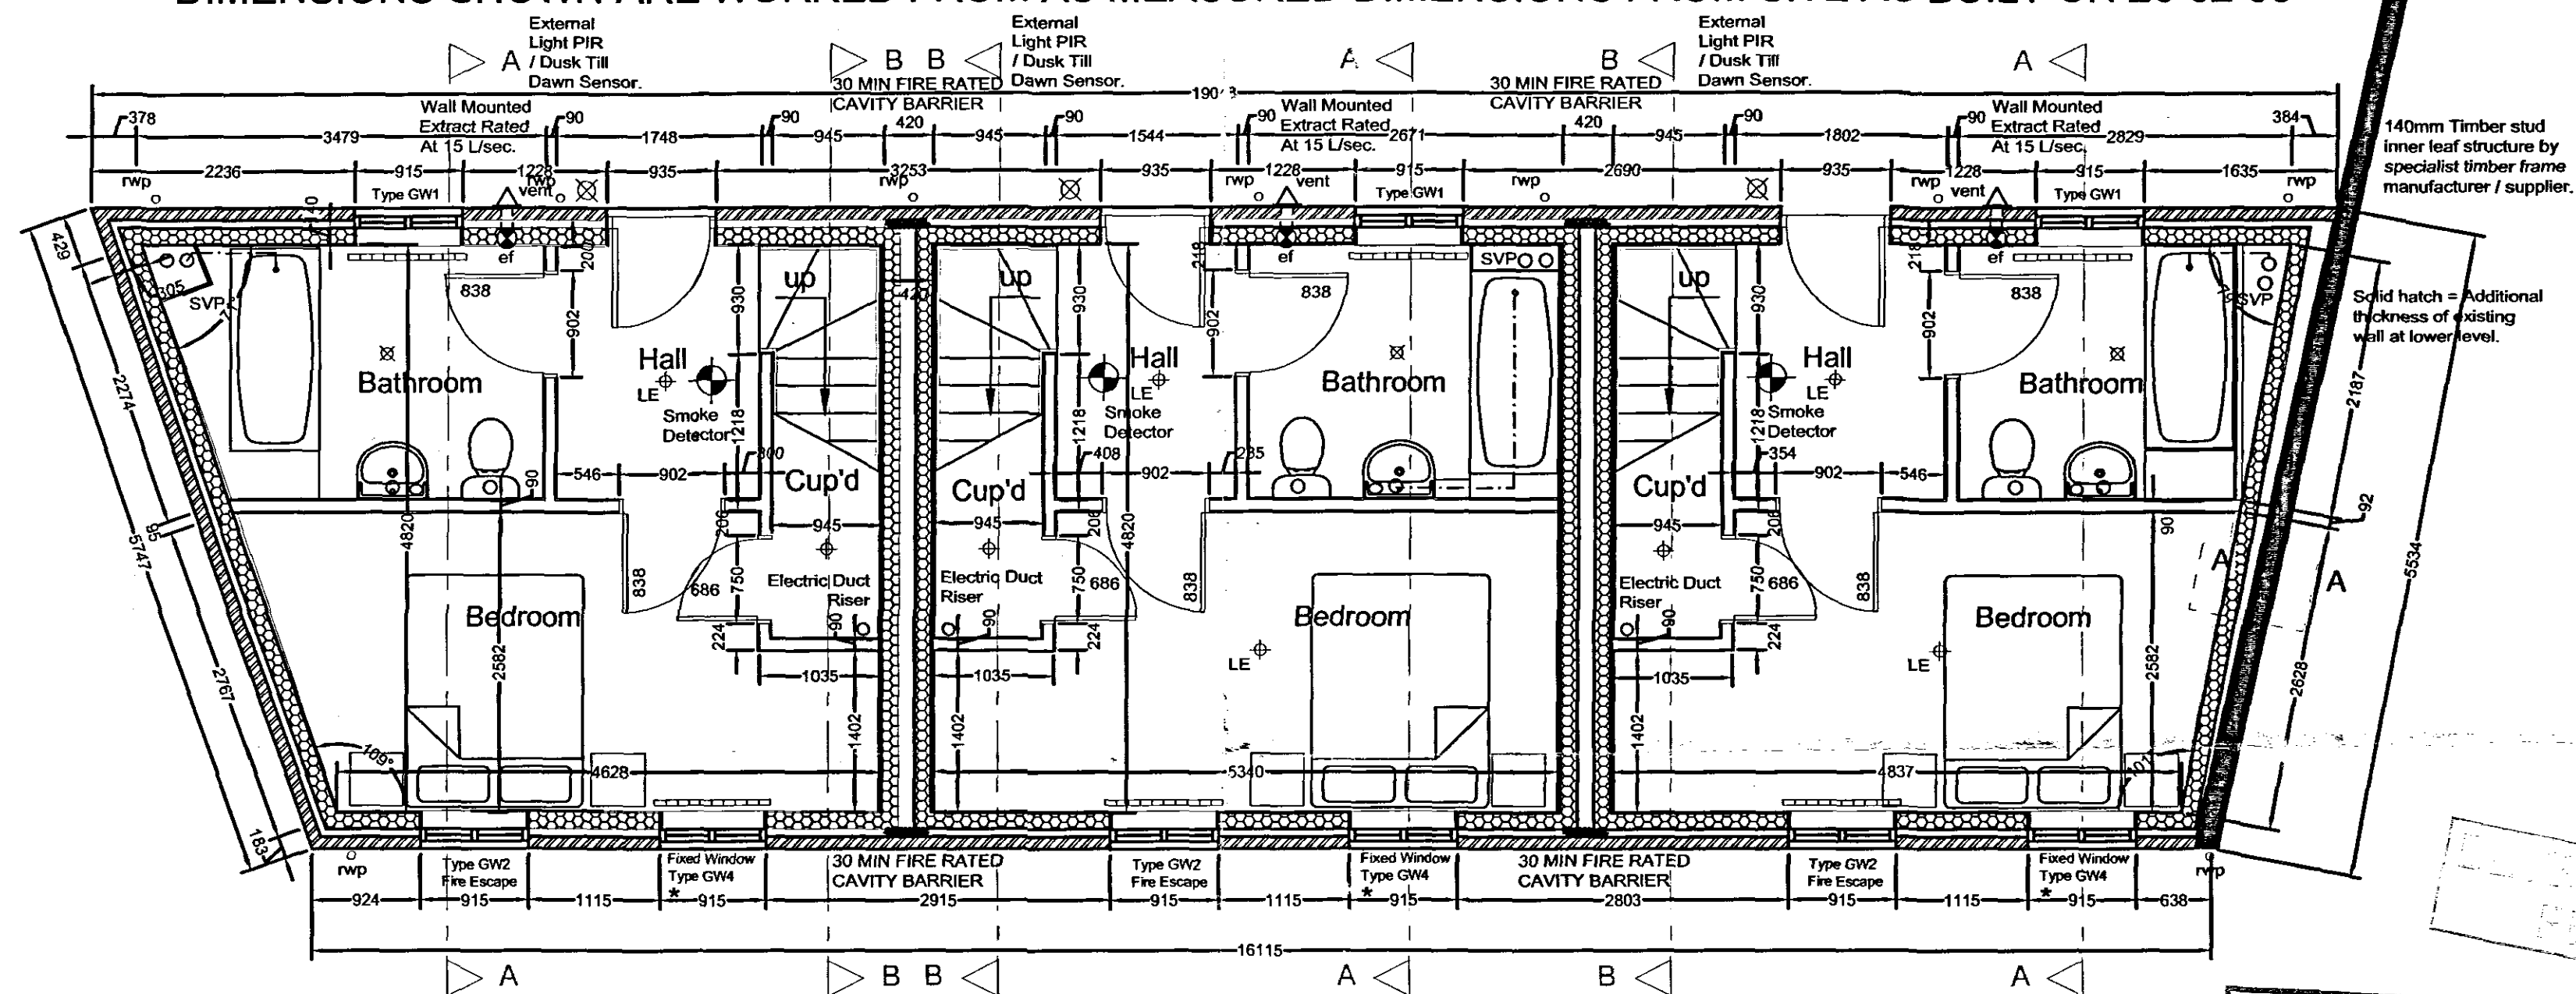

GROUND FLOOR PLAN

* = 3 Nr Fixed windows facing car park to be glazed with intumescent interlayer fire rated glazing to achieve 30 mins fire integrity / insulation protection.

SHDC
Planning & Development
26 MAR 2008
Ref: 0377/08

DIMENSION POSITIONING WALLS ARE ALL EXCLUDING THE PLASTERBOARDING.
EXTENT OF NEW DWELLING FOOTPRINT INCLUDING NEW FOUNDATIONS AND
OVERHANGING GUTTER NOT TO EXCEED BOUNDARY EXTENTS.


Oglesby & Limb Ltd

Chartered Architects
and Building Surveyors

67 London Road
Newark, Notts
NG24 1RZ

Tel: 01636 702030
Fax: 01636 703740

e-mail: design@o-ltd.co.uk

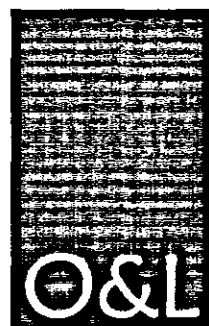

DO NOT SCALE THIS DRAWING. THE CONTRACTOR IS DEEMED TO HAVE CHECKED ALL DIMENSIONS ON SITE AND REPORT ANY DISCREPANCIES TO OGLESBY & LIMB LTD. THE CONTENTS OF THIS DRAWING ARE COVERED BY COPYRIGHT AND REMAIN THE PROPERTY OF OGLESBY & LIMB LTD. WRITTEN APPROVAL MUST BE OBTAINED FROM OGLESBY & LIMB LTD PRIOR TO DUPLICATION OR REPRODUCTION OF THIS DRAWING OR ITS CONTENTS. ANY DIMENSIONS NOT SHOWN ARE TO BE CHECKED AND AGREED WITH OGLESBY & LIMB LTD.

Rev-C - Window type ref's added - 18-03-08 - CLS.

Client:

Inntact Properties.

Project:

The Proposed Conversion of The
Granary to Residential Apartments,
Bedford Place, Spalding.

Drawing Title:

Proposed Ground Floor Layout
Of New Build Affordable Homes

Date: June 2007.

Scale: 1 : 50.

Drawn by: CLS.

Checked by: AJO.

Drawing Number:

A0690 - 50

Rev:

C