


MANAGEMENT PMO FOR PROSIDS PRESENT

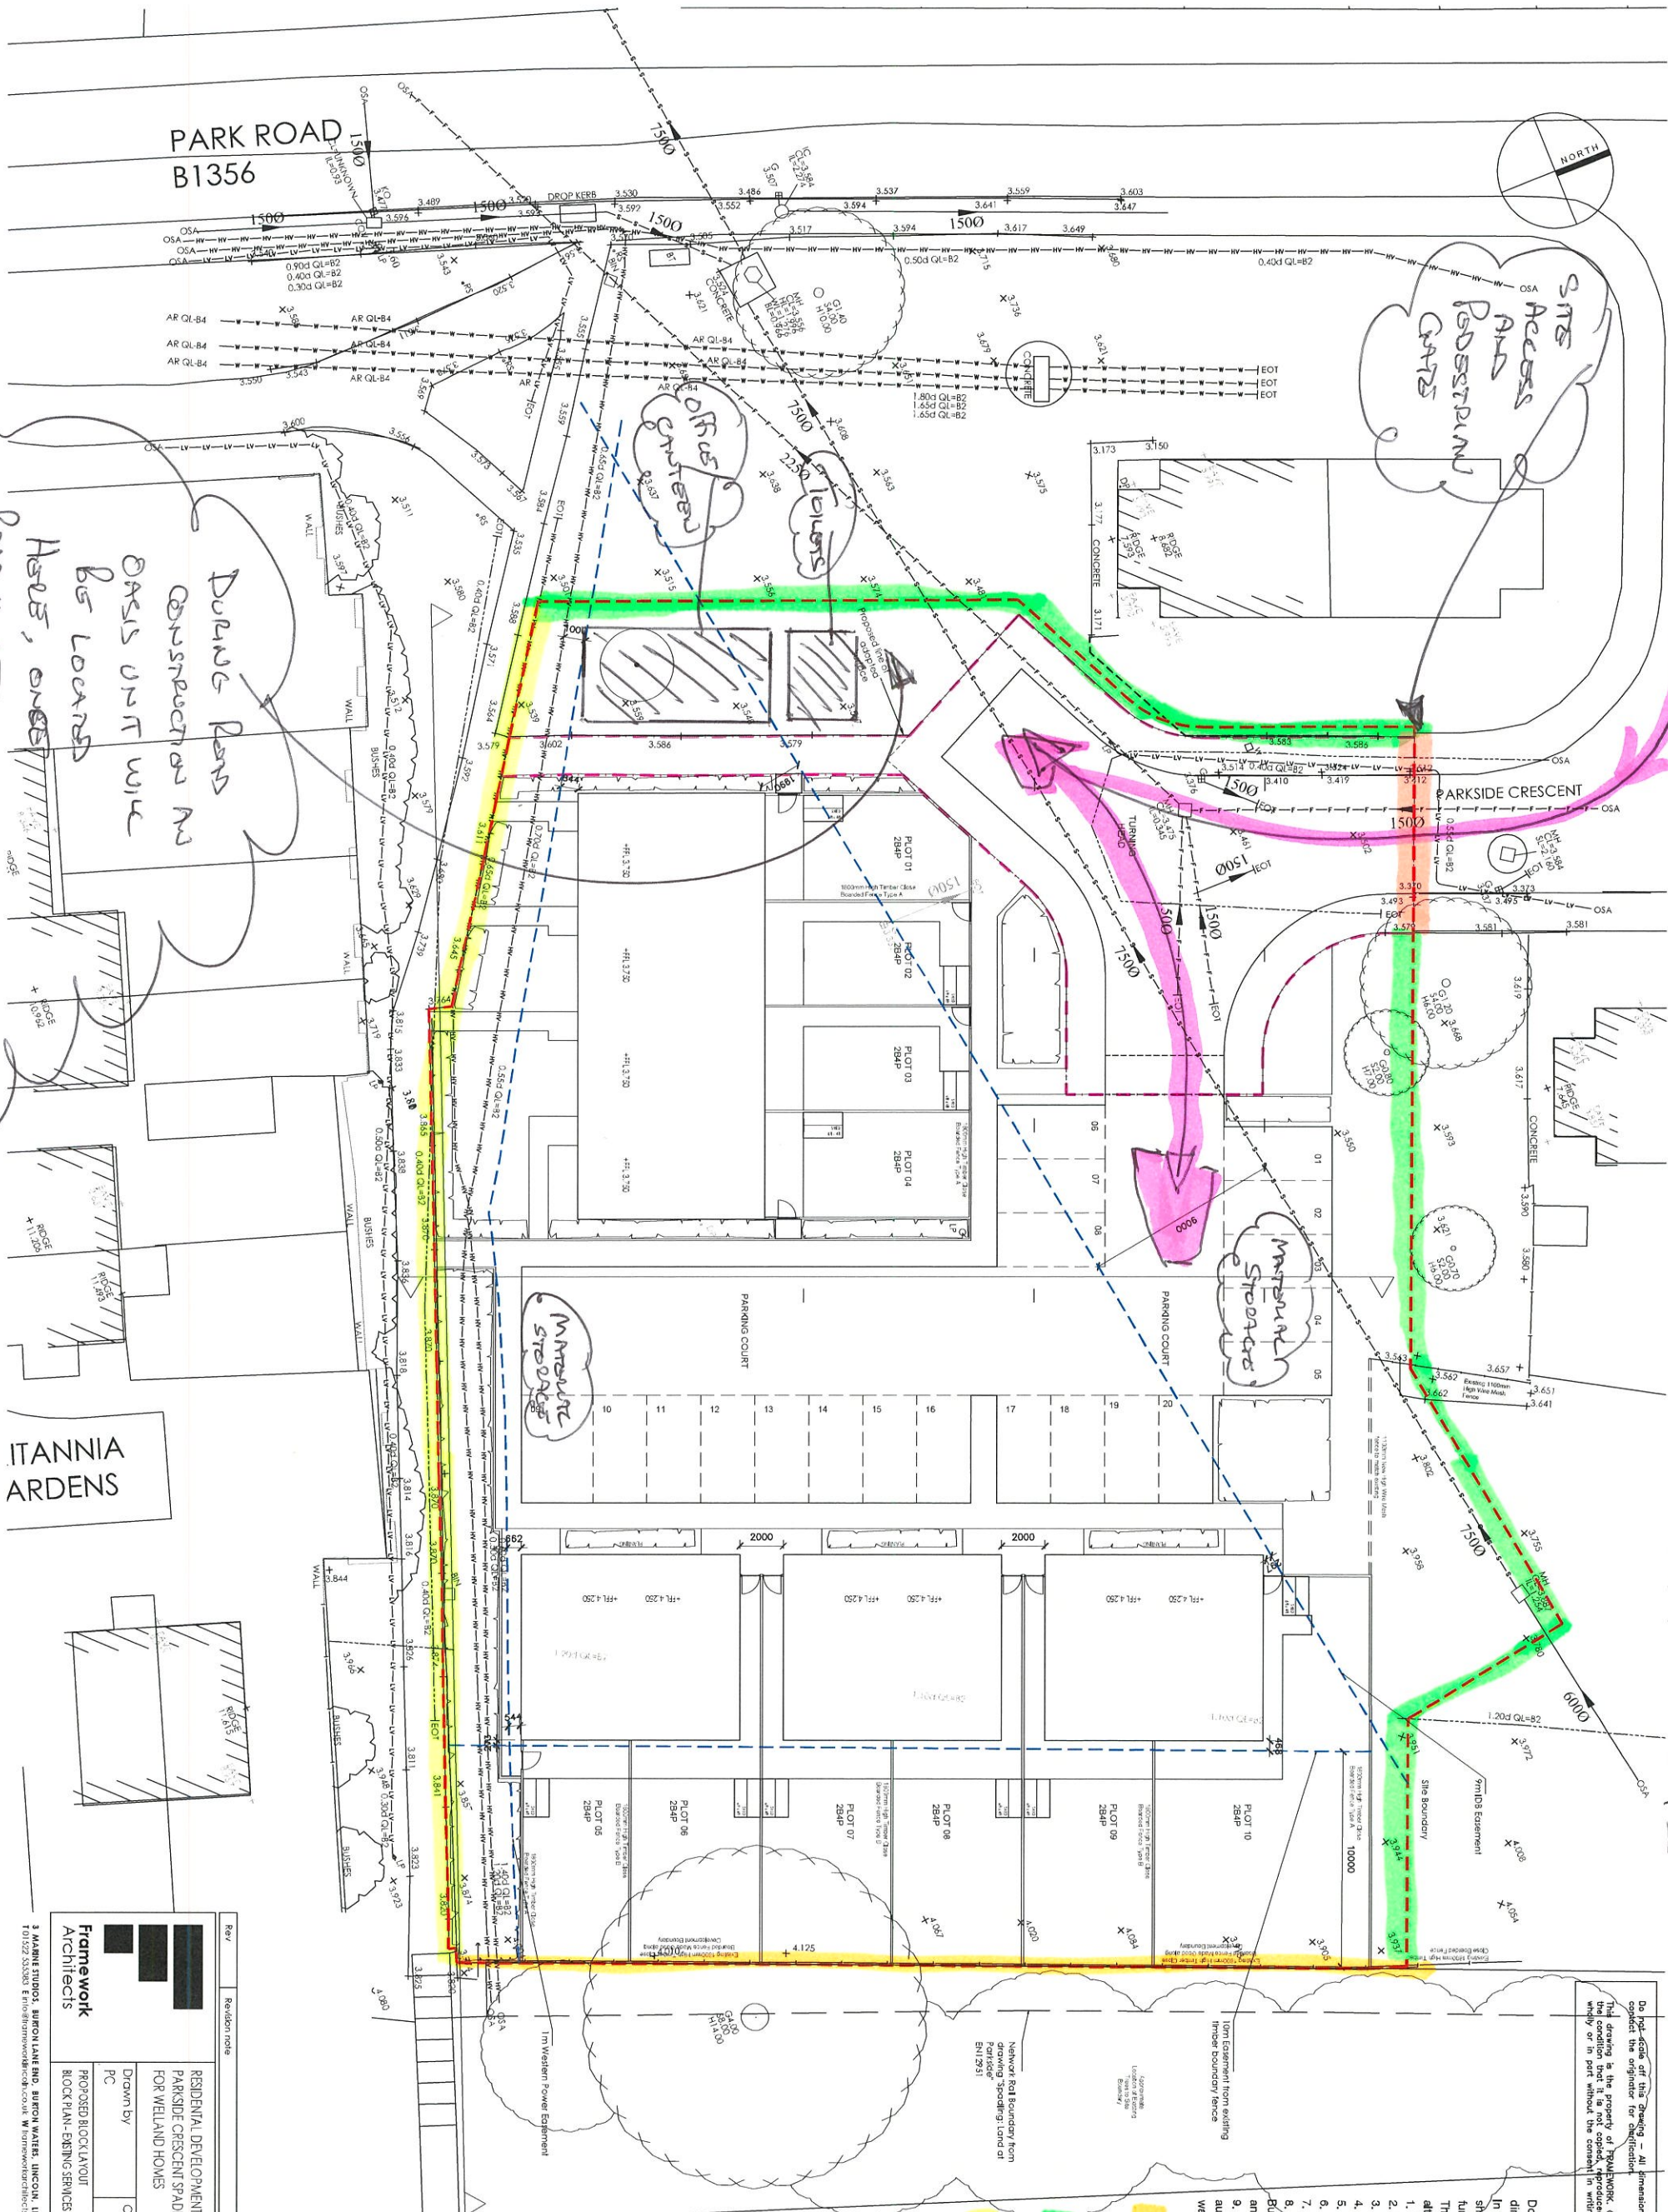

During Pond Construction An OASIS UNIT will be LOCATED HERE, ~~ONCE~~ POND IS AT RIGID, SITE SET UP ~~before~~ OF Accommodation will TAKE PLACE

ITANNIA
ARDENS

Rev	Revision note	Date	Drawn by
	RESIDENTIAL DEVELOPMENT PARADE CRESCENT SPADLING FOR WELAND HOMES		
	Drawn by	Checked	Date
	PC		AUG. 16
	PROPOSED BLOCK LAYOUT BLOCK PLAN - EXISTING SERVICES & EASEMENTS	DWG No	Rev
		J1620 (08) 05	
		Scale	
		1:200 @ A2	

Do not scale off this drawing. All dimensions and setting out to be verified on site. If in doubt consult the engineer for clarification.

This drawing is the property of PEARLWORK. Copyright is reserved by them and the drawing is based on the condition that it is not copied, reproduced, modified or disclosed to any unauthorised person, either orally or in print without the written consent of PEARLWORK.

Do not scale from this drawing or consider any dimension or room position as accurate. In the event of any discrepancy being found, these should be brought to the attention of the Architect for further instruction. If in doubt ask!

The proposed layouts are subject to the following:

1. although not exhaustive.
2. Further client design development
3. Structural Engineer Requirements.
4. Mechanical and Electrical Engineers Requirements.
5. Drainage Engineer Requirement.
6. Landscape Architect Requirements.
7. Highway Engineer Requirements.
8. local Authority Planning/Conservation/Highways/ Building Control dept. and Fire Officer vetting notes and approvals and agreements.
9. Approvals and agreements of all statutory authorities and undertakers necessary for all supplies, way, leaves and diversions.

Item Escamont from existing perimeter boundary fence

Existing network
Rail Fence
Heads Fencing
Solid Meme
Hoarding.