



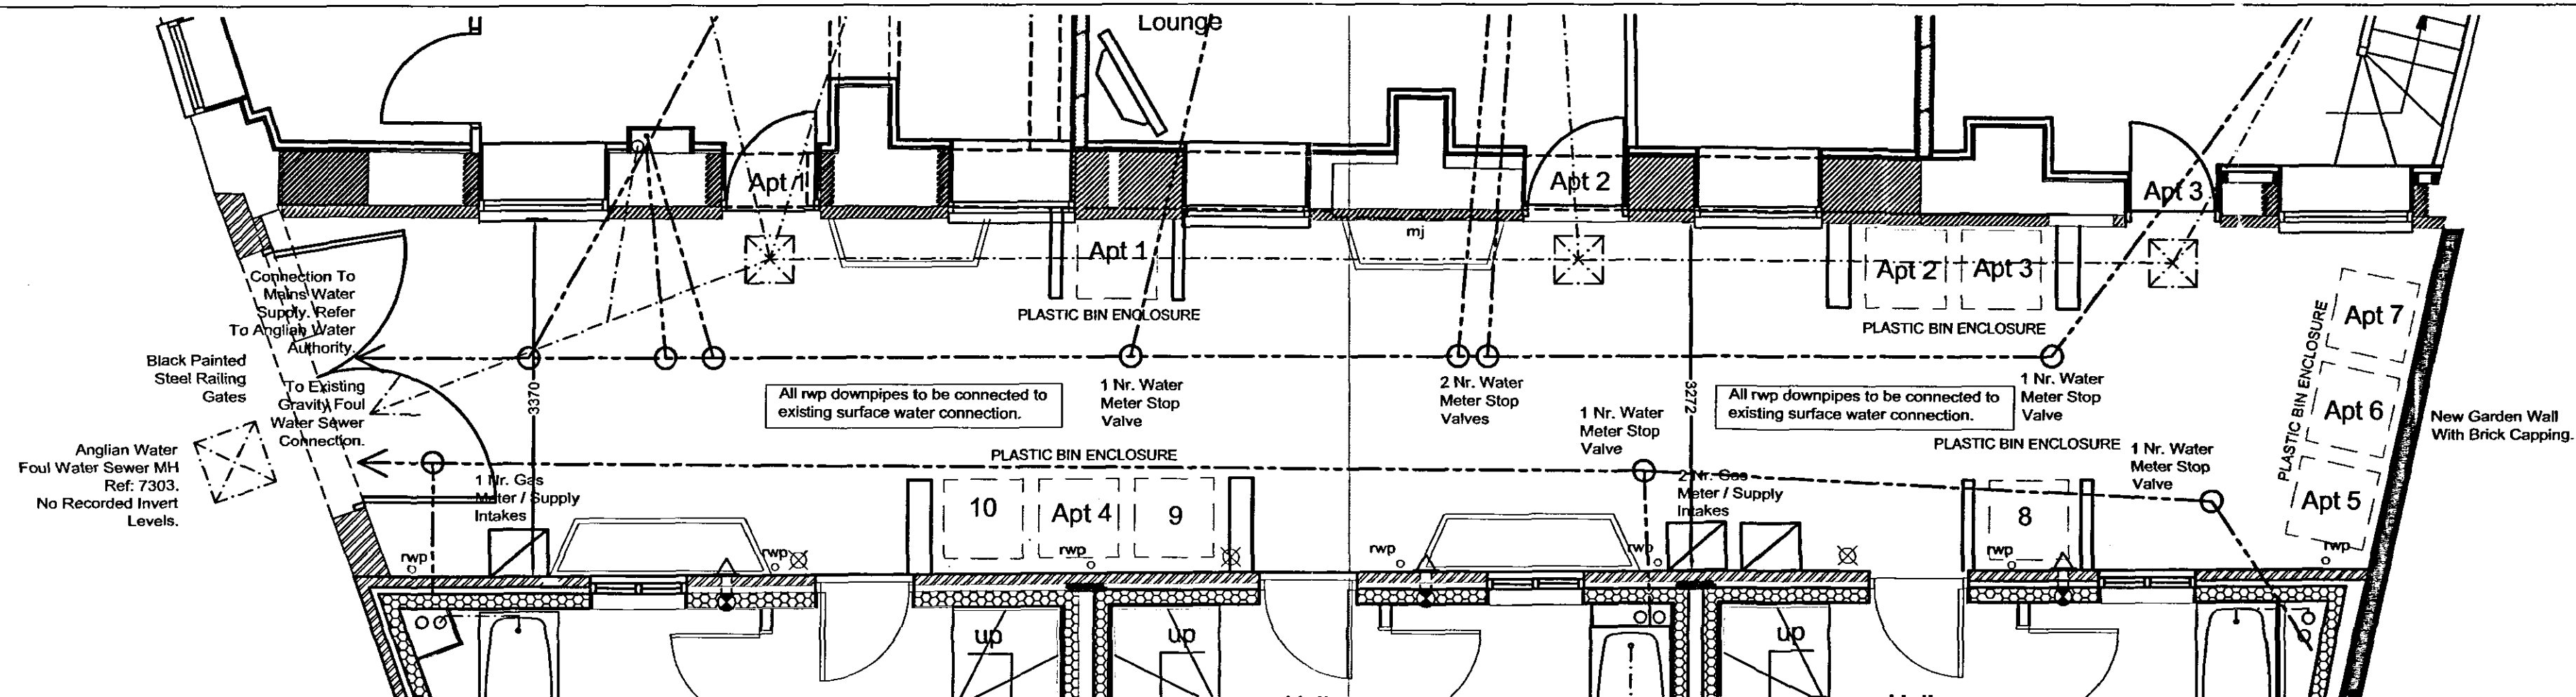

Proposed Courtyard Layout - (Scale = 1 to 50)

Drainage runs to 3 Nr new build to be indicated on a marked up drawing by site.

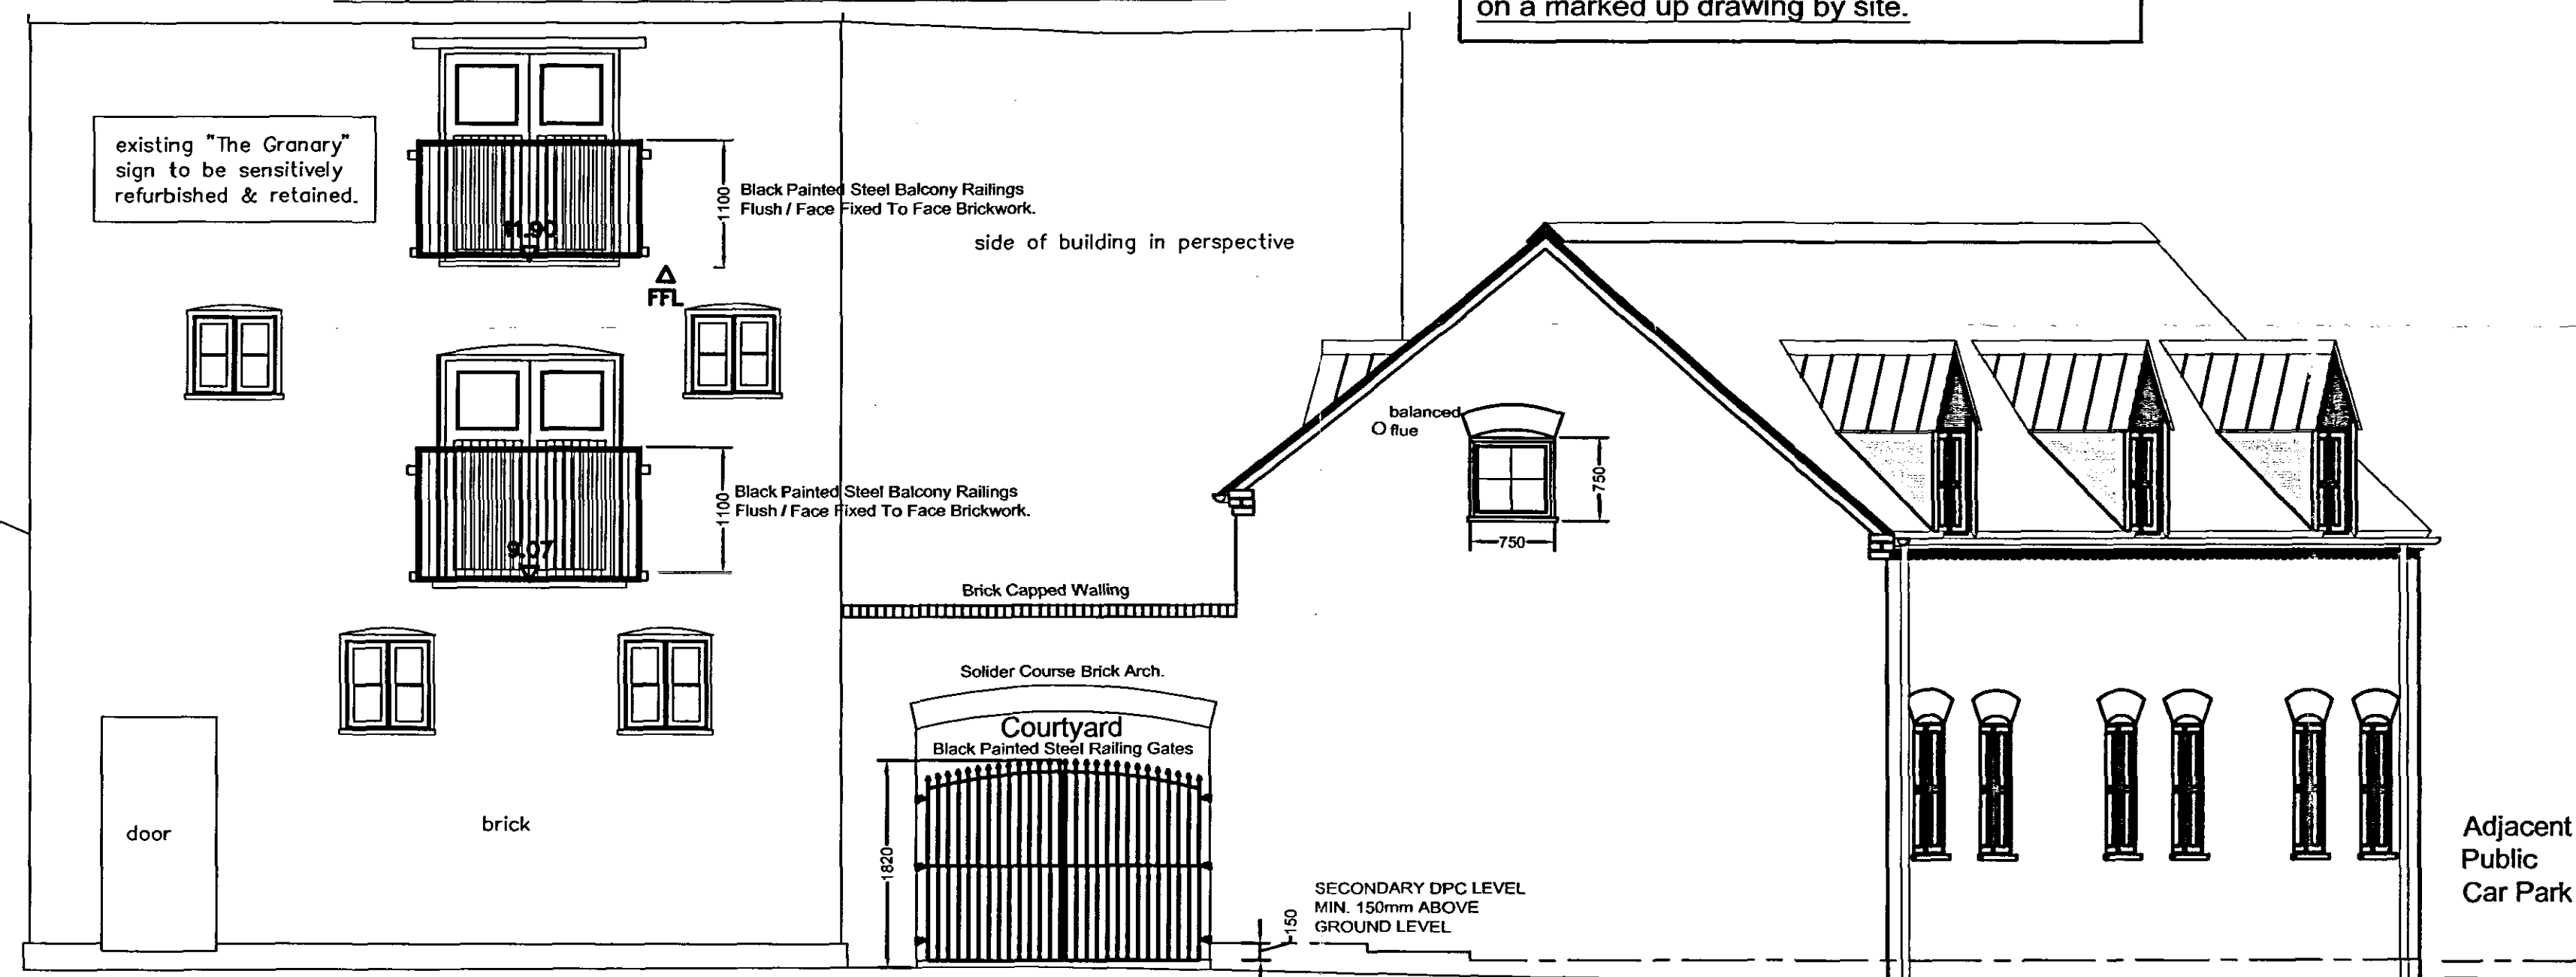

Elevation (Towards Bedford Place) - (Scale = 1 to 50)

SHDC
Planning & Development
- 2 MAY 2008
Ref: 0548/08

Adjacent
Public
Car Park

DETERMINED
PLAN

Oglesby & Limb Ltd

Chartered Architects
and Building Surveyors

67 London Road
Newark, Notts
NG24 1RZ

Tel: 01636 702030
Fax: 01636 703740

e-mail: design@o-l-ltd.co.uk



DO NOT SCALE THIS DRAWING. THE CONTRACTOR IS DEEMED TO HAVE CHECKED ALL DIMENSIONS ON SITE AND REPORT ANY DISCREPANCIES TO OGLESBY & LIMB LTD. THE CONTENTS OF THIS DRAWING ARE COVERED BY COPYRIGHT AND REMAIN THE PROPERTY OF OGLESBY & LIMB LTD. WRITTEN APPROVAL MUST BE OBTAINED FROM OGLESBY & LIMB LTD PRIOR TO DUPLICATION OR REPRODUCTION OF THIS DRAWING OR ITS CONTENTS. ANY DIMENSIONS NOT SHOWN ARE TO BE CHECKED AND AGREED WITH OGLESBY & LIMB LTD.

Rev-B - Gable window altered as per discussion with Planning Officer.
Footprint revised to AS BUILT dimensions with 140mm party wall cavity
and new build parallel with The Granary AS BUILT - 26-02-08 - CLS.

Rev-C - Gable window revised to AS BUILT position - 23-04-08 - CLS.

Client:

Inntact Properties.

Project:

The Proposed Conversion of The
Granary to Residential Apartments,
Bedford Place, Spalding.

Drawing Title:

Proposed Courtyard Layout

Date: Oct 2007.

Scale: 1:50

Drawn by: CLS.

Checked by: AJO.

Drawing Number:

A0690 - 62

Rev:

C