
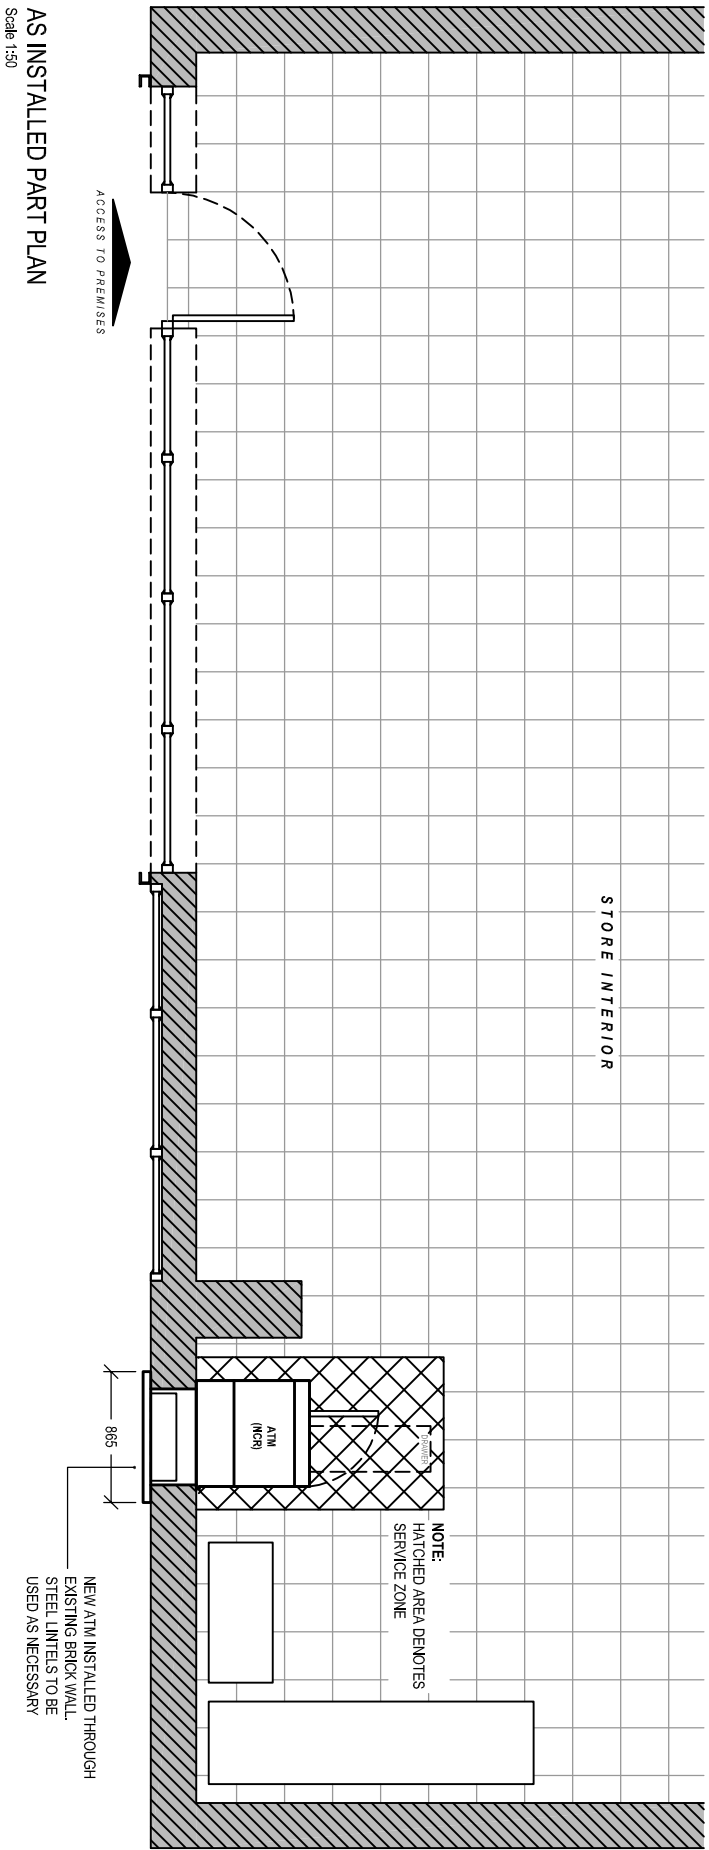


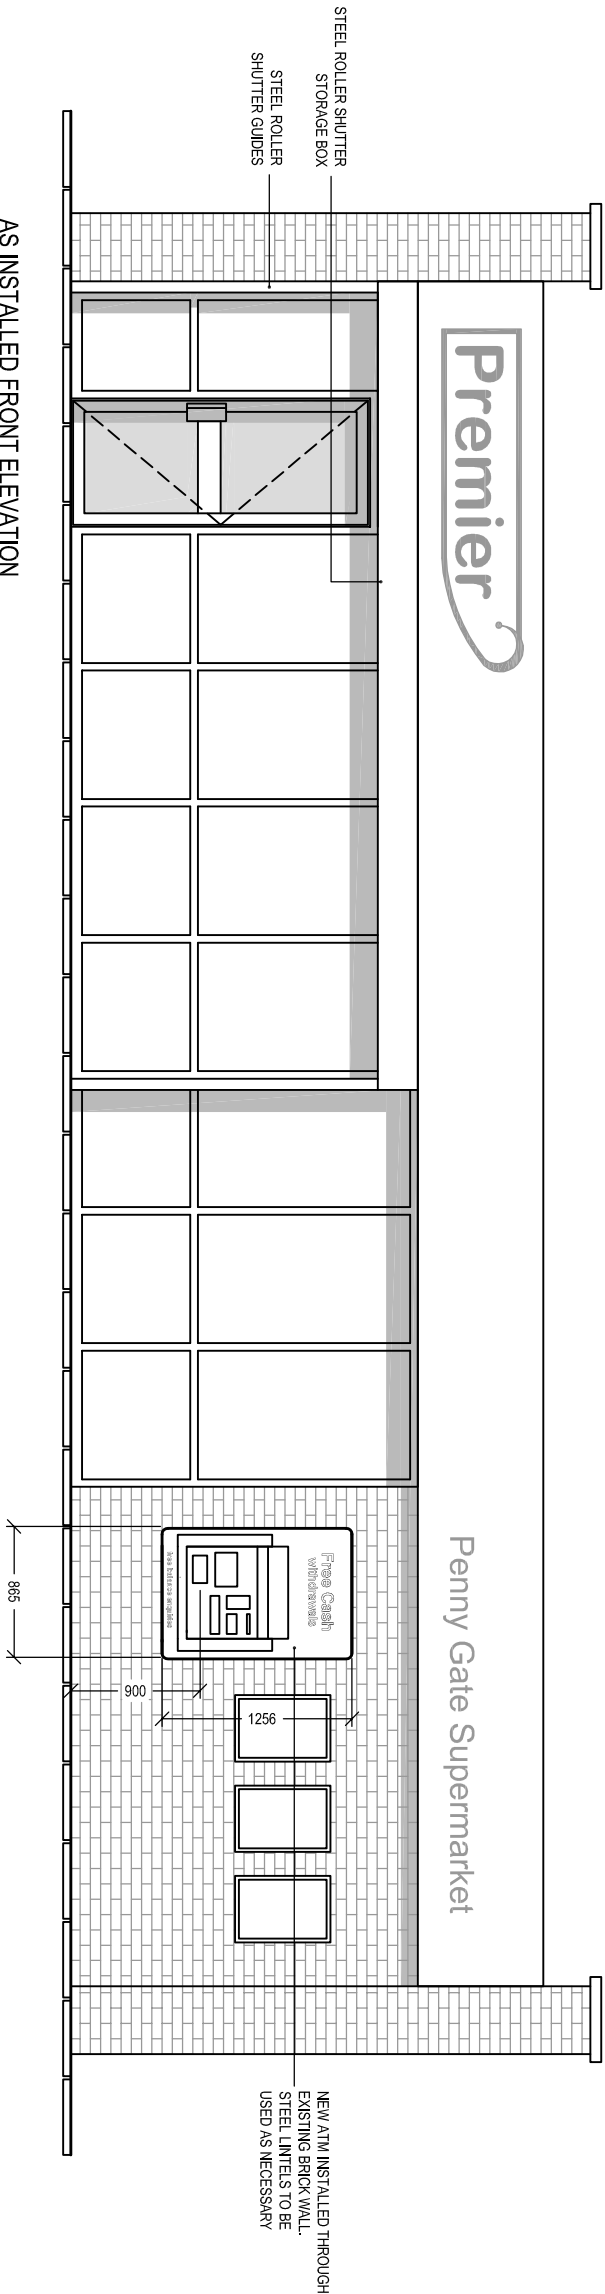

Date: _____

Comments: _____

By: _____

GENERAL NOTES:

1) All dimensions in millimeters unless otherwise stated.

Site:

PREMIER

201 Pennygate
Spalding
PE11 1LX

Drawing Title:

As Installed Elevations and Plans

Ref:	Date:	Rev:
NMA-06-2015-94-2	28-06-2015	

Scale:	Paper:	Date Rev:
1:50	A3	