



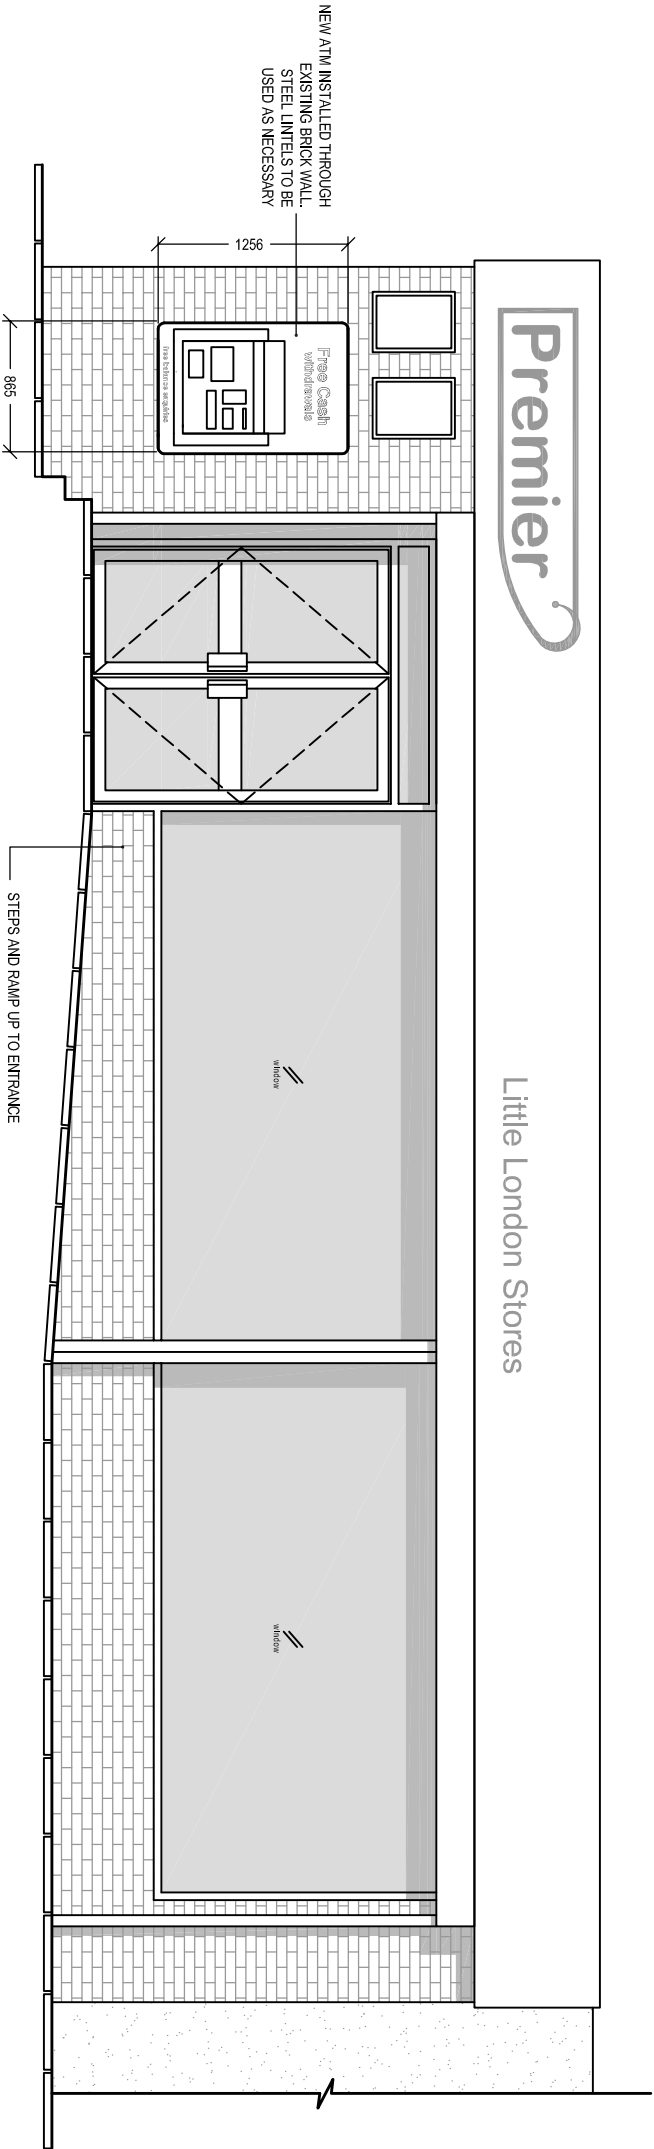

AS INSTALLED FRONT ELEVATION

Scale 1:50

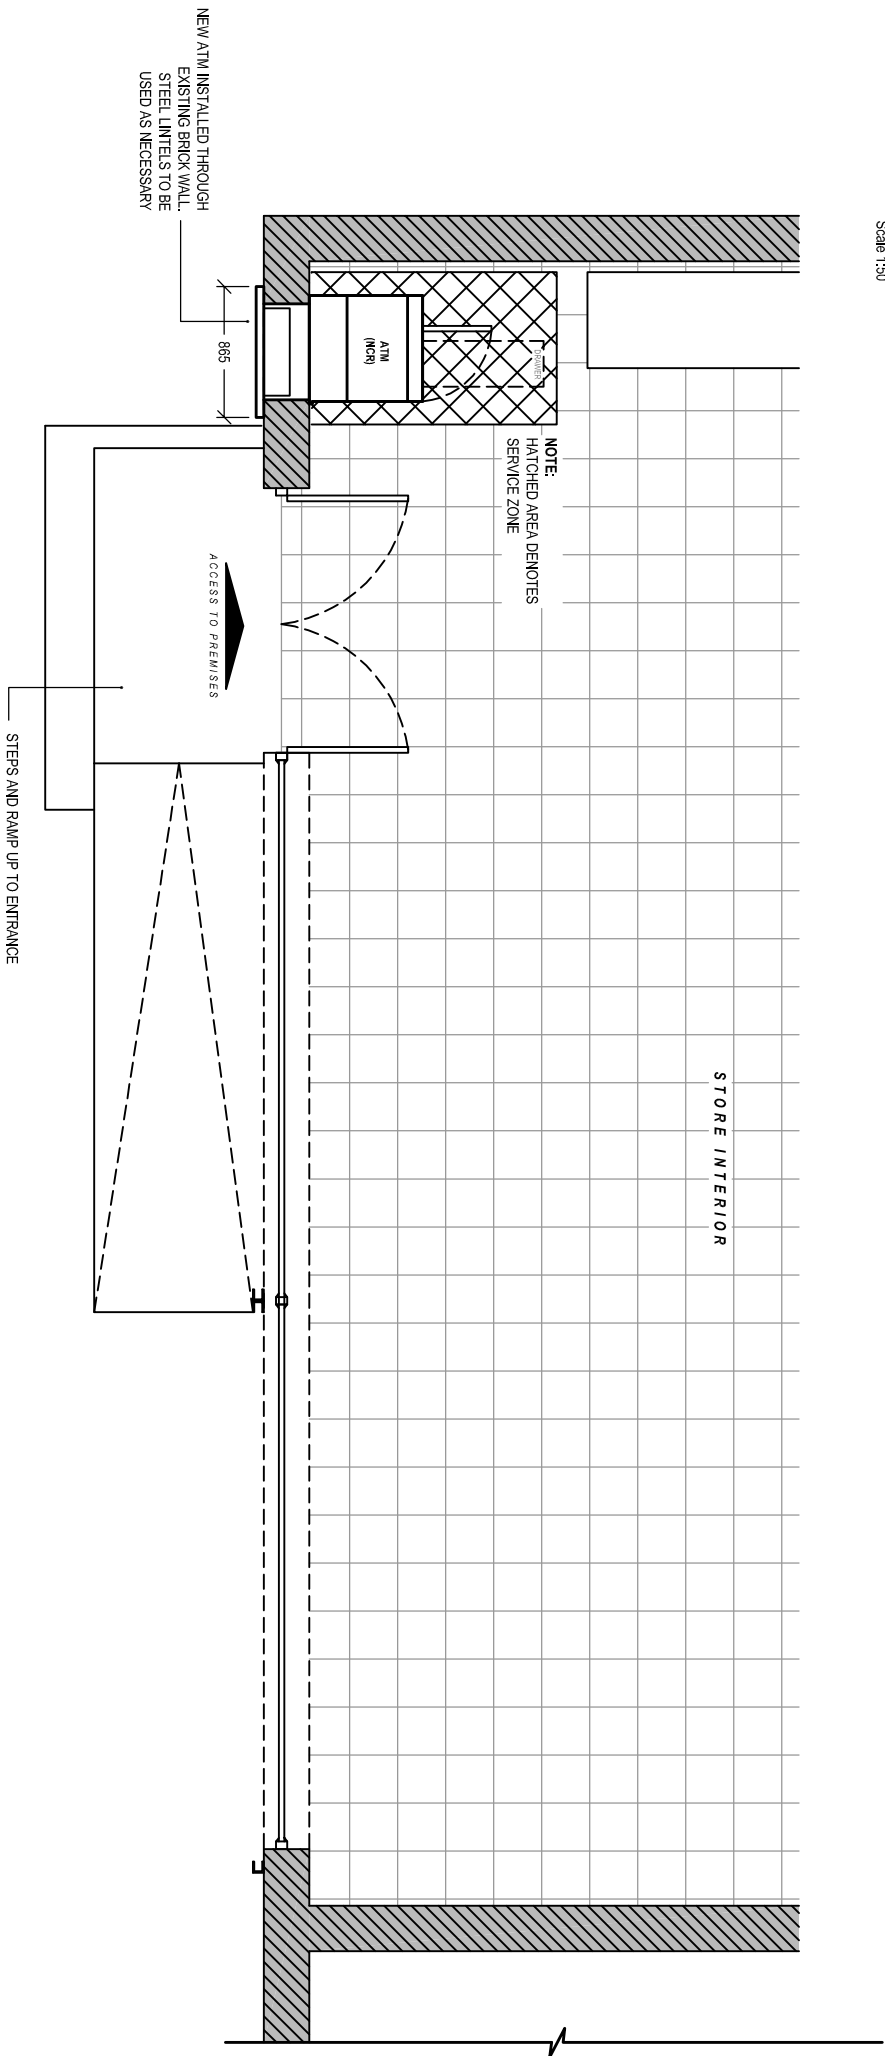

AS INSTALLED PART PLAN

Scale 1:50

Drawing Title:			
As Installed Elevations and Plans			
Ref:	Date:	Rev:	
NM-06-2015-93-2	28-06-2015		
Scale:	Paper:	Date Rev:	
1:50	A3		

Date:	Comments:	By:

GENERAL NOTES:
1) All dimensions in millimeters unless otherwise stated.

Site:
PREMIER
88 Little London
Spalding
PE11 2UJ