



AREA TO WHICH APPLICATION RELATES

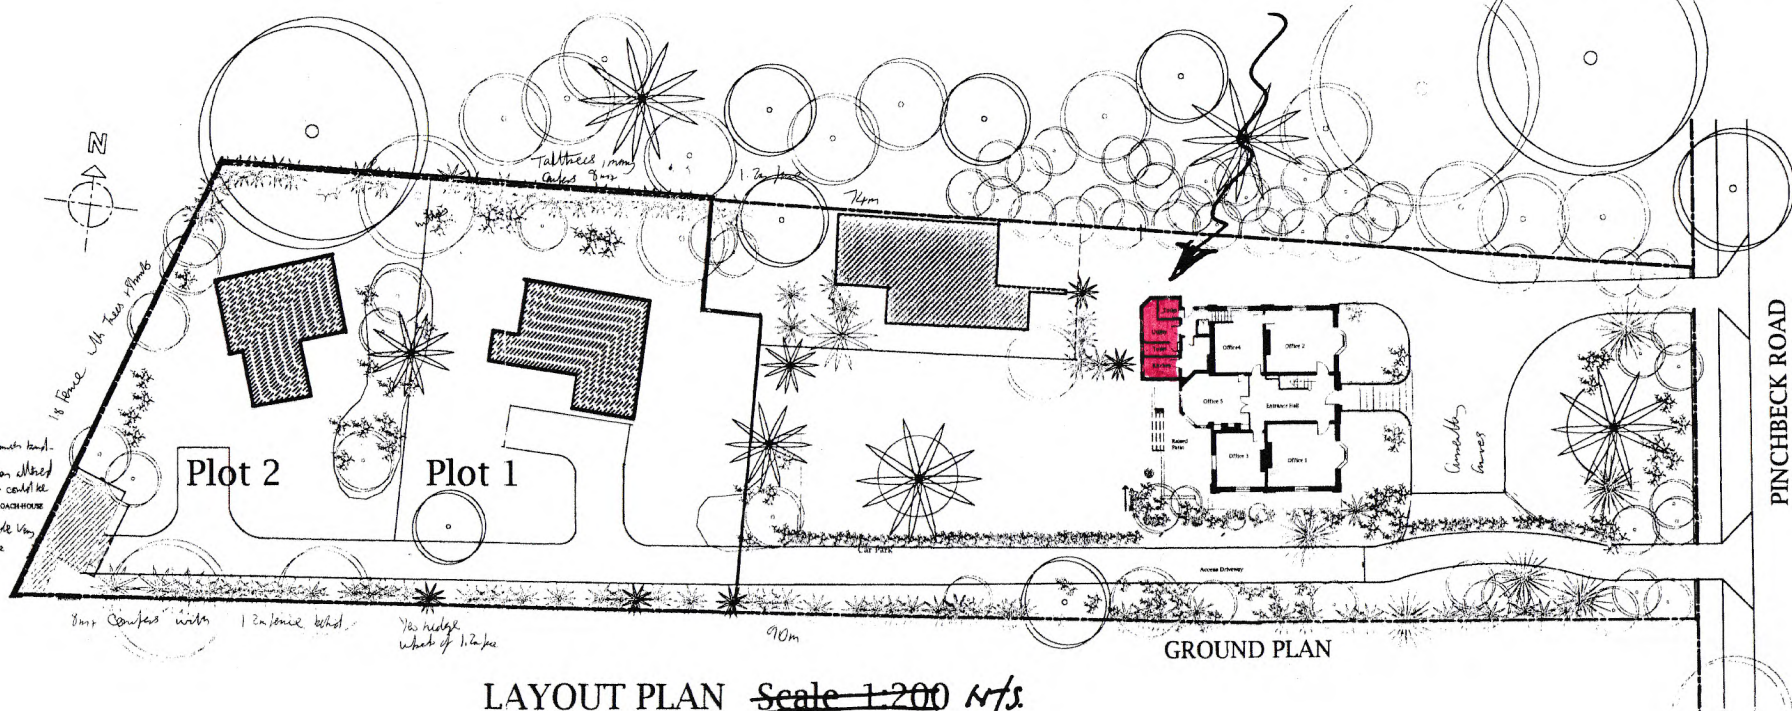

LAYOUT PLAN ~~Scale 1:200~~ N/S.

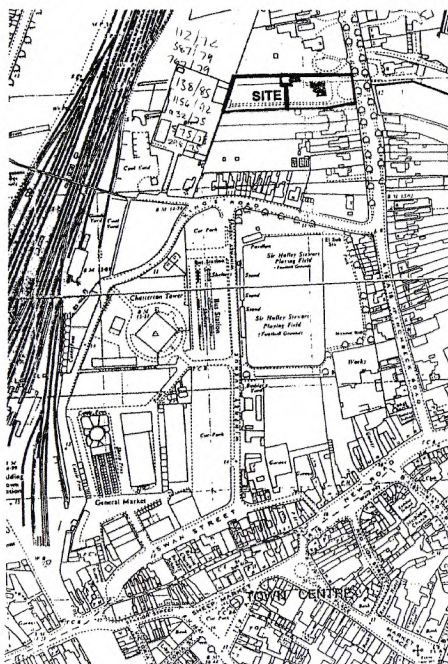

LOCATION PLAN
~~Scale: 1:1250~~

1: 2500 Gnds ac
100m.

