




Contractor to check all Dimensions on site prior to ordering materials / commencing work.Do Not Scale from this Drawing - If in doubt then please ask

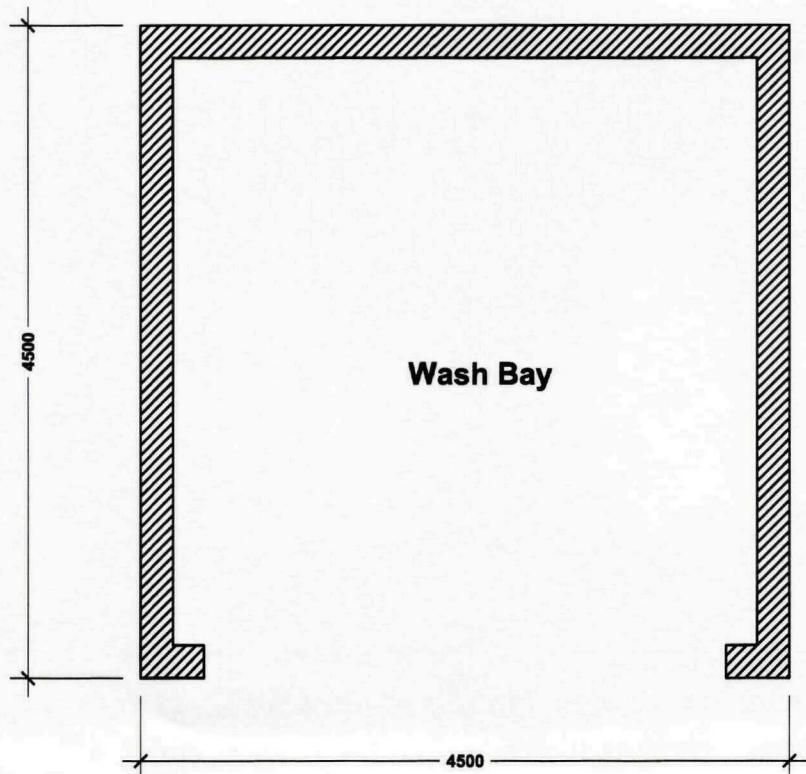

Existing Ground Floor Plan
Scale 1:50

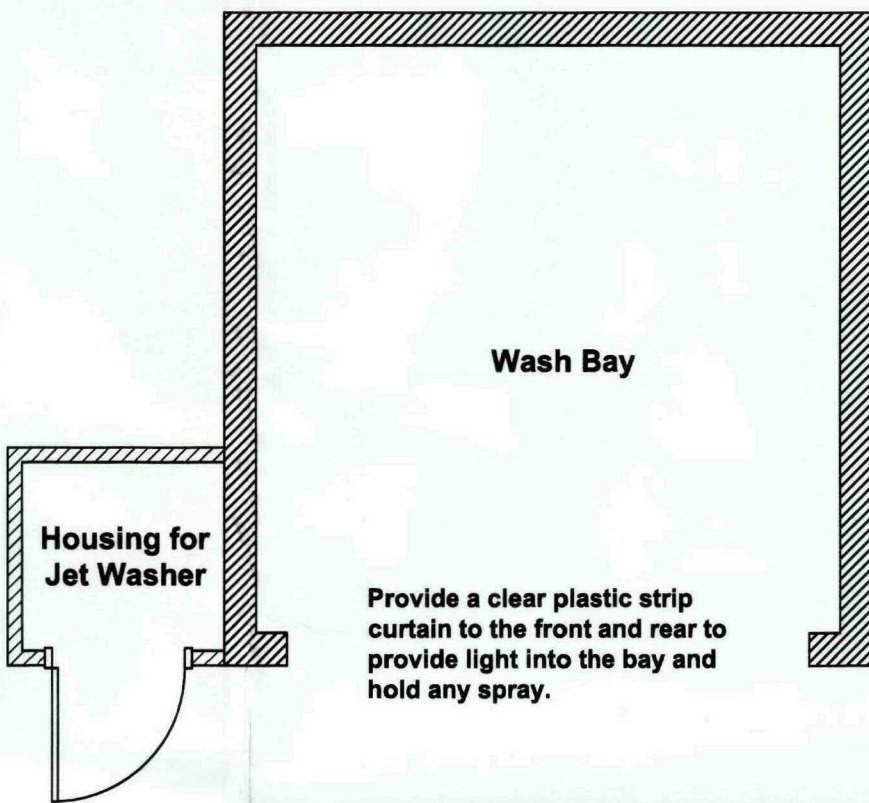


Proposed Ground Floor Plan
Scale 1:50

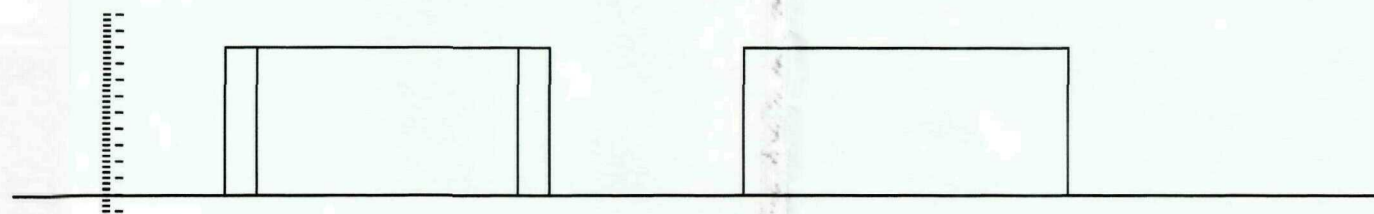

Front Elevation
Scale 1:100

Side Elevation
Scale 1:100

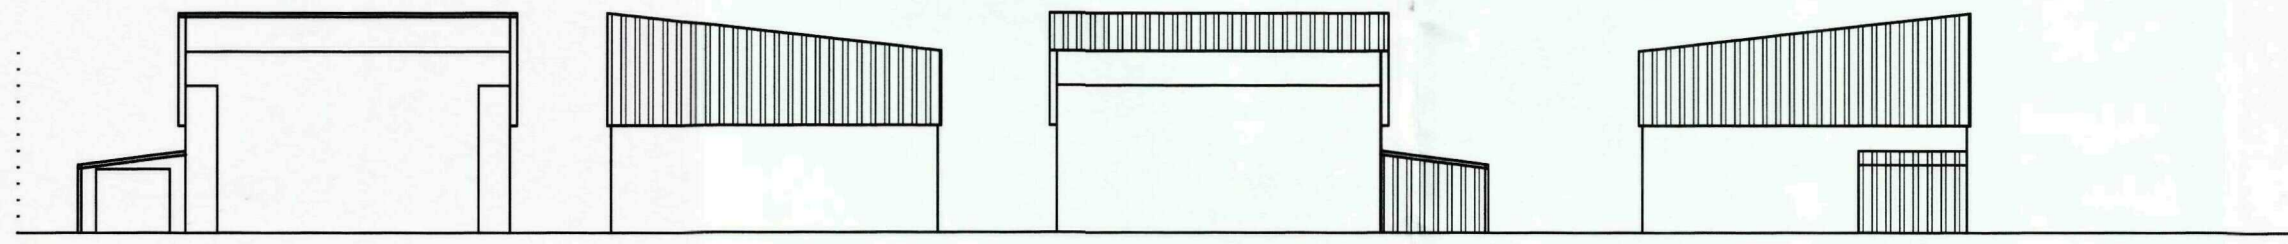

Front Elevation
Scale 1:100

Side Elevation
Scale 1:100

Rear Elevation
Scale 1:100

Side Elevation
Scale 1:100



rev "A" - 15.09.10 - Amended to suit As-Built condition on site

GENERAL CONDITIONS
Contractors are responsible for checking all dimensions on site when work commences and before ordering any materials. Any discrepancies should be brought to the attention of the Client for remedial action before commencing further.

All details shown are based on typical site conditions for that area, any abnormal conditions should be brought to the attention of the Client and Local Authority.

The notes shown are mainly to cover the requirements of Building Regulations and should not be treated as full specification.

No allowance has been made for any Structural Calculations, a "SAP" calculation, Soil Investigation or Flood Risk Assessment. If deemed necessary then these will be a chargeable extra. All steel beam sizes shown on drawing are all subject to confirmation from Structural Engineer.

All materials not specified to be of a standard suitable for the work proposed and be fit for purpose. All work to be in accordance with good building practice and all necessary BS codes for Workmanship on Building Sites.

Client :
Shoebridge Engineering
Kellett Gate
Low Fulney
Spalding
PE12 6EH

Site :
Jet Wash Housing Bay

Drawing Title
Existing and Proposed Details


remway
Design Ltd
2nd Floor - 5 Sheepmarket
Spalding
P E 11 1 B H
Tel : 01775 768 921
e-mail: enquiries@remwaydesign.co.uk

July06 Scale : As Noted

1667 - 01A

PLEASE NOTE:
Due to areas of the structure being covered, unexposed or otherwise inaccessible the notes / specifications of existing materials are subject to confirmation of site when it is feasible to expose the relevant areas of construction.

