
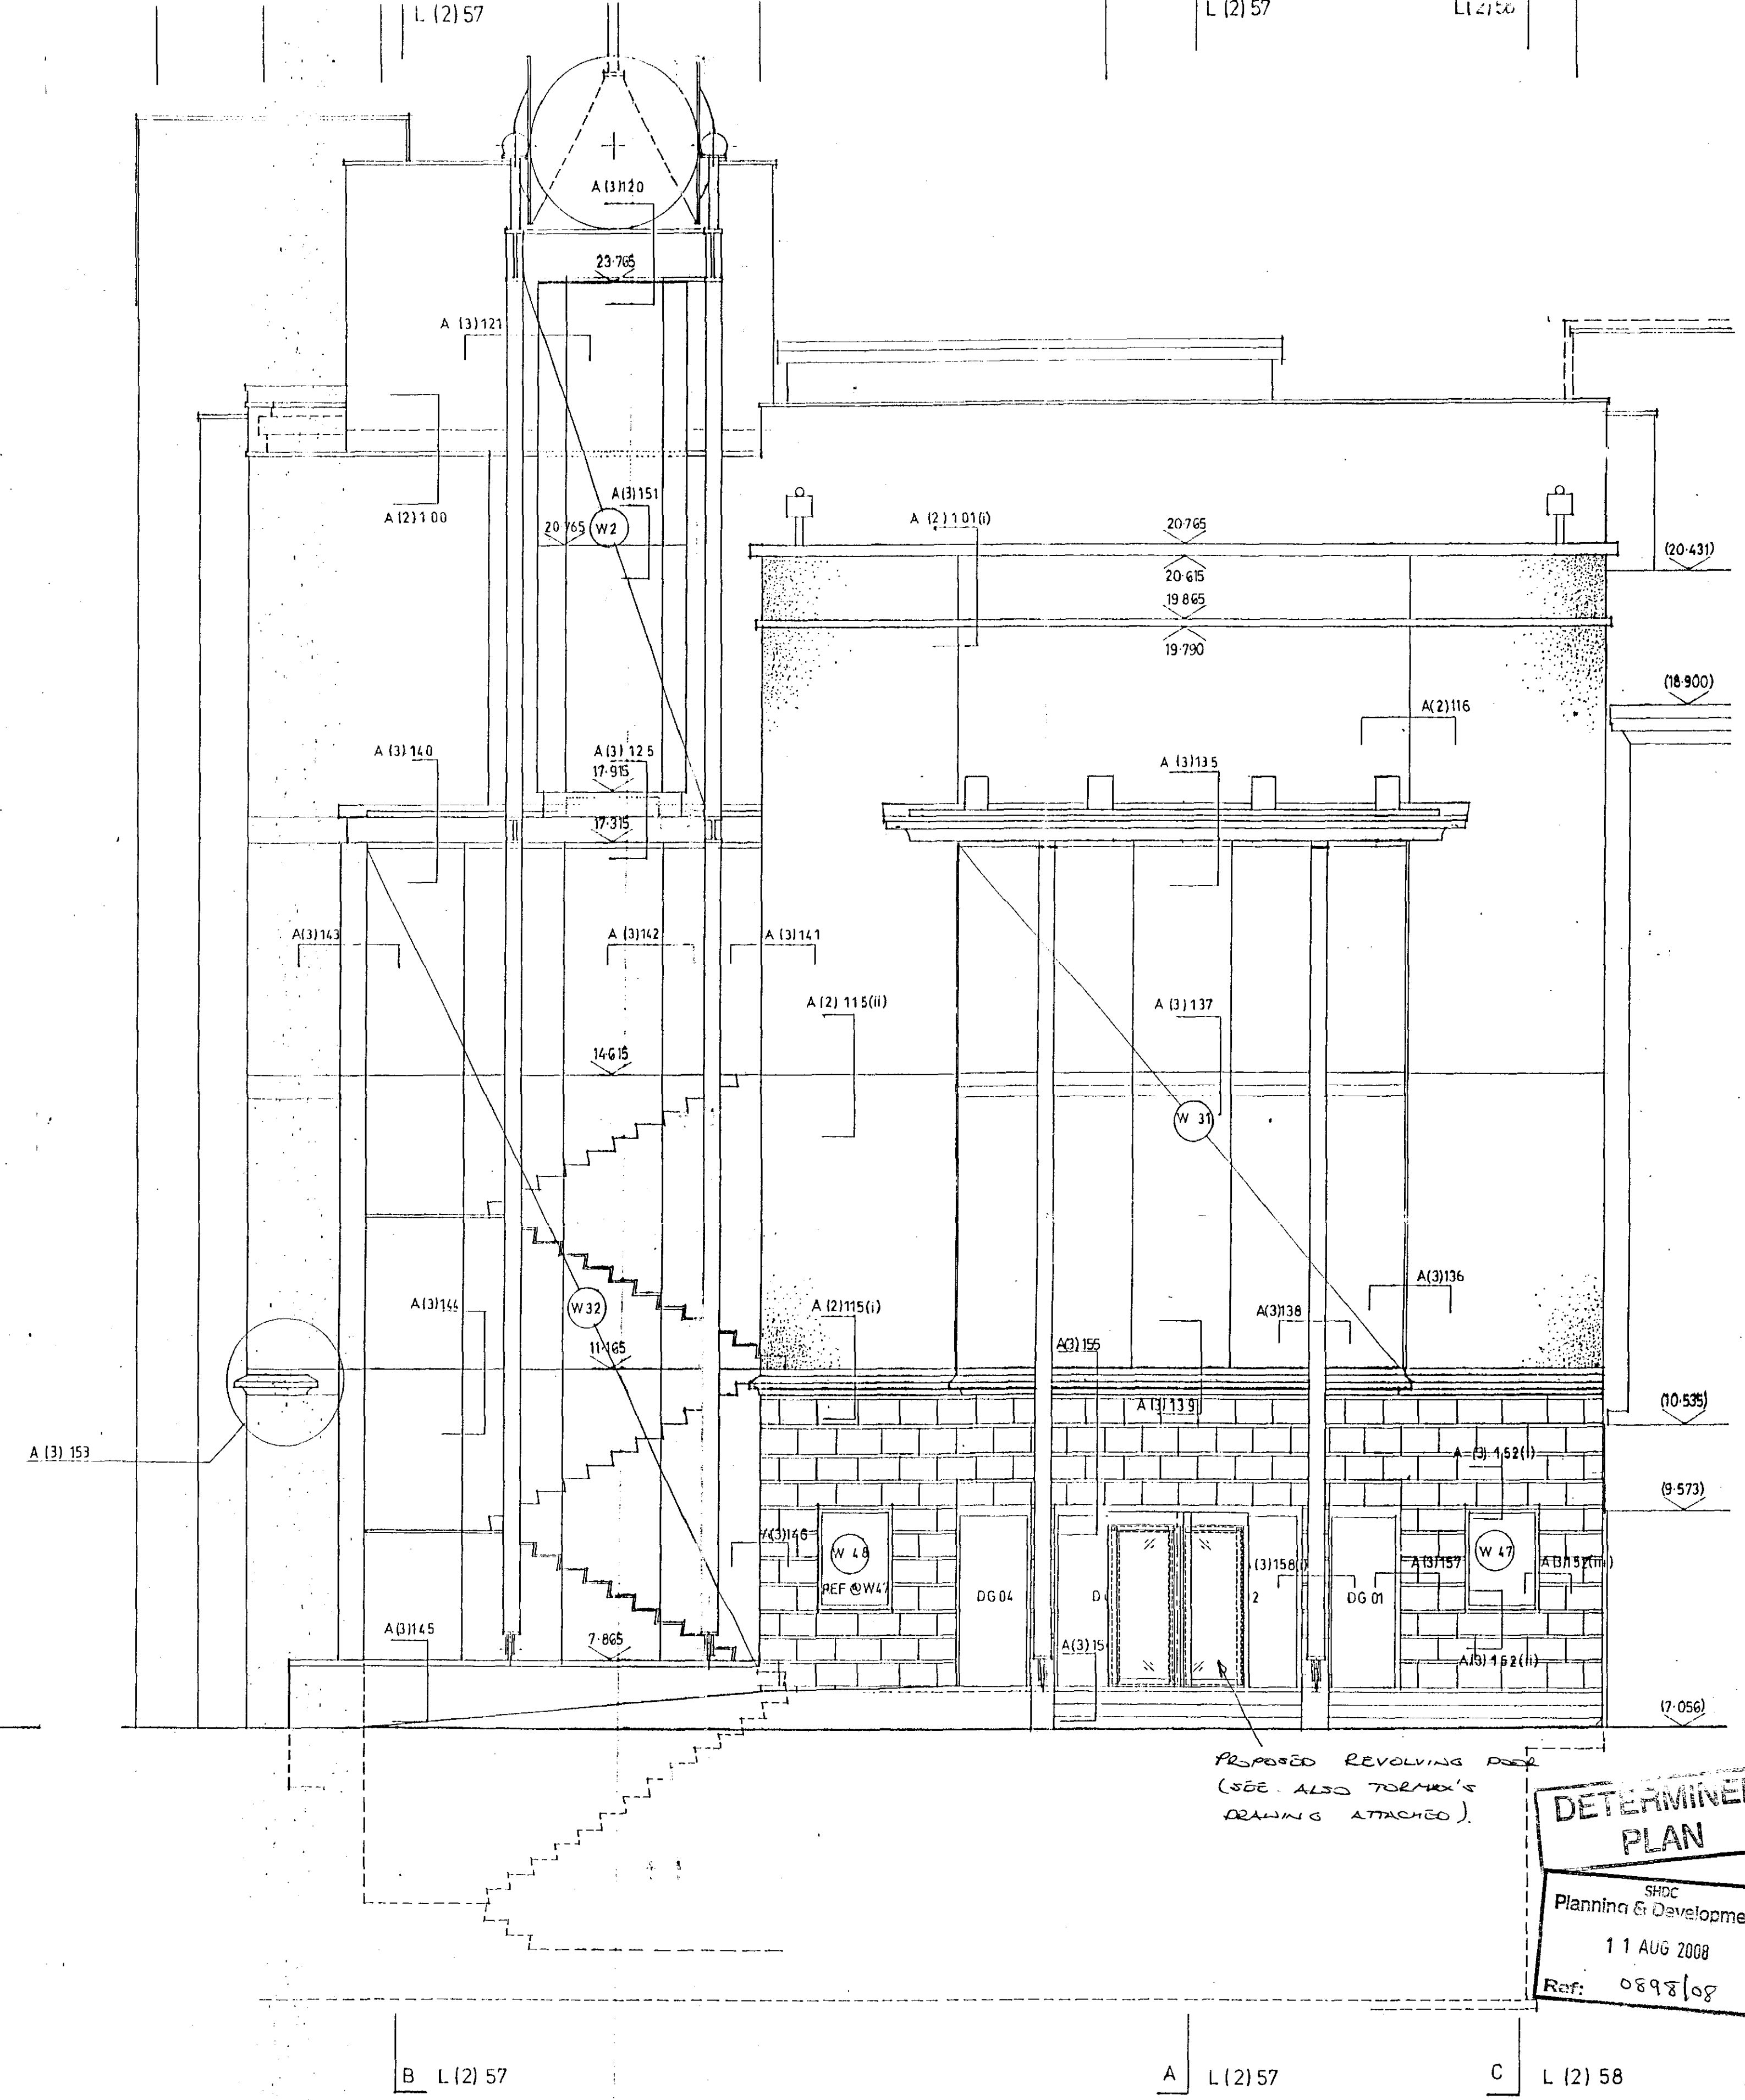


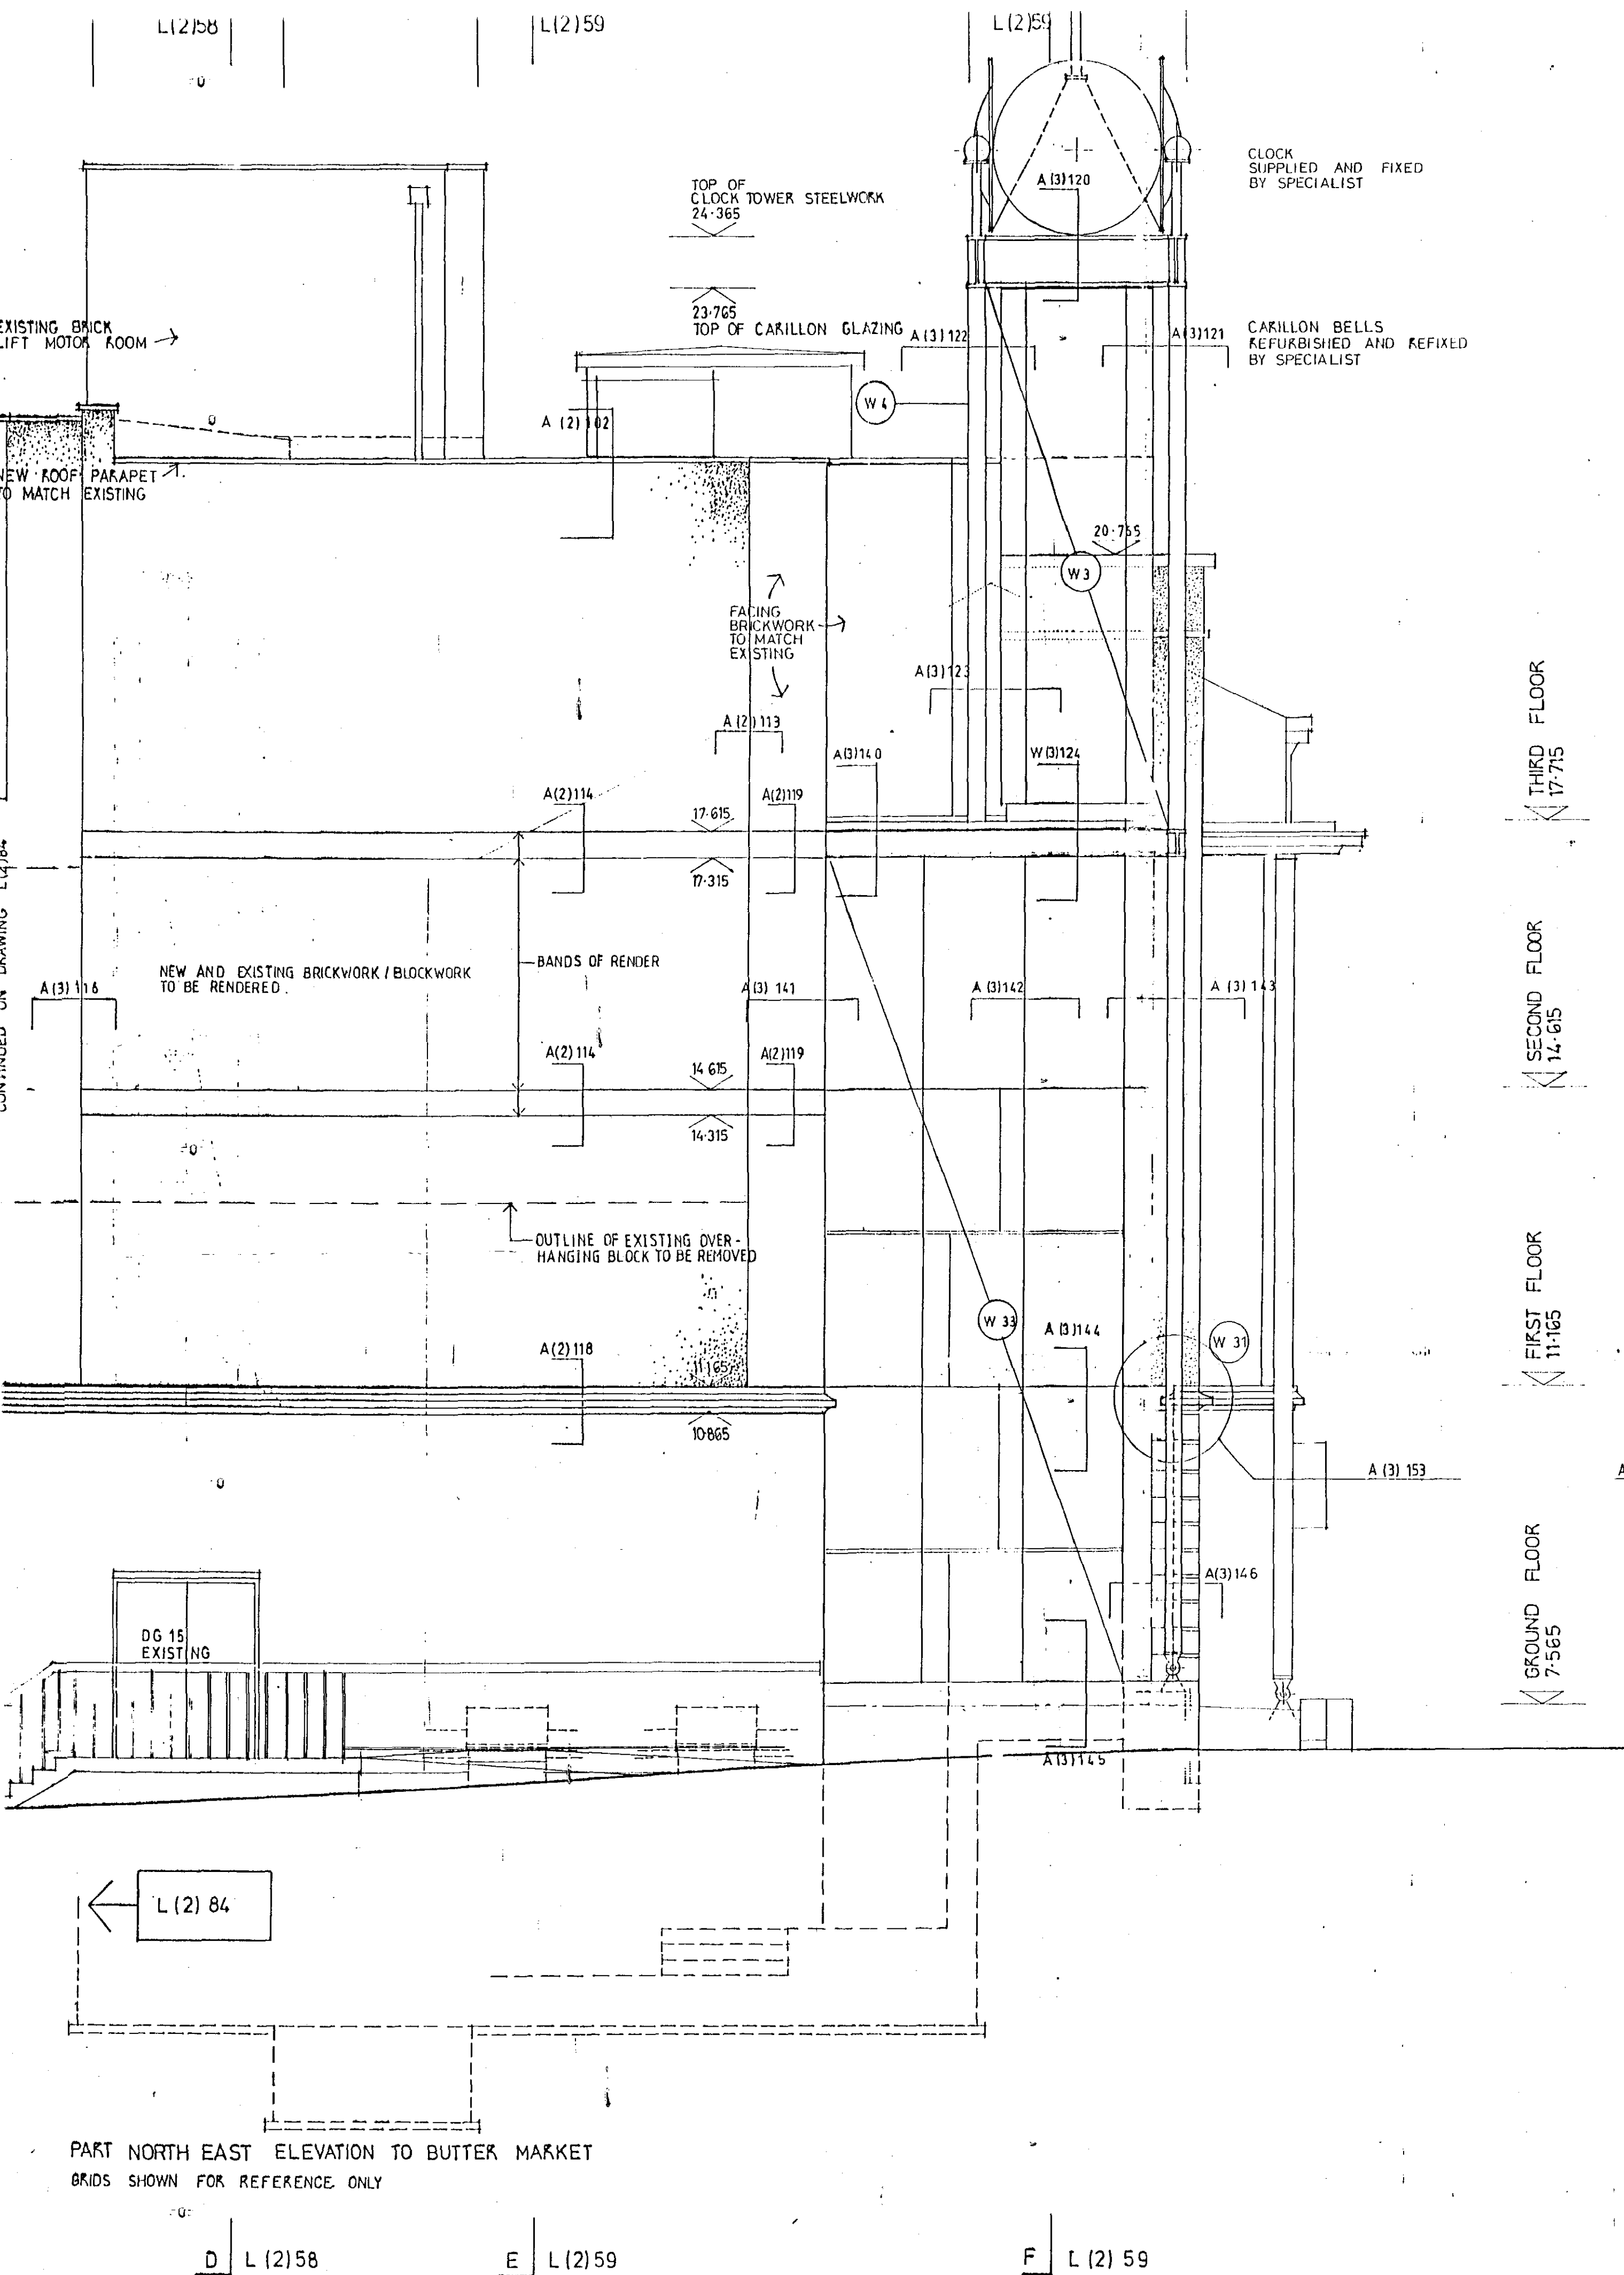

PROPOSED REVOLVING DOOR
(SEE ALSO TORMAX'S
DRAWING ATTACHED)

DETERMINED PLAN

SHDC
Planning & Development
11 AUG 2008
Ref: 0898/08

SURVEY INFORMATION BASED ON RANDALL SURVEYS DRAWINGS. EXISTING LEVELS THUS (-18.900) FOR STRUCTURAL DETAILS SEE WS ATKINS DRAWINGS

ISANSOME HALL ARCHITECTS

REGENCY COURT 220 UPPER FIFTH ST. CENTRAL MILTON KEYNES MK9 2HR TEL: 01908 866555 FAX: 01908 866002

PROJECT:
SOUTH HOLLAND CENTRE • SPALDING

TITLE:
FRONT OF HOUSE • NE. ELEVATION (PART) AND NW. ELEVATION TO MARKET PL.

SCALE: 1:50 DATE: 4.6.96 JOB: 9215 DWG: L(2) 60 (A) REV: AS BUILT

Dimensions to be used in reference to scaled sizes. All dimensions must be checked by contractor before commencing work on site. No deviation from this drawing will be permitted without prior written consent of the architect.