




ID	Revision Description	Date	Checked	Reviewed
A	First Issue	30.08.26	WF	CT



Site Plan As Approved Ref: H16-1091-24

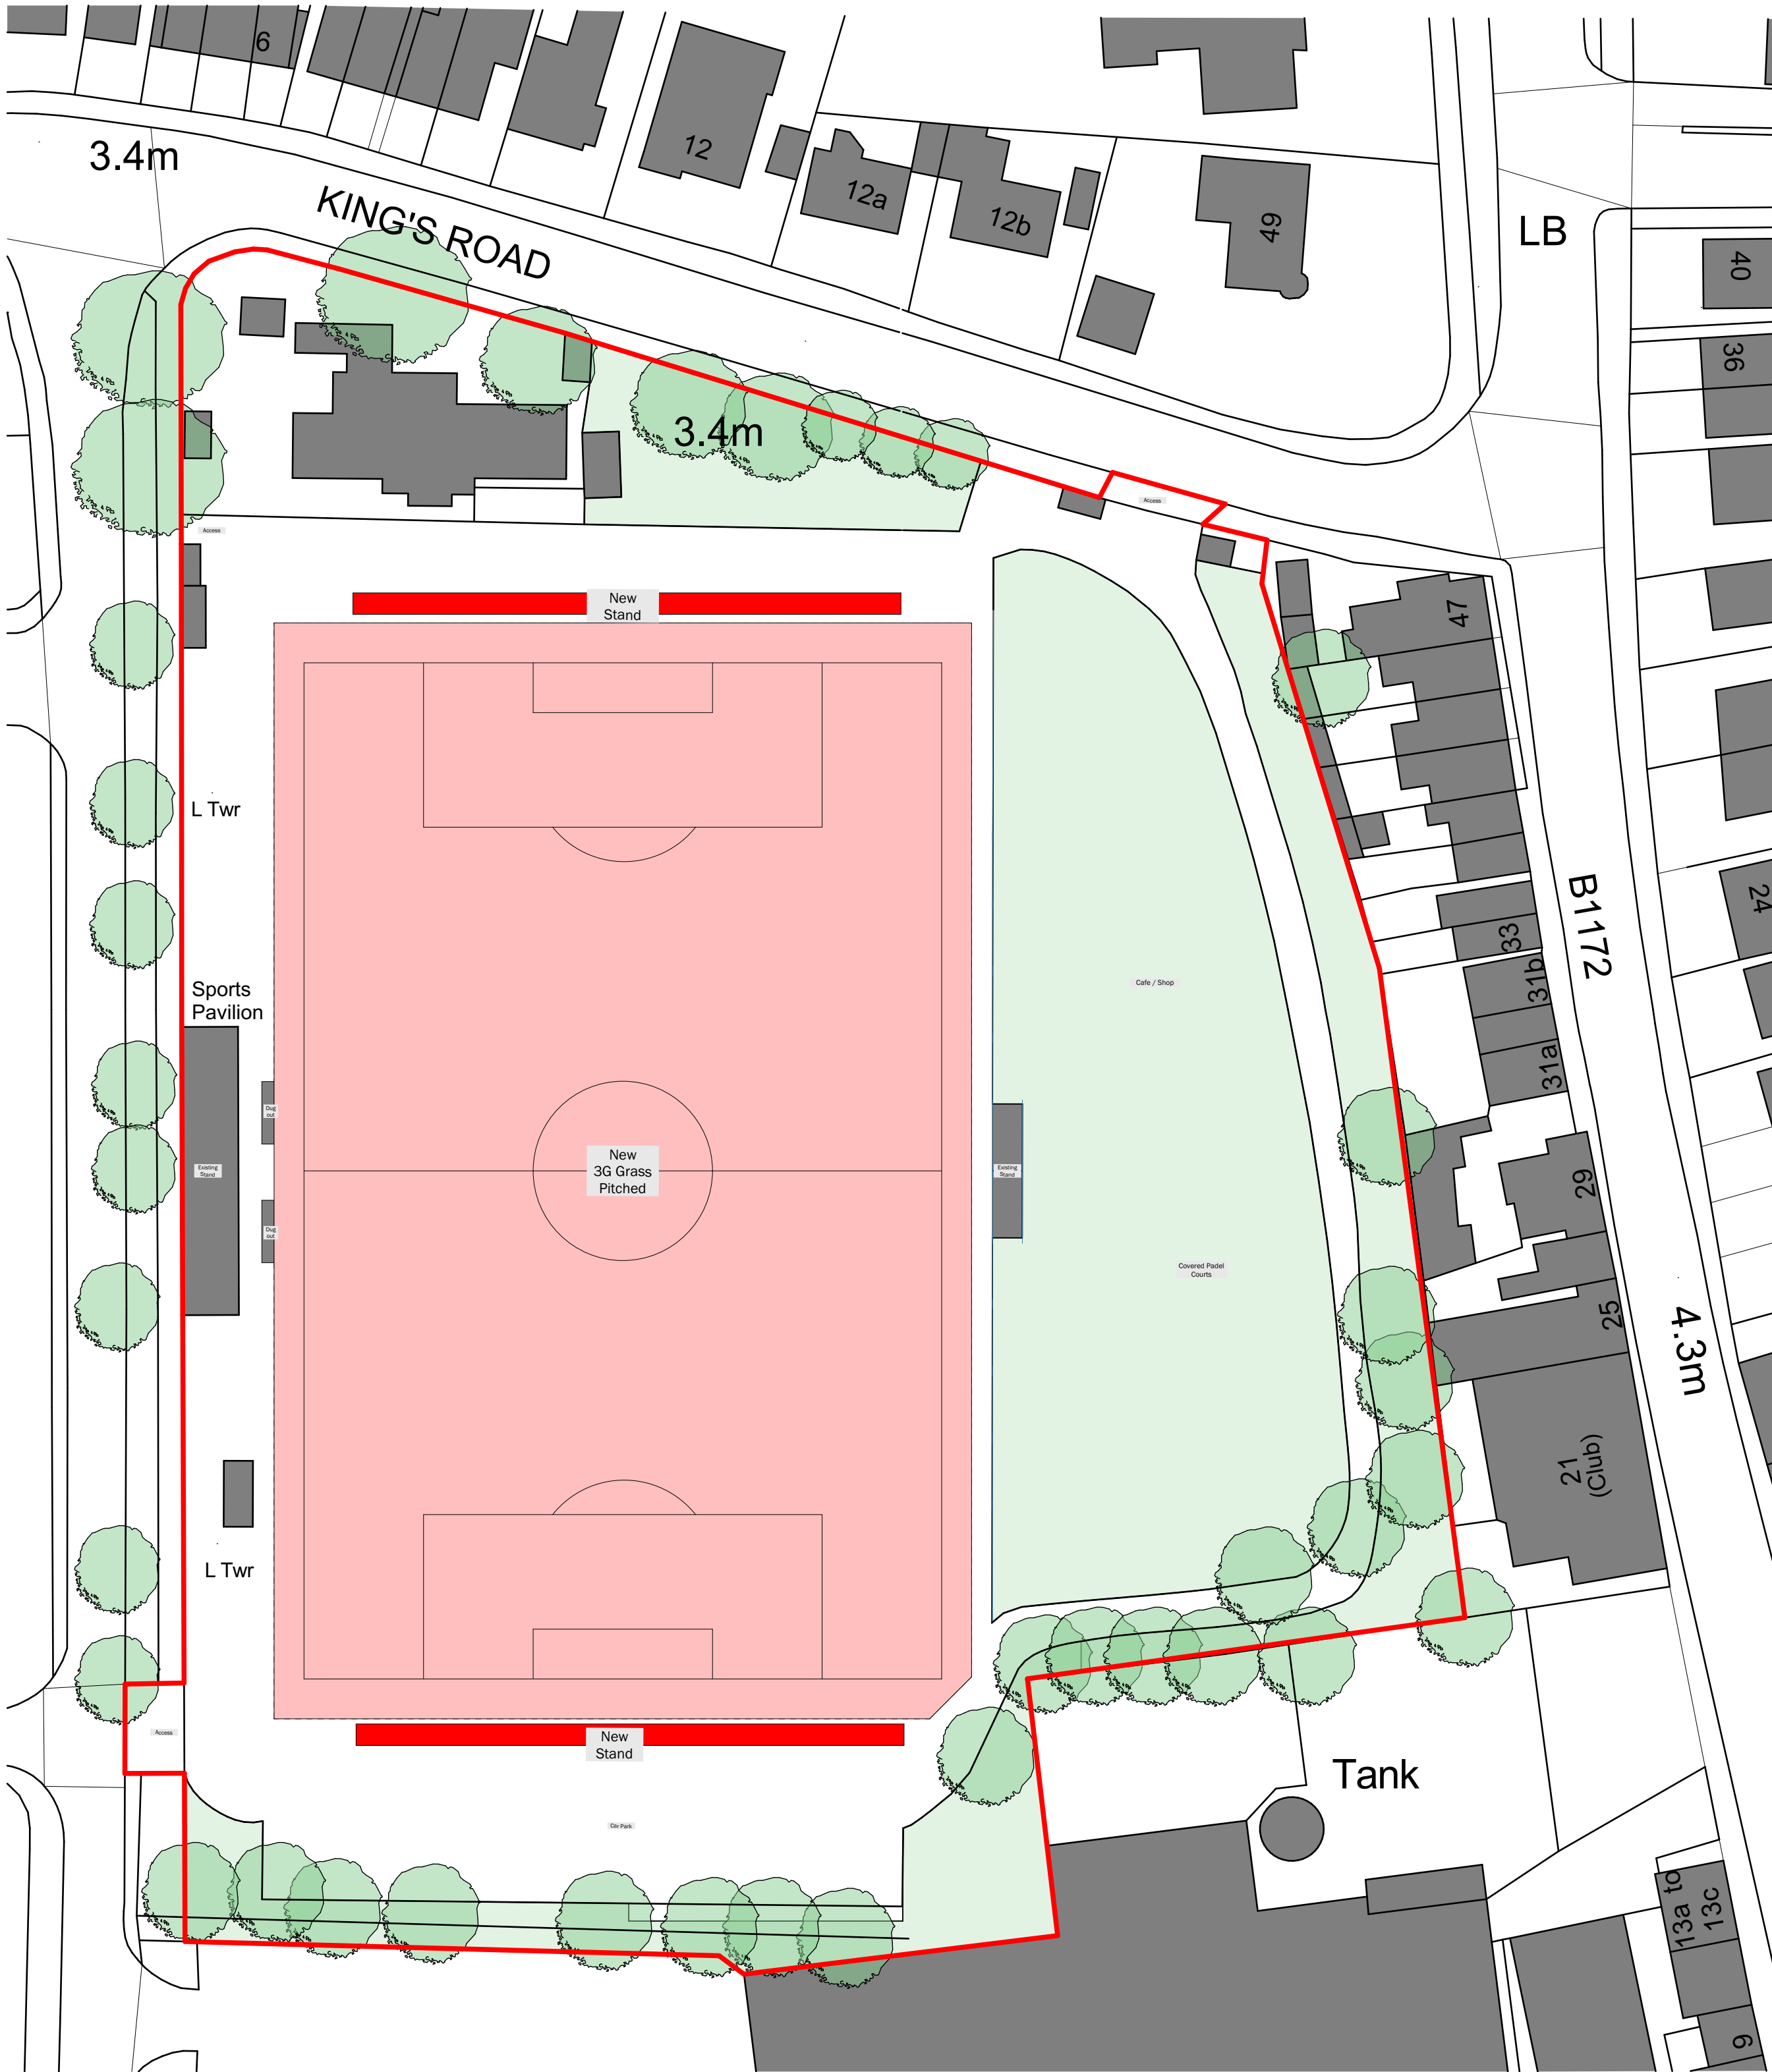

Site Plan As Existing

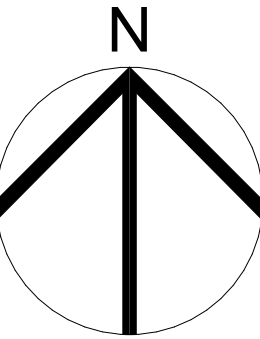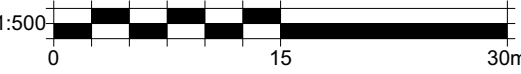

- = New Stands
- = 3G Pitch



T: 01780 740 008 | M: 07708931576 | admin@fieldandfox.com
www.fieldandfox.com | Ashton, Stamford

CLIENT
CTEK Services

PROJECT
**Two new stands & 3G Pitch
Sir Halley Stewart Playing Fields, Spalding**

DRAWING TITLE
**Block Plan: approved and as-built
comparison**

DRAWING STATUS		DRAWING SCALE @ A1	
Planning		1:500	
DRAWN BY	REVIEWED BY	DATE OF FIRST ISSUE	
WF	WF	30.08.26	
PROJECT NUMBER	WORK STAGE	DRAWING NUMBER	REVISION
1083	S03	PL0002	A