



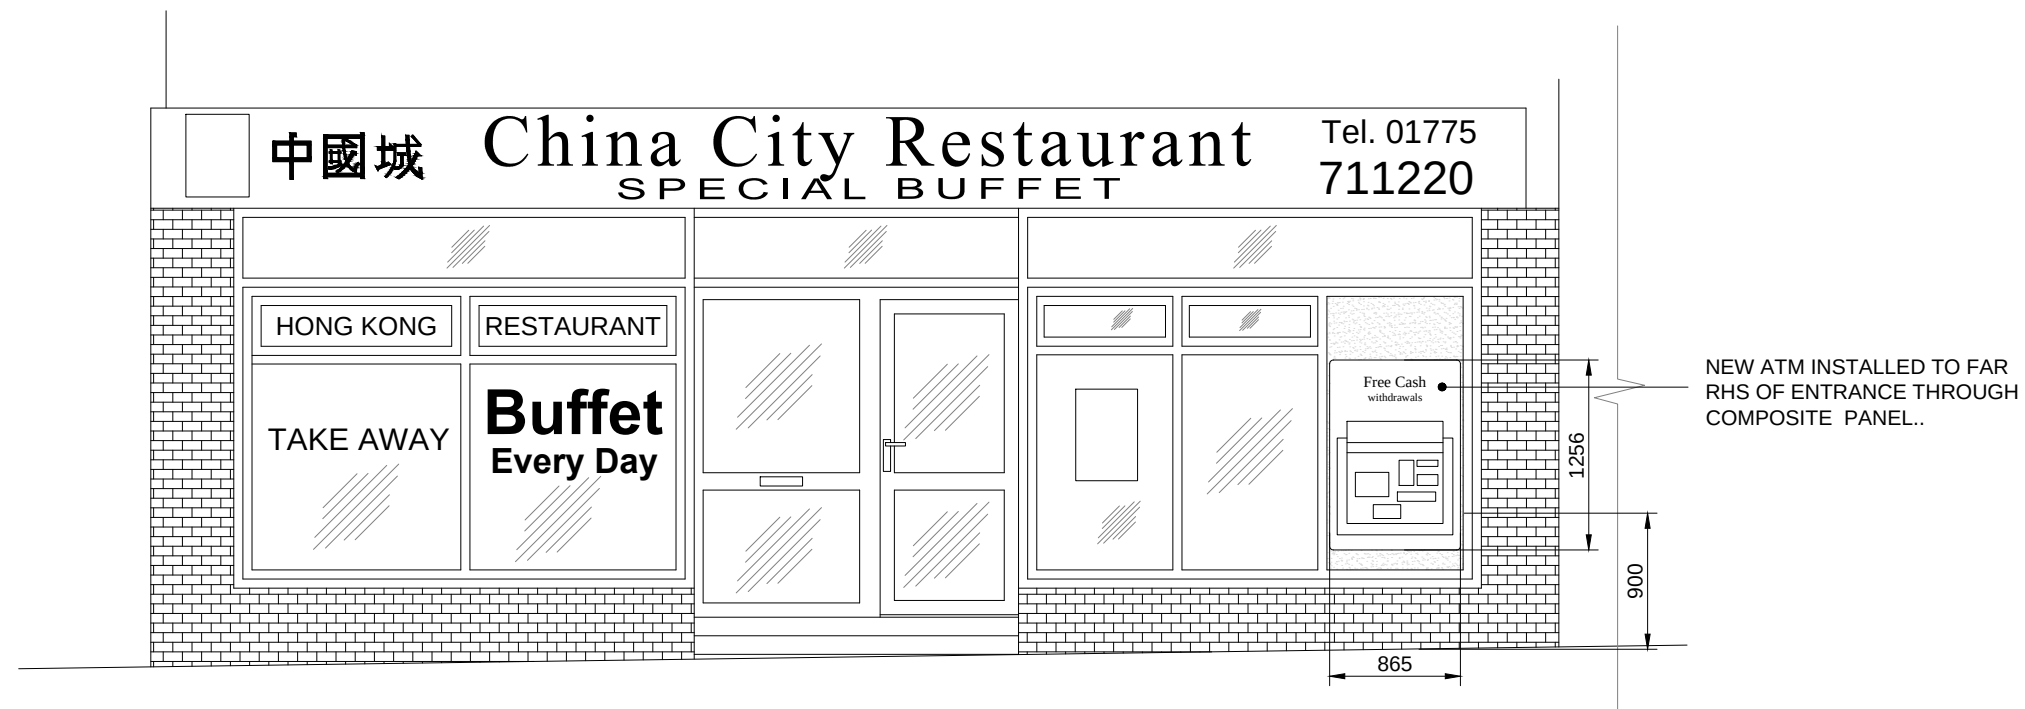

AS INSTALLED FRONT ELEVATION
SCALE 1:50

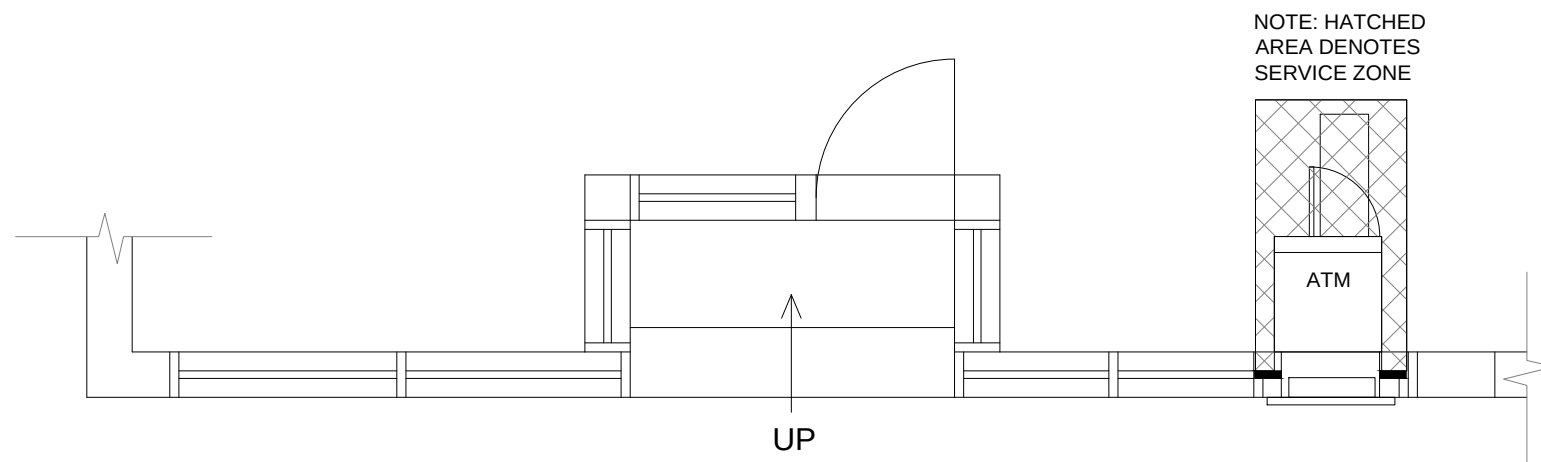

AS INSTALLED PART PLAN
SCALE 1:50

1. ALL MEASUREMENTS/DIMENSIONS TO BE CHECKED ON SITE PRIOR TO UNDERTAKING ANY WORKS.

REV.	DATE	BY	DESCRIPTION



NoteMachine UK Ltd

Elvicta Business Park, Crickhowell, Powys, NP8 1DF
Tel: 01873 811 634 Fax: 01873 811 552

CLIENT Mini Pole (TTW)			
TITLE AS INSTALLED ELEVATION AND PLAN CONVENIENCE STORE 20 WINSOVER ROAD SPALDING, PE11 1EJ			
DRAWN BY PM/CAD	DATE 05/08/16	SCALE 1:50	SHEET SIZE A3
CHECKED BY	DATE	APPROVED BY	DATE
DRAWING No. 32048-37-002			REVISION 0