

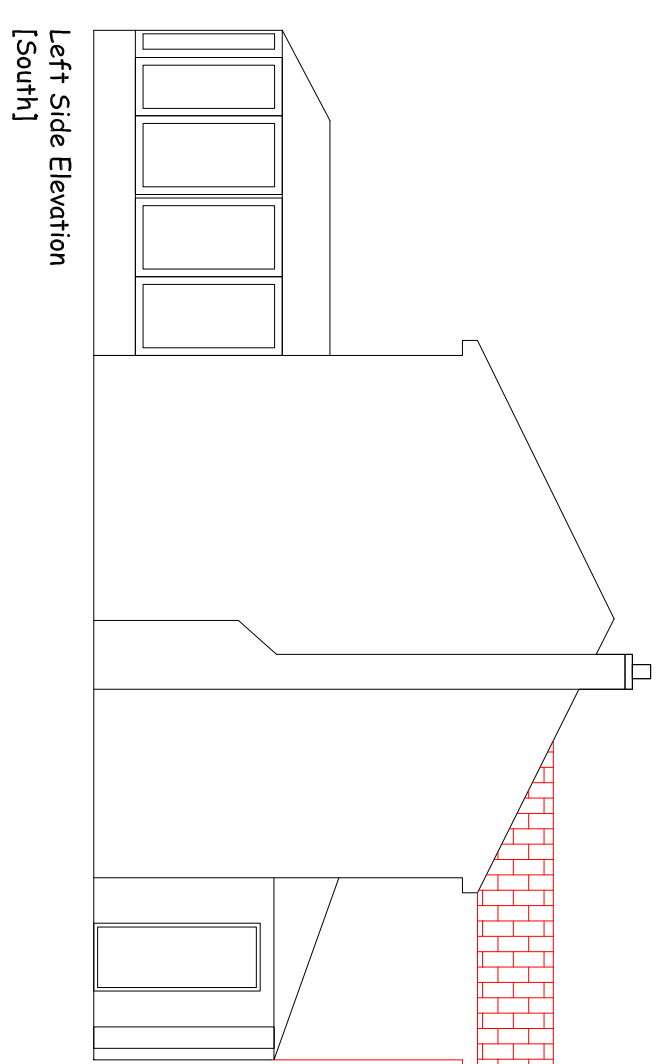
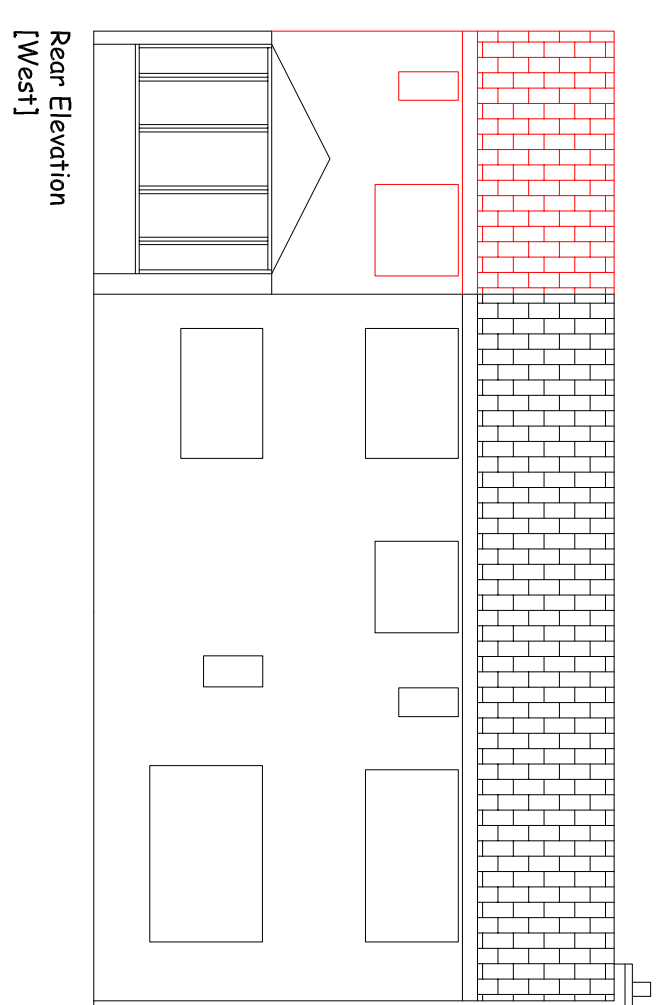
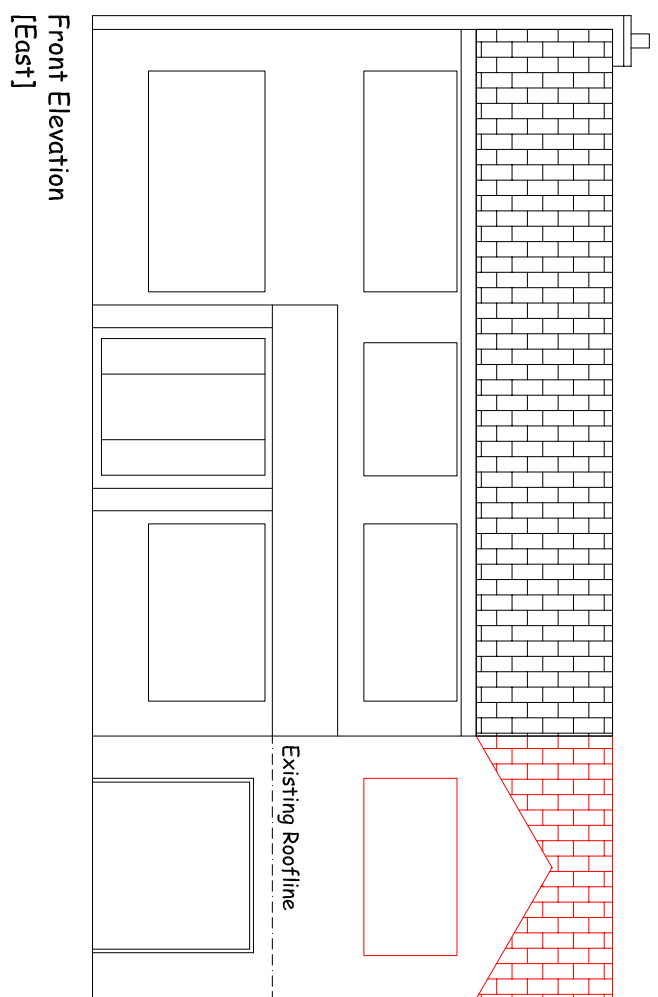
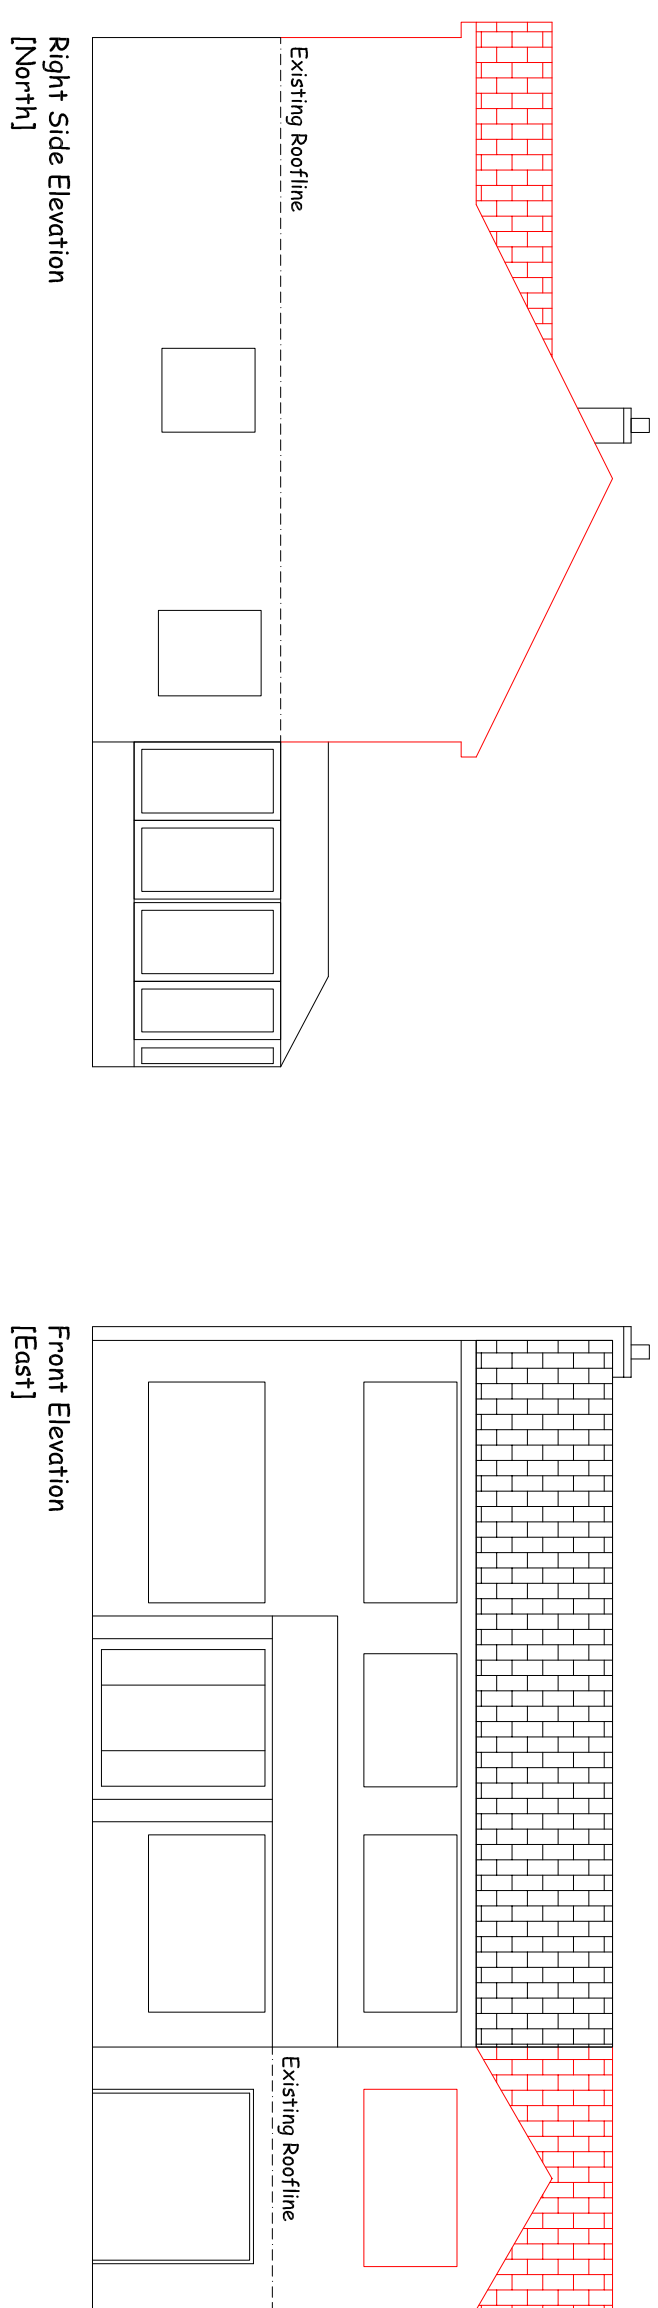


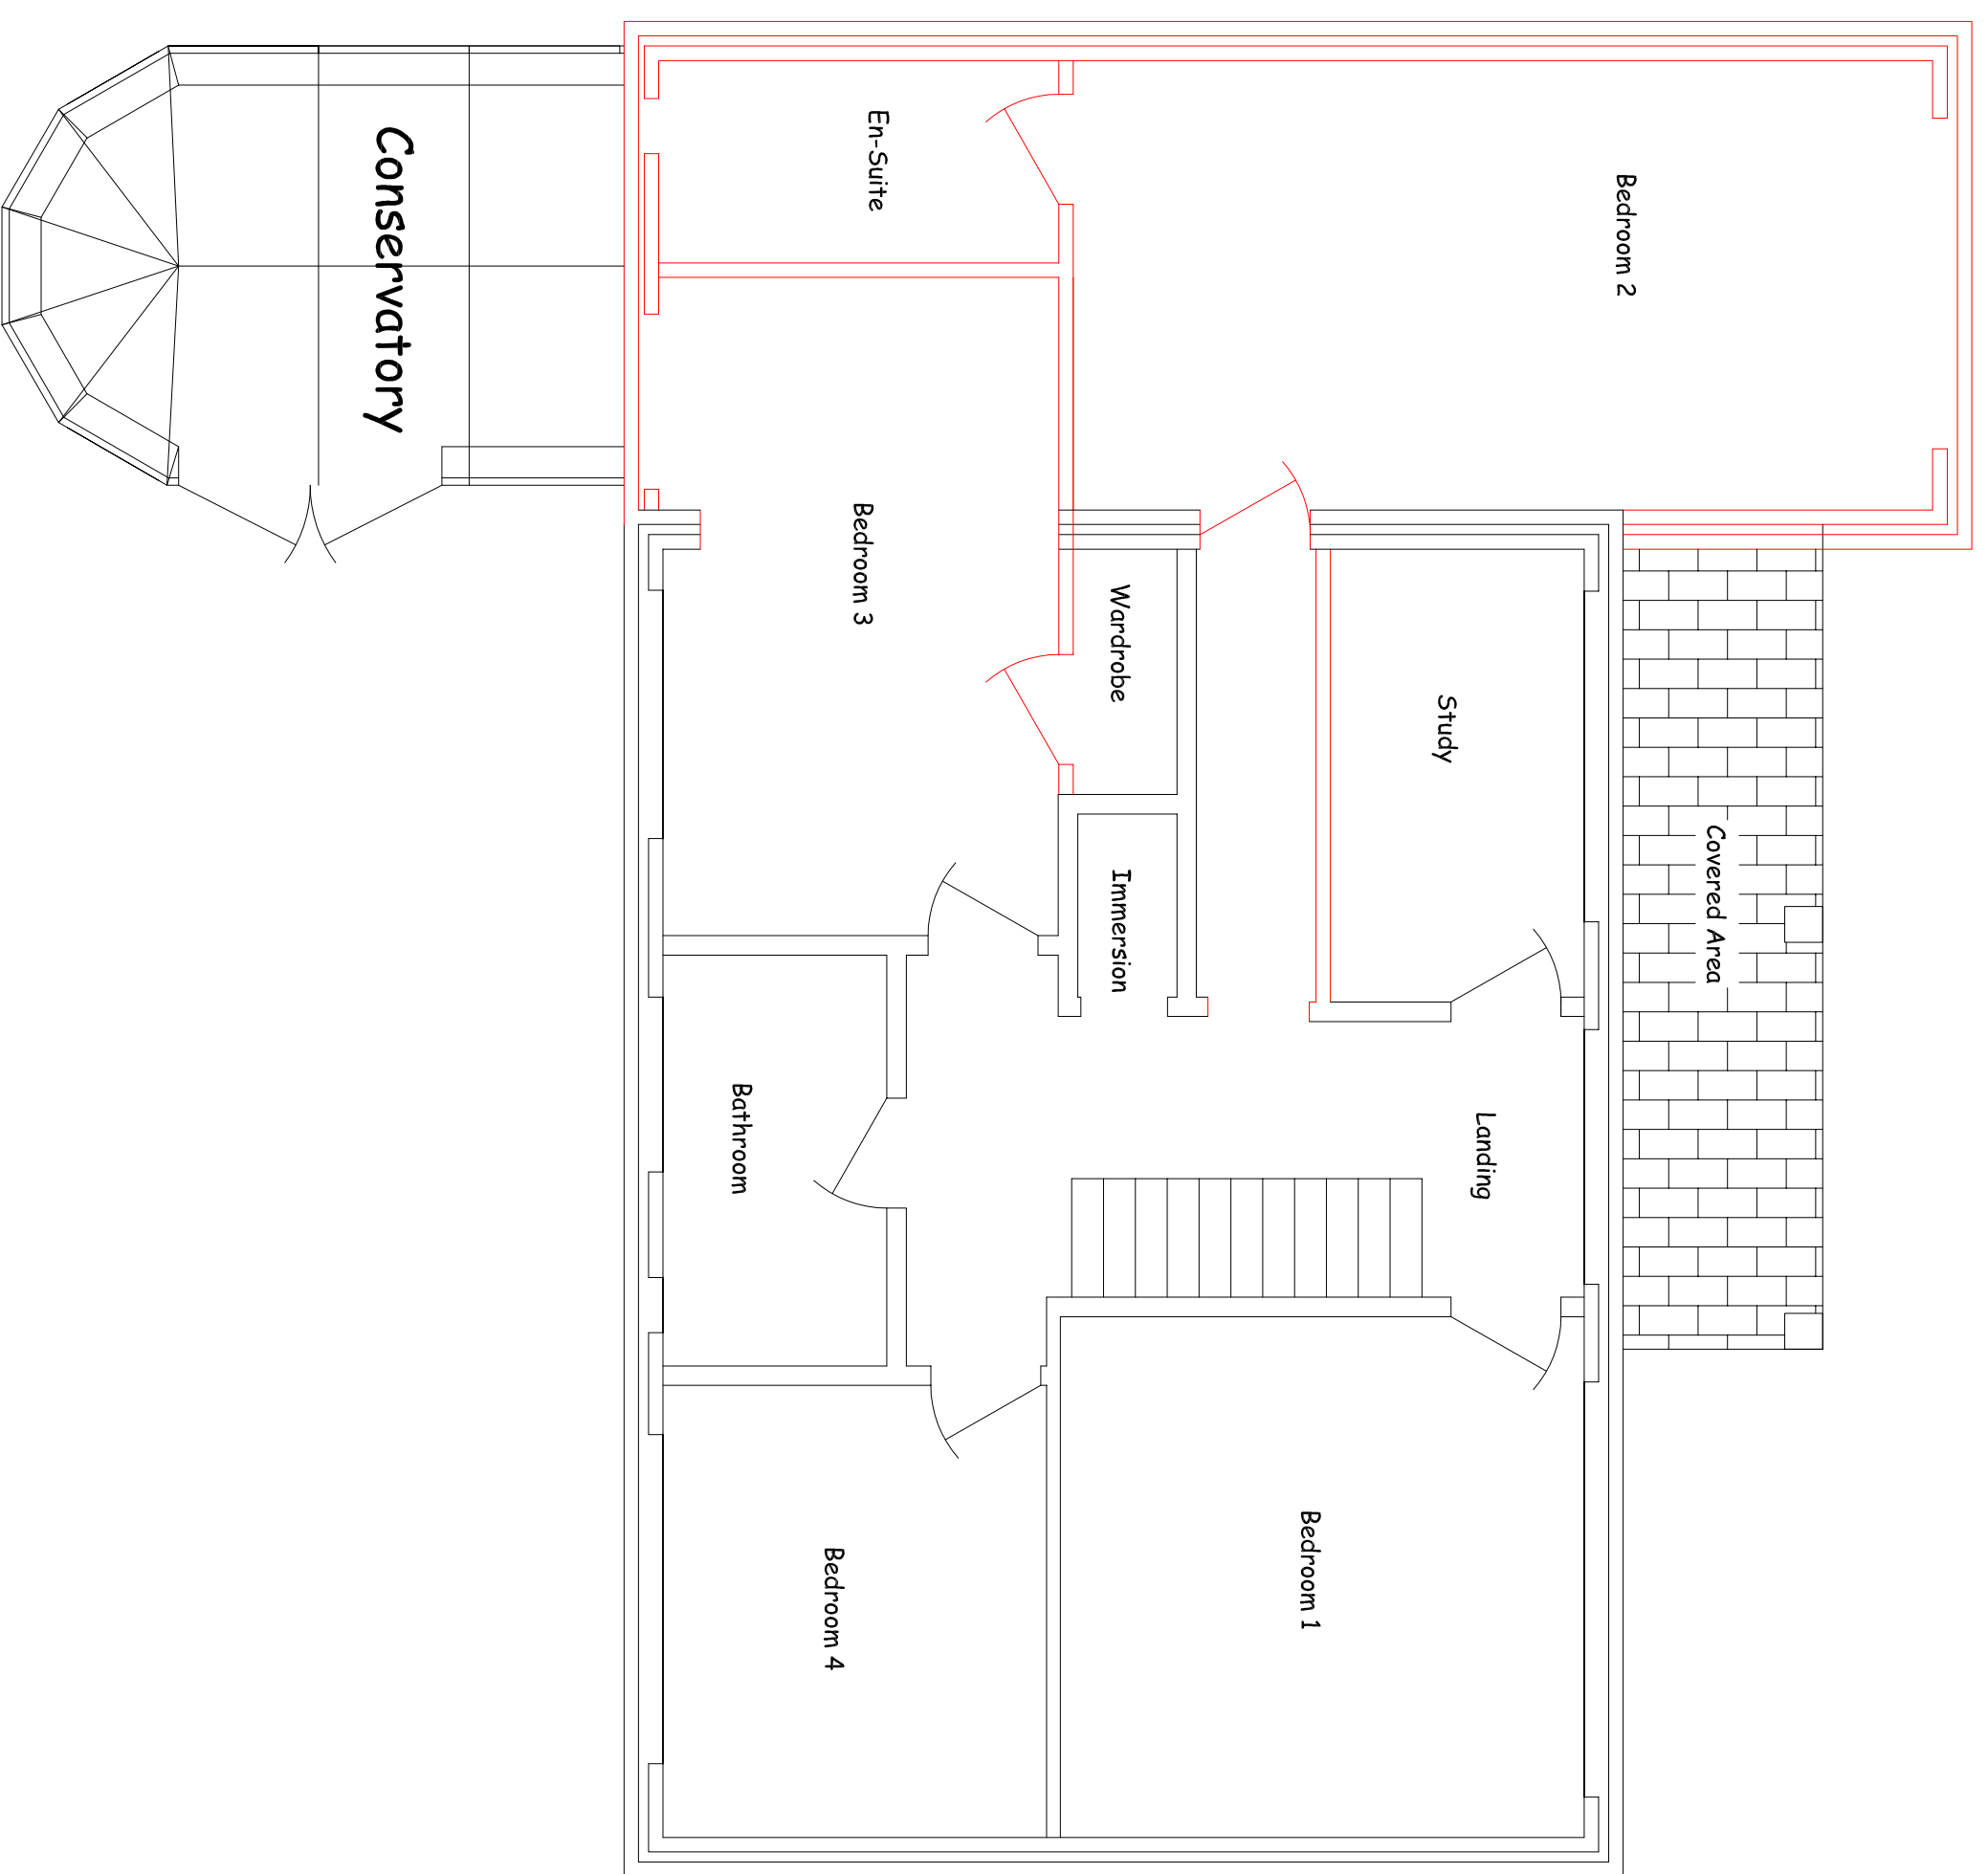

Scale 1:100

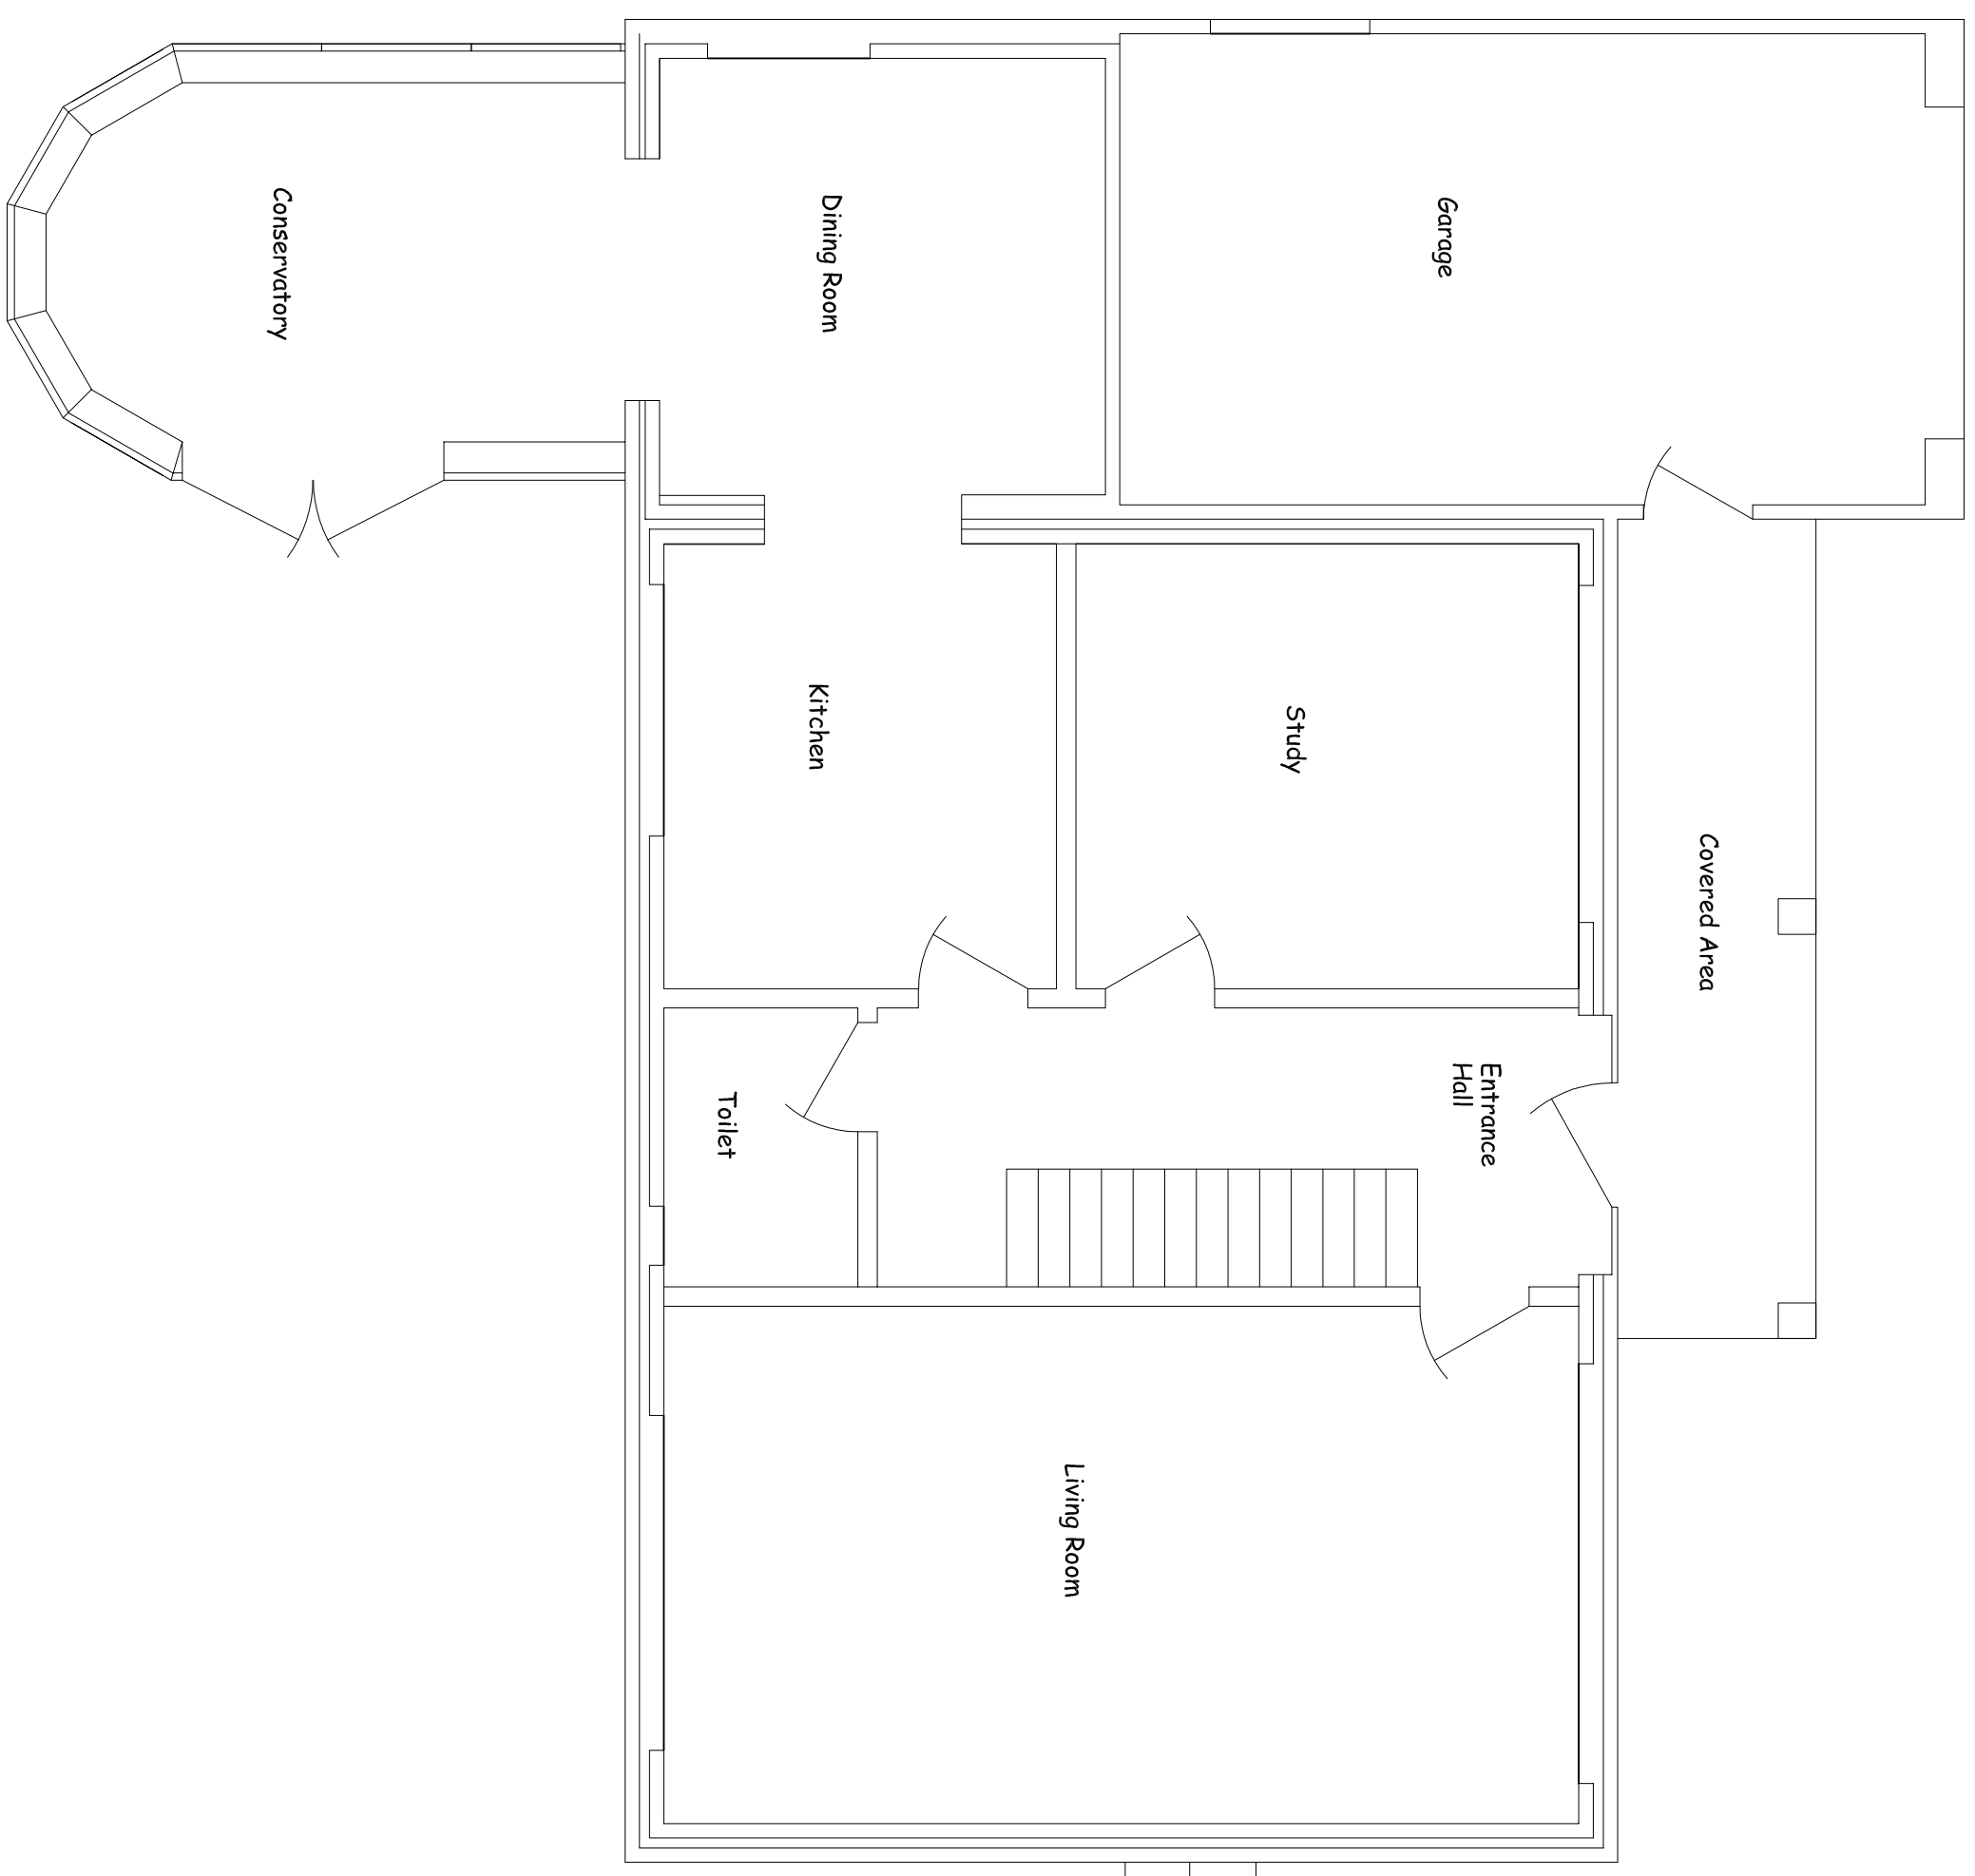

Proposed Ground Floor - no change to floor plan
Scale 1:50

Proposed First Floor - proposed changes marked in red
Scale 1:50

BRANCH		A1_LAYOUT_PAGE			
JMCC					
DATE		08.10.2021			
CHECKED		JSMQLEOD			
CHECKED		PROPOSED-EXTENSION			
DATE					
—					
SCALE					
VARIABLES					
REF	2021 SUB	81021	1	1	A