
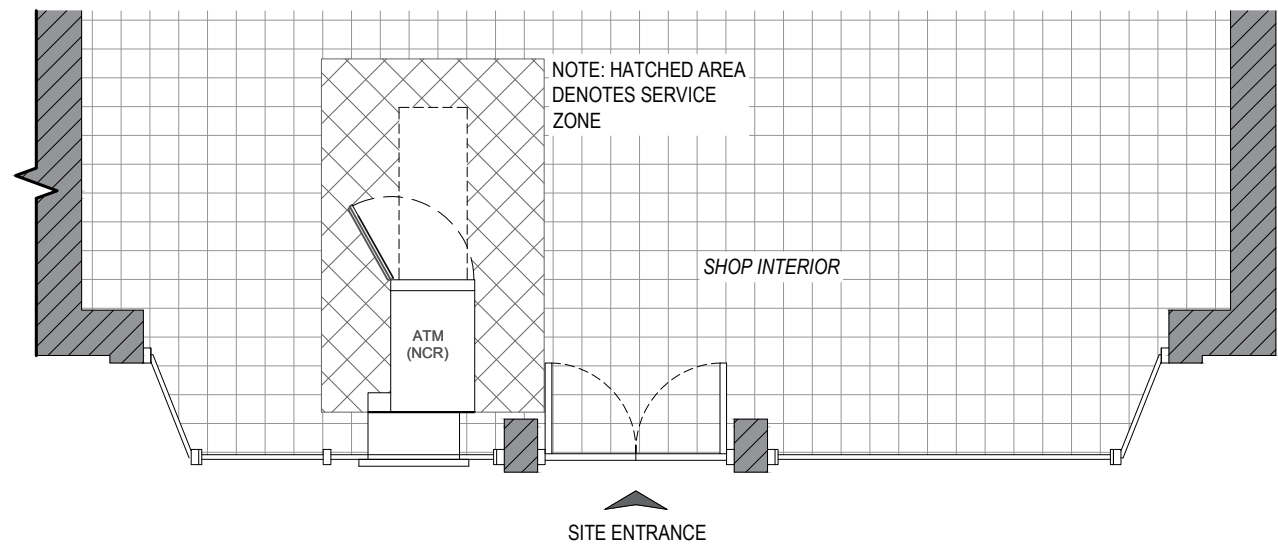
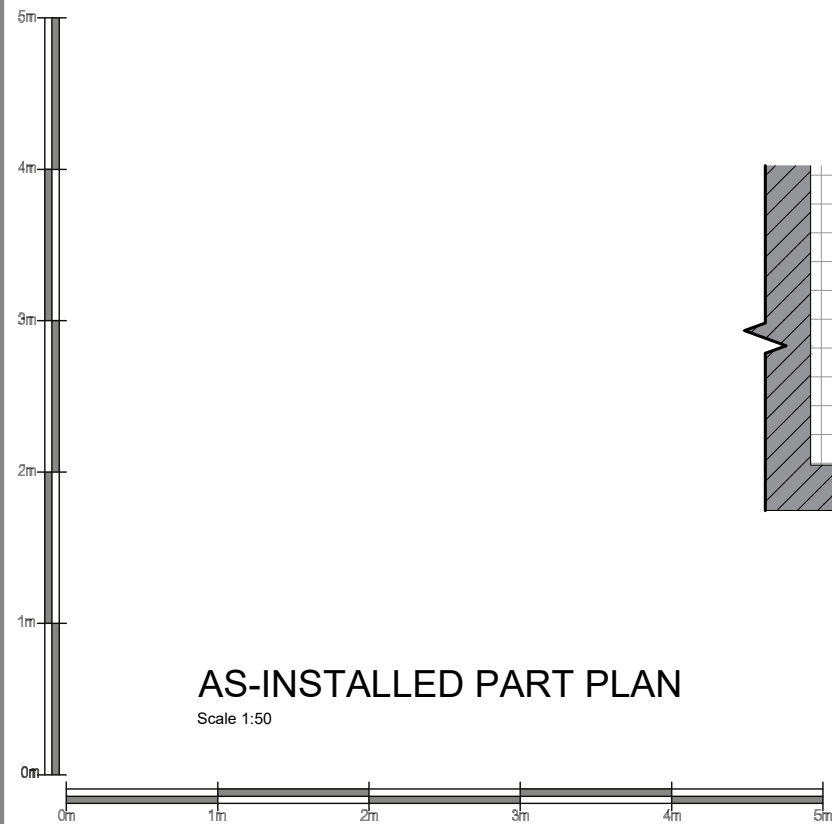
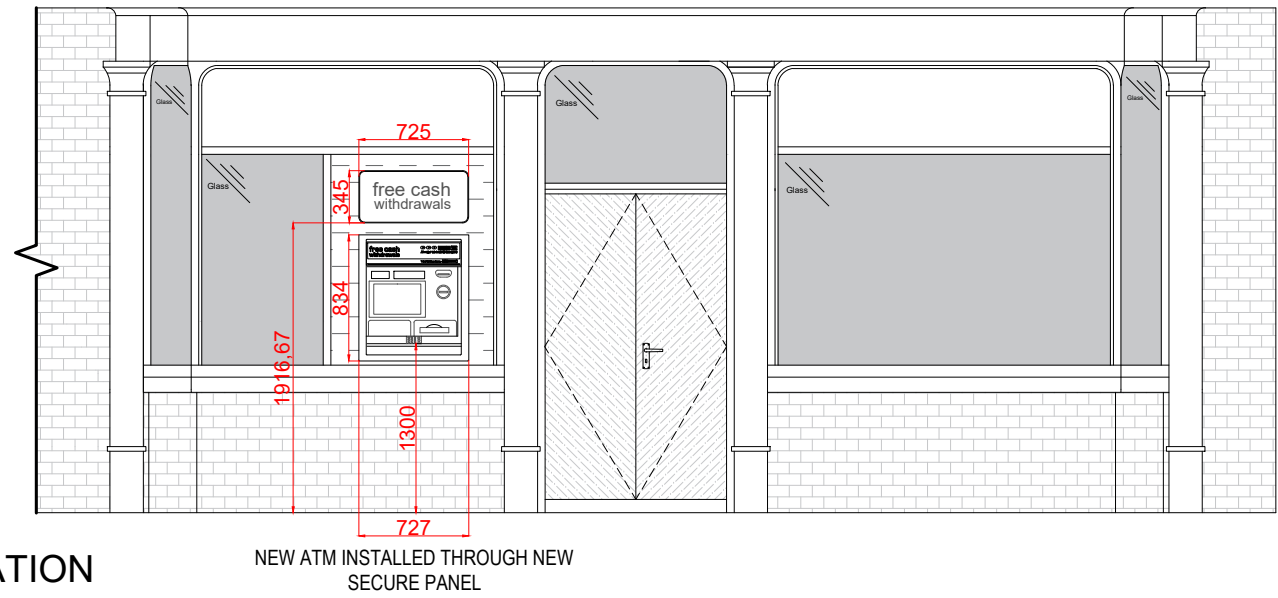


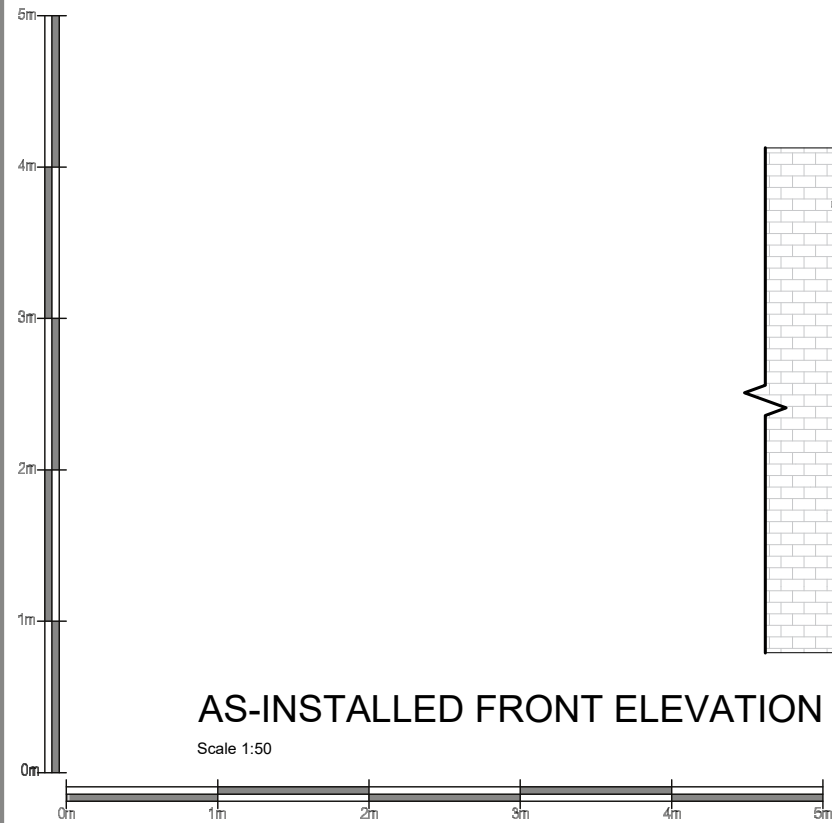

Date: Comments: By:

GENERAL NOTES:
1) All dimensions in millimeters unless otherwise stated.

Site:
Nida,
13 WINSOVER ROAD,
SPALDING,
PE11 1EG

Drawing Title:
As-Installed Plan and Elevation

Ref: T020924_AI	Date: 20/06/2022	Rev:
Scale: 1:50	Paper: A3	Date Rev: