

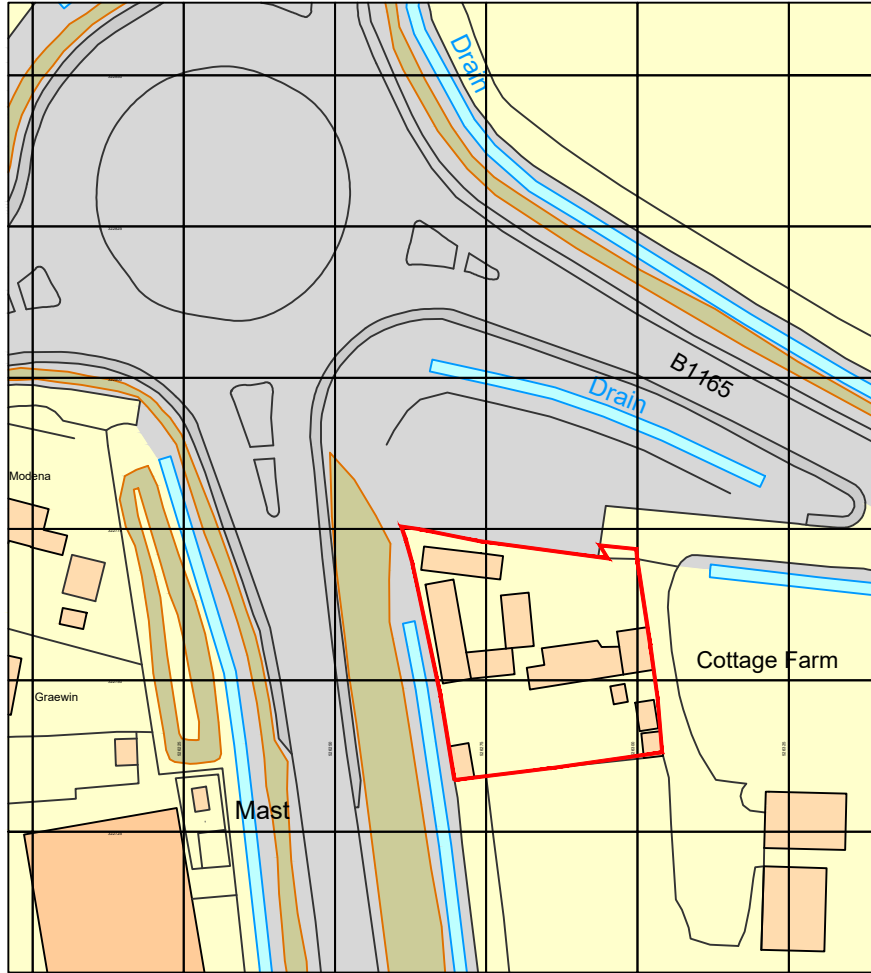


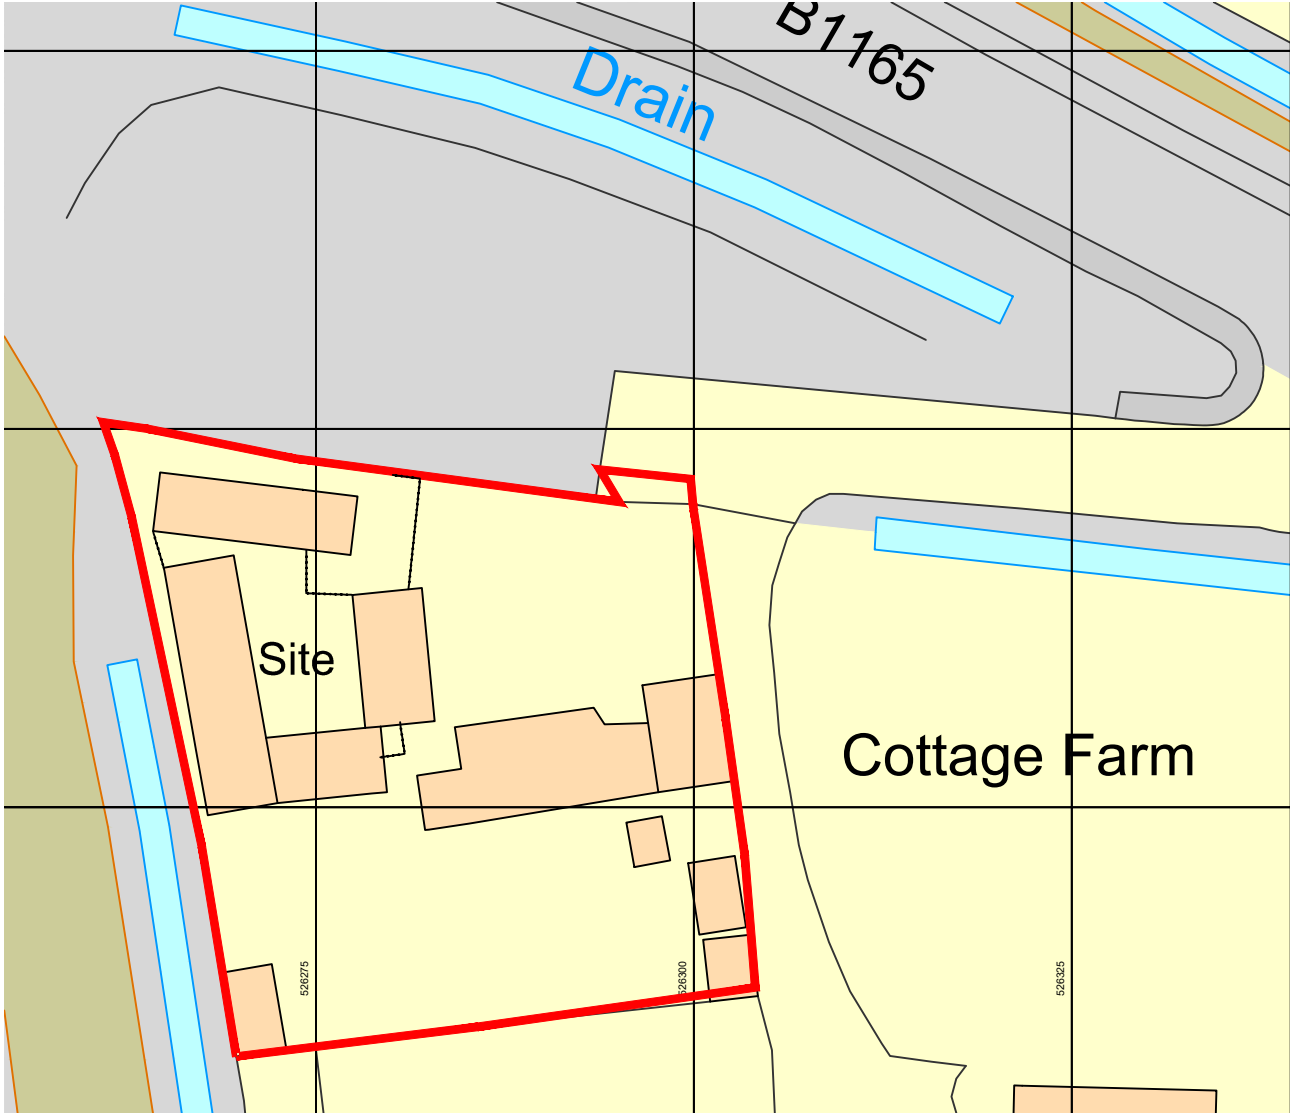

Ordnance Survey, (c) Crown Copyright 2022. All rights reserved. Licence number 100022432


Site Location Plan as constructed

Scale 1:1250 @ A3

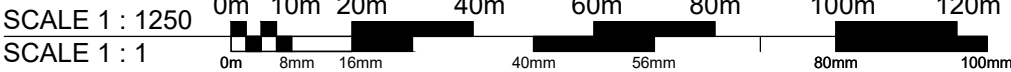

Site Block Plan as constructed

Scale 1:500 @ A3

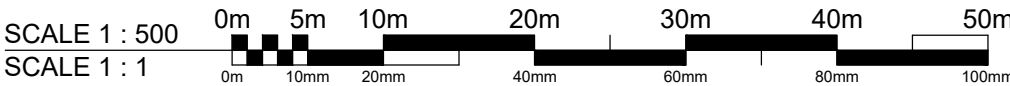

Client:
Mr M. Adamonis

Project: **Proposed dog kennels at Fulney Cottage
Low Road
Spalding
PE12 6EF**

Drawing No.:
A1635- 10

Rev:
-

Date: **30.11.22**

Drawn by: **RCW**

Scale: **As Shown @ A3**

Checked by: **AJO**

DO NOT SCALE THIS DRAWING. THE CONTRACTOR IS DEEMED TO HAVE CHECKED ALL DIMENSIONS ON SITE AND REPORT ANY DISCREPANCIES TO OGLESBY & LIMB LTD. THE CONTENTS OF THIS DRAWING ARE COVERED BY COPYRIGHT AND REMAIN THE PROPERTY OF OGLESBY & LIMB LTD. WRITTEN APPROVAL MUST BE OBTAINED FROM OGLESBY & LIMB LTD PRIOR TO DUPLICATION OR REPRODUCTION OF THIS DRAWING OR ITS CONTENTS. ANY DIMENSIONS NOT SHOWN ARE TO BE CHECKED AND AGREED WITH OGLESBY & LIMB LTD.

Drawing Title:
**Site Location and Block Plan
as constructed**
**RETROSPECTIVE PLANNING
APPLICATION ISSUE
PREVIOUSLY APPROVED H16-0986-19**

Oglesby & Limb Ltd
Chartered Architect

Suite 1 Market Chambers
12 Market Place, Spalding
PE11 1SL

T: 01775 761196

e-mail: design@o-l-ltd.co.uk

